

APPLICATION

PERCOLATION TESTING

A 45730

P _____

HOWARD COUNTY HEALTH DEPARTMENT
BUREAU OF ENVIRONMENTAL HEALTH
P.O. BOX 476 ELLICOTT CITY, MARYLAND 21043
TELEPHONE: 461-9933

DISTRICT _____

DATE _____

TO: THE COUNTY HEALTH OFFICER
ELLICOTT CITY, MARYLAND

I, HEREBY, APPLY FOR THE NECESSARY TEST IN ORDER TO CONSTRUCT (OR RECONSTRUCT) A SEWAGE DISPOSAL SYSTEM.

PROPERTY OWNER Murle L. Thompson - Robert Stevens

ADDRESS 3017 Evergreen Way, Ellicott City, MD PHONE 531-3212

PROSPECTIVE BUYER Robert Steves

ADDRESS 1626 Forest Park Ave, Balt, MD PHONE 744-3362

21207

PROPERTY LOCATION:

SUBDIVISION Thompson Property LOT NO. Parcel 1

ROAD AND DESCRIPTION N. side of Route 144, E. side of Thompson Drive

(11872 Thompson Drive)

TAX MAP 16 PARCEL # 159

SIZE OF LOT 3 acres TYPE BLDG. SFD - 3 Bedroom

BLDG. PERMIT SIGNED
AND RETURNED 8/16/94
Serial # 55531
(SINGLE FAMILY DWELLING OR COMMERCIAL)

THE SYSTEM INSTALLED UNDER THIS APPLICATION IS ACCEPTABLE ONLY UNTIL PUBLIC FACILITIES BECOME AVAILABLE. I FULLY UNDERSTAND THE
FEE CONNECTED WITH THE FILING OF THIS PERC TEST APPLICATION IS NON-REFUNDABLE UNDER ANY CIRCUMSTANCES. I ALSO AGREE TO COMPLY
WITH ALL M.O.S.H.A. REQUIREMENTS IN TESTING THIS LOT.

(SIGNATURE OF APPLICANT)

APPROVED BY _____ FOR _____ DATE _____

REJECTED BY _____ FOR _____ DATE _____

HOLD PENDING FURTHER TESTS _____ DATE _____

REASONS FOR REJECTION OR HOLDING HOLD FOR APPROVAL OF ADJOINER


CONVEYANCE + ENG'R PLAT - PERC OK MR 7/9/90

HD-216

THIS IS NOT A PERMIT

③ ④
SOIL PROFILE

brn org
sandy
clay
loam
2 1/2-3
tan &
org
sand
loam
25%
frags
↓
10-11

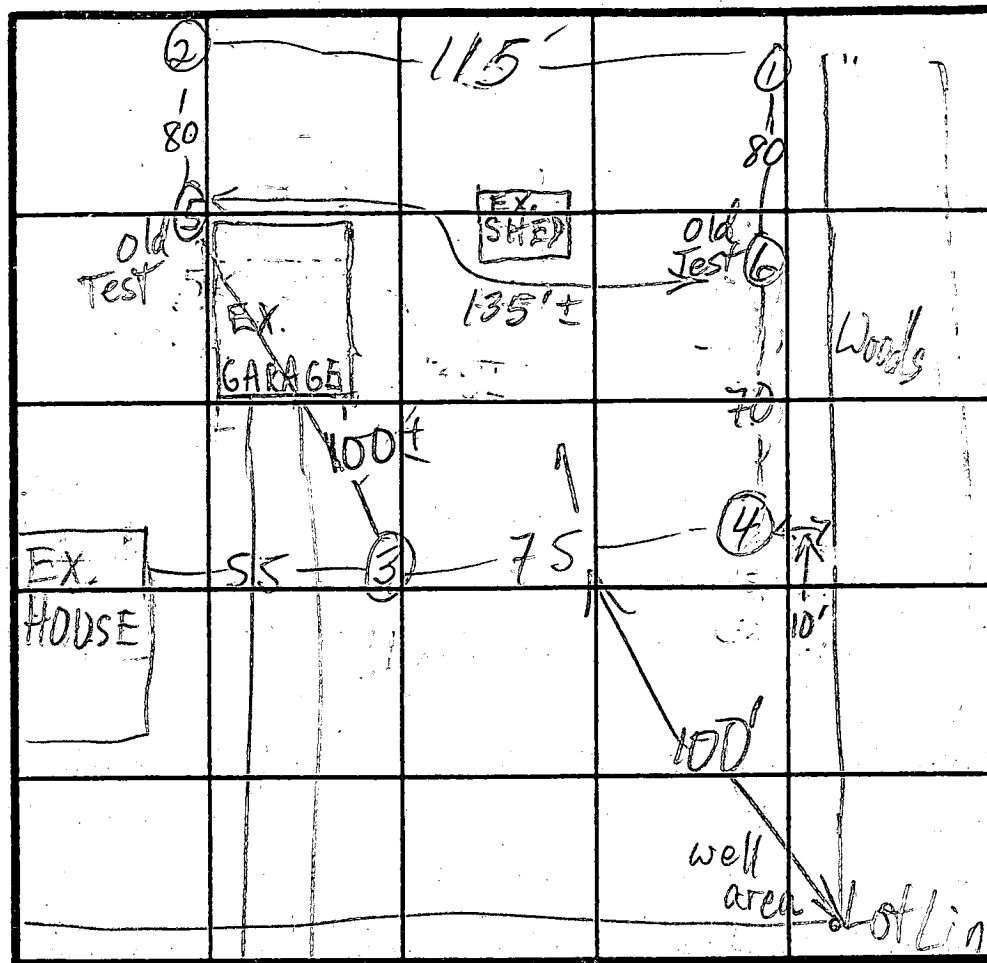

INDICATE NORTH - NAME ADJOINING ROADWAY AS BASE LINE.

① ② H1
⑤ ⑥ L0

$\bar{x} = 7$
180° BR
Enter 3'
Bot 5'

⑤
brn
cl lm
brn
sa lm
30%
frags
Rock Bot

⑥
brn
cl lm
brn
sa lm
w/rotten
RX
@ 7'
sa lm
↓

DATE	TEST NO.	DEPTH	PRE-WET		TEST - 1" DROP		TIME
			START	STOP	START	STOP	
7/9/90	3 S	3'	9:45	9:50	9:50	10:08	14
11/1/90	3 M	7'	10:36	10:37	11:37	10:38	1
	3 V	11	see profile				
	4 S	4'	10:22	10:23	10:23	10:27	4
	4 V	10	sim to ① some large frags w/white decayed rock below 4'				
4/25/90	5 S	3 1/2	11:50	11:56	11:56	12:09	13
	5 V	9	see profile HARD BOT				
	6 S	4	12:05	12:06	12:06	12:07	1
	6 V	13	see profile				

REMARKS 1 V 13 1/2 MOTTLES from 7 1/2 FAIL
2 V 10 50% RX from 2 1/2 FAIL

TYPE OF SOIL HOLES PER PLAT

TESTED BY M. R. Fkin

ALSO PRESENT Owner