

[Menu](#)[Refine Search](#)[GIS](#)[Help](#)

Data Filter: Filter TMP's

[My Filters](#)


Showing 1 of 1

<input type="checkbox"/> <u>Permit #</u>	<u>Status</u>	<u>Record Type Alias</u>	<u>Street #</u>	<u>Street Name</u>	<u>Type</u>	<u>Unit Type</u>	<u>Unit #</u>	<u>City</u>
<input type="checkbox"/> <u>B21002984</u>	Review In Process	Residential Interior Alteration Townhouse Permit	10441	RESORT	RD			ELLICOTT

Page  of 1 [<](#) [>](#)

Howard Popkin

4/ full  
1 1/2

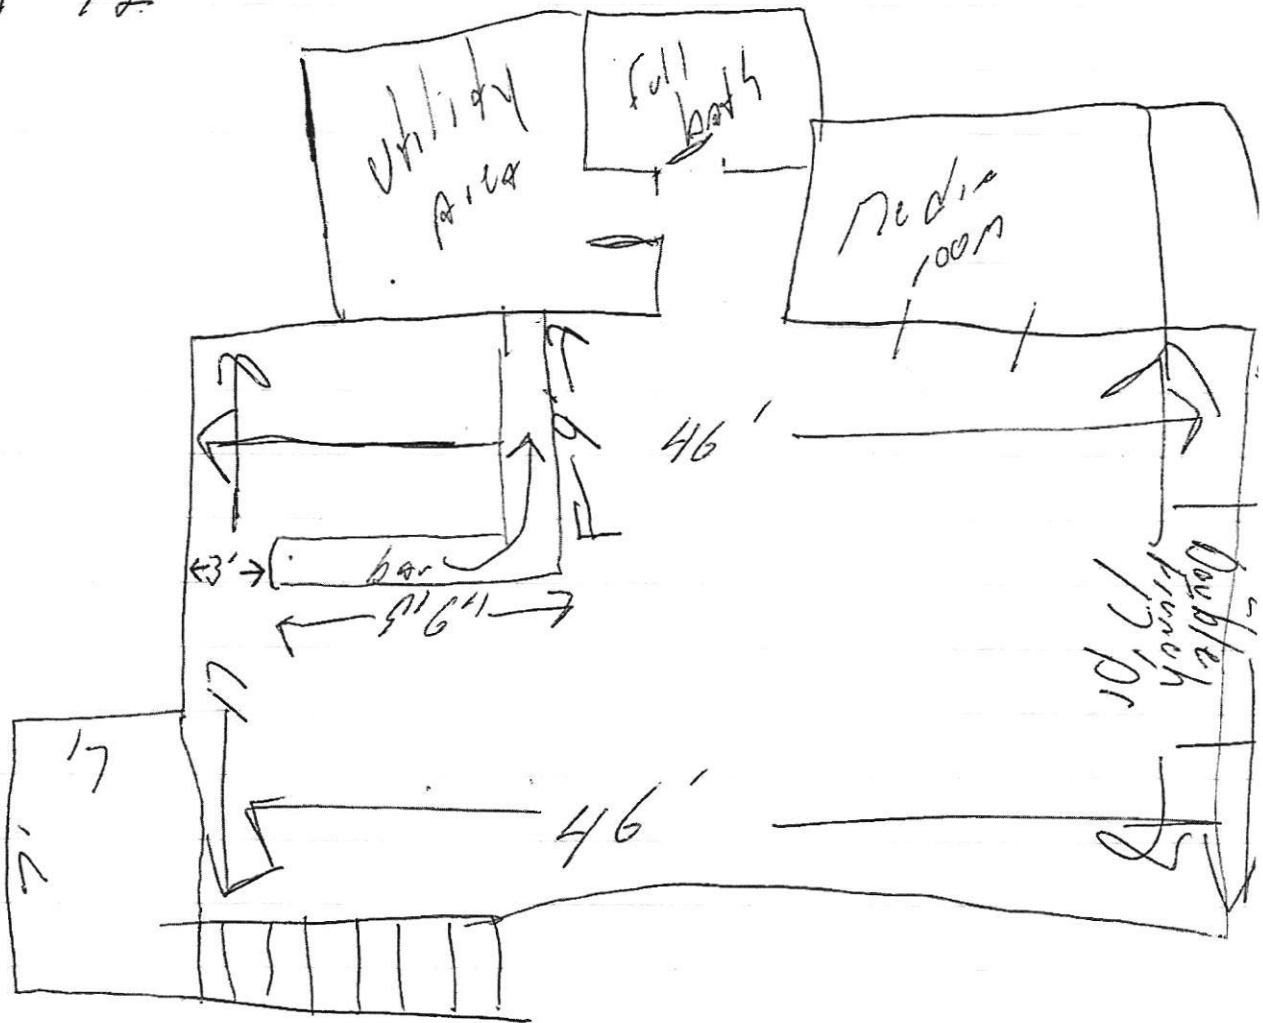

Approved Septic System Plan  
Howard County Health Department  
Dana Bernard 8/17/11  
Signature Date  
B81002984