

RECEIVED

JUL 28 2021

LICENSES & PERMITS
DIVISION

DEAR HOWARD COUNTY PLAN REVIEW,


I WOULD TO AMEND PERMIT # B21000164

~~REVIEW~~
ADD ONE FULL BATH OVER ADDITION
REMODEL EXISTING SITTING RM.
TO INCLUDE A LAUNDRY RM
AND CLOSET

THANK YOU.

JOHN KOJWLSKI
301-977-3652

Approved Septic System Plan
Howard County Health Department
Bernard, D 8-10-21
Signature Date

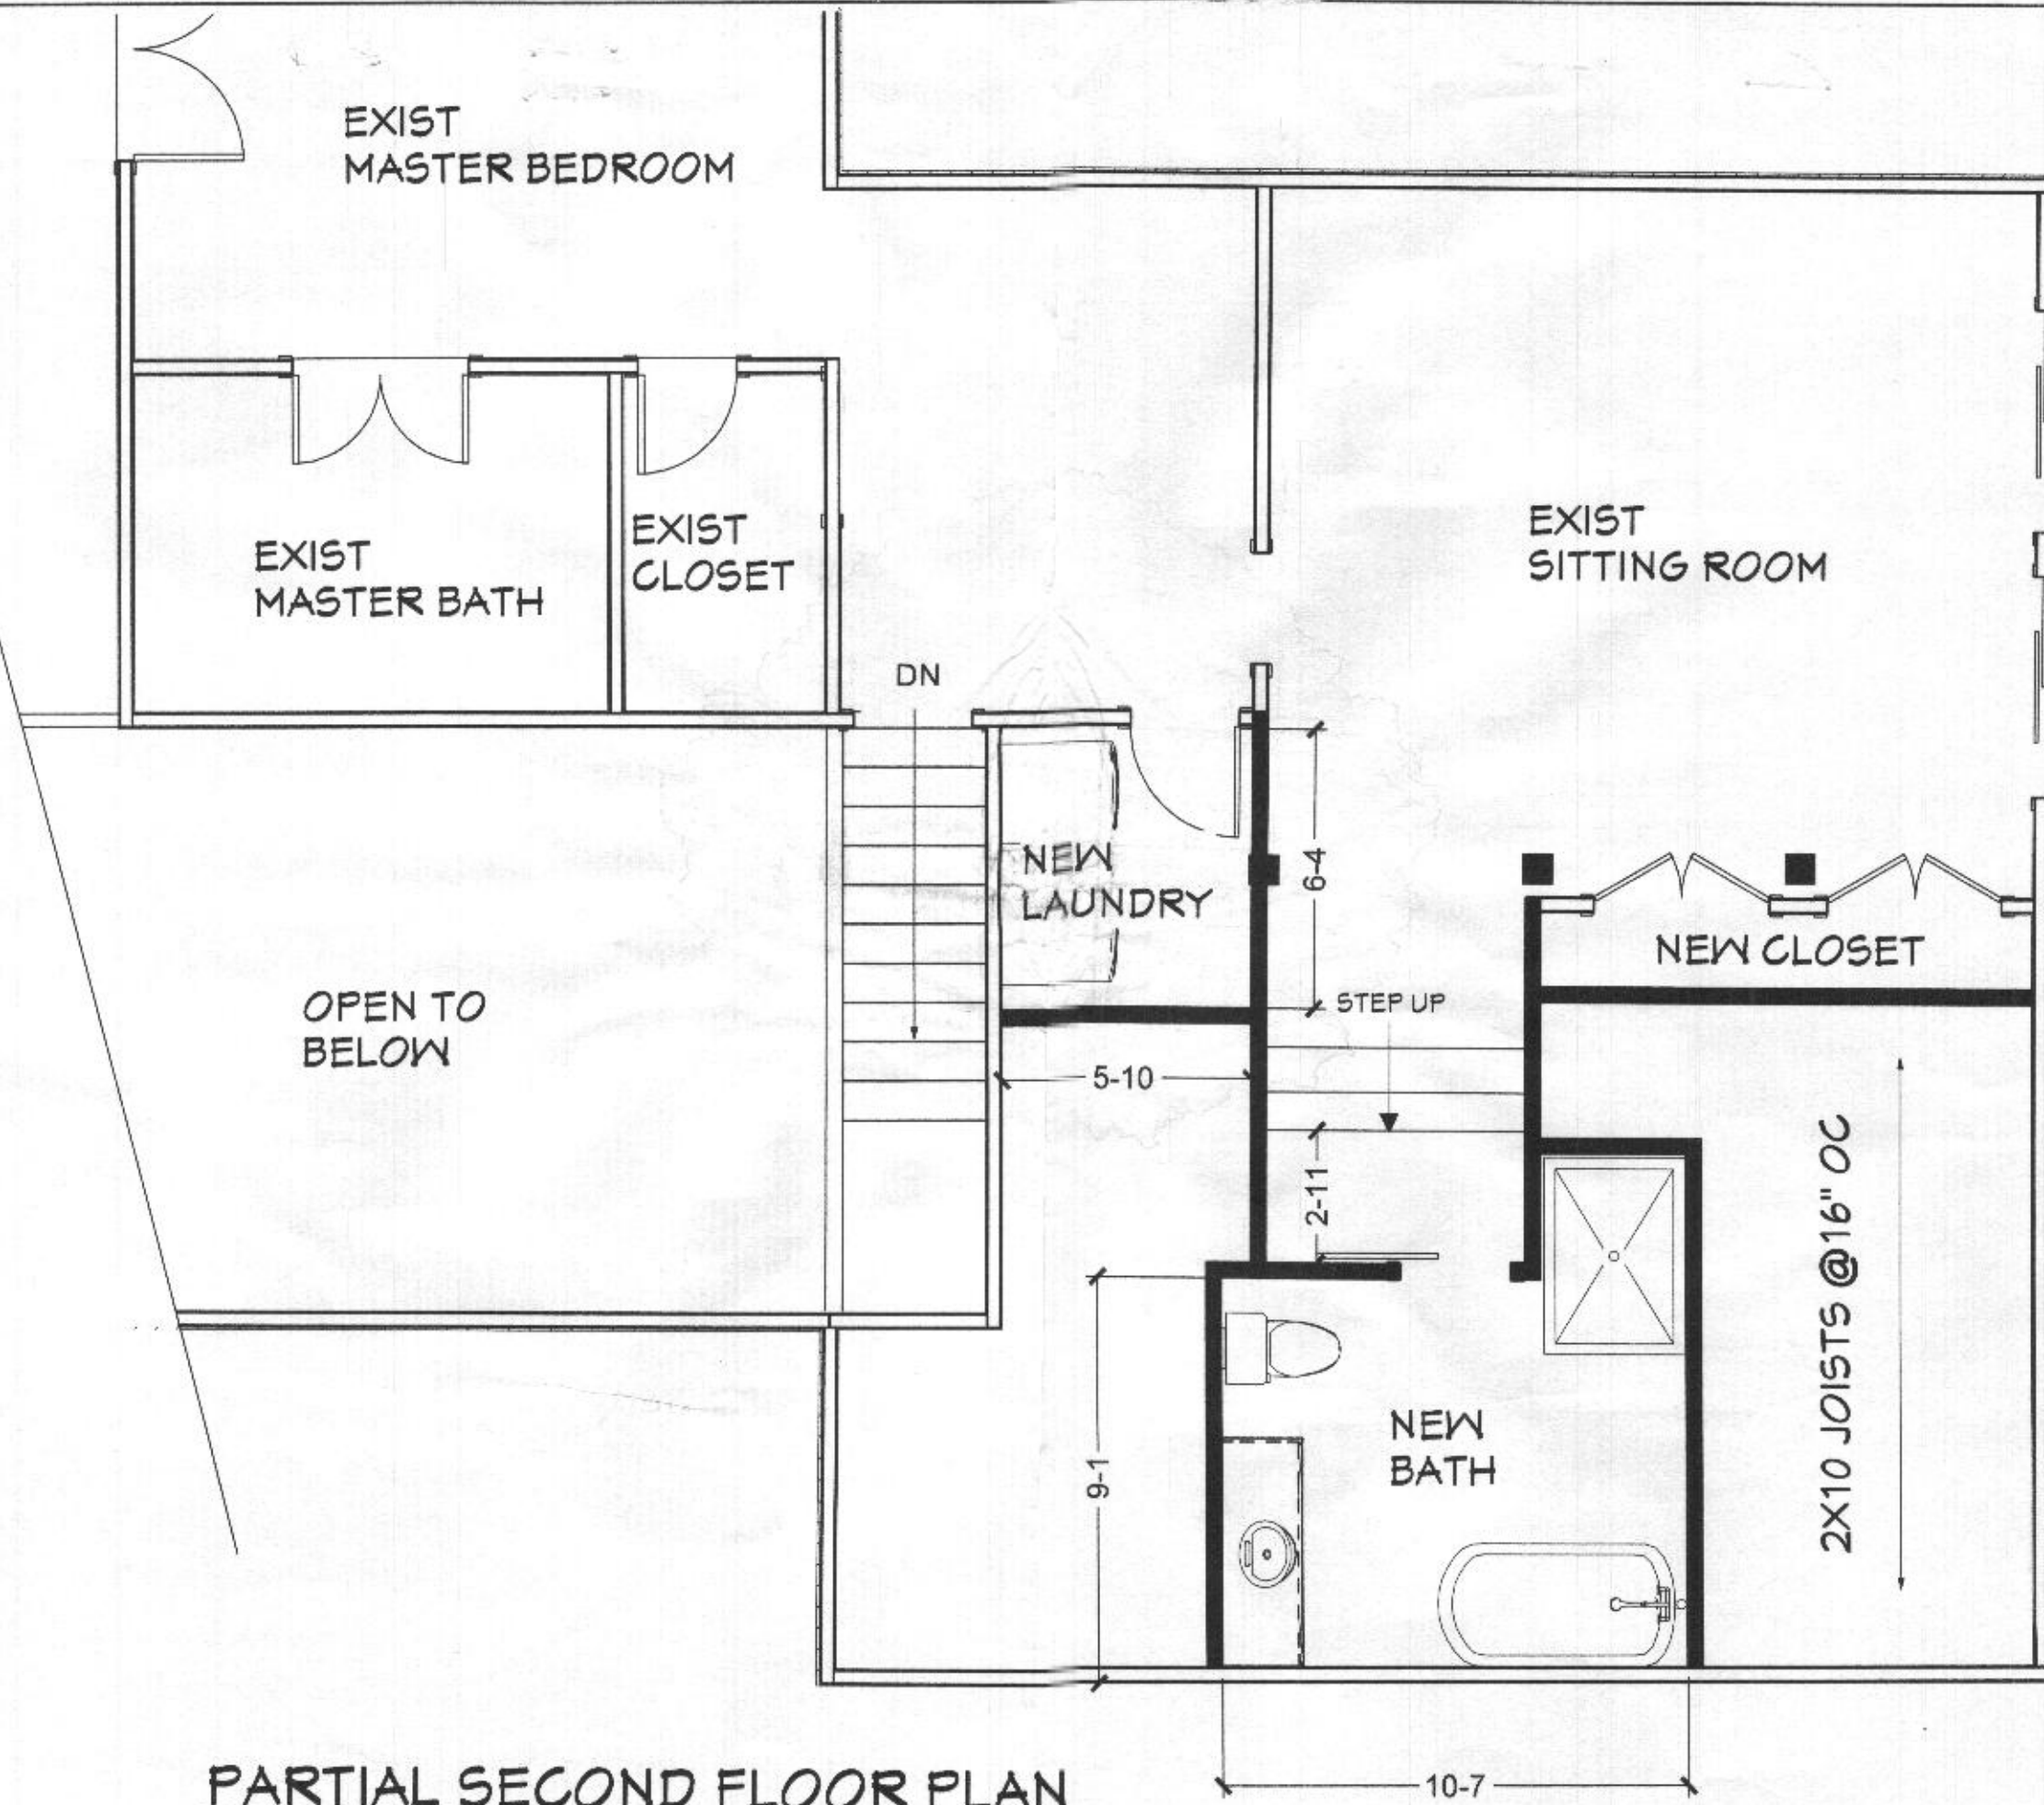

PARTIAL SECOND FLOOR PLAN

1/4" = 1'-0"

SECOND FLOOR PLAN

1/4" = 1'-0"

13080 WILLIAMFIELD DR
ELLICOTT CITY MD

JDK DESIGN
LAYTONSVILLE MI
301-977-3652

SHEET
1 of 1