

RECEIVED
HOWARD COUNTY
HEALTH DEPT.
CT 34 7 52 AM '88
ENVIRONMENTAL
HEALTH
Friday
3-13-88
9:30

APPLICATION

PERCOLATION TESTING

A 09342

HOWARD COUNTY HEALTH DEPARTMENT
BUREAU OF ENVIRONMENTAL HEALTH
P.O. BOX 476 ELLICOTT CITY, MARYLAND 21143
TELEPHONE 481-9933

DISTRICT

DATE

TO THE COUNTY HEALTH OFFICER
ELLICOTT CITY, MARYLAND

I HEREBY APPLY FOR THE NECESSARY TEST IN ORDER TO CONSTRUCT OR RECONSTRUCT A SEWAGE DISPOSAL SYSTEM

PROPERTY OWNER Robert Weickgenannt

ADDRESS 3929 Fully Quarter Rd. PHONE 988-9393

PROSPECTIVE BUYER

(same) 3907 BRIGHTWAY
(") WEIKTON W. VA. 304-748-1115

PROPERTY LOCATION

2625

SUBDIVISION

THOMPSON DRIVE

LOT NO.

Parcel
#179

ROAD AND DESCRIPTION

REPSRC (TESTED) 2X'S PRIOR - UNSUCCESS

TAX MAP

16

PARCEL #

179

SIZE OF LOT

TYPE BLDG

(SINGLE FAMILY DWELLING OR COMMERCIAL)

THE SYSTEM INSTALLED UNDER THIS APPLICATION IS ACCEPTABLE ONLY UNTIL PUBLIC FACILITIES BECOME AVAILABLE. I FULLY UNDERSTAND THE
FEE CONNECTED WITH THE FILING OF THIS PERC TEST APPLICATION IS NON-REFUNDABLE UNDER ANY CIRCUMSTANCES. I ALSO AGREE TO COMPLY
WITH ALL M.O.S.H.A. REQUIREMENTS IN TESTING THIS LOT.

(SIGNATURE OF APPLICANT)

APPROVED BY

Carelin

FOR

SEWER SYSTEM

DATE

2/10/87

REJECTED BY

FOR

DATE

HOLD PENDING FURTHER TESTS

DATE

REASONS FOR REJECTION OR HOLDING

3-13-88 Percolation test - failed for Certified hole 5' deep

BLDG. PERMIT SIGNED

AND RETURNED 1-20-88

See BP 1642

THIS IS NOT A PERMIT

REMARKS


Smallen Eng 154

2. 504582

ALSO PRESENT

DATE	TEST NO	DEPTH	START	STOP	TEST - 1" DROP	TIME
3/19/82	A1S	18'-4"	10:05	10:35	UNIFORM SOIL BELOW 3"	
	A2S	12'-4"	10:08	10:12	UNIFORM SOIL BELOW 28"	10 MIN
	A3S	10'-	10:16	10:26	UNIFORM SOIL BELOW 23"	10 MIN
	A4S	14'-	10:55	10:59	UNIFORM SOIL BELOW 23"	10 MIN
	A4S	18'-	10:59	11:02	UNIFORM SOIL BELOW 23"	10 MIN
	A4V	9'-2"	10:44	10:44	UNIFORM SOIL BELOW 39"	10 MIN
	A1S	44"	11:15	11:19	UNIFORM SOIL BELOW 40"	10 MIN
	A5S	44"	11:15	11:19	UNIFORM SOIL BELOW 40"	10 MIN

124"	40% clay 50% sand 10% 4-10% clay 15-25% coarse fms
82"	yellow sandy loam mix med 10-15% fms but not in soil moist 1967 test

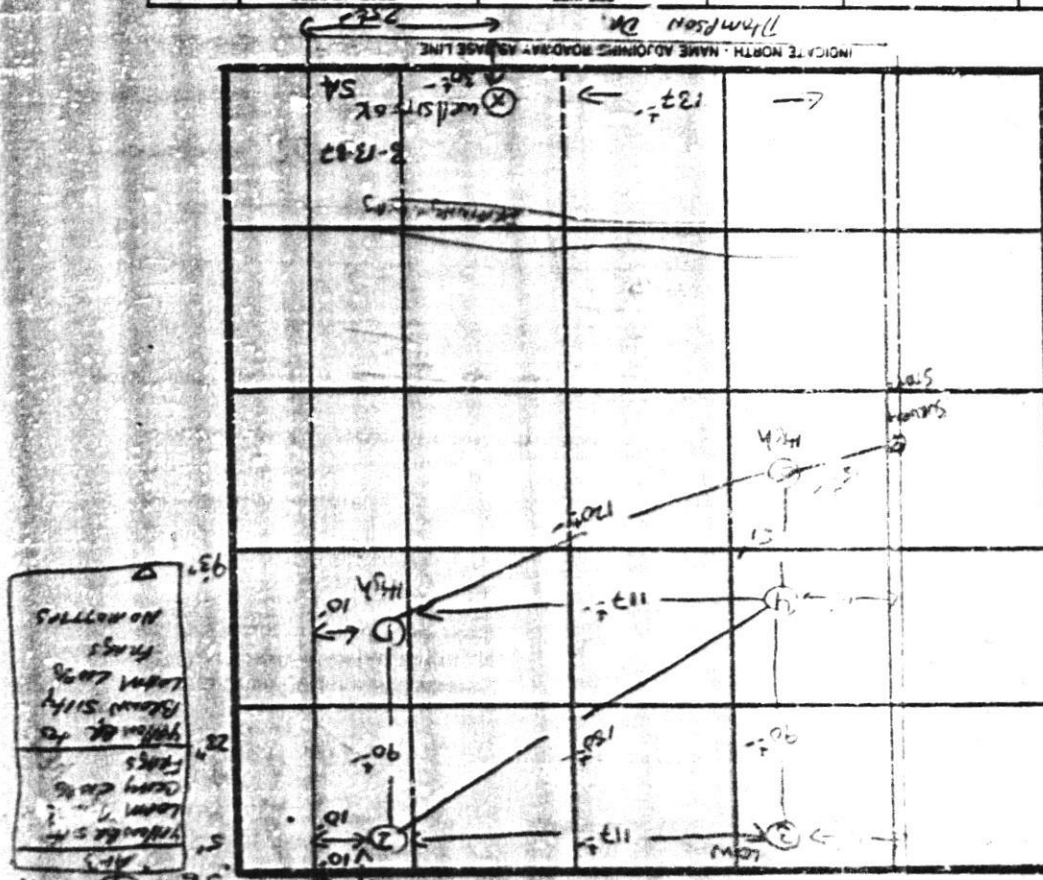[illegible]

A-09542

John Burkhead

90 Century

Highway Realty


9090 Chevrolet

E.C.


465-2575

7/2/75	17	3 1/2	952	957	957	1009	12
	8	3 1/2	1002	1016	1016	1046	FAILED 2ND INCH
	9	3 1/2	1002	1008	1008	1016	8
	9A	10 1/2	UNDER GROUND 10 FT FROM GRADE				
	8A	9 1/2	1021	1025	1025	1028	3
7/2/75	7A	8	1023	1026	1026	1030	4
	9B	8	1037	1040	1040	1043	3
	8B	5	1054	1059	1059	1110	11
	8C	12	UNDER GROUND WATER			COMES IN	11 FT
	7B	12	UNDER GROUND WATER			COMES IN	11 1/2 FT

Presented To: McGinty (Realtor)
Ben Burkhead Buyer

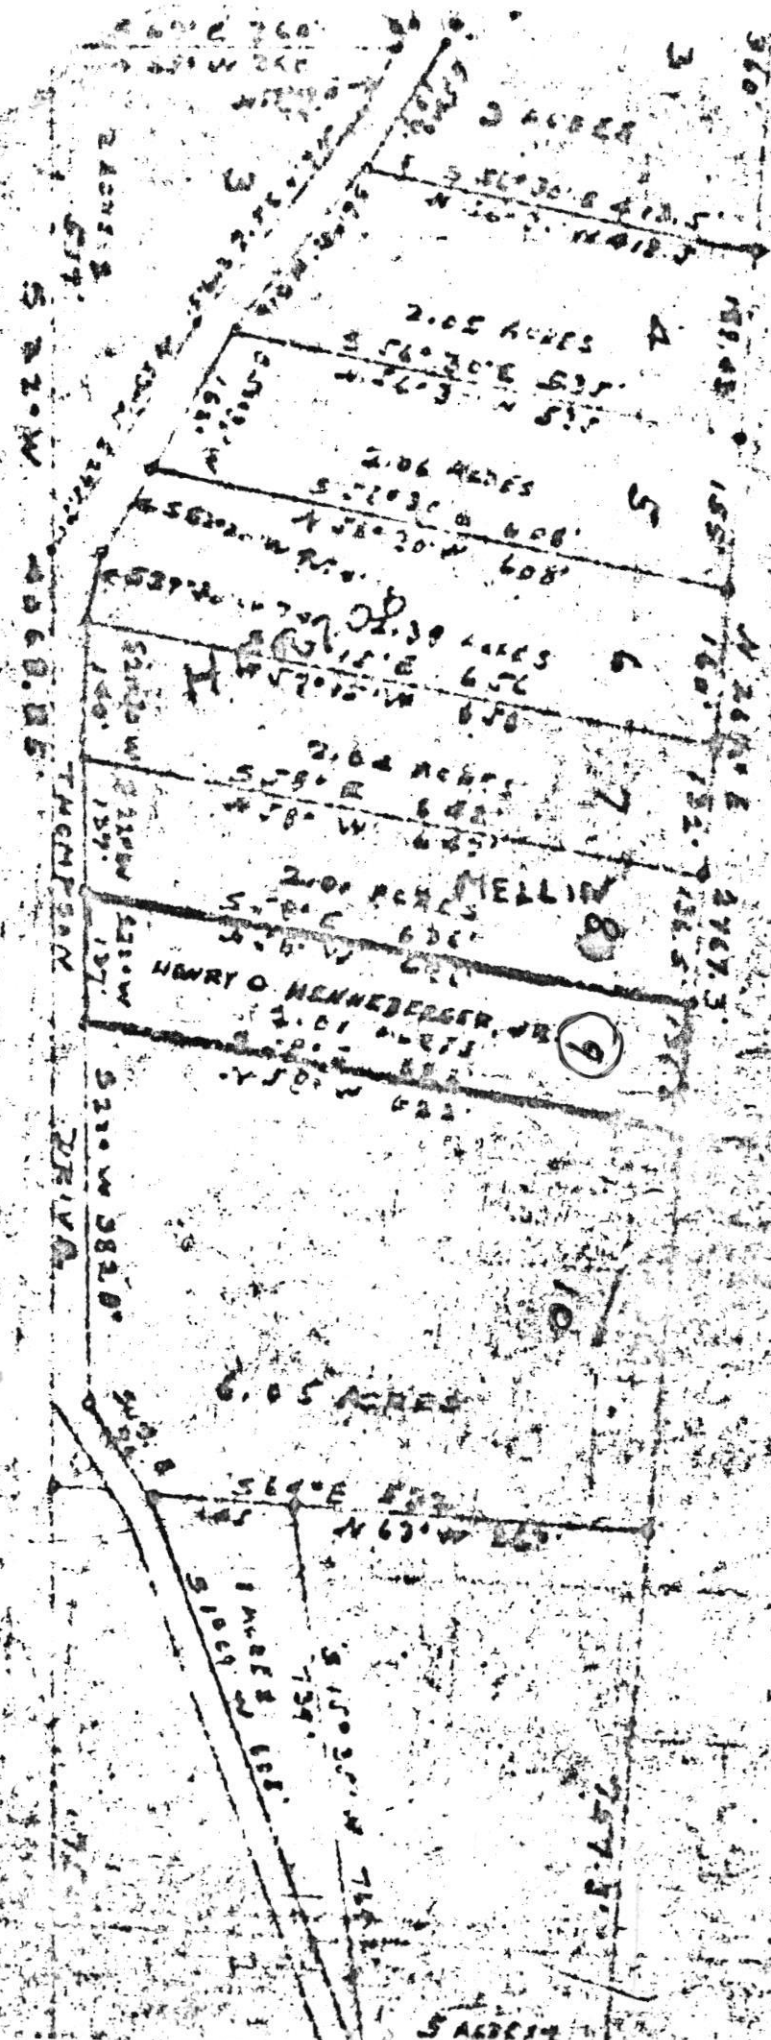

PROPERTY OF HARVEY THOMPSON SITUATE IN THE
3RD ELEC. N. DISTRICT, CLAY COUNTY, MO.

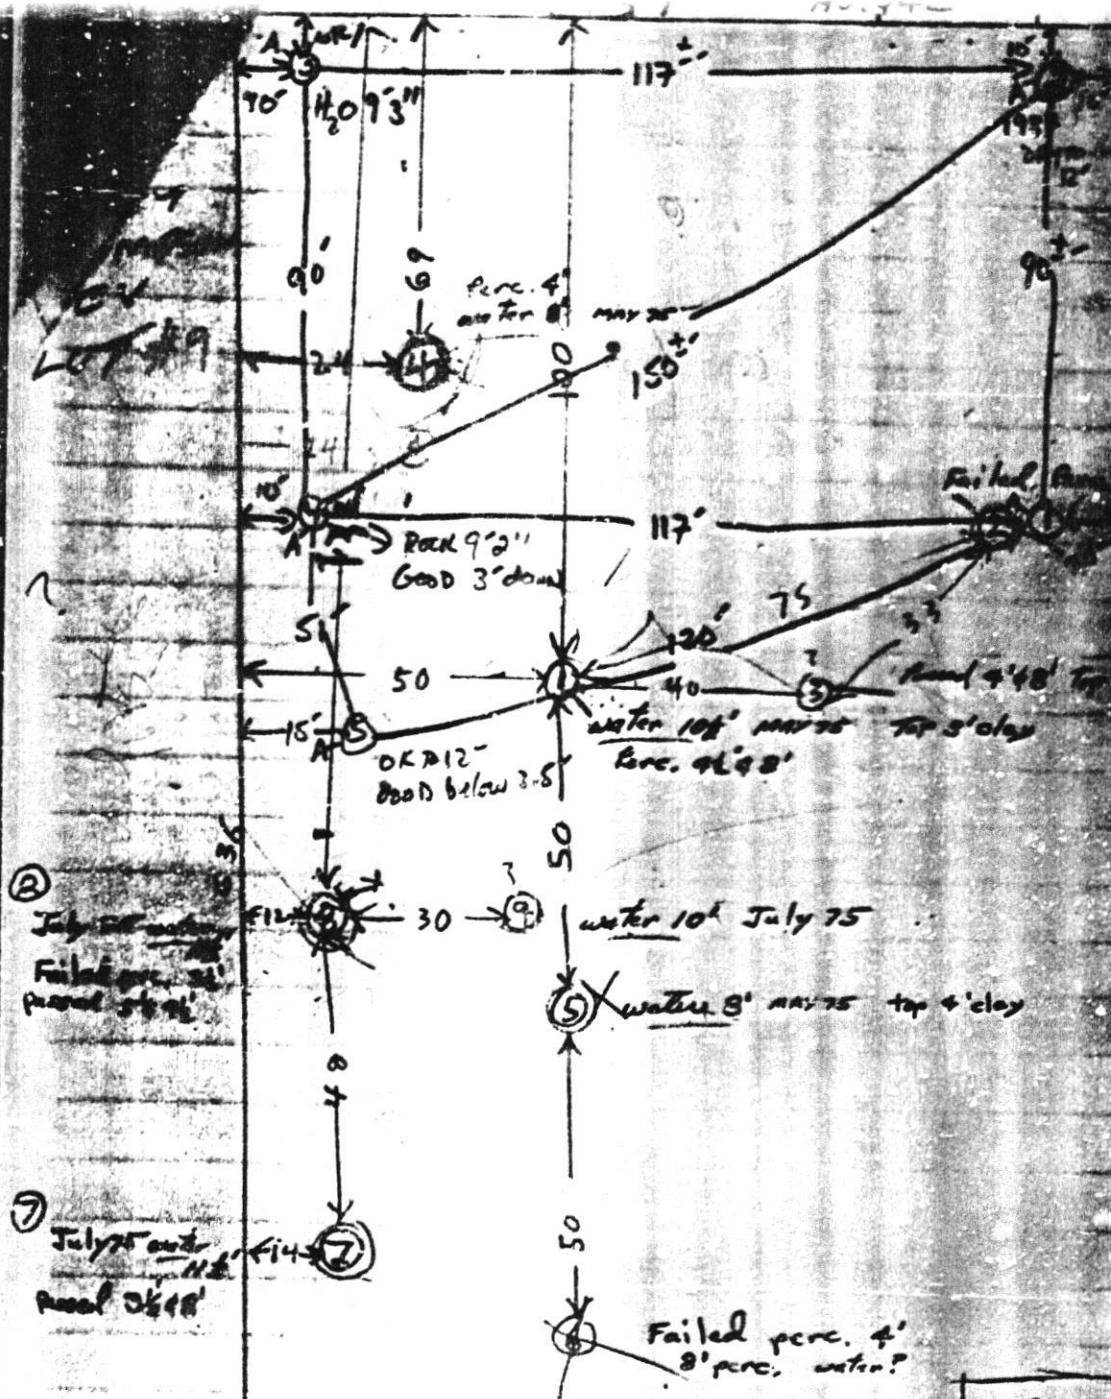

3/13/82 S. Abel
A-#

Δ WATER TABLE
XING 1975-1976
2' CW

A09342


new road (Bulwer, Bulwer)
1-10-85
DP 5790C

new road
1-10-85
DP 5790C

right 16435
1-20-88

6/6/87
CWA

new road
1-10-85

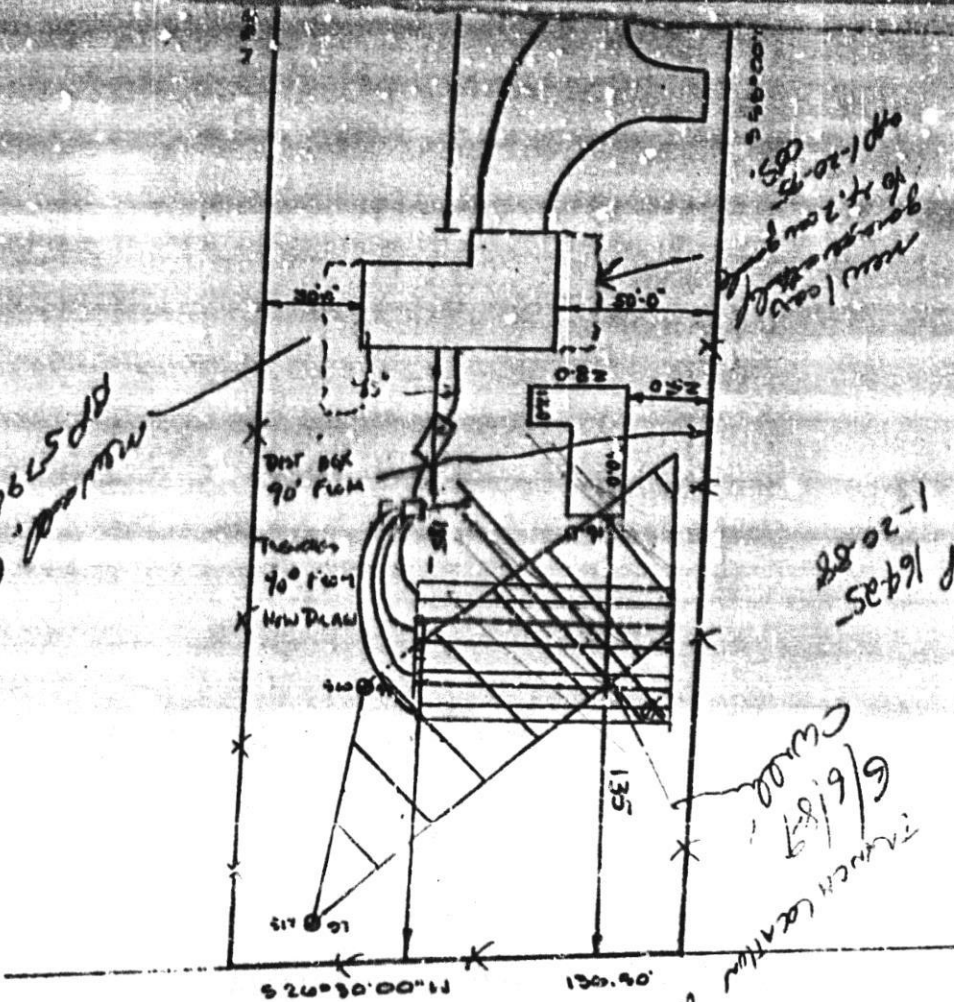

2625-10000
RT. 10000

A 59392



APPLICATION

A 09342

P _____

SEWAGE DISPOSAL TESTING

STATE OF MARYLAND - DEPARTMENT OF HEALTH AND MENTAL HYGIENE

HOWARD COUNTY HEALTH DEPARTMENT
ENVIRONMENTAL HEALTH SERVICESP. O. BOX 476, ELLICOTT CITY, MARYLAND 21043
TELEPHONE: 465-5000, EXT. 356

DISTRICT _____

DATE _____

TO: THE COUNTY HEALTH OFFICER
ELLICOTT CITY, MARYLANDI, HEREBY, APPLY FOR THE NECESSARY TEST IN ORDER TO CONSTRUCT (OR RECONSTRUCT) A SEWAGE
DISPOSAL SYSTEM. OWNER BEN BUIKSAPROPERTY OWNER DAVID C BLACK BuyerADDRESS 9370 CEDER LANE COLUMBIA PHONE 596 6119

PROPERTY LOCATION:

SUBDIVISION H. THOMPSON LOT NO. 9

ROAD AND DESCRIPTION _____

SIZE OF LOT _____ TYPE BLDG. _____

NUMBER OF BEDROOMS _____

IF NOT SINGLE RESIDENCE DESCRIBE _____

THE SYSTEM INSTALLED UNDER THIS APPLICATION IS ACCEPTABLE ONLY UNTIL PUBLIC
FACILITIES BECOME AVAILABLE.

SIGNATURE OF APPLICANT _____

APPROVED BY _____ FOR _____ DATE _____

(KIND OF SYSTEM)

REJECTED BY Frank Skinner FOR any DATE 7/24/81


(KIND OF SYSTEM)

HOLD PENDING FURTHER TESTS _____ DATE _____

REASONS FOR REJECTION OR HOLDING 5/7/75 - HOLD REVIEW UNDERGROUND WATER SEEN RH 5/12/75HELD FOR REVIEW WITH DM. & REJECTED 7/2/75 HOLD FOR
REVIEW RH & RT. 7/2/75 Held for Review with FF. No Decision Must consult
with DM, RH.

THIS IS NOT A PERMIT

137

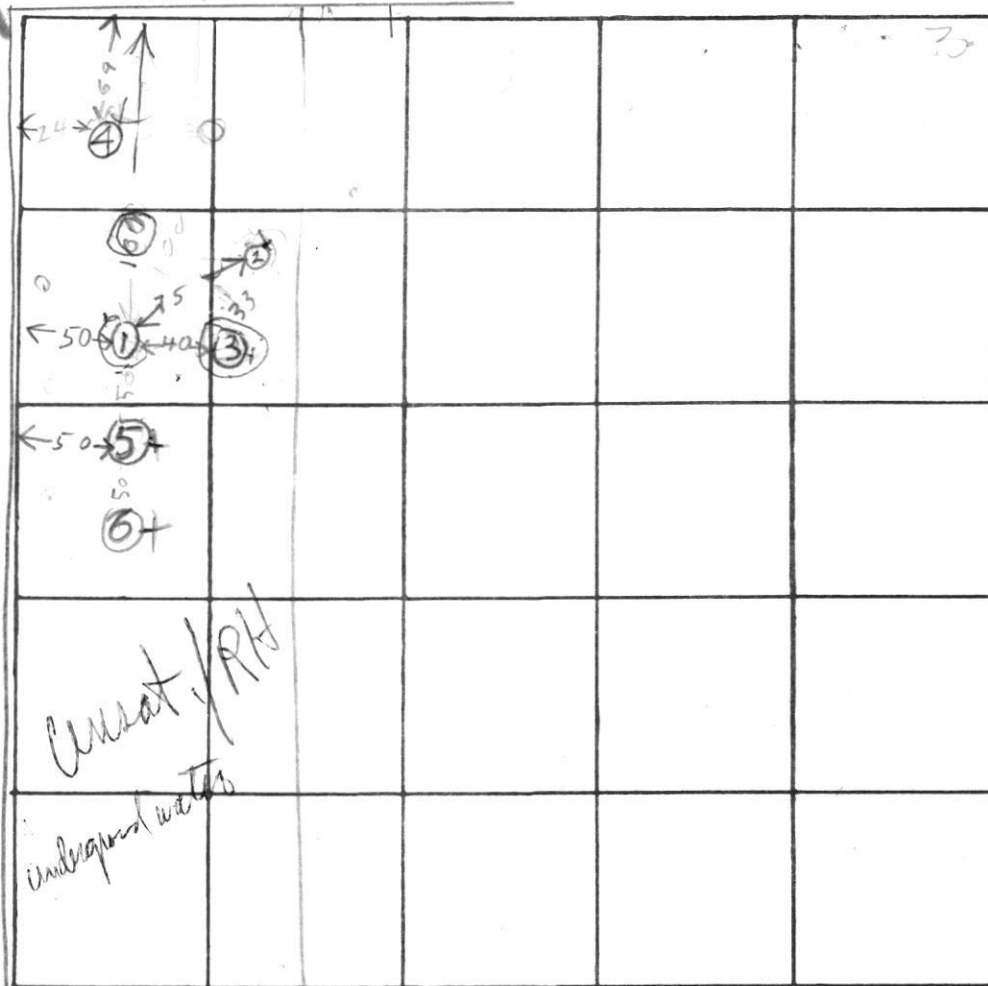

INDICATE NORTH. NAME ADJOINING ROADWAY AS BASE LINE

LOT 15
ALMOST LEVEL
ELEVATION

4 TOR 144

THOMPSON DRIVE

DATE	TEST NO.	DEPTH	PRE-WET		TEST - 1" DROP		TIME
			START	STOP	START	STOP	
5/7/75	1	4 1/2	1004	1010	1010	1016	6
	1A	8	1006	1014	1014	1022	8
	1B	12 1/2	UNDER GROUND WATER ON 10 1/2 FT FROM GRADE				
	2	8	1020	1145	FAILE TO MAKE 1ST INCH		
	2A	4	1027	1052	1ST INCH	25 MIN	FAIL
	3	8	1106	1108	1108	1112	4
	3A	4	1106	1116	1116	1130	14
	3B	12 1/2	DRY				
	4	4	1111	1113	1113	1115	2
	4A	8 1/2	WATER COMES IN @ FT				
	5	8	WATER @ FT TOP 4 FT CLAY				
REMARKS	HOLE 6	4	202	228	little peris Failed		
5/7/75	6A	8	204	211	211	227	6
TYPE OF SOIL	7B	3 1/2	1052				

TYPE OF SOIL

TESTED BY

B. HODGES

ALSO PRESENT:

BLACK (BUILDER)
MCKINTY
BALTZELL (BACKHOE)

A09342


Lot 9 Thompson Dr.

(Harvey Thompson Prop/30)

2625 T.M.

Ed Geisler

Ed Geisler

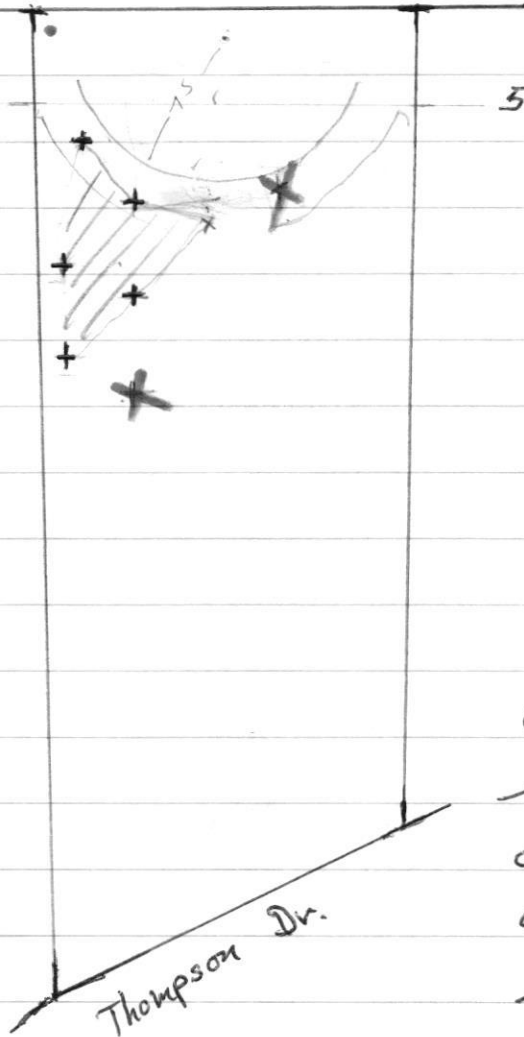


50' B.R.L.

6/9/81 T.C. & Mr. Buksa shaded area acceptable for drain fields. Mr. Buksa informed perc plot required. Copy of this worksheet & topo given to Buksa F.S.

7/24/81 Visited property to check hole locations submitted by Carl Hodgins. Lot was tested at its very highest point, lot drops off to rear & is heavily wooded. Lot not acceptable for drain fields F.S.

7/27/81 T.C. & Ben Buksa & informed him that lot is not acceptable for drain fields. He mentioned possibility of buying higher ground from neighbor Geisler to be able to get good perc. I told him it must be tested in WET SEASON ONLY F.S.

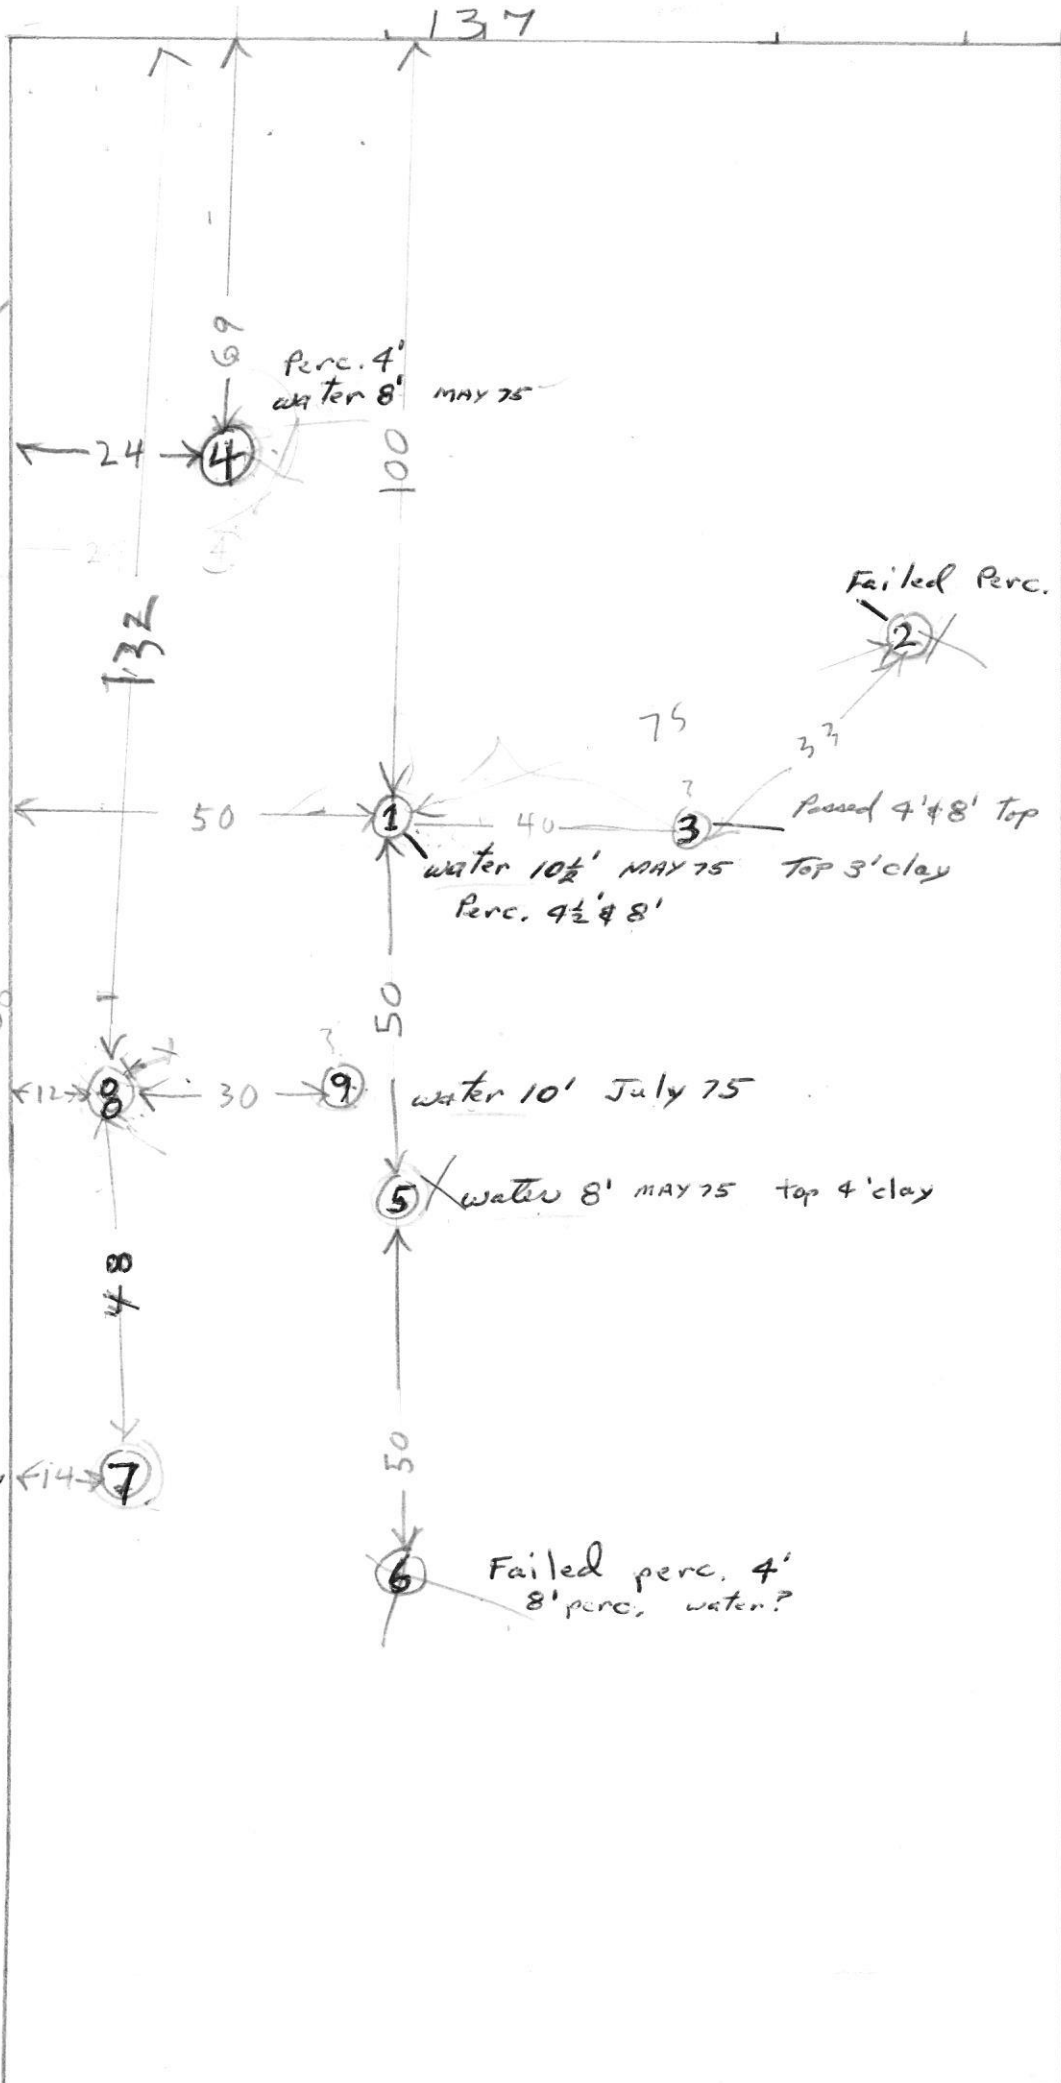

FILE _____ DATE REPORTED _____

PROPERTY OWNER _____

P.O. ADDRESS _____ TELEPHONE _____

DIRECTIONS TO PROPERTY _____

INFORMANT _____


CONDITION FOUND _____

ACTION TAKEN _____

FINAL DISPOSITION _____

A 09342

2625 Thompson Dr.
 wie genannt

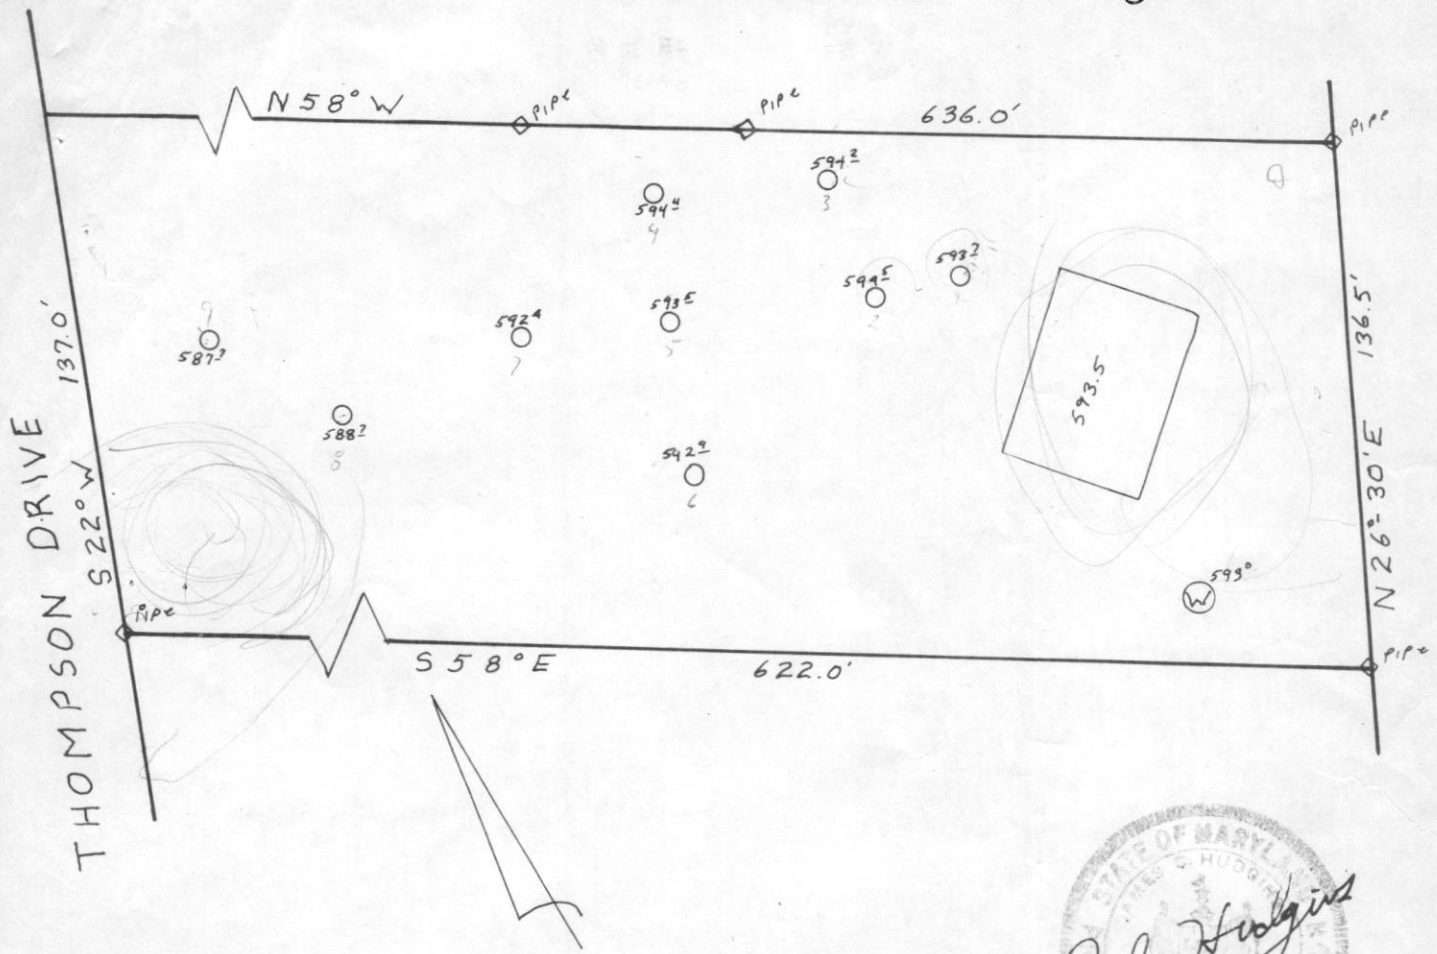


This area designates a private sewage easement of 10,000 square feet as required by the Maryland State Department of Health and Mental Hygiene for individual sewage disposal. Improvements of any nature in this area are restricted until public sewage is available. These easements shall become null and void upon connection to a public sewage system. The County Health Officer shall have the authority to grant variances for encroachments into the private sewage easement. Recordation of a modified sewage easement shall not be necessary. Percolation test holes shown hereon have been field located and shown as "●". The lots shown hereon comply with the minimum ownership width and lot areas as required by the Maryland State Department of Health and Mental Hygiene. Percolation areas and water wells for adjoining lots have been shown where pertinent.

PERCOLATION TEST PLAT
 Property of
 Benedict Buksa, Jr.
 Deed 684/248
 3rd Election District
 Howard County, Maryland
 Scale 1"=50'
 Date 6-24-81

NTT Associates
 Suite 307, Clark Bldg.
 Columbia, MD 21044
 321-0307

For Private Water and Private Sewage Systems

lth Officer _____ Date _____

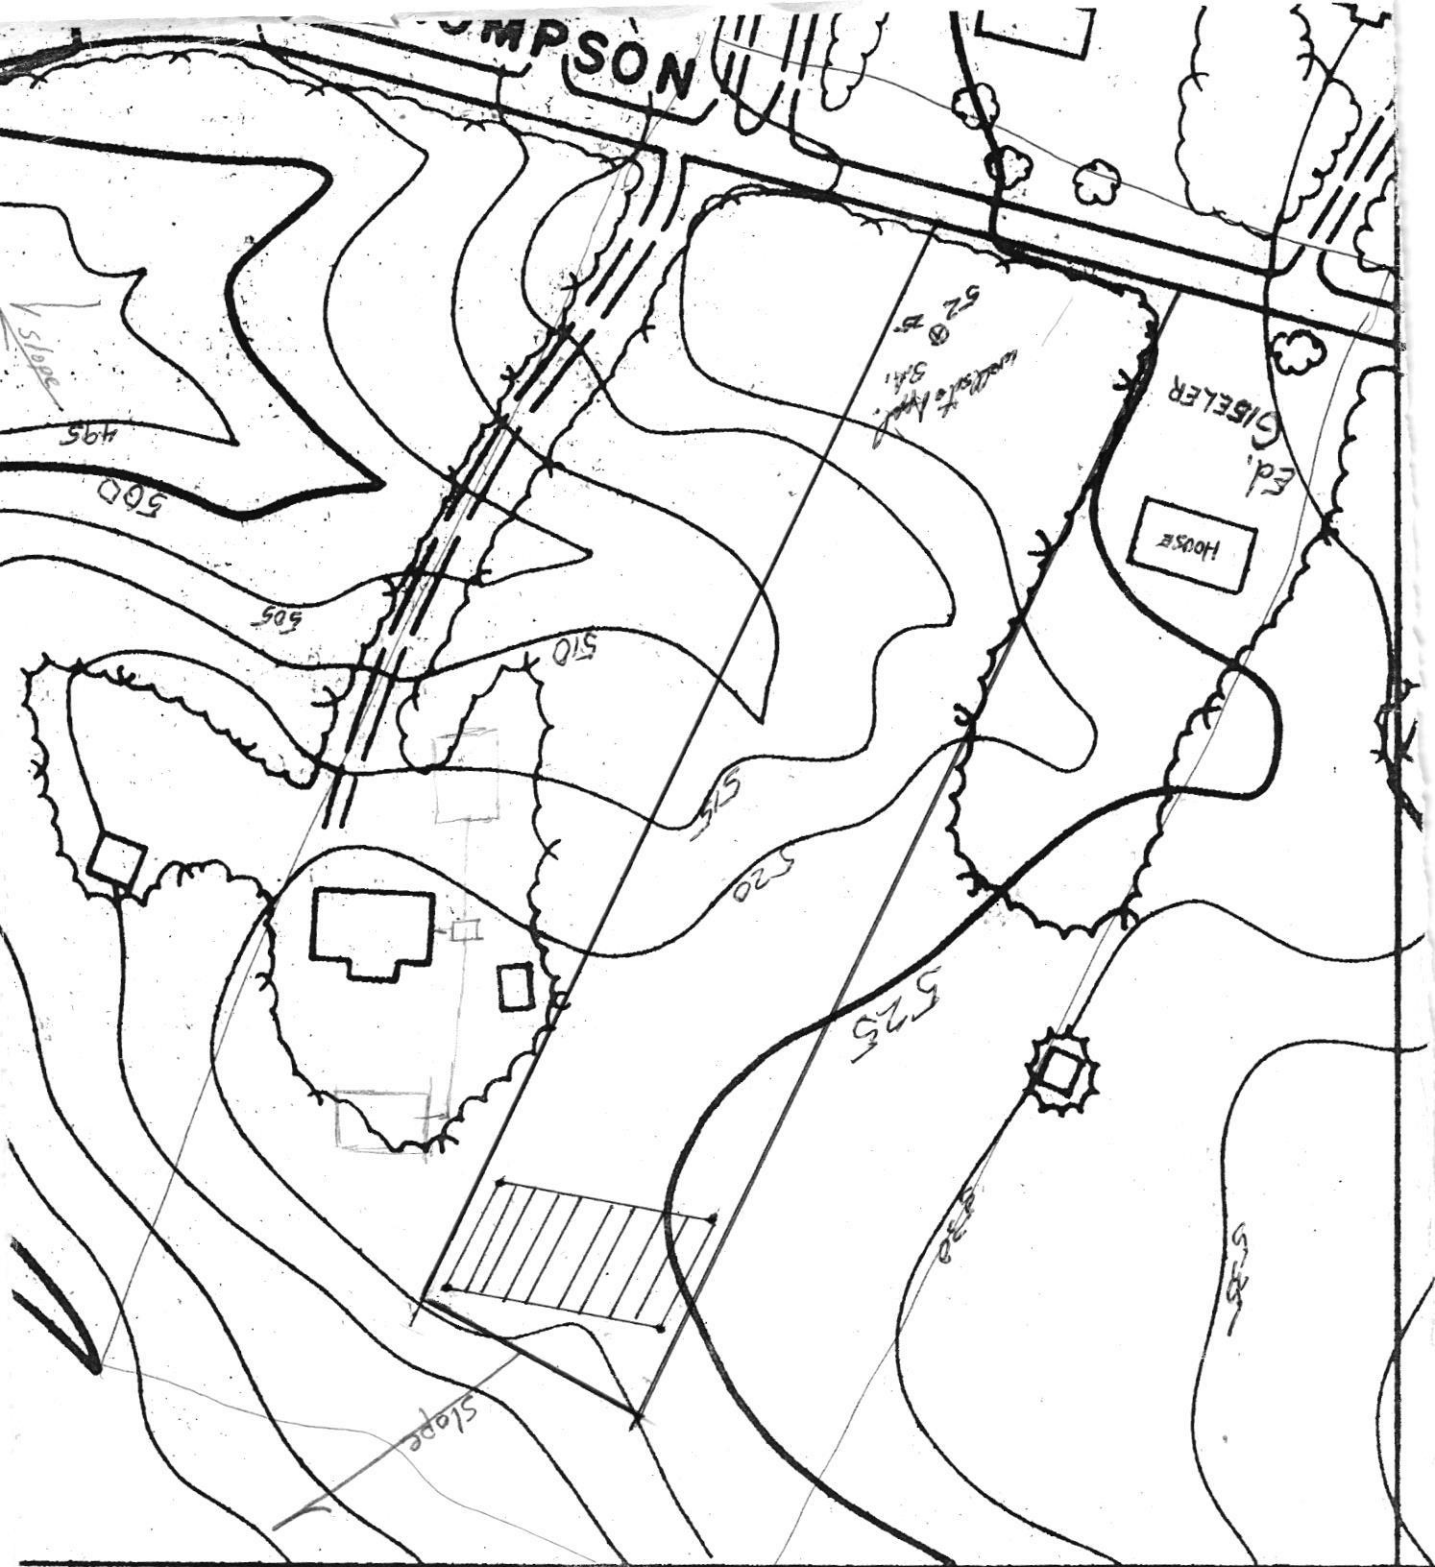

4,000

4-38

TAX MAP 16
 12/179 Harvey Thompson
 LOT 9 2.01 AC
 1684 1248

2 = 1

240

1 200

240,000
80

2300000

155,000
114,000 mths.
38,750,000