

Name: CBI HOMES, LLC
Street Address: 112 S. Main Street
City, State, Zip: Mt. Airy, MD 21771
Date: 1/19/2022

Amendment, Permit # B21004668

Ms. Debbie Whalen
Division of Plan Review
Department of Inspections, Licenses and Permits
Howard County Government
3430 Court House Dr
Ellicott City, MD 21043

Dear Ms. Whalen:

I am requesting to amend Permit # B21004668 at
3004 Skye Meadow Way, W. Friendship, MD 21794 to
add an approximate 924 sq. ft. partially finished basement. They are NOT adding
a bathroom.

Enclosed:

☒ Fee: \$25.00
☒ Plot Plans
☒ Sets of Construction Drawings
Other: _____

If there is anything we can do to assist you, please let me know.

Sincerely,


Name: Pam Walter
Title: Controller
Phone: 410-977-1732
Email: pregester@catonsvillehomes.com

RECEIVED

JAN 26 2022

LICENSES & PERMITS
DIVISION

Amendment Letter

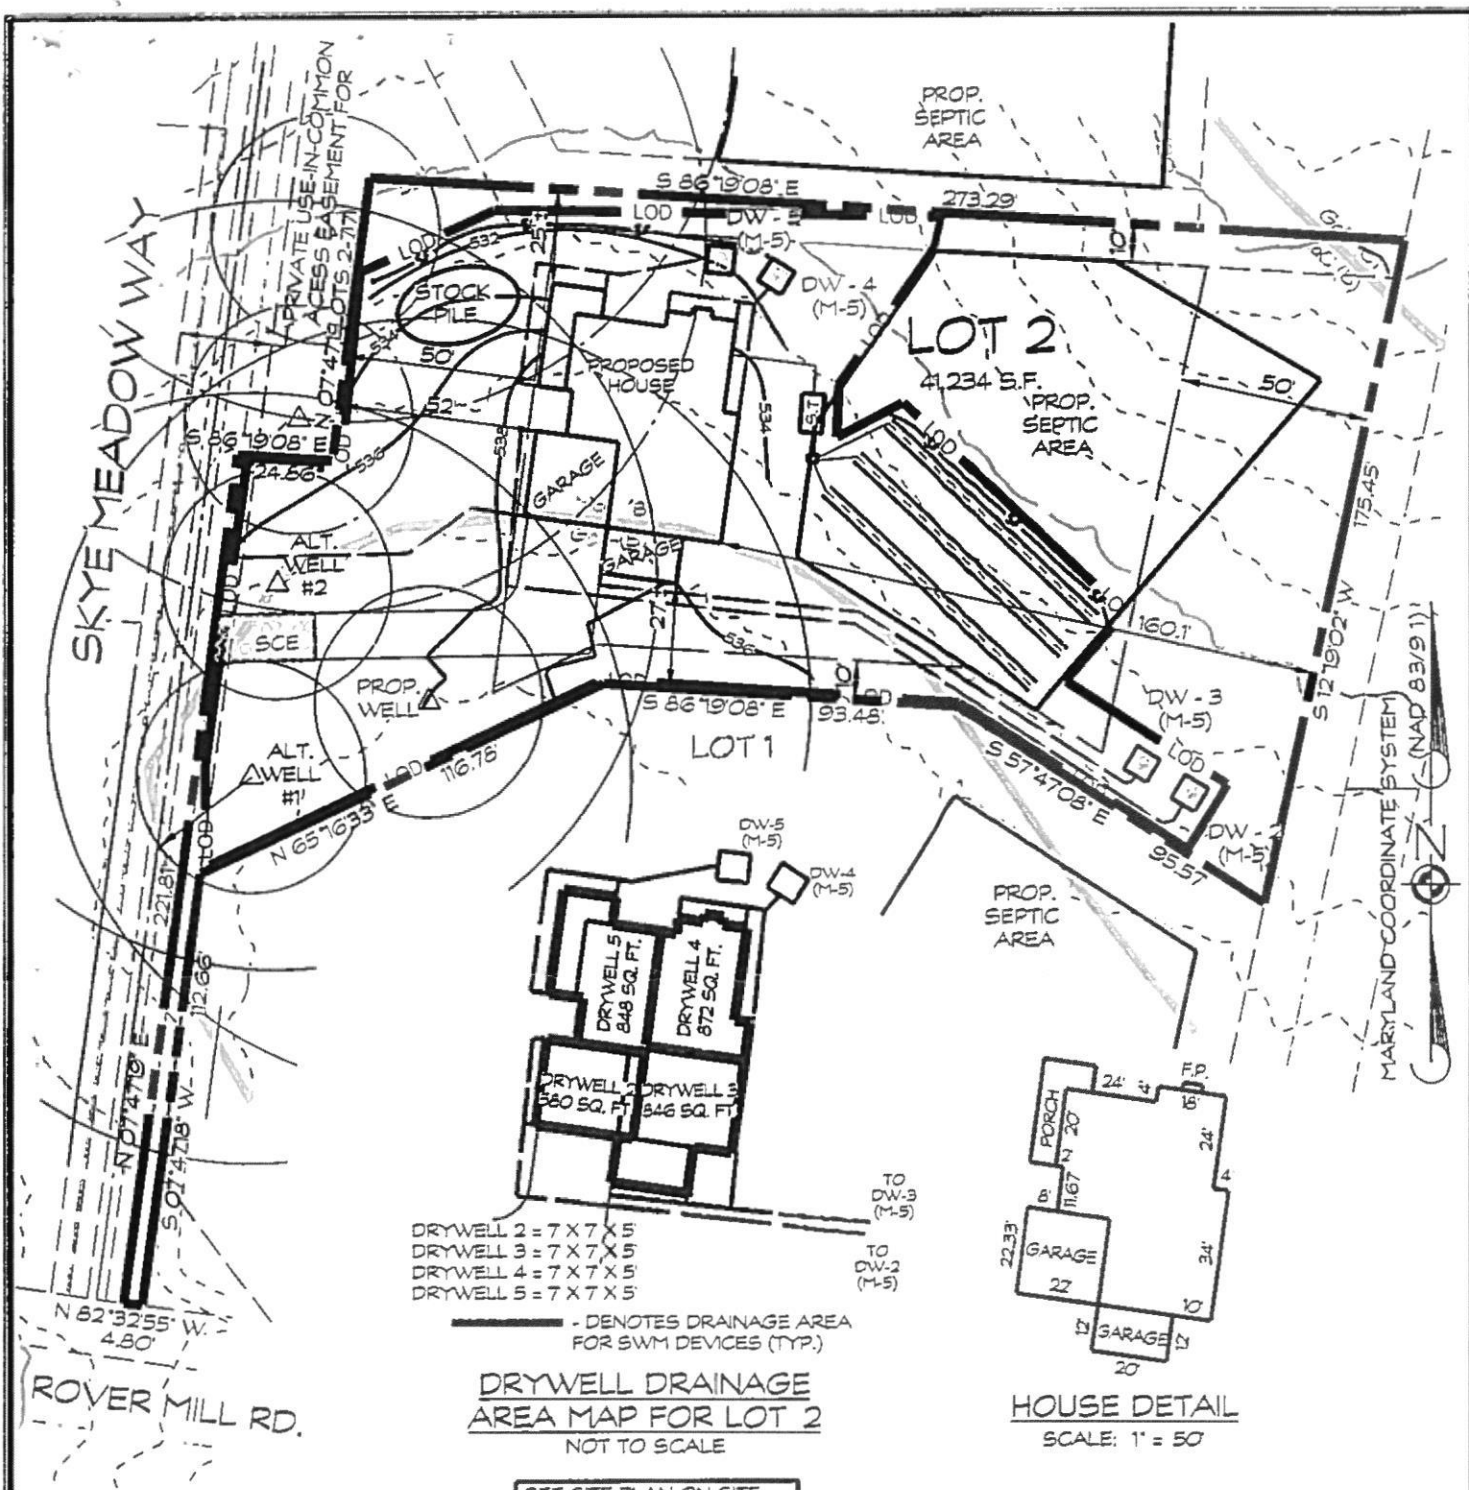

BUILDER TO VERIFY AVAILABILITY OF
BASEMENT SEWER SERVICE PRIOR TO
DWELLING STAKEOUT.

THERE ARE NO WELLS OR SEPTIC SYSTEMS
WITHIN 100' OF THE PROPERTY BOUNDARY
UNLESS OTHERWISE SHOWN HERE ON.

Carroll Land Services, Inc. 12-9-2021
DATE

EXISTING GRADES SHOULD BE FIELD
VERIFIED WHEN HOUSE STAKEOUT IS DONE.


DATE	REVISIONS

PLOT PLAN - LOT 2
ROVER MILL ESTATES
RECORDED IN PLAT NO. 25607
TAX MAP: 15 * GRID: 14 * PARCEL: 169
3rd ELECTION DISTRICT * HOWARD COUNTY, MD



439 East Main Street Westminster, MD 21157-5539
(410) 848-1790 FAX (410) 848-1791

DRAWN BY: BM
DESIGN BY:
REVIEW BY:
DATE: 11/19/21
SCALE: AS SHOWN
JOB NO: 2021303
SHEET: 1

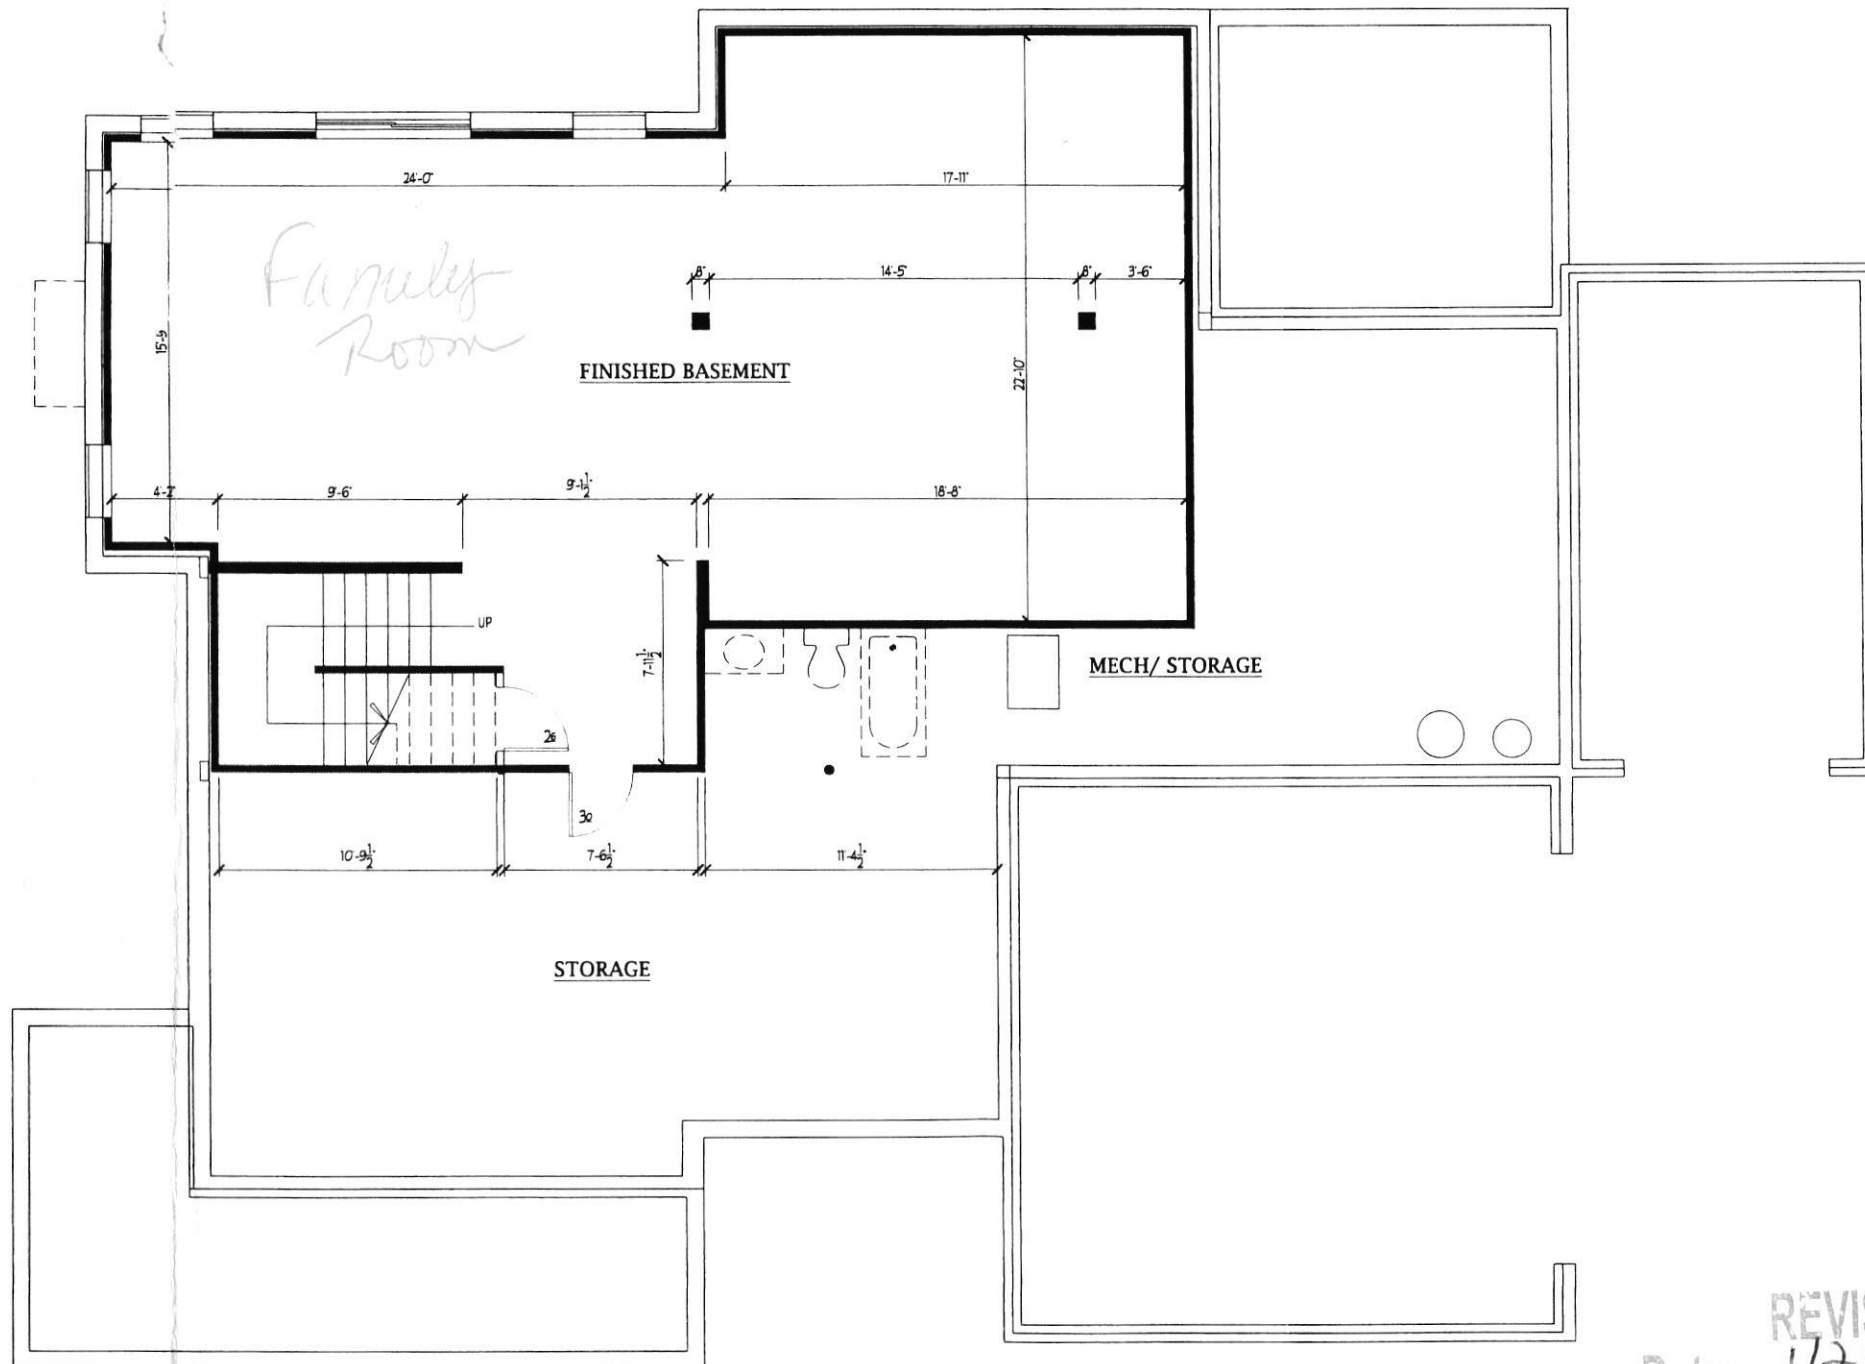

ROVER MILL LOT 2
B 2100 4668

REVISED
Date: 1/26/22
B2100 4668
Comments: ADD Partial finished
Basement to Family Room