



GENERAL PLAN NOTES

- ALL WOOD STUD PARTITIONS NOT DIMENSIONED ARE TO BE 3 1/2" FOR INTERIOR AND 3 1/2" FOR EXTERIOR WALLS UNLESS OTHERWISE NOTED.
- ALL INTERIOR DIMENSIONS ARE TO FACE OF STUDS.
- ALL EXTERIOR DIMENSIONS ARE TO FACE OF STUDS.
- ALL DIMENSIONS GOVERN OVER SCALE.
- ALL SMOKE DETECTORS ARE TO BE WIRED IN SUCH A MANNER THAT ACTIVATION OF ONE WILL ACTIVATE THEM ALL.
- ENCLOSED ACCESSIBLE SPACE UNDER STAIRS SHALL HAVE WALLS AND CEILING PROTECTED OR ENCLOSED WITH 1/2" GYPSUM BOARD.
- ALL WINDOWS ARE NOTED IN FEET + INCHES AS MEASURED FROM CASH TO SASH.
- REFER TO ELEVATIONS FOR WINDOW HEAD HEIGHTS.
- ALL DOORS ARE TO BE 6' 8" UNLESS OTHERWISE NOTED.
- WALKER ALWAYS TO BE ON LEFT SIDE OF DOOR.
- DISHWASHER ALWAYS TO BE ON RIGHT SIDE OF SINK.

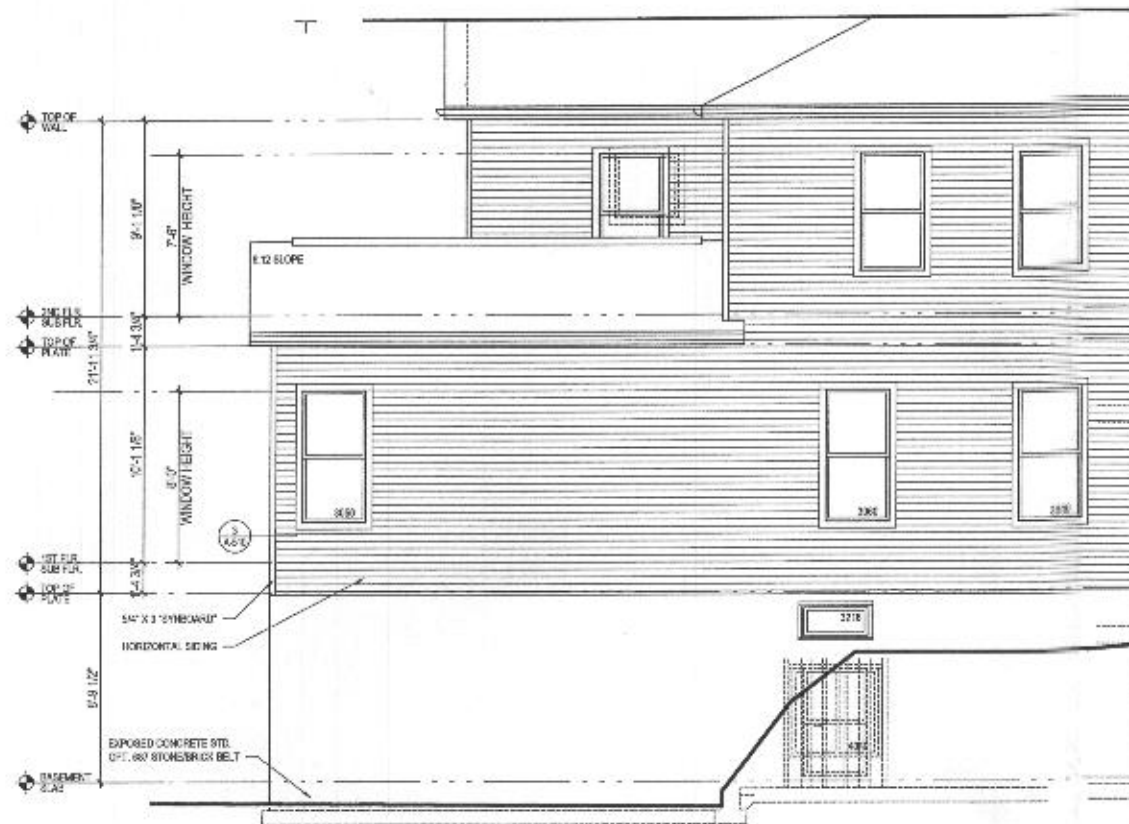


5 PART. LEFT ELEV.
A-407 SCALE 1/4"=1'-0"

w/ OPT. 263073 MULTI-GEN. SUITE
w/ COVD OUTDOOR LIVING @ WALKOUT CONDITION

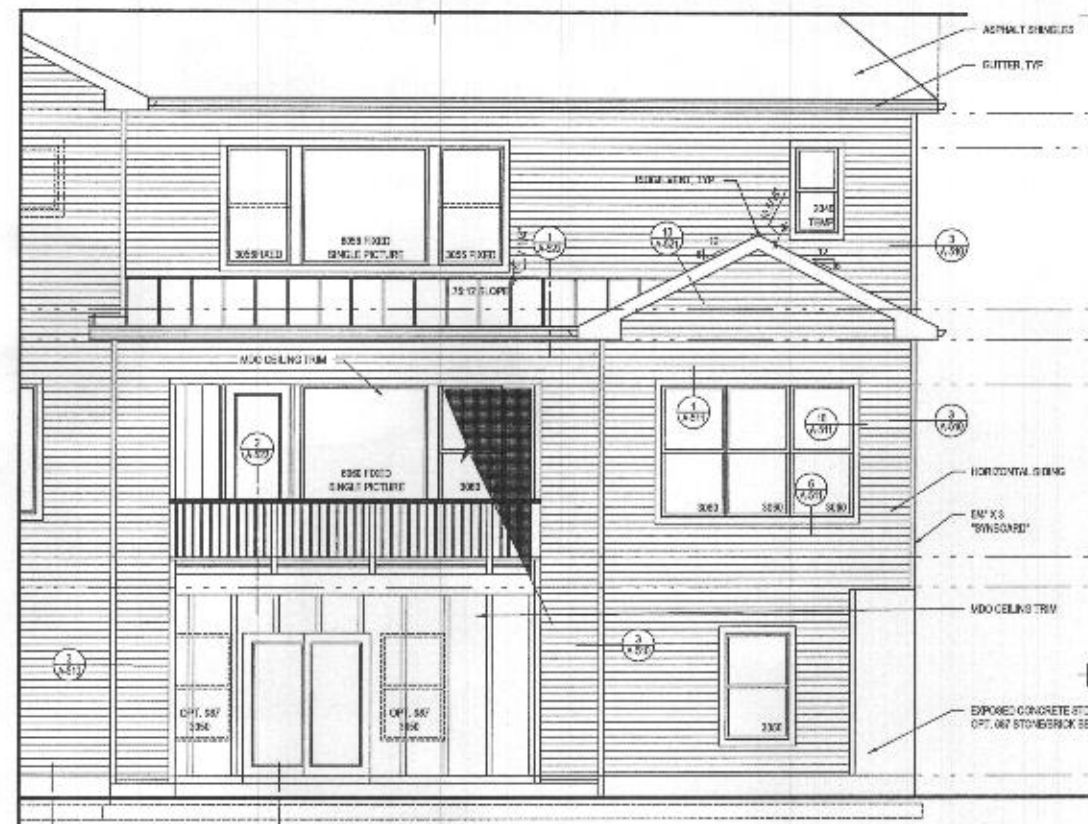


4 REAR ELEVATION
A-407 SCALE 1/4"=1'-0"

w/ OPT. 263073 MULTI-GEN. SUITE
w/ COVD OUTDOOR LIVING @ WALKOUT CONDITION

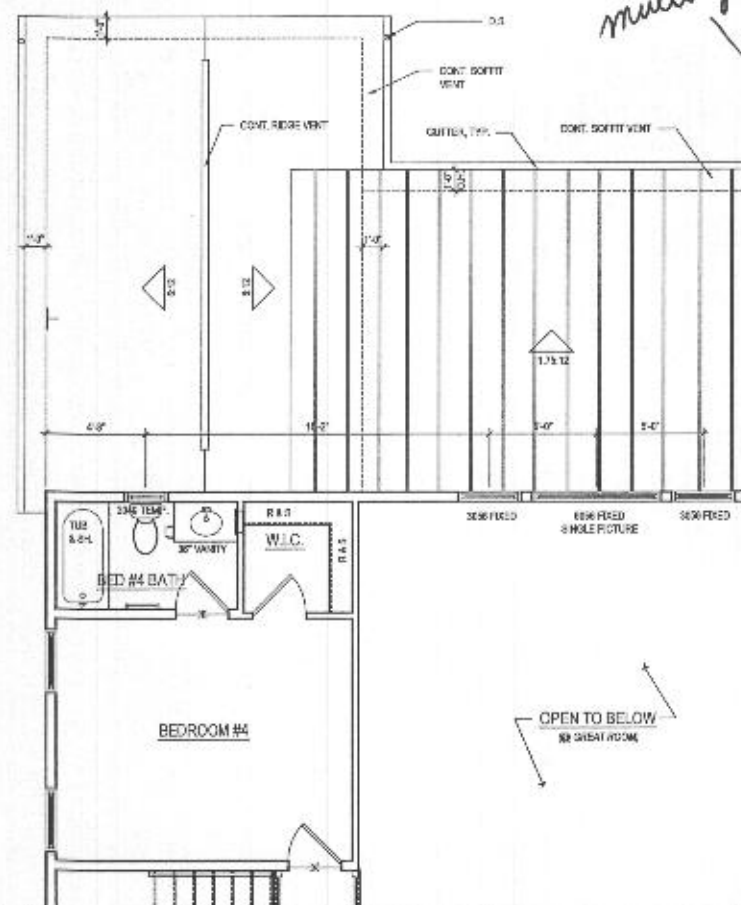


3 PART. SECOND FLOOR PLAN
A-407 SCALE 1/4"=1'-0"

w/ OPT. 263073 MULTI-GEN. SUITE
w/ COVD OUTDOOR LIVING @ WALKOUT CONDITION

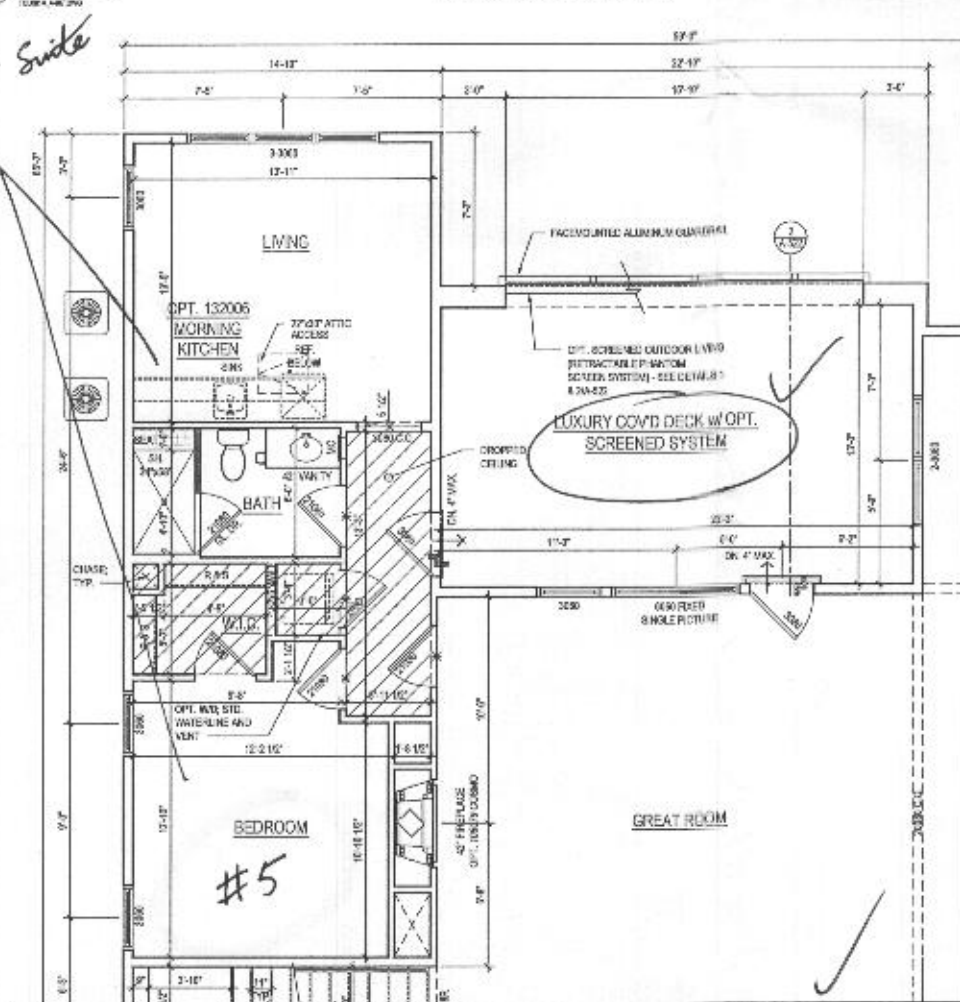

2 PART. FIRST FLOOR PLAN
A-407 SCALE 1/4"=1'-0"

w/ OPT. 263073 MULTI-GEN. SUITE
w/ COVD OUTDOOR LIVING @ WALKOUT CONDITION

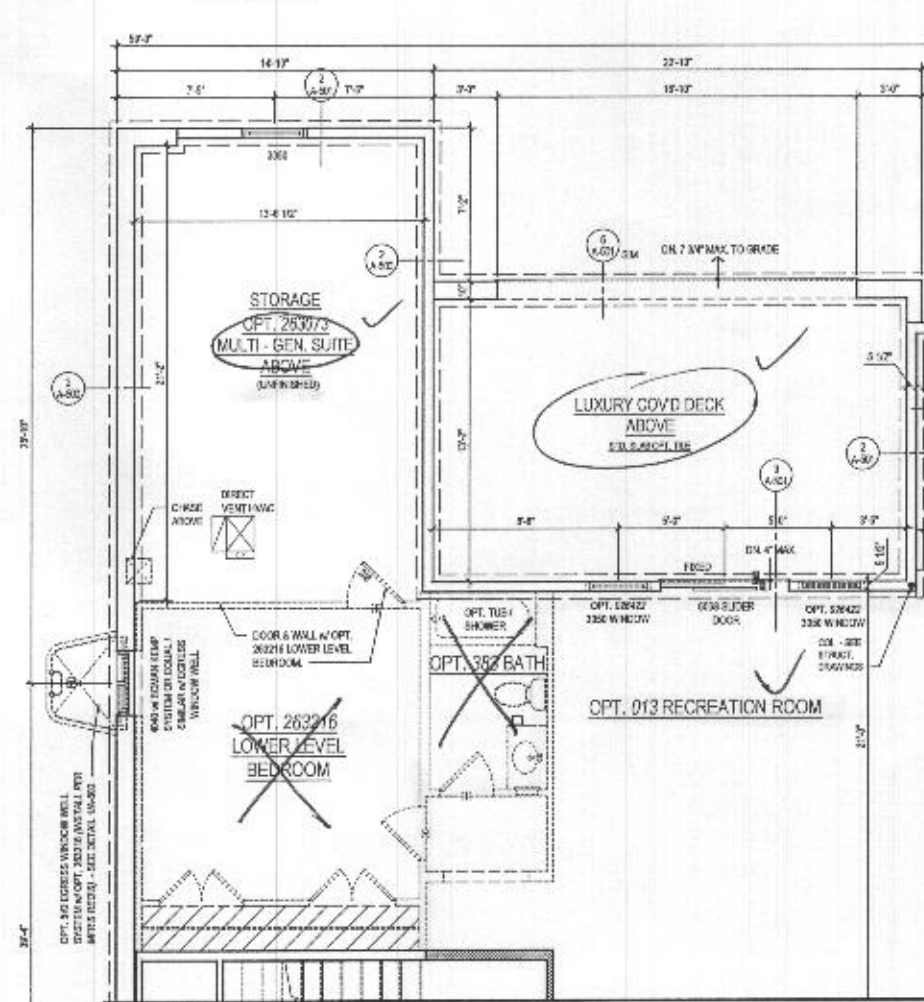

1 PART. BASEMENT PLAN
A-407 SCALE 1/4"=1'-0"

w/ OPT. 263073 MULTI-GEN. SUITE
w/ COVD OUTDOOR LIVING @ WALKOUT CONDITION



SEAL & SIGNATURE

TOLL BROTHERS
19775 BELMONT EXECUTIVE PLAZA
ARLINGTON, VA 22204
P: 571.351.6000
CONTACT: CHRISTINA LEMLEY
clmley@tollbrothers.com

EXECUTIVE SERIES
MARYLAND

PARKHURST
OPTIONS


NO.	DESCRIPTION	DATE
1	REV. SET	08.20.23
2	PERMIT SET	08.20.23
3	NO NEW STANDARDS	09.18.23
4	NO. #22244	12.11.23

PROJECT NO: TOL-263073
DRAWN BY: ACN
CHECKED BY: JH
PLOT DATE: Jan. 20, 2024
FILE NAME: 110.0123_A407.dwg

A-407

10545 Pudding Lane
 LOT 26
 Kings forest

- GENERAL PLAN NOTES**
- ALL WOOD STUD PARTITIONS NOT DIMENSIONED ARE TO BE 1 1/2" FOR INTERIOR AND 2 1/2" FOR EXTERIOR WALLS UNLESS OTHERWISE NOTED.
 - ALL INTERIOR DIMENSIONS ARE TO FACE OF STUD.
 - ALL EXTERIOR DIMENSIONS ARE TO FACE OF STUD.
 - ALL DIMENSIONS GIVEN OVER SCALE.
 - ALL DOOR DETECTORS ARE TO BE WIRE BY SQUIB AMMETER THAT ACTIVATION OF DOOR WILL ACTIVATE THEM ALL.
 - ENCLOSED ACCESSIBLE SPACE UNDER STAIRS SHALL HAVE WALLS AND BUFFERS PROTECTED ON ENCLOSED SIDE WITH 1/2" CYPRUS SCARS.
 - ALL WINDOWS SIZE ARE NOTED IN FEET + INCHES AS MEASURED FROM SASH TO SASH.
 - REFER TO ELEVATIONS FOR WINDOW HEAD HEIGHTS.
 - ALL DOORS ARE TO BE 6' 8" HIGH UNLESS OTHERWISE NOTED.
 - WASHER ALWAYS TO BE ON LEFT SIDE OF DRYER.
 - DISHWASHER ALWAYS TO BE ON RIGHT SIDE OF SINK.

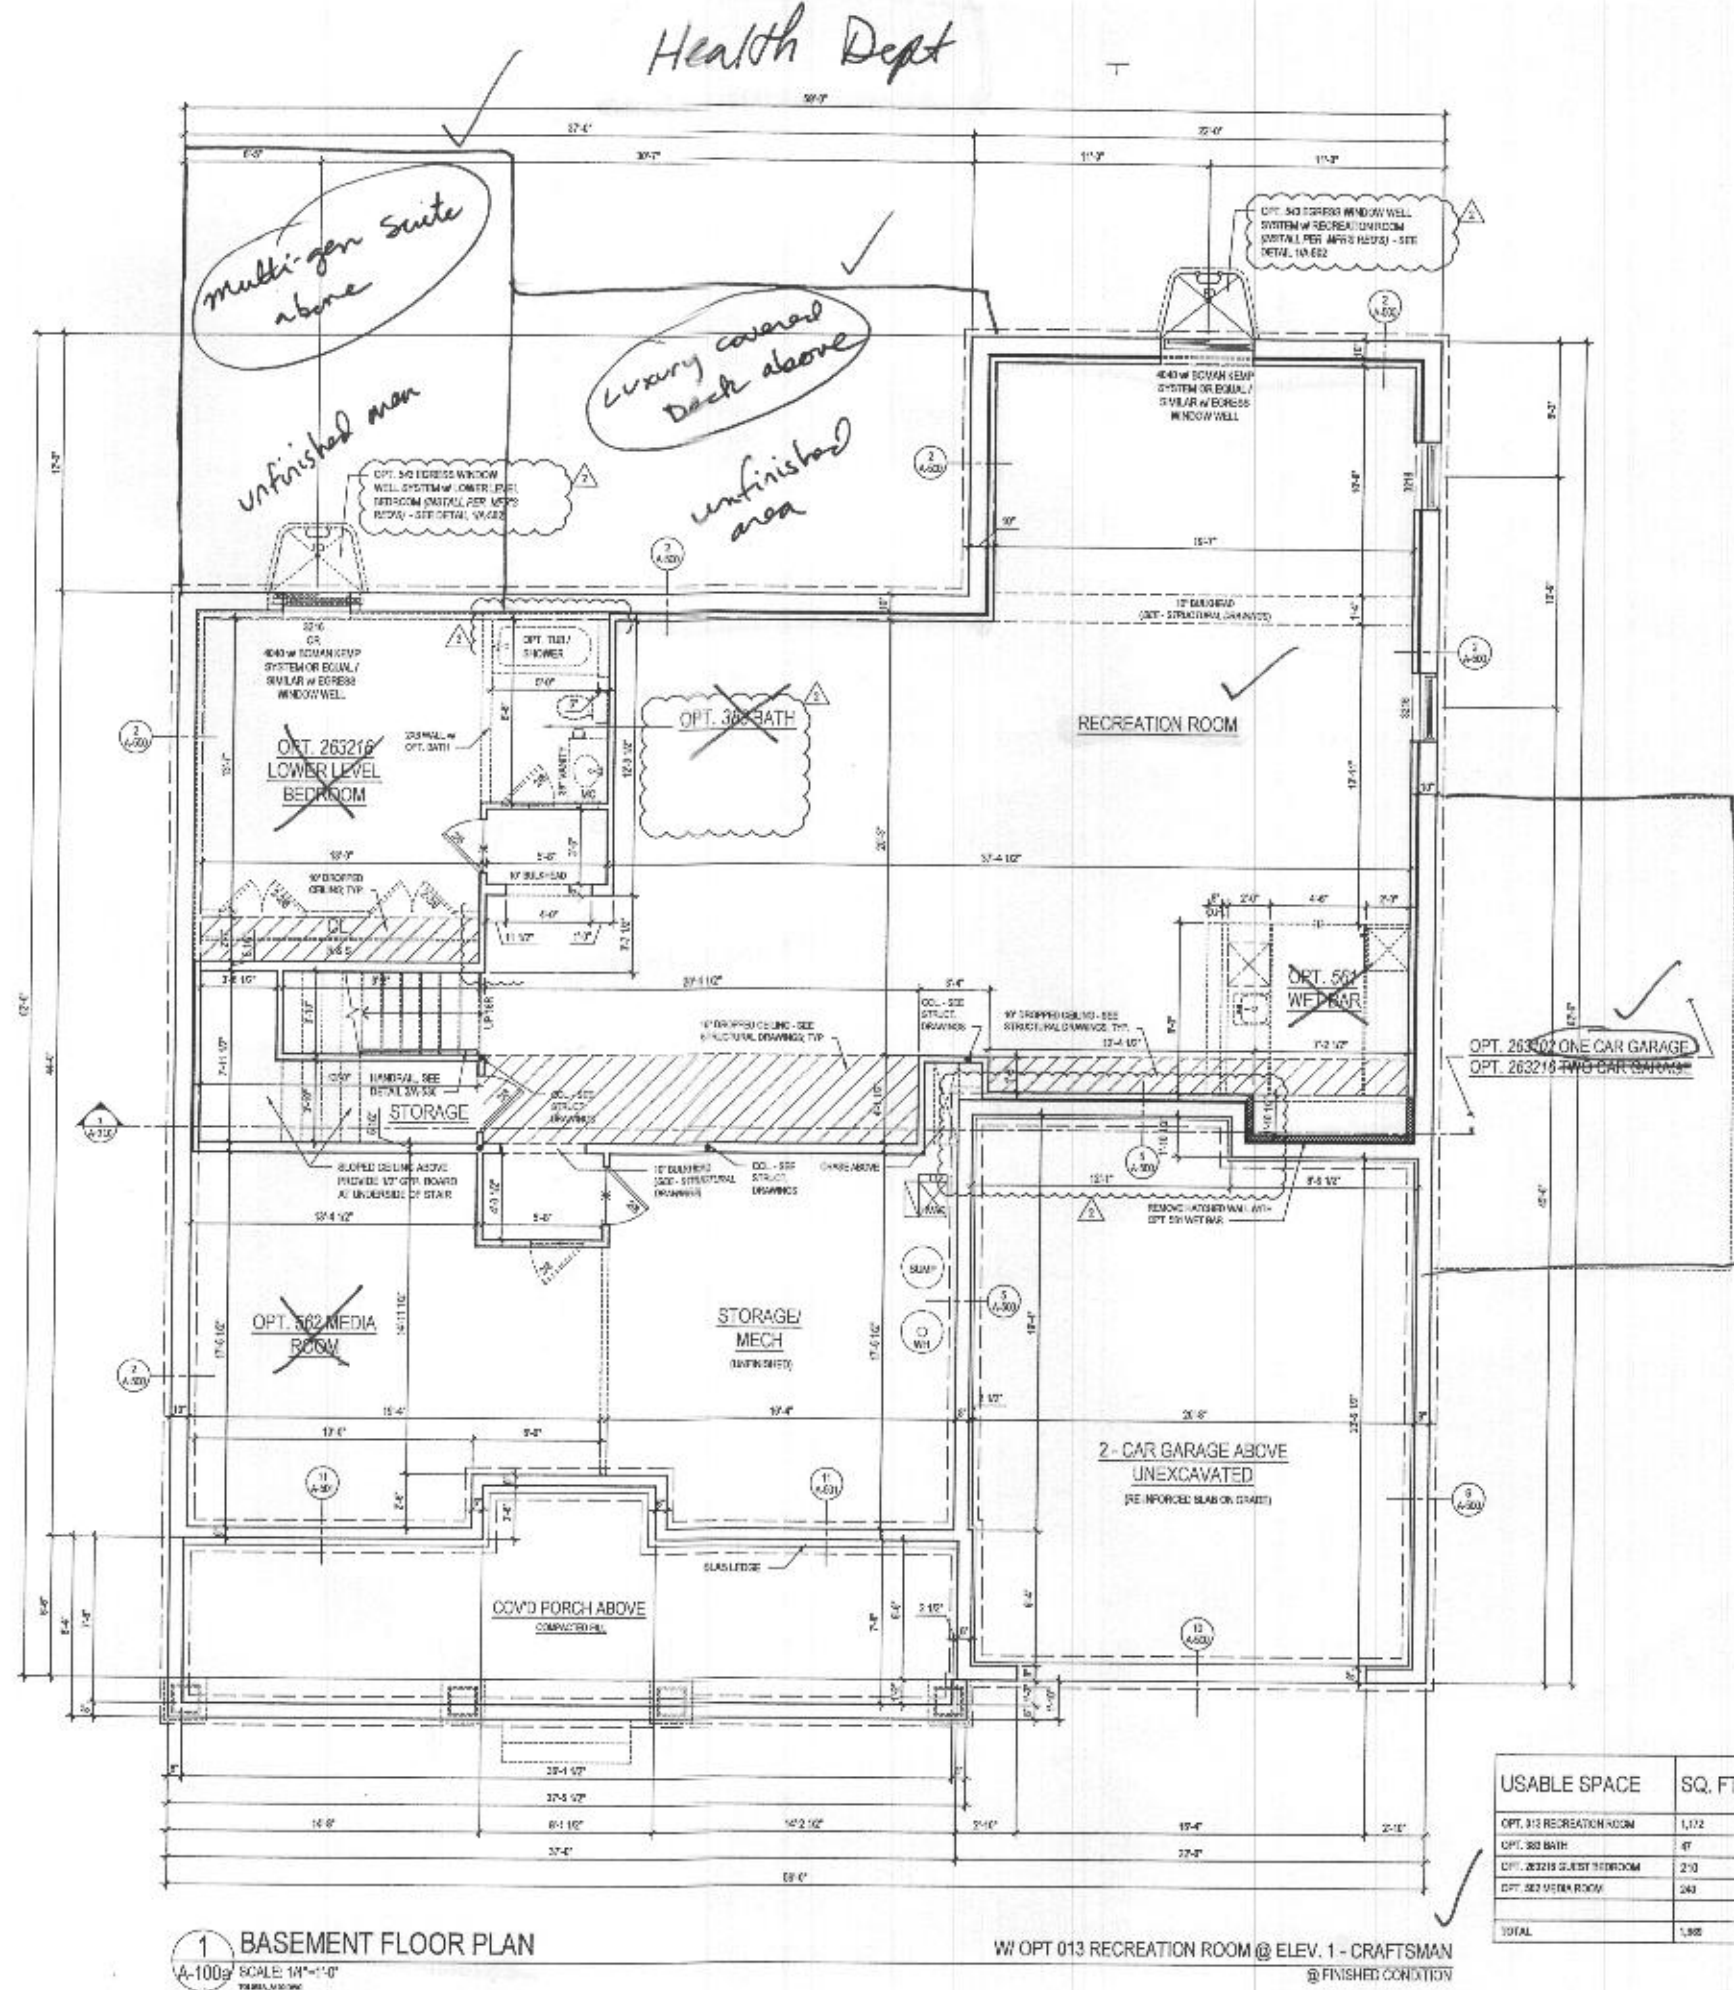

ARCHITECT:

lessard DESIGN

8521 Leesburg Pike
 Suite 700 | Vienna, VA 22182
 P: 571.830.1800 | F: 571.830.1801
 www.lessarddesign.com

SEAL & SIGNATURE

OWNER:

TOLL BROTHERS
 15075 BELMONT EXECUTIVE PLAZA
 ARLINGTON, VA 22207
 P: 571.291.8058
 CONTACT: CHRISTINA LEWLEY
 cllewley@tollbrothers.com

PROJECT NAME:

MARYLAND

PARKHURST FLOOR PLANS

ISSUE / REVISION

NO.	DESCRIPTION	DATE
1	ISSUE SET	03.20.19
2	PERMIT SET	06.15.19
3	NO NEW STANDARDS	09.15.19
4	NO 2020041	02.21.20


PROJECT NO: TOL-0814
 DRAWN BY: AL-001
 CHECKED BY: AL-001
 PLOT DATE: Apr. 23, 2020
 FILE NAME: TOL-0814_A-100a.dwg

A-100a


B22000599

- GENERAL PLAN NOTES**
- ALL WOOD STAIR PARTITIONS NOT DIMENSIONED ARE TO BE 3' 0" FOR INTERIOR AND 4' 0" FOR EXTERIOR WALLS UNLESS OTHERWISE NOTED.
 - ALL INTERIOR DIMENSIONS ARE TO FACE OF STUDS.
 - ALL EXTERIOR DIMENSIONS ARE TO FACE OF STUDS.
 - ALL DIMENSIONS GOVERN OVER SCALE.
 - ALL SMOKE DETECTORS ARE TO BE MOUNTED IN SUCH A MANNER THAT ACTIVATION OF ONE WILL ACTIVATE THEM ALL.
 - EXTERIOR ACCESS BELL SIGNS UNDER STAIRS SHALL HAVE WALLS AND SIGNS PROTECTED ON ENCLOSED SIDE WITH 1/2" CYCLAM BOARD.
 - ALL WINDOWS SIZE ARE NOTED IN FEET - INCHES AS MEASURED FROM DASH TO DASH.
 - REFER TO ELEVATIONS FOR WINDOW HEAD HEIGHTS.
 - ALL DOORS ARE TO BE 3' 0" UNLESS OTHERWISE NOTED.
 - WASHER ALWAYS TO BE ON LEFT SIDE OF DRYER.
 - DRYER WASHES ALWAYS TO BE ON RIGHT SIDE OF DRYER.

See detail page

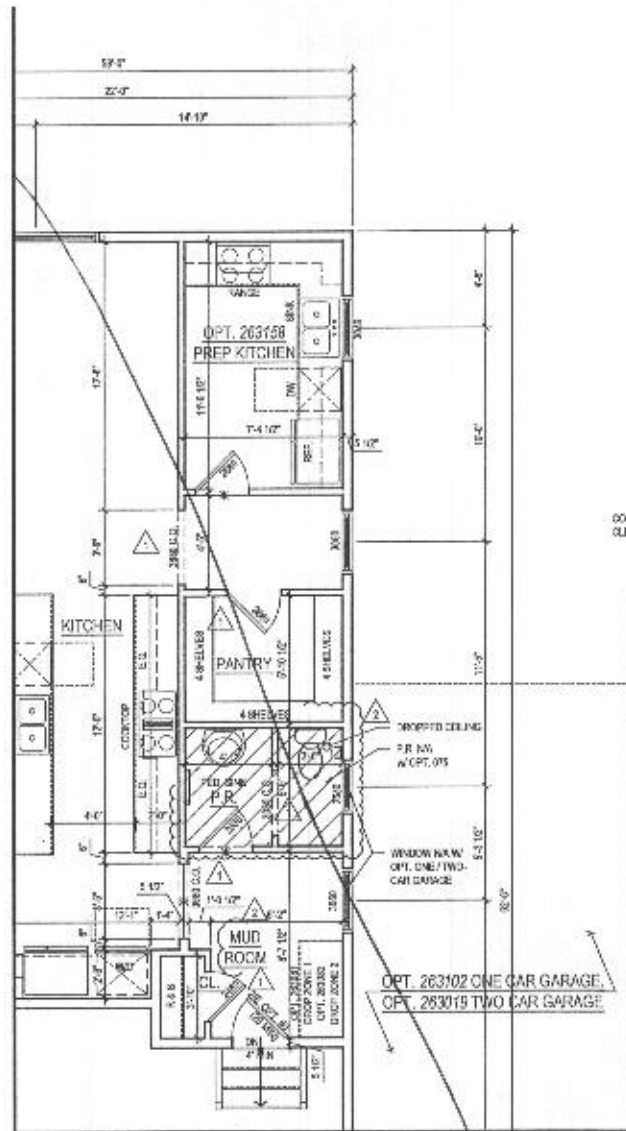

2 PART. FIRST FLOOR PLAN w/ OPT. 263158 - OPT. PREP KITCHEN
A-110 SCALE 1/4" = 1'-0"

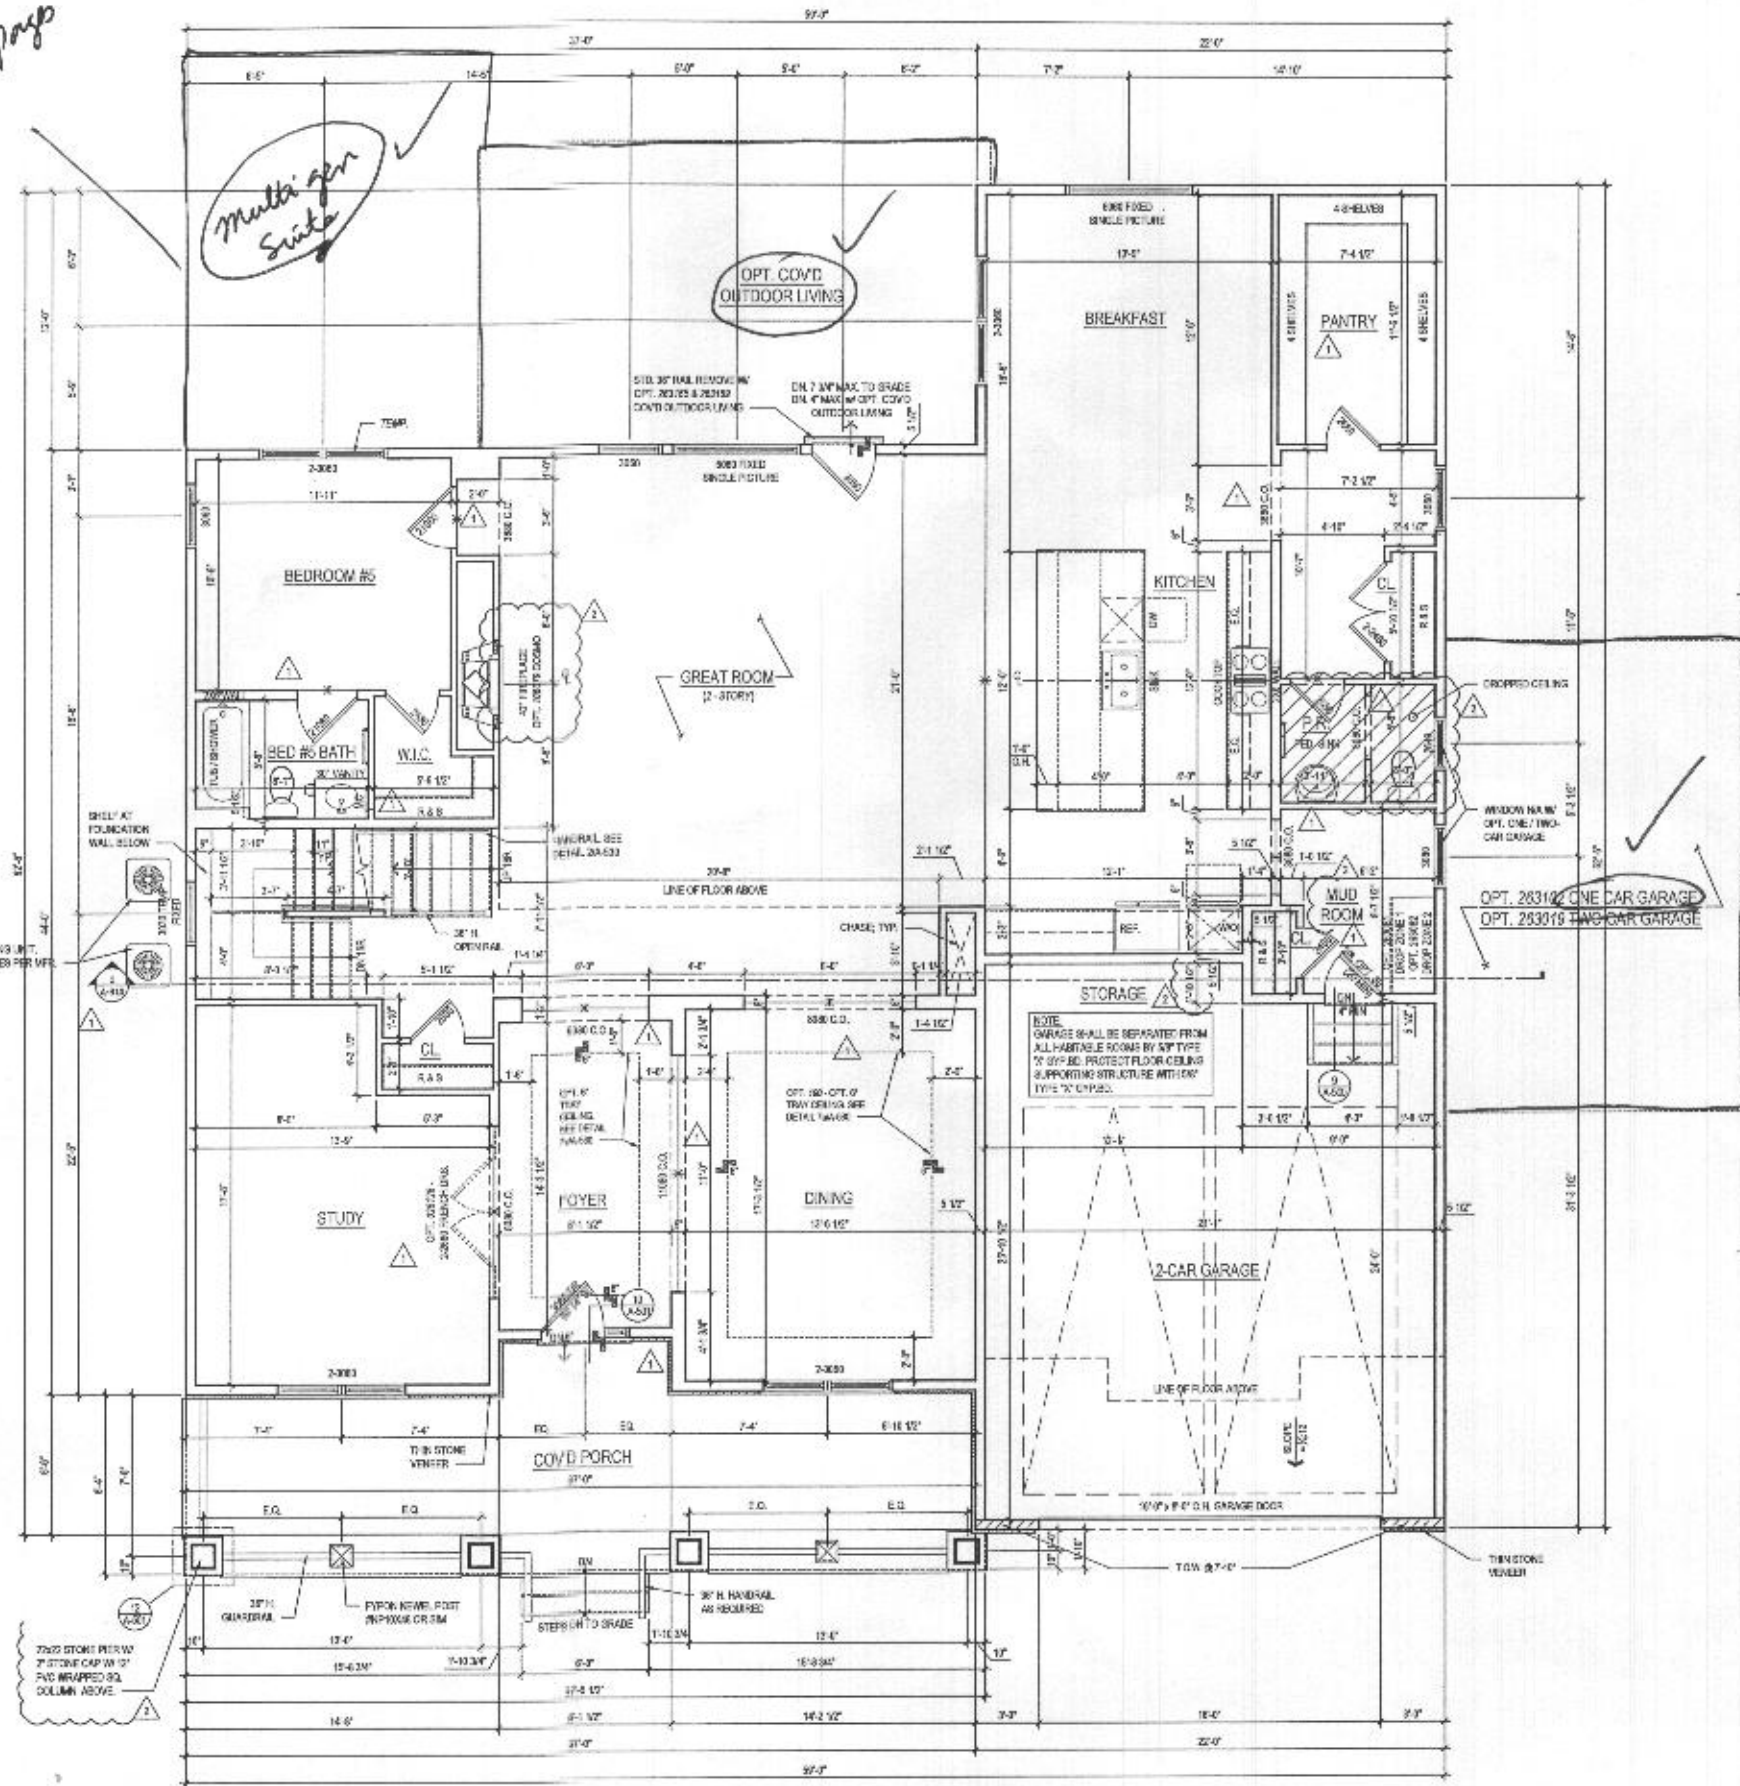

1 FIRST FLOOR PLAN
A-110 SCALE 1/4" = 1'-0"

lessard DESIGN
8571 Leesburg Pike
Suite 700 | Vienna, VA 22182
P: 571.830.1800 | F: 571.830.1801
www.lessardesign.com
SEA. & SIGNATURE


TOLL BROTHERS
19725 BELMONT EXECUTIVE PLAZA
ASHBURTON, VA 22047
P: 571.251.6065
CONTACT: CHRISTINA LEHLEY
doherty@tollbrothers.com

PARKHURST FLOOR PLANS
MARYLAND

NO.	DESCRIPTION	DATE
1	DESIGN	05.20.20
2	SCHEMATIC	06.30.20
3	100% NEW STRAWDOG	09.16.20
4	100% NEW STRAWDOG	12.13.20


PROJECT NO. TOLBROTH
DRAWN BY: JALON
CHECKED BY: JALON
PLOT DATE: 05.20.2021
FILE NAME: 100-001-0110-001

A-110

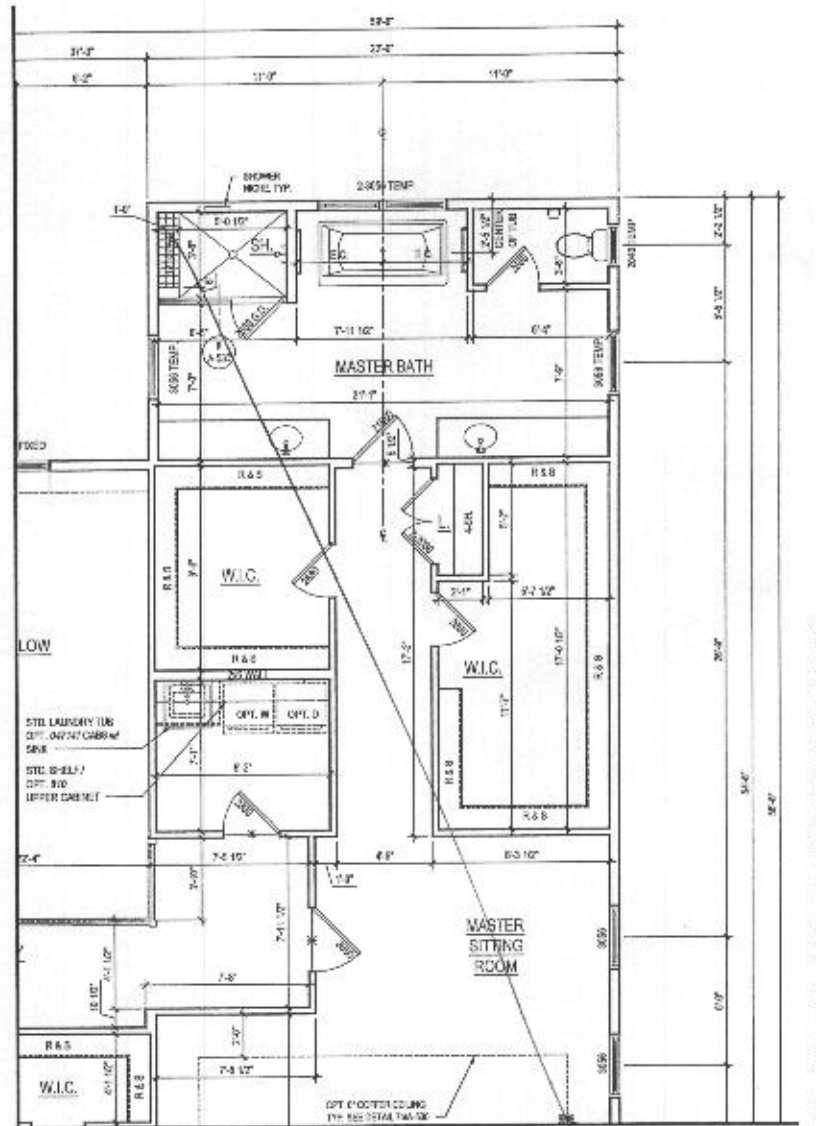

2 PART. SECOND FLOOR PLAN W/ OPT. 030 - ADDITIONAL WALK IN CLOSET
A-120 SCALE 1/8"=1'-0"

- GENERAL PLAN NOTES**
- ALL WOOD STUD PARTITIONS NOT DIMENSIONED ARE TO BE 2" X 4" FOR INTERIOR AND 2" X 6" FOR EXTERIOR WALLS UNLESS OTHERWISE NOTED.
 - ALL INTERIOR DIMENSIONS ARE TO FACE OF STUDS.
 - ALL EXTERIOR DIMENSIONS ARE TO FACE OF STUDS.
 - ALL DIMENSIONS GOVERN OVER BOARDS.
 - ALL SMOKE DETECTORS ARE TO BE WIRED IN SUCH A MANNER THAT ACTIVATION OF ONE WILL ACTIVATE THE WHOLE.
 - ENCLOSED ACCESSIBLE SPACE UNDER STAIRS SHALL HAVE WALLS AND CEILING PROTECTED ON ENCLOSED SIDE WITH 1/2" GYPSUM BOARD.
 - ALL WINDOWS ARE TO BE NOTED IN FEET & INCHES AS MEASURED FROM BASH TO BASH.
 - REFER TO ELEVATIONS FOR WINDOW HEAD HEIGHTS.
 - ALL DOORS ARE TO BE 6' 8" HIGH UNLESS OTHERWISE NOTED.
 - WASHER ALWAYS TO BE ON LEFT SIDE OF SINK.
 - DISHWASHER ALWAYS TO BE ON RIGHT SIDE OF SINK.

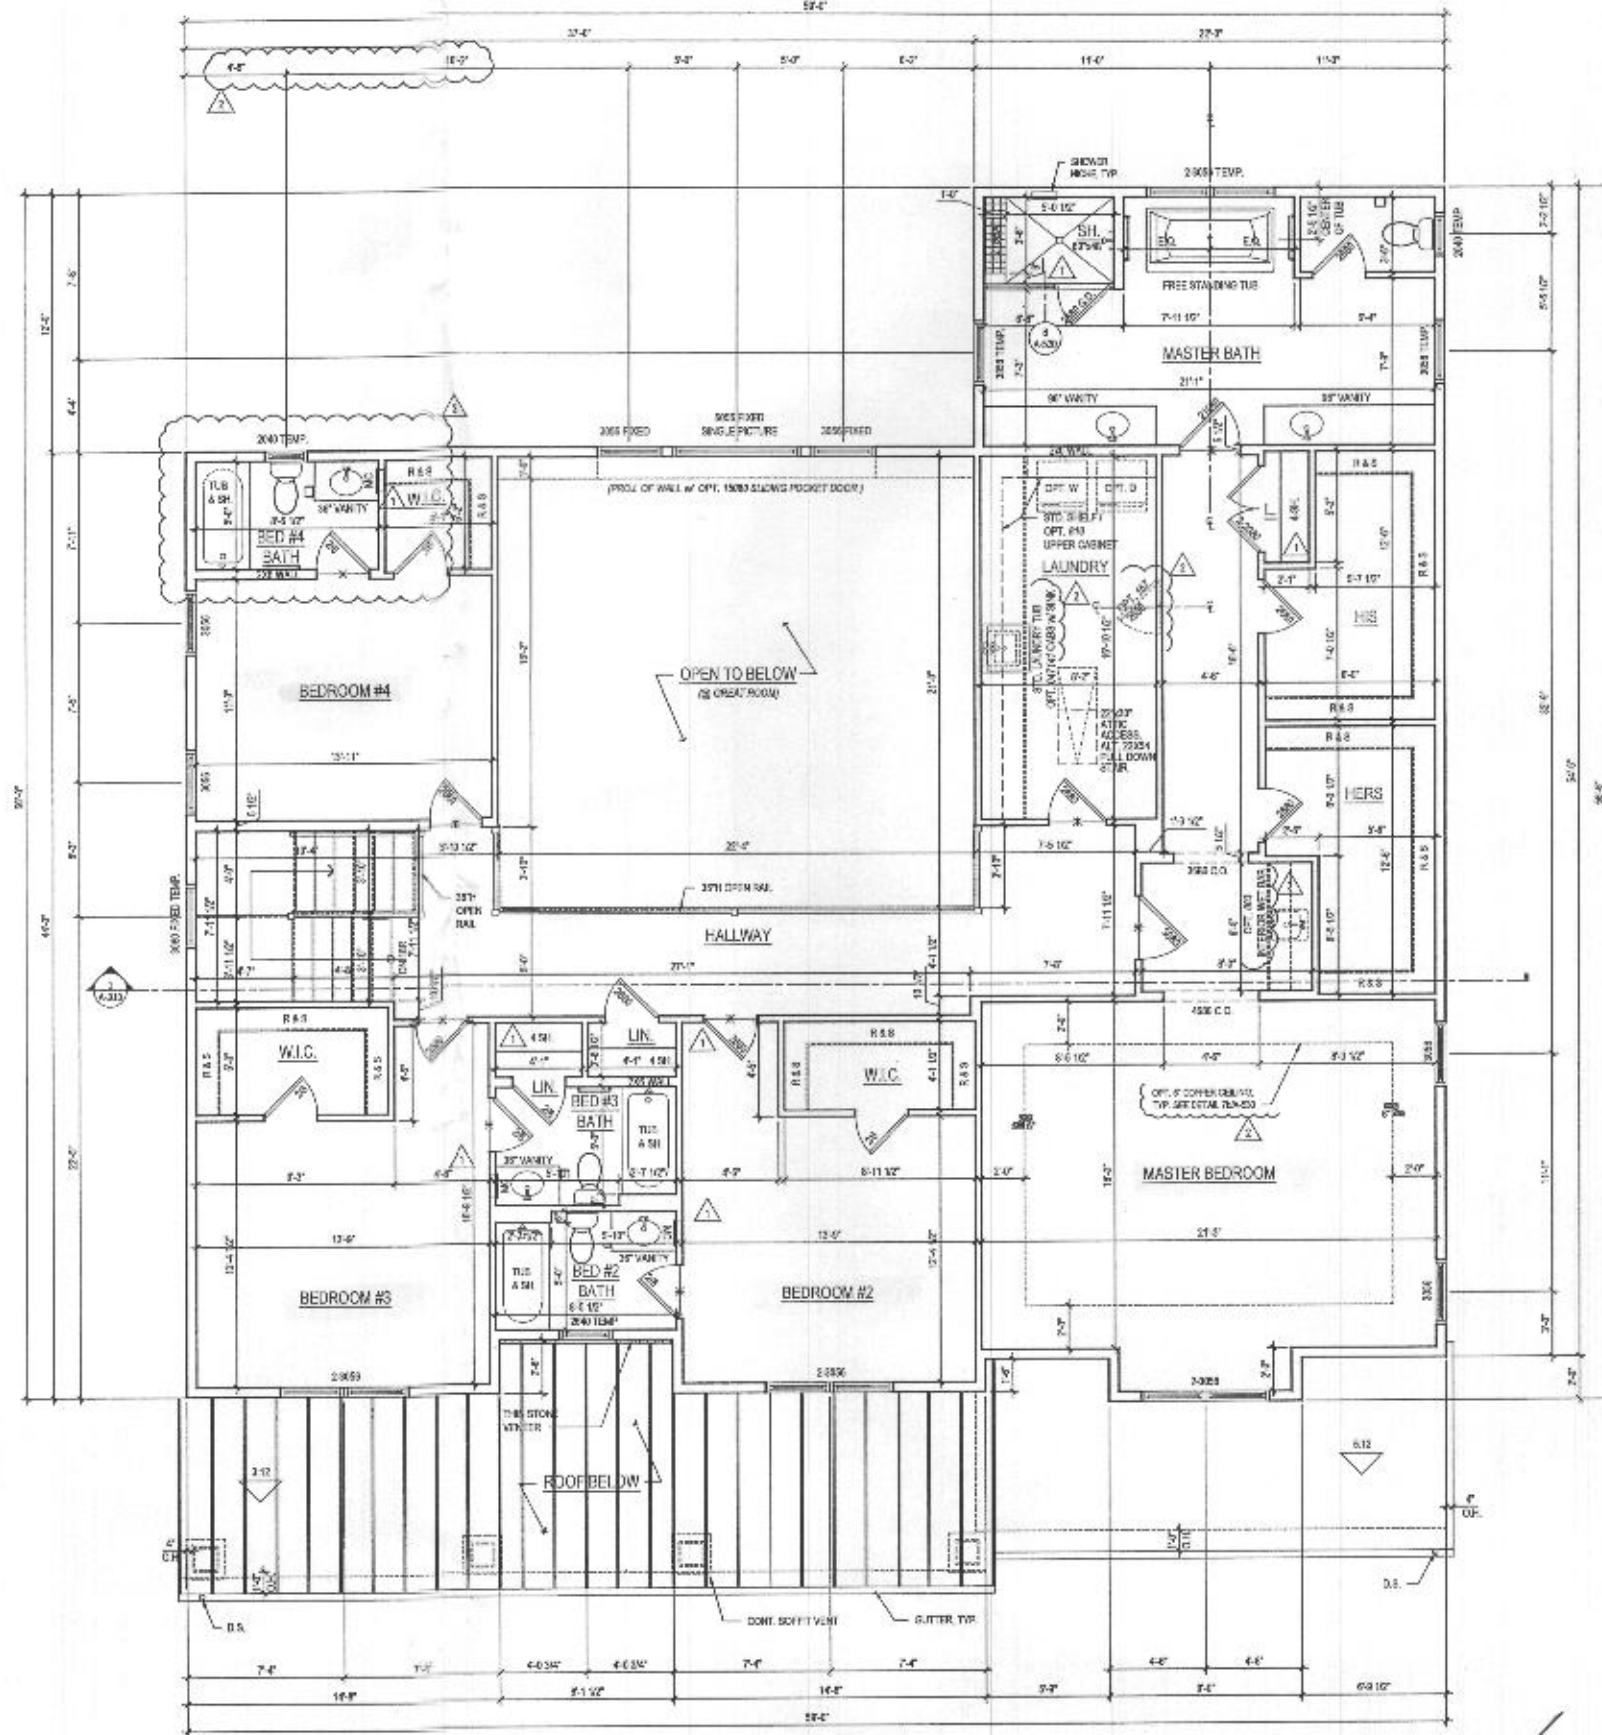

1 SECOND FLOOR PLAN
A-120 SCALE 1/8"=1'-0"

@ ELEV. 1 - CRAFTSMAN

ARCHITECT

lessard
DESIGN

8521 Leesburg Pike
Suite 200 | Vienna, VA 22182
P: 571.830.1800 | F: 571.830.1801
www.lessarddesign.com

SEAL & SIGNATURE

OWNER:

TOLL BROTHERS
19775 BELMONT EXECUTIVE PLAZA
ARLINGTON, VA 22207
P: 571.251.8055
CONTACT: CHRISTINA LONLEY
clonley@tollbrothers.com

PROJECT NAME

MARYLAND

PARKHURST FLOOR PLANS

SHEET TITLE

NO.	DESCRIPTION	DATE
1	RED SET	03.25.19
2	PERMIT SET	05.16.19
3	FOR NEW STANDARDS	03.16.19
4	FOR #220211	12.13.20

PROJECT NO: 104-0638


DRAWN BY: ALB

CHECKED BY: JLD


PLT DATE: 03.20.2020

FILE NAME: 104-0638-01.dwg


A-120

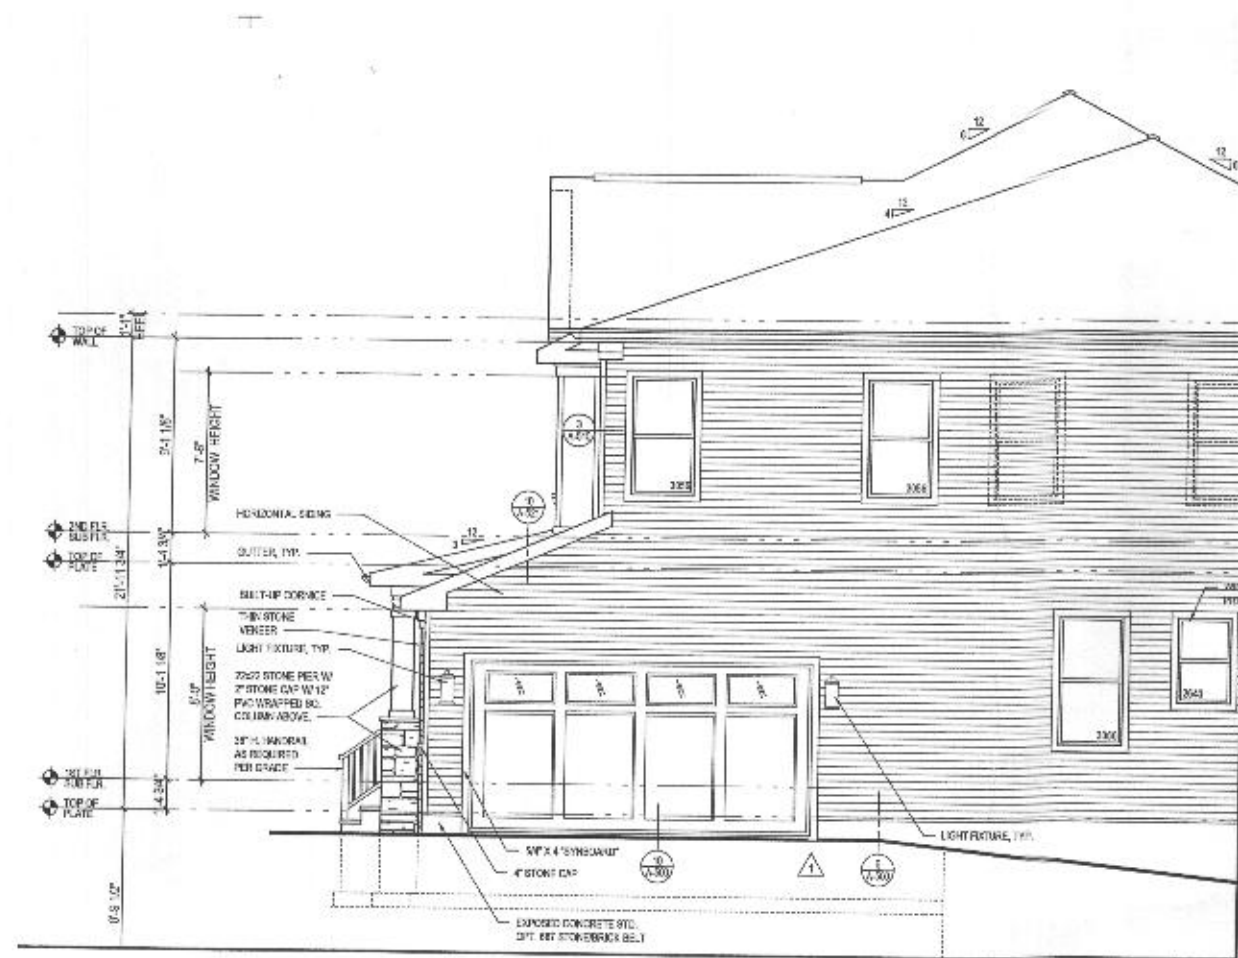


4 PART. RIGHT SIDE ELEVATION w/ OPT. 012 - SIDE LOAD GARAGE
A-400 SCALE: 1/4"=1'-0"
TOLLS, MARYLAND

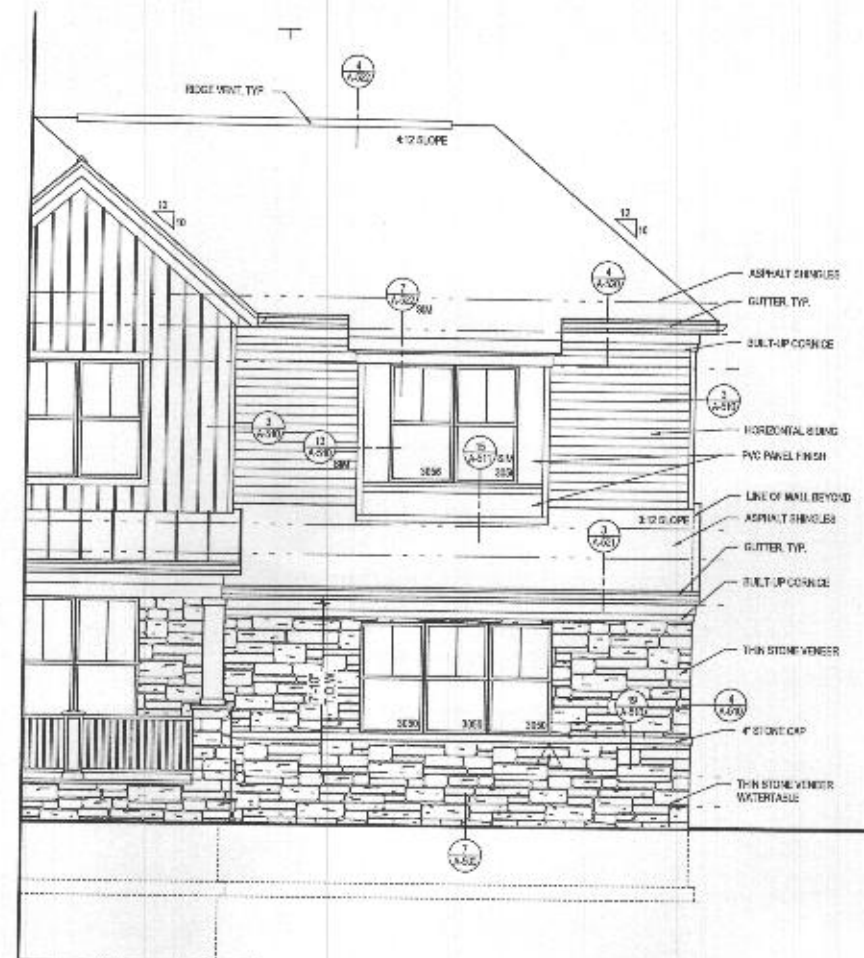

3 PART. FRONT ELEVATION w/ OPT. 012 - SIDE LOAD GARAGE
A-400 SCALE: 1/4"=1'-0"
TOLLS, MARYLAND

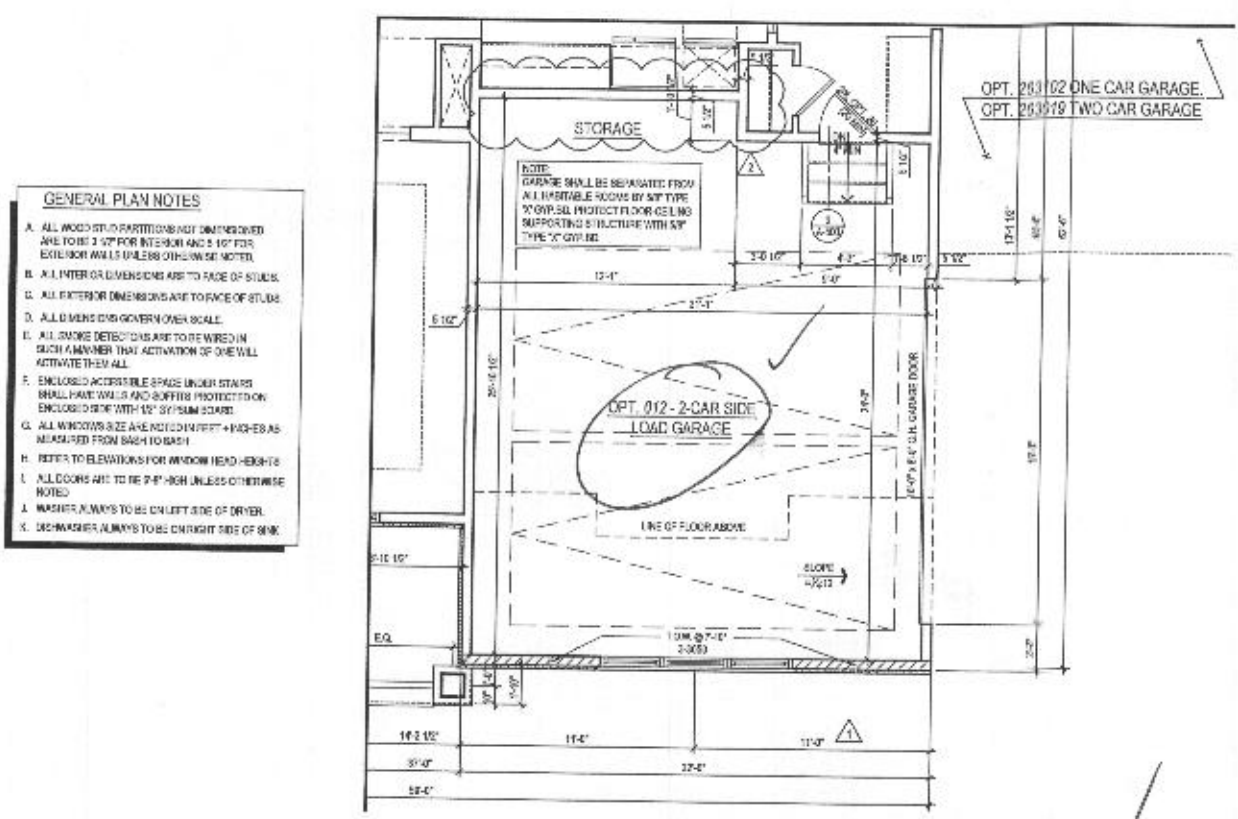

2 PART. FIRST FLOOR PLAN w/ OPT. 012 - SIDE LOAD GARAGE
A-400 SCALE: 1/4"=1'-0"
TOLLS, MARYLAND

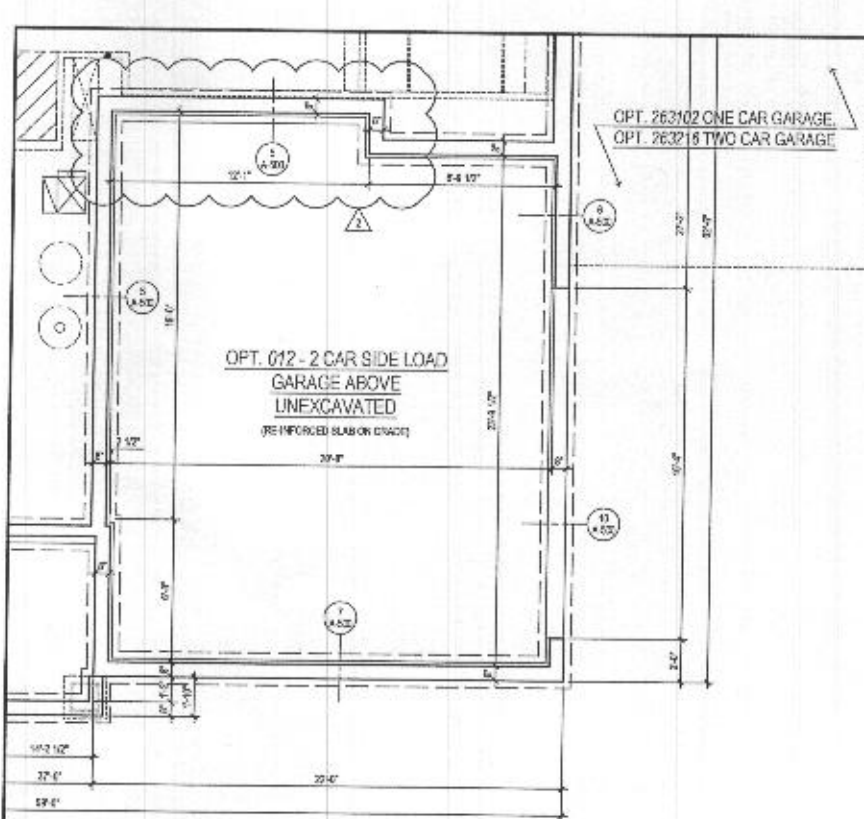

1 PART. BASEMENT FLOOR PLAN w/ OPT. 012 - SIDE LOAD GARAGE
A-400 SCALE: 1/4"=1'-0"
TOLLS, MARYLAND

- GENERAL PLAN NOTES**
- ALL WOOD STUD PARTITIONS NOT DIMENSIONED ARE TO BE 2"X4" FOR INTERIOR AND 2"X6" FOR EXTERIOR WALLS UNLESS OTHERWISE NOTED.
 - ALL INTERIOR DIMENSIONS ARE TO FACE OF STUDS.
 - ALL EXTERIOR DIMENSIONS ARE TO FACE OF STUDS.
 - ALL DIMENSIONS GOVERN OVER SCALE.
 - ALL SMOKE DETECTORS ARE TO BE WIRED IN SUCH A MANNER THAT ACTIVATION OF ONE WILL ACTIVATE THEM ALL.
 - ENCLOSED ACCESSIBLE SPACE UNDER STAIRS SHALL HAVE WALLS AND SURFACES PROTECTED ON ENCLOSED SIDE WITH 1/2" GYP. BOARD.
 - ALL WINDOWS ARE TO BE 4"X6" UNLESS OTHERWISE NOTED.
 - HEADS TO ELEVATIONS FOR WINDOW HEAD HEIGHTS.
 - ALL DOORS ARE TO BE 7'-0" HIGH UNLESS OTHERWISE NOTED.
 - HANDLES ALWAYS TO BE ON LEFT SIDE OF DOOR.
 - DOORWAYS ALWAYS TO BE ON RIGHT SIDE OF DOOR.

ARCHITECT

lessard DESIGN

8521 Leesburg Pike
Suite 700 | Vienna, VA 22182
P: 571.830.1800 | F: 571.830.1801
www.lessarddesign.com

SEAL & SIGNATURE

OWNER:

TOLL BROTHERS
19775 BELMONT EXECUTIVE PLAZA
ASHBURN, VA 20147
P: 571.291.2558
CONTACT: CHRISTINA LEMLEY
clemley@tollbrothers.com


PROJECT NAME: **PARKHURST MARYLAND**

SHEET TITLE: **OPTIONS**


NO.	DESCRIPTION	DATE
1	PERMIT SET	03.18.19
2	PERMIT SET	06.18.19
3	PERMIT SET	09.18.19
4	PERMIT SET	12.11.19

PROJECT NO: TOLLS-19-01
DESIGN BY: JAL
CHECKED BY: JAL
DATE: 03.25.2020
TOLL NAME: TOLLS-19-01-01


A-400

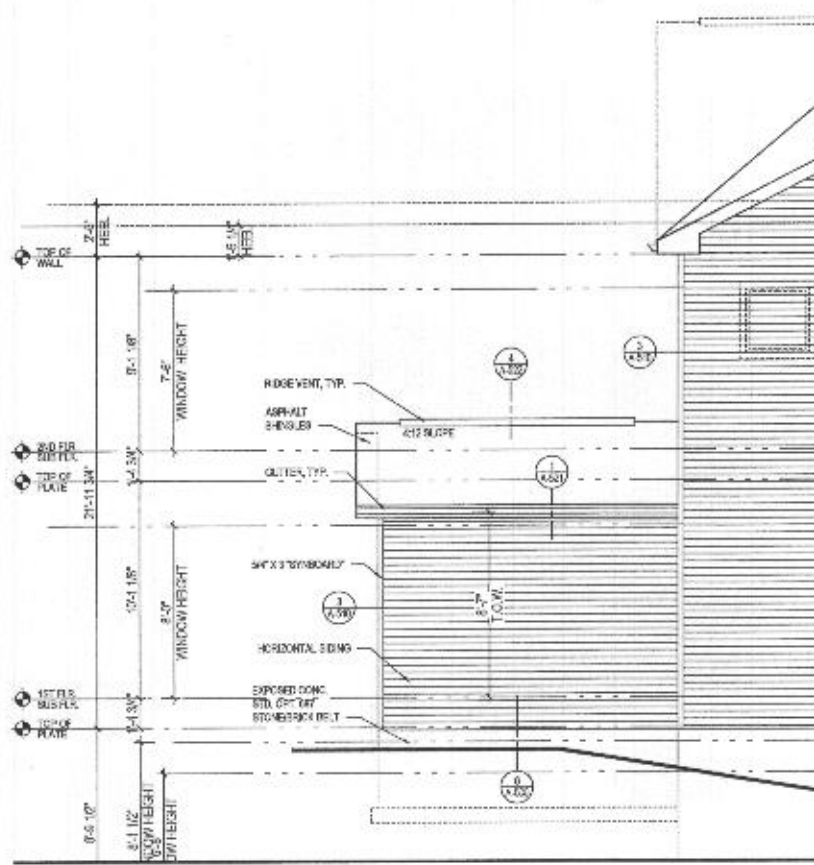

6 PART. REAR ELEVATION w/ OPT. 263102 - ONE CAR GARAGE
A-401 SCALE: 1/4"=1'-0"
TOLUNA, MD

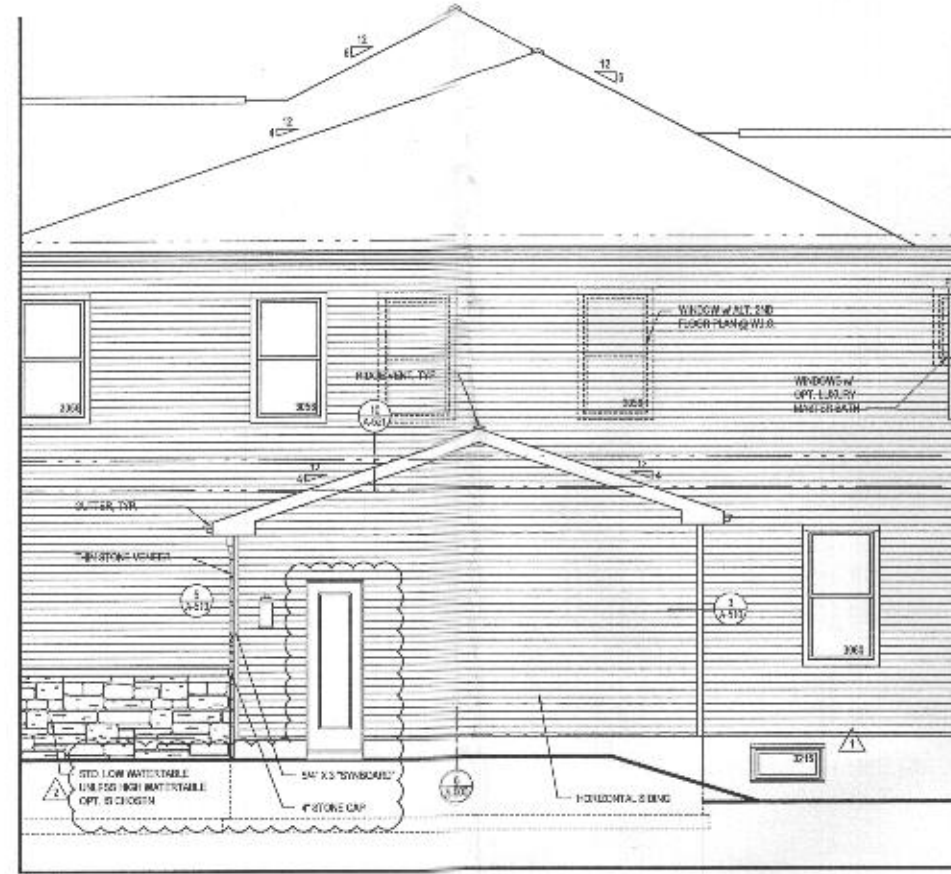


5 PART. RIGHT SIDE ELEVATION w/ OPT. 263102 - ONE CAR GARAGE
A-401 SCALE: 1/4"=1'-0"
TOLUNA, MD

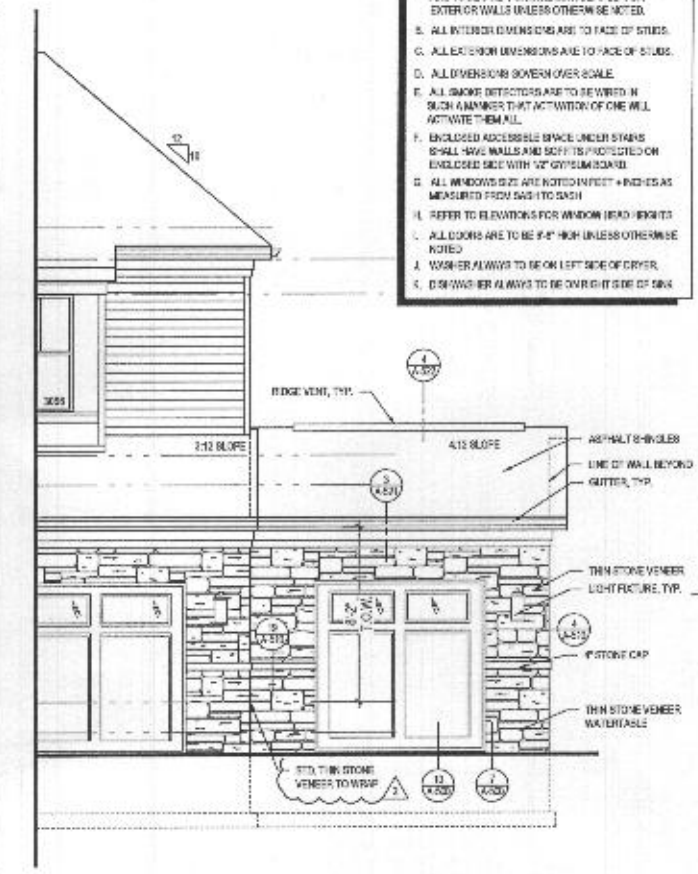


4 PART. FRONT ELEVATION w/ OPT. 263102 - ONE CAR GARAGE
A-401 SCALE: 1/4"=1'-0"
TOLUNA, MD


- GENERAL PLAN NOTES**
- ALL WOOD STUD PARTITIONS NOT DIMENSIONED ARE TO BE 2" X 4" FOR INTERIOR AND 2" X 6" FOR EXTERIOR WALLS UNLESS OTHERWISE NOTED.
 - ALL INTERIOR DIMENSIONS ARE TO FACE OF STUDS.
 - ALL EXTERIOR DIMENSIONS ARE TO FACE OF STUDS.
 - ALL DIMENSIONS GOVERN OVER SCALE.
 - ALL SMOKE DETECTORS ARE TO BE WIRED IN SUCH A MANNER THAT ACTIVATION OF ONE WILL ACTIVATE THE OTHER.
 - ENCLOSED ACCESSIBLE SPACE UNDER STAIRS SHALL HAVE WALLS AND SOFFITS PROTECTED ON ENCLOSED SIDE WITH 1/2" GYPSUM BOARD.
 - ALL WINDOWS SIZES ARE NOTED IN FEET + INCHES AS MEASURED FROM SASH TO SASH.
 - REFER TO ELEVATIONS FOR WINDOW HEAD HEIGHTS.
 - ALL DOORS ARE TO BE 6'8" HIGH UNLESS OTHERWISE NOTED.
 - WALKER ALWAYS TO BE ON LEFT SIDE OF DOOR.
 - DOWNWALKER ALWAYS TO BE ON RIGHT SIDE OF DOOR.

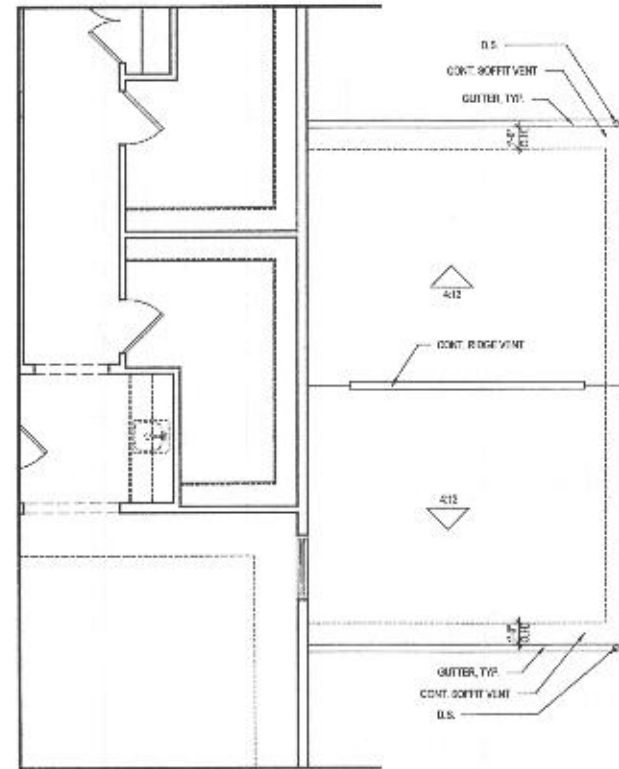

3 PART. SECOND FLOOR PLAN w/ OPT. 263102 - ONE CAR GARAGE
A-401 SCALE: 1/4"=1'-0"
TOLUNA, MD

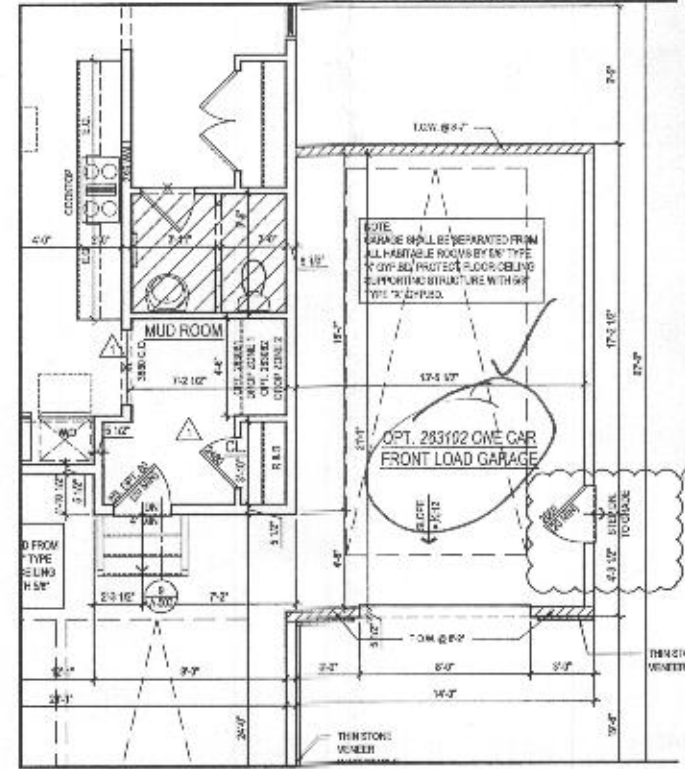

2 PART. FIRST FLOOR PLAN w/ OPT. 263102 - ONE CAR GARAGE
A-401 SCALE: 1/4"=1'-0"
TOLUNA, MD

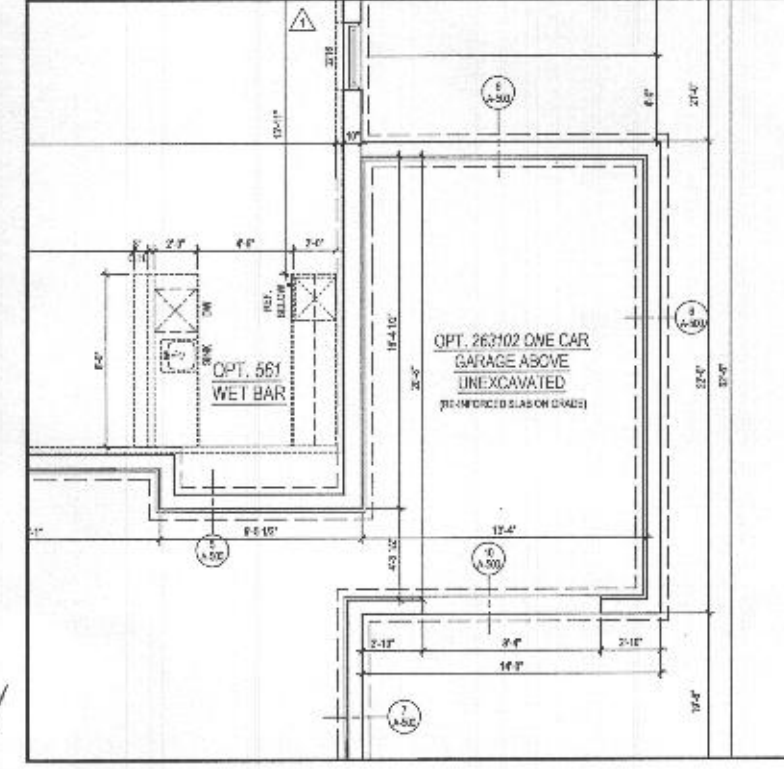

1 PART. BASEMENT FLOOR PLAN w/ OPT. 263102 - ONE CAR GARAGE
A-401 SCALE: 1/4"=1'-0"
TOLUNA, MD

ARCHITECT

lessard
DESIGN

8521 Leesburg Pike
Suite 700 | Vienna, VA 22182
P: 571.830.1800 | F: 571.830.1801
www.lessarddesign.com

SEAL & SIGNATURE

OWNER:

TOLL BROTHERS
19775 RICHMONT EXECUTIVE PLAZA
ASHBURN, VA 20147
P: 571.291.5588
CONTACT: CHRISTINA LEMLEY
clemley@tollbrothers.com

PROJECT NAME: **PARKHURST OPTIONS**

PROJECT NO: **A-401**

DATE: **10/24/2023**

ISSUE / REVISION

NO.	DESCRIPTION	DATE
1	ISSUE SET	10/24/2023
2	PERMIT SET	10/24/2023
3	FOR PERMITTING	10/24/2023
4	FOR PERMITTING	10/24/2023

PROJECT NO: **TOLUNA**

DESIGN BY: **ACORN**

CHECKED BY: **JA**


DATE: **10/24/2023**

FILE NAME: **TOLUNA_A401.dwg**

A-401

GENERAL PLAN NOTES

- ALL WOOD STUD PARTITIONS NOT DIMENSIONED ARE TO BE 3 1/2" FOR INTERIORS AND 6 1/2" FOR EXTERIOR WALLS UNLESS OTHERWISE NOTED.
- ALL INTERIOR DIMENSIONS ARE TO FACE OF STUDS.
- ALL EXTERIOR DIMENSIONS ARE TO FACE OF STUDS.
- ALL DIMENSIONS GIVEN ON OVER SCALE.
- ALL SMOKE DETECTORS ARE TO BE INSTALLED IN SUCH A MANNER THAT ACTIVATION OF ONE WILL ACTIVATE THEM ALL.
- ENCLOSED ACCESSIBLE STAIRS UNDER STAIRS SHALL HAVE WALLS AND DOORS PROTECTED ON ENCLOSED SIDE WITH 1/2" CY/SM BOARD.
- ALL WINDOWS SIZE ARE NOTED IN FEET - INCHES AS MEASURED FROM SASH TO SASH.
- REFER TO ELEVATIONS FOR WINDOW HEAD HEIGHTS.
- ALL DOORS ARE TO BE 6' 8" MINIMUM SW OR OTHERWISE NOTED.
- WORKER ALWAYS TO BE ON LEFT SIDE OF DOOR.
- CLIPPING SHALL ALWAYS TO BE ON RIGHT SIDE OF DOOR.

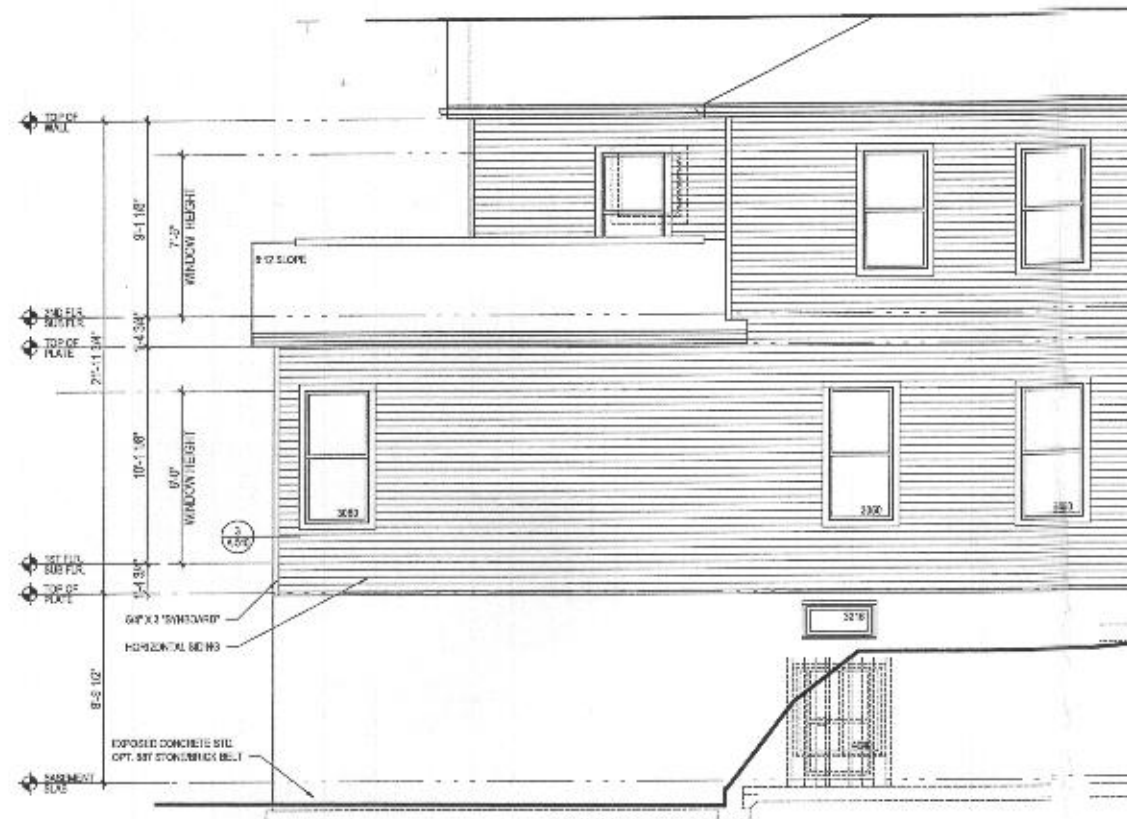


5 PART. LEFT ELEV.
A-407 SCALE 1/4"=1'-0"

w/ OPT. 263073 MULTI-GEN. SUITE
w/ COVID OUTDOOR LIVING @ WALKOUT CONDITION




4 REAR ELEVATION
A-407 SCALE 1/4"=1'-0"

w/ OPT. 263073 MULTI-GEN. SUITE
w/ COVID OUTDOOR LIVING @ WALKOUT CONDITION

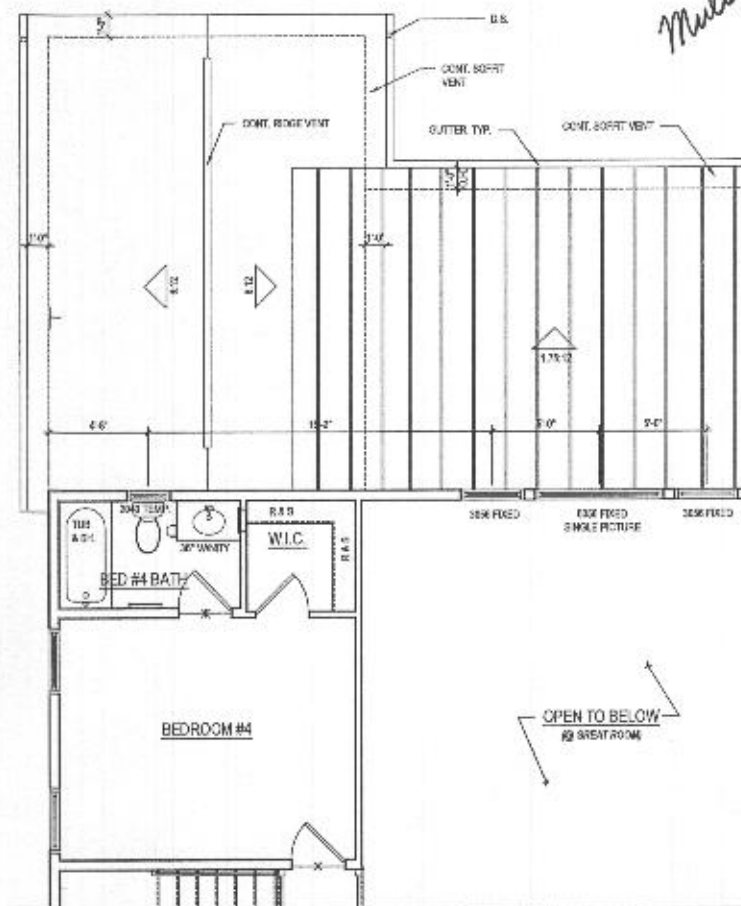


3 PART. SECOND FLOOR PLAN
A-407 SCALE 1/4"=1'-0"

w/ OPT. 263073 MULTI-GEN. SUITE
w/ COVID OUTDOOR LIVING @ WALKOUT CONDITION

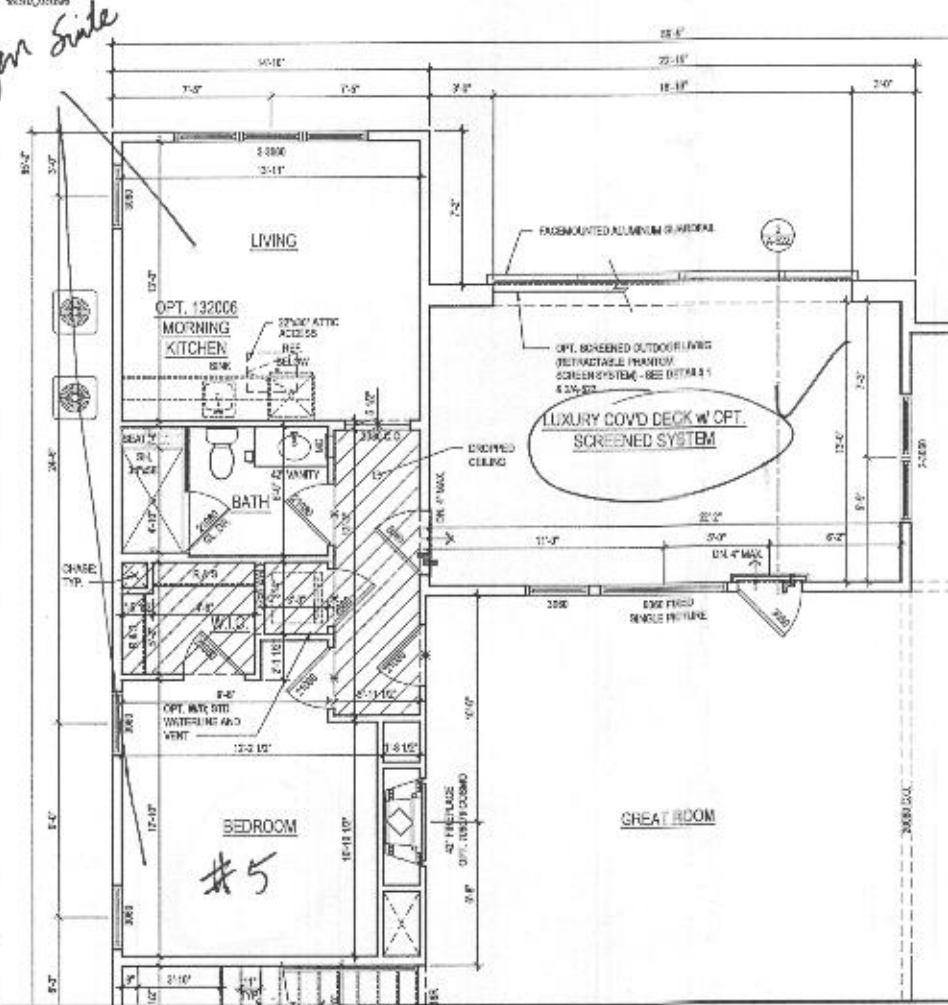

2 PART. FIRST FLOOR PLAN
A-407 SCALE 1/4"=1'-0"

w/ OPT. 263073 MULTI-GEN. SUITE
w/ COVID OUTDOOR LIVING @ WALKOUT CONDITION

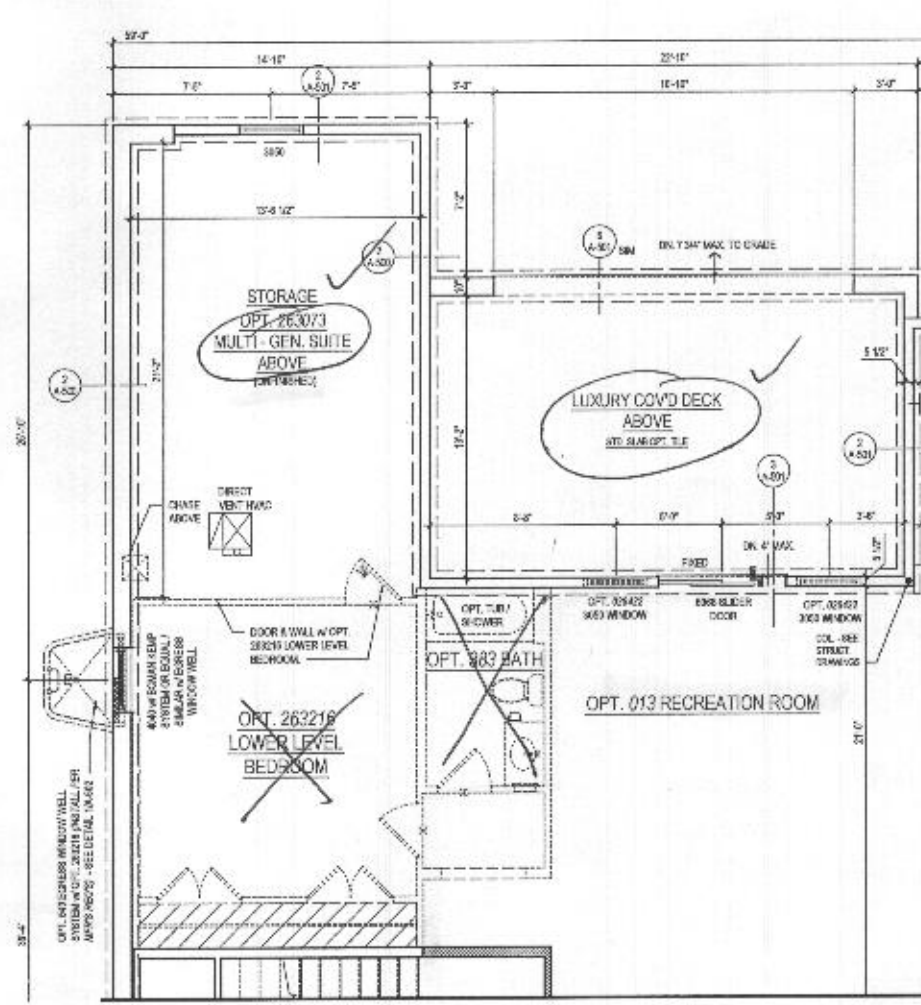

1 PART. BASEMENT PLAN
A-407 SCALE 1/4"=1'-0"

w/ OPT. 263073 MULTI-GEN. SUITE
w/ COVID OUTDOOR LIVING @ WALKOUT CONDITION

ARCHITECT

lessard
DESIGN

8521 Leesburg Pike
Suite 700 | Vienna, VA 22182
P: 571.830.1800 | F: 571.830.1801
www.lessarddesign.com

SEAL & SIGNATURE

TOLL BROTHERS

19775 BELMONT EXECUTIVE PLAZA
ARLINGTON, VA 22207
P: 571.251.8058
CONTACT: CHRISTINA LEMLEY
cllemley@tollbrothers.com

EXECUTIVE SERIES
MARYLAND

PARKHURST
OPTIONS

PROJECT NAME: _____

ISSUE / REVISION

NO.	DESCRIPTION	DATE
1	ISSUE SET	06.26.19
2	PERMIT SET	06.16.19
3	NO NEW STARTWORKS	06.16.19
4	REV. 263073	12.11.20

PROJECT NO: 176-001

DRAWN BY: JCM

CHECKED BY: JCM

DATE: 06.26.19

FILE NAME: TOLBROTH_A407.dwg

A-407