


B 1	1048	SEQUENCE NO. (MDE USE ONLY)	STATE OF MARYLAND APPLICATION FOR PERMIT TO DRILL WELL please type	STATE PERMIT NUMBER HO-95-1531 <small>fill in this form completely</small>
Date Received (APA) 1/25/08 <small>8 MM DD YY 13</small>		OWNER INFORMATION		
15 Last Name Clark		34 First Name John		
36 Street or RFD 2916 Summer Hill Dr.		55		
57 Town West Friendship Md		76 Zip 21794		
DRILLER INFORMATION				
Driller's Name Joseph L. Wayne		76 License No. MS D024		
Firm Name Joseph L. Wayne well Drilling		81		
Address 5512 Ridge Rd Int Arty md 21771		55		
Signature Joseph L. Wayne		Date 1/25/08		
B 2 WELL INFORMATION				
1 APPROX. PUMPING RATE (GAL. PER MIN.)		12		
AVERAGE DAILY QUANTITY NEEDED (GAL. PER DAY)		20		
USE FOR WATER (CIRCLE APPROPRIATE BOX)				
<input checked="" type="checkbox"/> DOMESTIC POTABLE SUPPLY & RESIDENTIAL IRRIGATION <input type="checkbox"/> FARMING (LIVESTOCK WATERING & AGRICULTURAL IRRIGATION) <input type="checkbox"/> INDUSTRIAL, COMMERCIAL, DEWATERING <input type="checkbox"/> PUBLIC WATER SUPPLY WELL <input type="checkbox"/> TEST, OBSERVATION, MONITORING <input type="checkbox"/> GEO-THERMAL				
NOT TO BE FILLED IN BY DRILLER HEALTH DEPARTMENT APPROVAL				
COUNTY NAME Howard COUNTY NO. (13) STATE SIGNATURE Brian Baker INSERT S 41 DATE ISSUED 1/25/2008 CO SIGNATURE 1/25/2009 EXP. DATE NORTH GRID 532 000 EAST GRID 818 000				
APPROXIMATE DEPTH OF WELL 400 FEET		NEAREST TOWN		
APPROXIMATE DIAMETER OF WELL 6 INCH		NEAREST TOWN		
METHOD OF DRILLING (circle one)				
BORED (or Augered) <input checked="" type="checkbox"/> JETTED <input type="checkbox"/> Jetted & DRIVEN <input type="checkbox"/> AIR-ROTARY <input type="checkbox"/> AIR-PERCUSION <input type="checkbox"/> ROTARY (Hydraulic Rotary) <input type="checkbox"/> CABLE <input type="checkbox"/> REVERSE-ROTARY <input type="checkbox"/> DRIVE-POINT <input type="checkbox"/> other _____				
REPLACEMENT OR DEEPEMED WELLS (CIRCLE APPROPRIATE BOX)				
<input type="checkbox"/> THIS WELL WILL NOT REPLACE AN EXISTING WELL <input type="checkbox"/> THIS WELL WILL REPLACE A WELL THAT WILL BE ABANDONED AND SEALED <input checked="" type="checkbox"/> THIS WELL WILL REPLACE A WELL THAT WILL BE USED AS A STANDBY-CONTACT LOCAL APPROVING AUTHORITY FOR POLICY ON STANDBY WELLS <input type="checkbox"/> THIS WELL WILL DEEPEM AN EXISTING WELL				
PERMIT NUMBER OF WELL TO BE REPLACED OR DEEPEMED (IF AVAILABLE) 41 _____ 52				
Not to be filled in by driller (MDE OR COUNTY USE ONLY)				
APPROX. PERMIT NUMBER _____ G _____				
PERMIT No. HO-95-1531				
SPECIAL CONDITIONS				
NOTE - APPROVING AUTHORITIES SHOULD USE SEPARATE SHEET IF NEEDED				

SITE INSPECTION SHEET

OWNER: John Clarke PHONE #: _____
ADDRESS: 2916 Summer Hill Drive CONTRACTOR: J. Mayne
WELL TAG #: 95-1531
SUBDIVISION: Sobus Farms LOT: 18 COUNTY #: _____
PROPOSAL: _____

LOCATION DIAGRAM

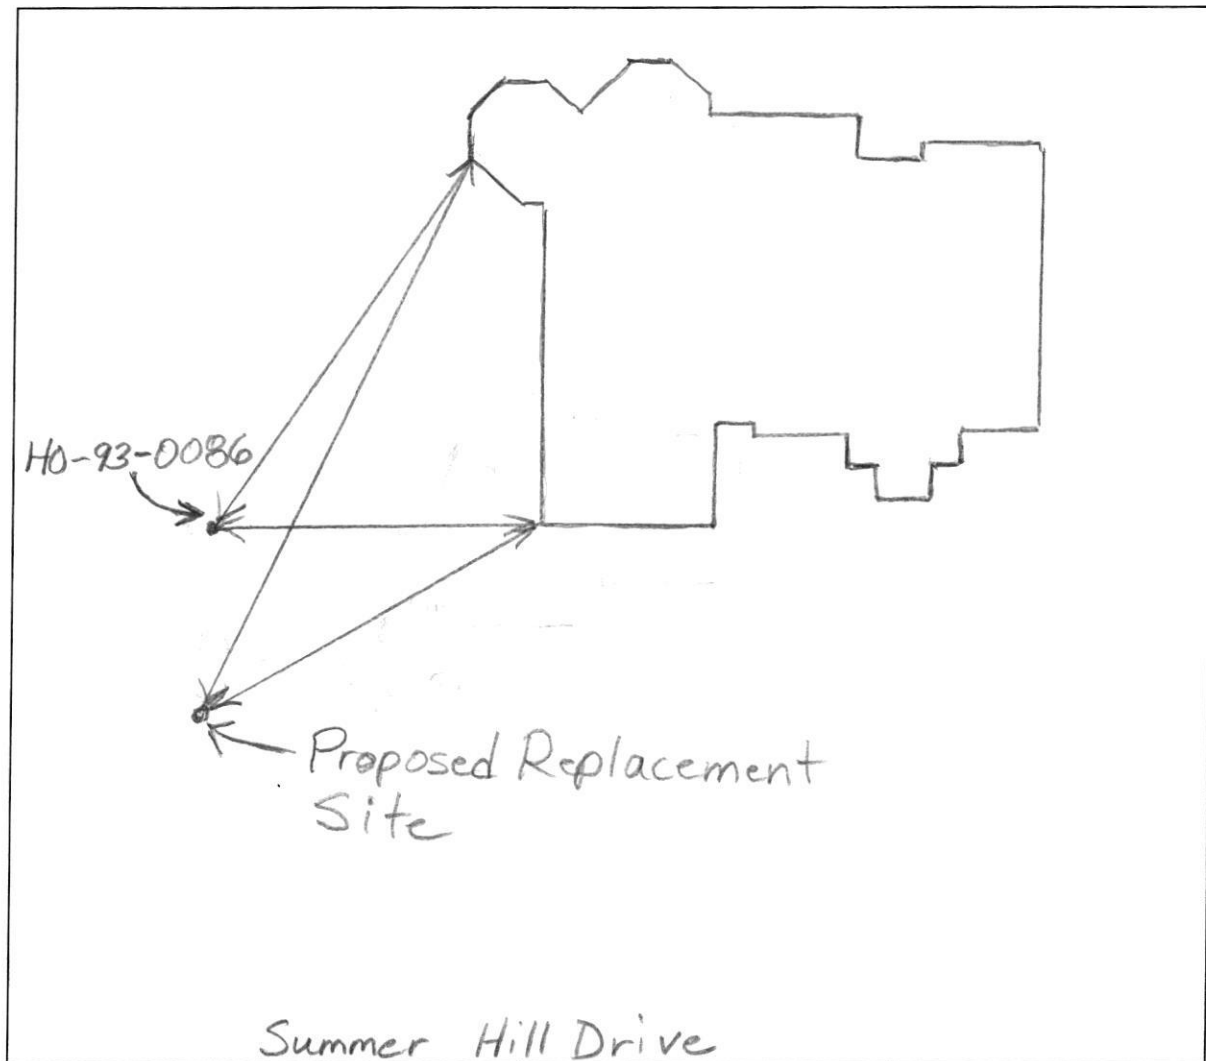

COMMENTS: Site Above Chosen

DATE: 1/25/08 INSPECTOR: Brian Baker