

**COMPLETE THIS FORM WHEN DROPPING OFF ANY  
CORRESPONDENCE AND/OR PLANS TO THE HOWARD COUNTY  
DEPARTMENT OF INSPECTIONS, LICENSES AND PERMITS COUNTER:**

Date: 10/20/2022

To: MICHAEL BLEVINS BUILDING REVIEW  
(Reviewer/Requestor's Name) (Division)

From: NICOLE BUTCHER, TRANSFORMING ARCHITECTURE 301 776 2666  
(Your Name, Company Name) (Phone Number)

Subject: Project name SANYAL RENO & ADDITION  
Project site address 6006 TEN OAKS RD CLARKSVILLE MD 21029  
Permit # B22003316 SDP #                       
Other information pertinent to this project ADDRESSES MR BLEVINS COMMENTS ARE CLIENT REVISIONS/ADD

✓ Please check the attachments below that you are submitting with this transmittal:

- ☒ Letter of response to address plan review comment letter
- ☐ Revised plans and/or revised details: When submitting for a complete re-review, duplicate sets shall be submitted.
- ☐ Letter Summarizing Changes
- ☐ Energy conservation calculations
- ☐ Copies of \_\_\_\_\_ (be specific).  
☐ Health Department Request ☐ DPZ/ DED Request ☐ Applicant's Request
- ☐ Two sets of single-family model plans to be placed on permanent file: Model Name/ # \_\_\_\_\_
- ☒ Other RESPONDING TO MR BLEVINS COMMENTS ARE NEW CLIENT REVISION # SCOPE ADDITION

**Contact Person Information: (Required)**

NICOLE BUTCHER  
Please Print Name

Telephone No: 301 776 2666

E-Mail Address: nicole@transformingarchitecture.com

**PLEASE ASSURE ALL DOCUMENTS AND/OR REVISIONS ARE APPROPRIATELY SIGNED AND SEALED, IF NECESSARY, BY A LICENSED ARCHITECT OR ENGINEER. PLEASE BE ADVISED THAT INSUFFICIENT INFORMATION MAY RESULT IN THE DELAY OF REVIEW BY THE PLANS EXAMINER. THE DEPARTMENT OF INSPECTIONS, LICENSES AND PERMITS WILL CONTACT YOU IF THERE IS A PROBLEM. IN ADDITION, ONCE THE BUILDING PERMIT IS APPROVED BY THE PLAN REVIEW DIVISION AND ALL OTHER REQUIRED SIGNATORY AGENCIES, AND THE BUILDING PERMIT IS READY FOR ISSUANCE, THE PERMIT DIVISION WILL NOTIFY THE APPROPRIATE CONTACT PERSON FOR PERMIT PICK UP. ALL PERMIT STATUS INQUIRIES SHALL BE DIRECTED TO THE PERMIT DIVISION AT 410-313-2455 OPTION #4 OR BY VISITING MYHOWARD.INFO. CODE RELATED QUESTIONS AND PLAN REVIEW INQUIRIES SHALL BE DIRECTED TO THE PLAN REVIEW DIVISION AT 410-313-2436. PLEASE ALLOW A MINIMUM OF FIVE (5) WORKING DAYS FOR ANY PLAN SUBMITTALS TO BE REVIEWED. THANK YOU.**

Received by                     


White-Plan Review / Yellow-Applicant / Pink-Permit Division  
T:\Operations\Updated forms\HoCoTransmittalForm04.2020

**RECEIVED**

OCT 20 2022

LICENSES & PERMITS  
DIVISION



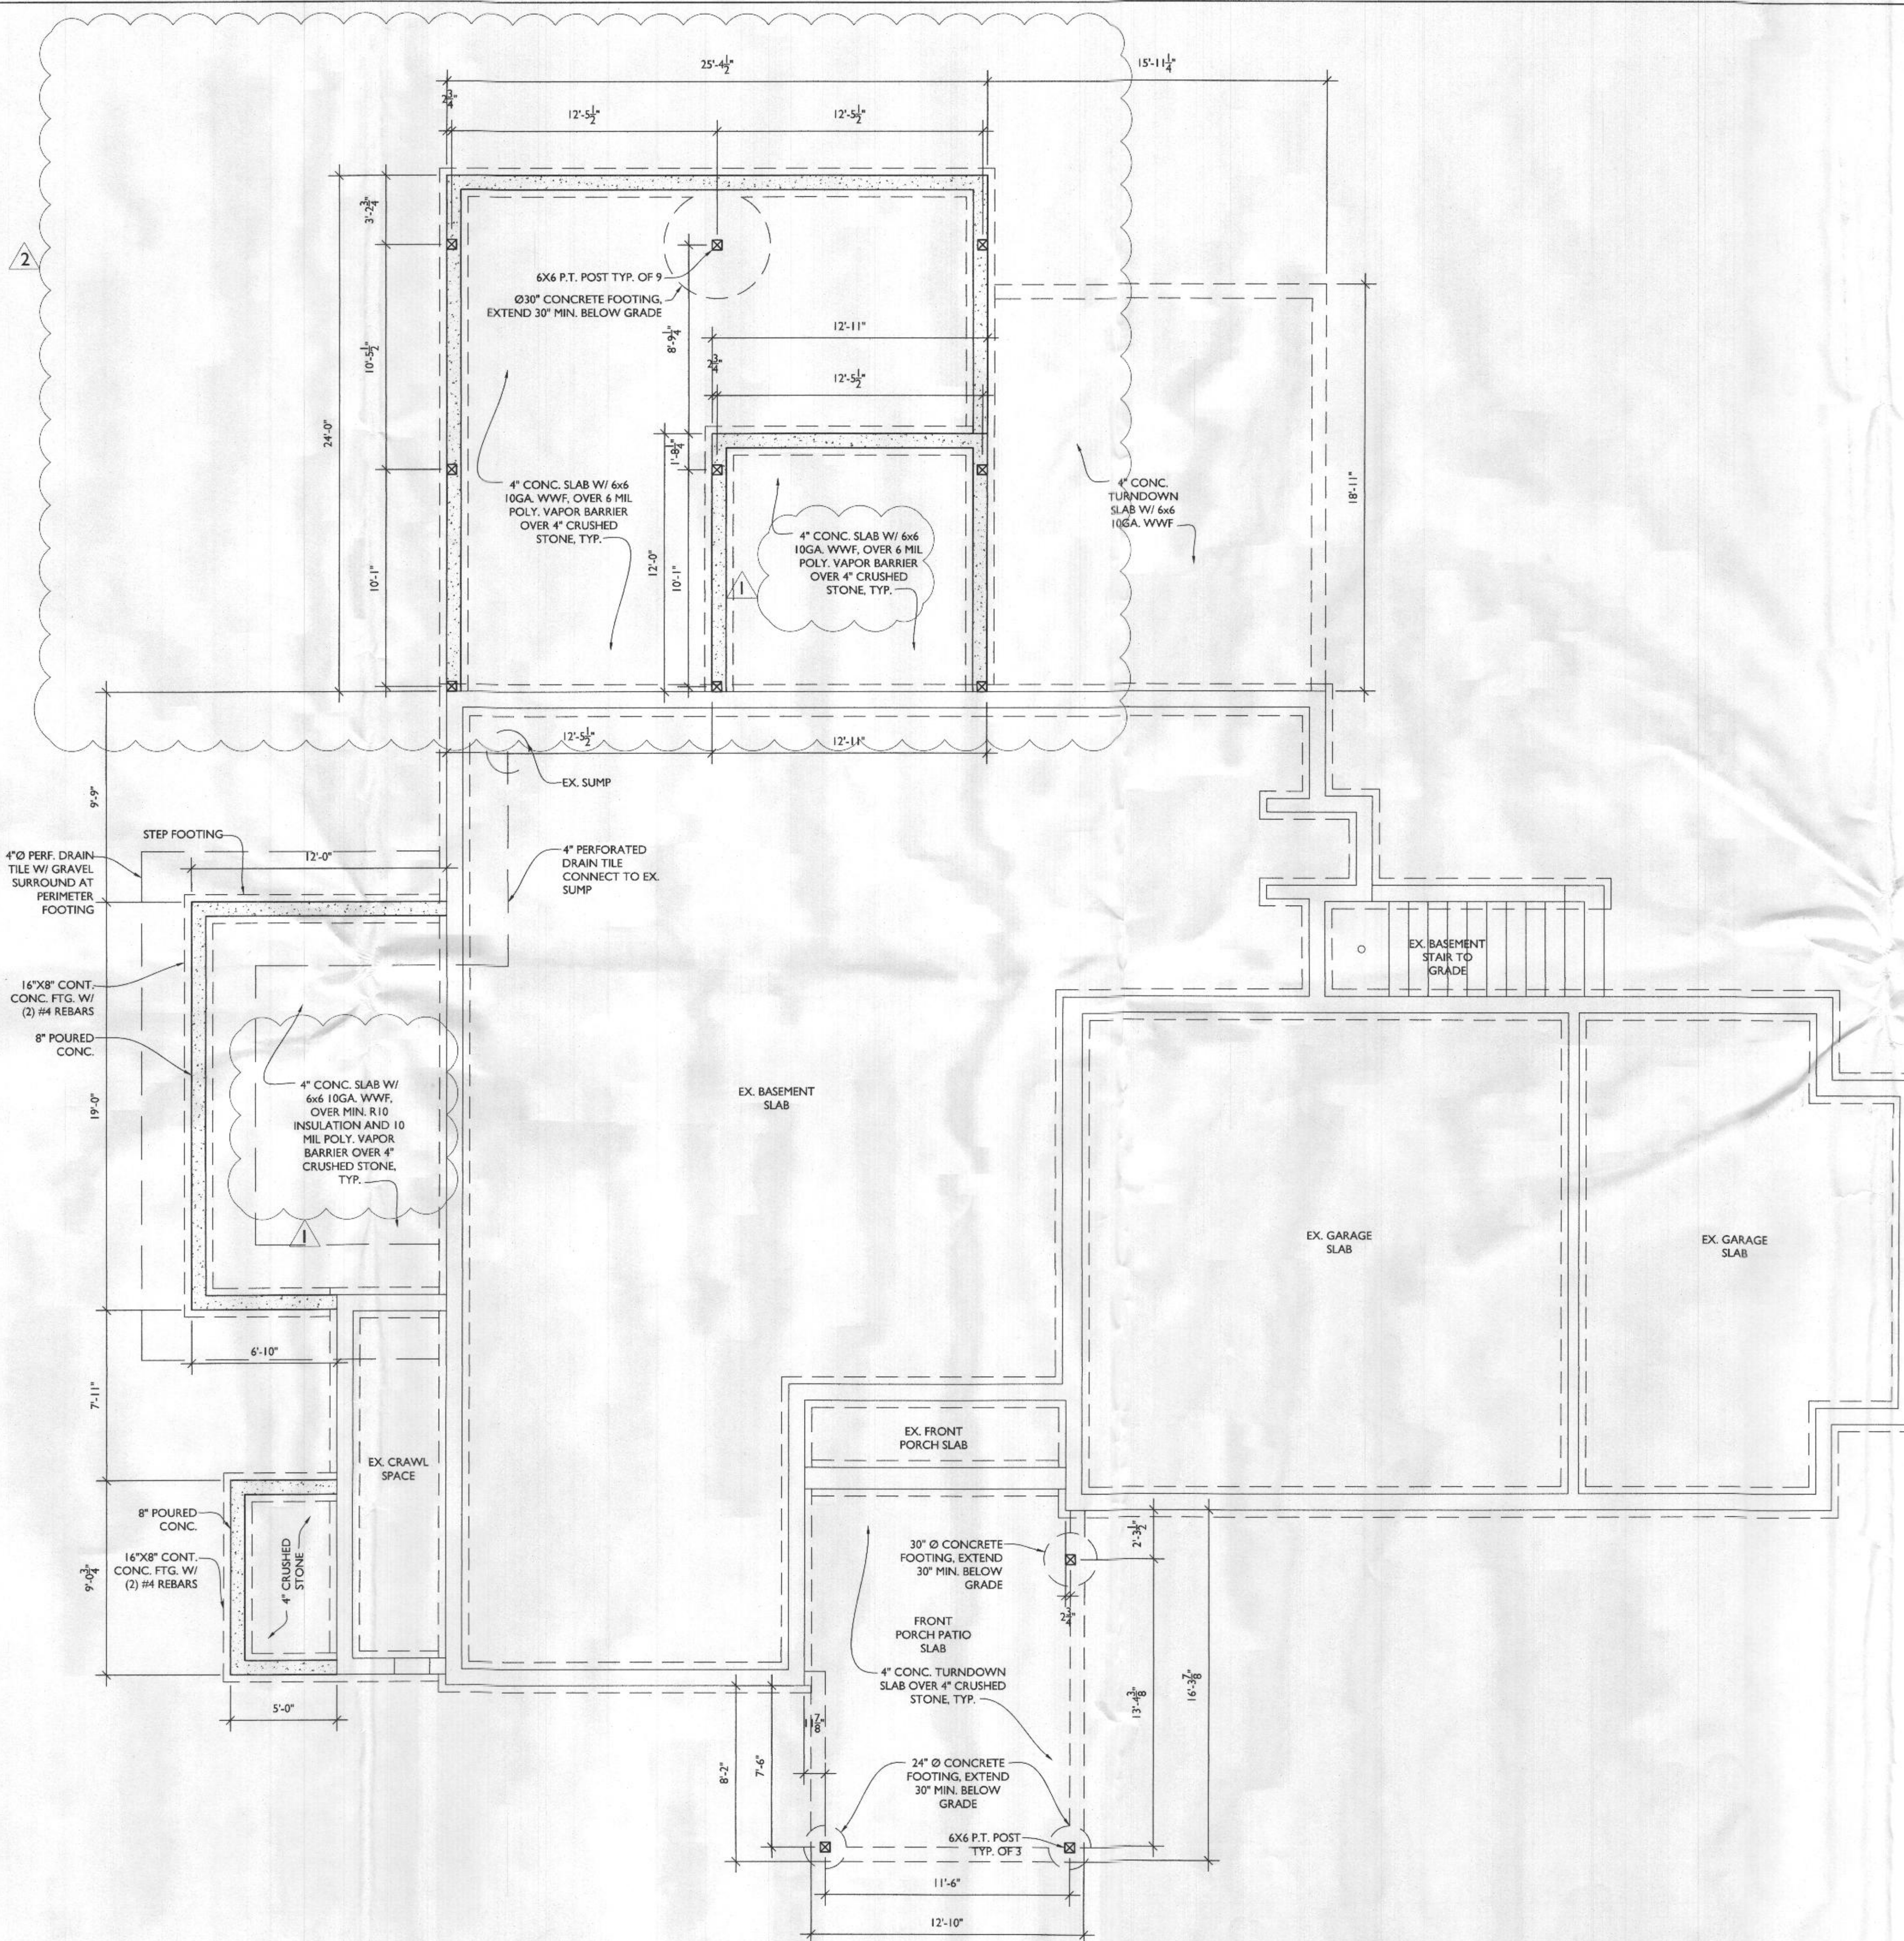

13953 Brighton Dam Road  
Clarksville, MD 21029  
301-776-2666  
info@TransformingArchitecture.com  
www.TransformingArchitecture.com



**STAMP**

I CERTIFY THAT THESE DOCUMENTS WERE PREPARED OR APPROVED BY ME, AND THAT I AM A DULY LICENSED ARCHITECT UNDER THE LAWS OF THE STATE OF MARYLAND, LICENSE NUMBER 13662, EXPIRATION 10-22-2023.

NOTE: THESE DRAWINGS ARE THE PROPERTY OF TRANSFORMING ARCHITECTURE AND, AS SUCH, MAY NOT BE RE-USED OR REPRODUCED, EITHER WHOLLY OR IN PART, WITHOUT PRIOR WRITTEN CONSENT OF TRANSFORMING ARCHITECTURE.

PROJECT PHASE  
**PERMIT**

PROJECT TITLE  
**THE SANYAL RESIDENCE**

6006 Ten Oaks Rd  
Clarksville, MD 21029


REVISIONS		
SYMBOL	DATE	ISSUED FOR
1	10/20/2022	BUILDING REVIEW
2	10/20/2022	ADDED SCOPE

PROJECT NUMBER 19-433  
DATE 08/23/2022  
SCALE AS NOTED


DRAWING TITLE  
**FOUNDATION PLAN**

SHEET NUMBER  
**A-101**




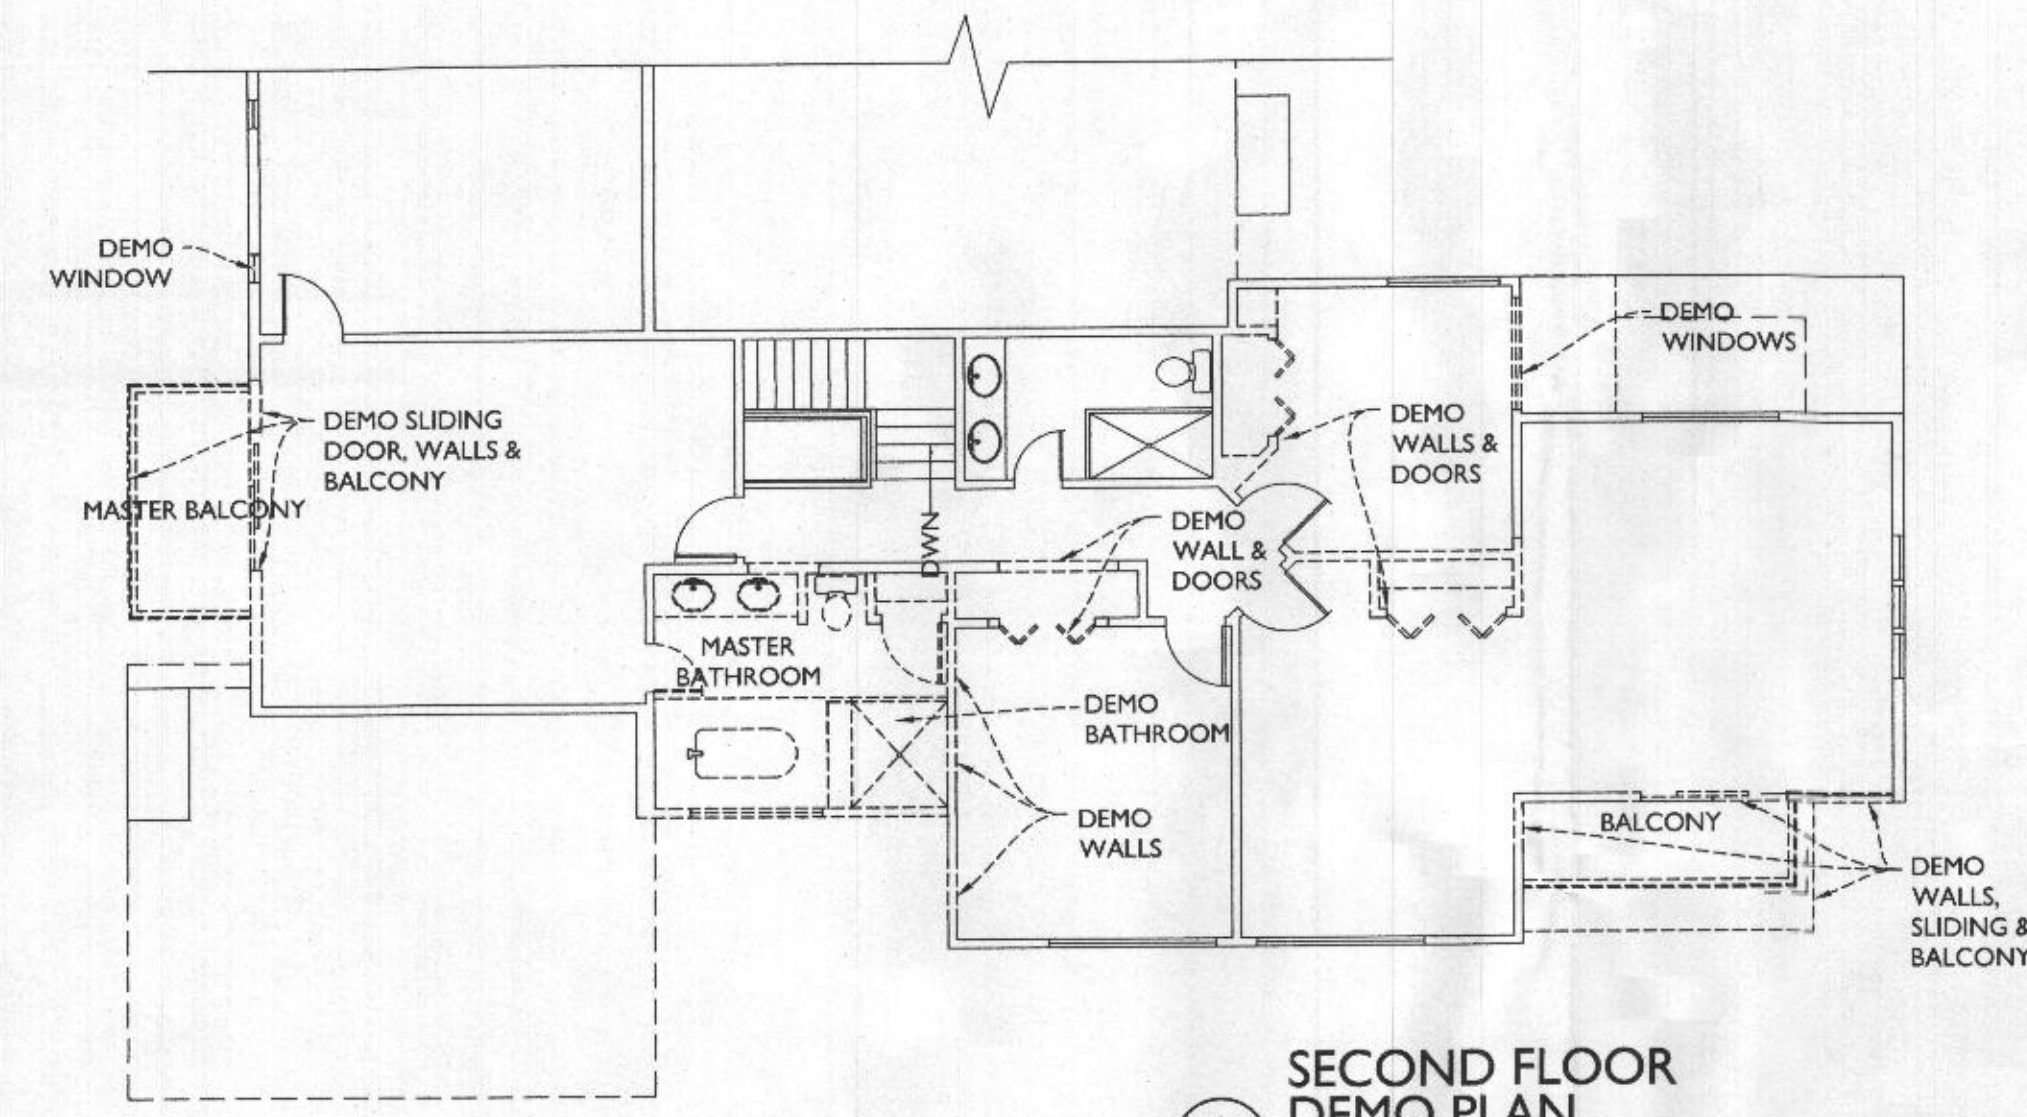


**SECOND FLOOR DEMO PLAN**  
SCALE: 1/8"=1'-0"

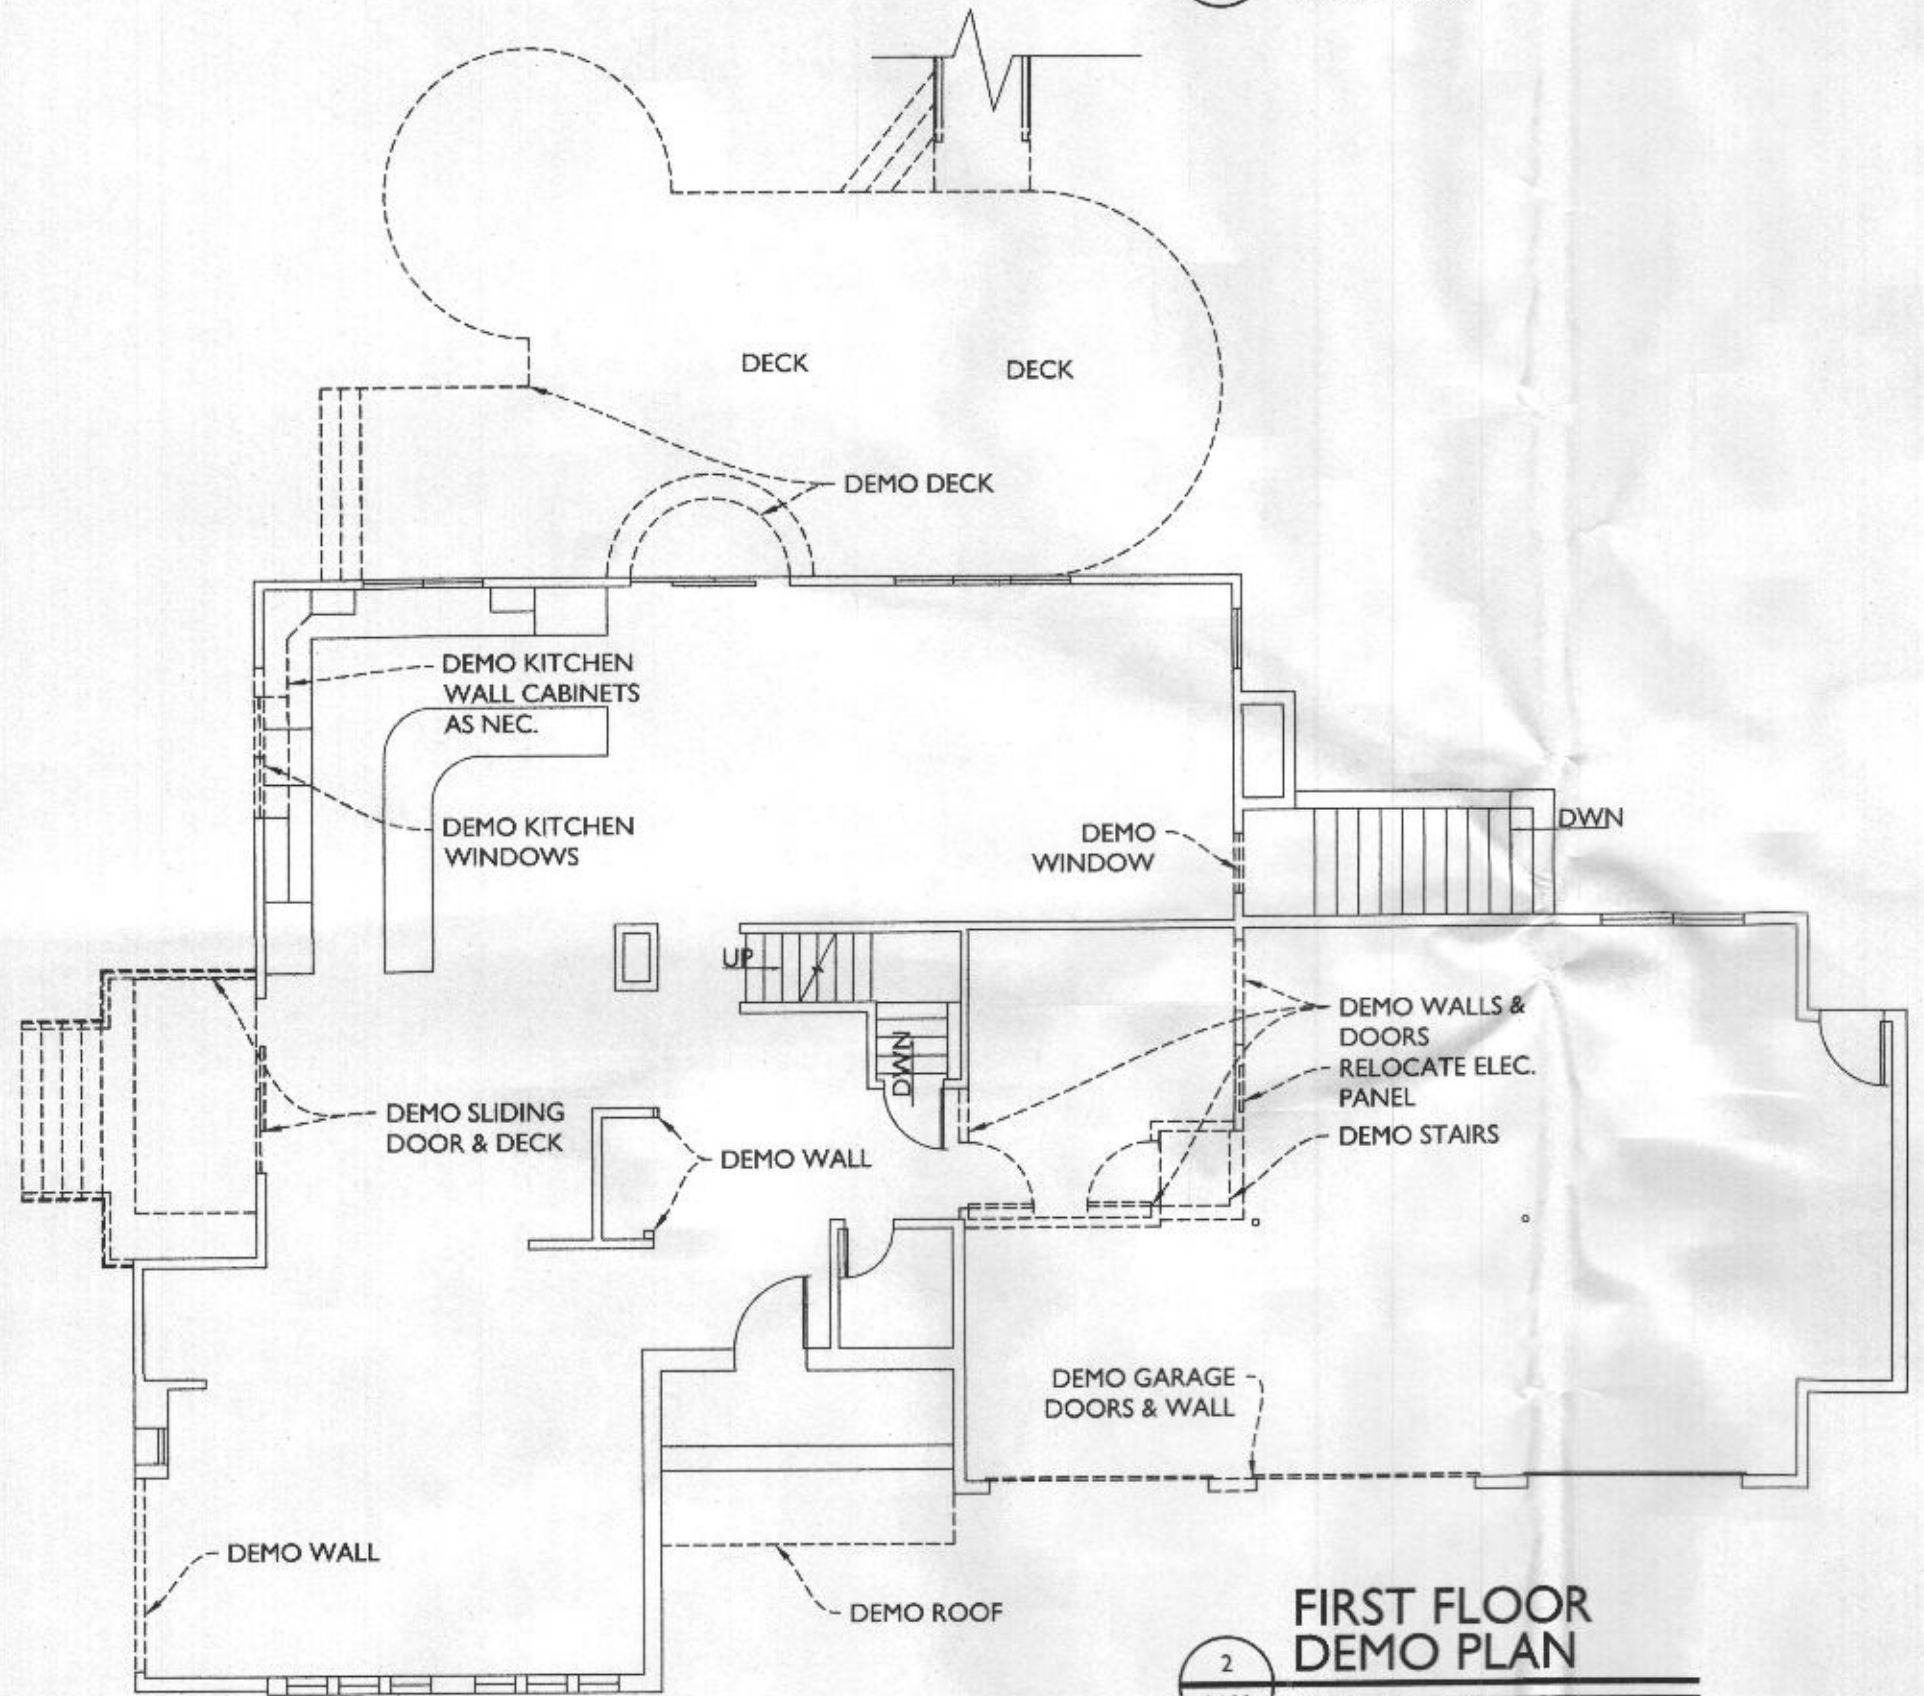

**FIRST FLOOR DEMO PLAN**  
SCALE: 1/8"=1'-0"

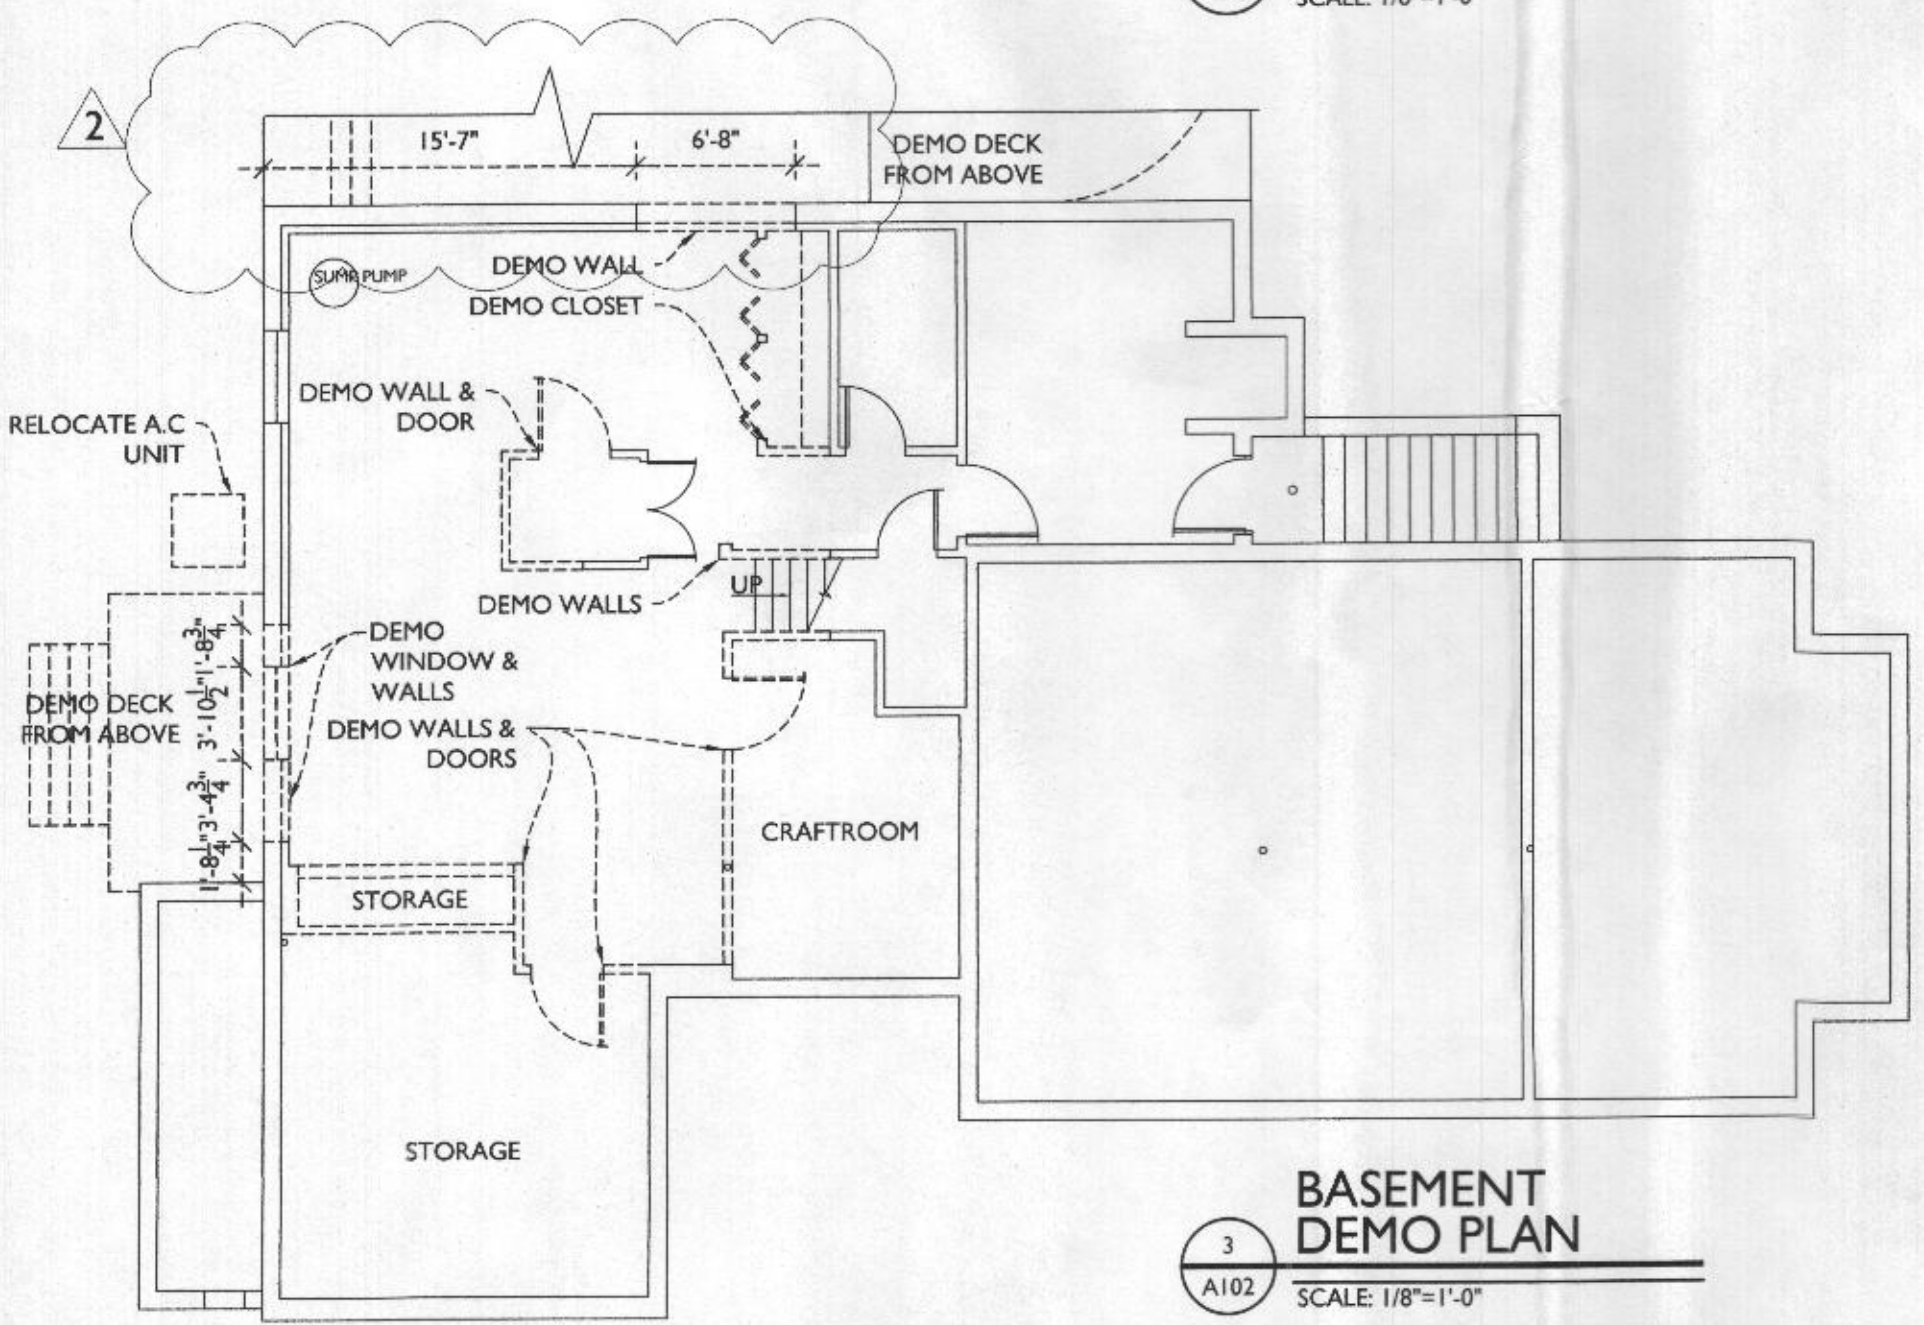

**BASEMENT DEMO PLAN**  
SCALE: 1/8"=1'-0"

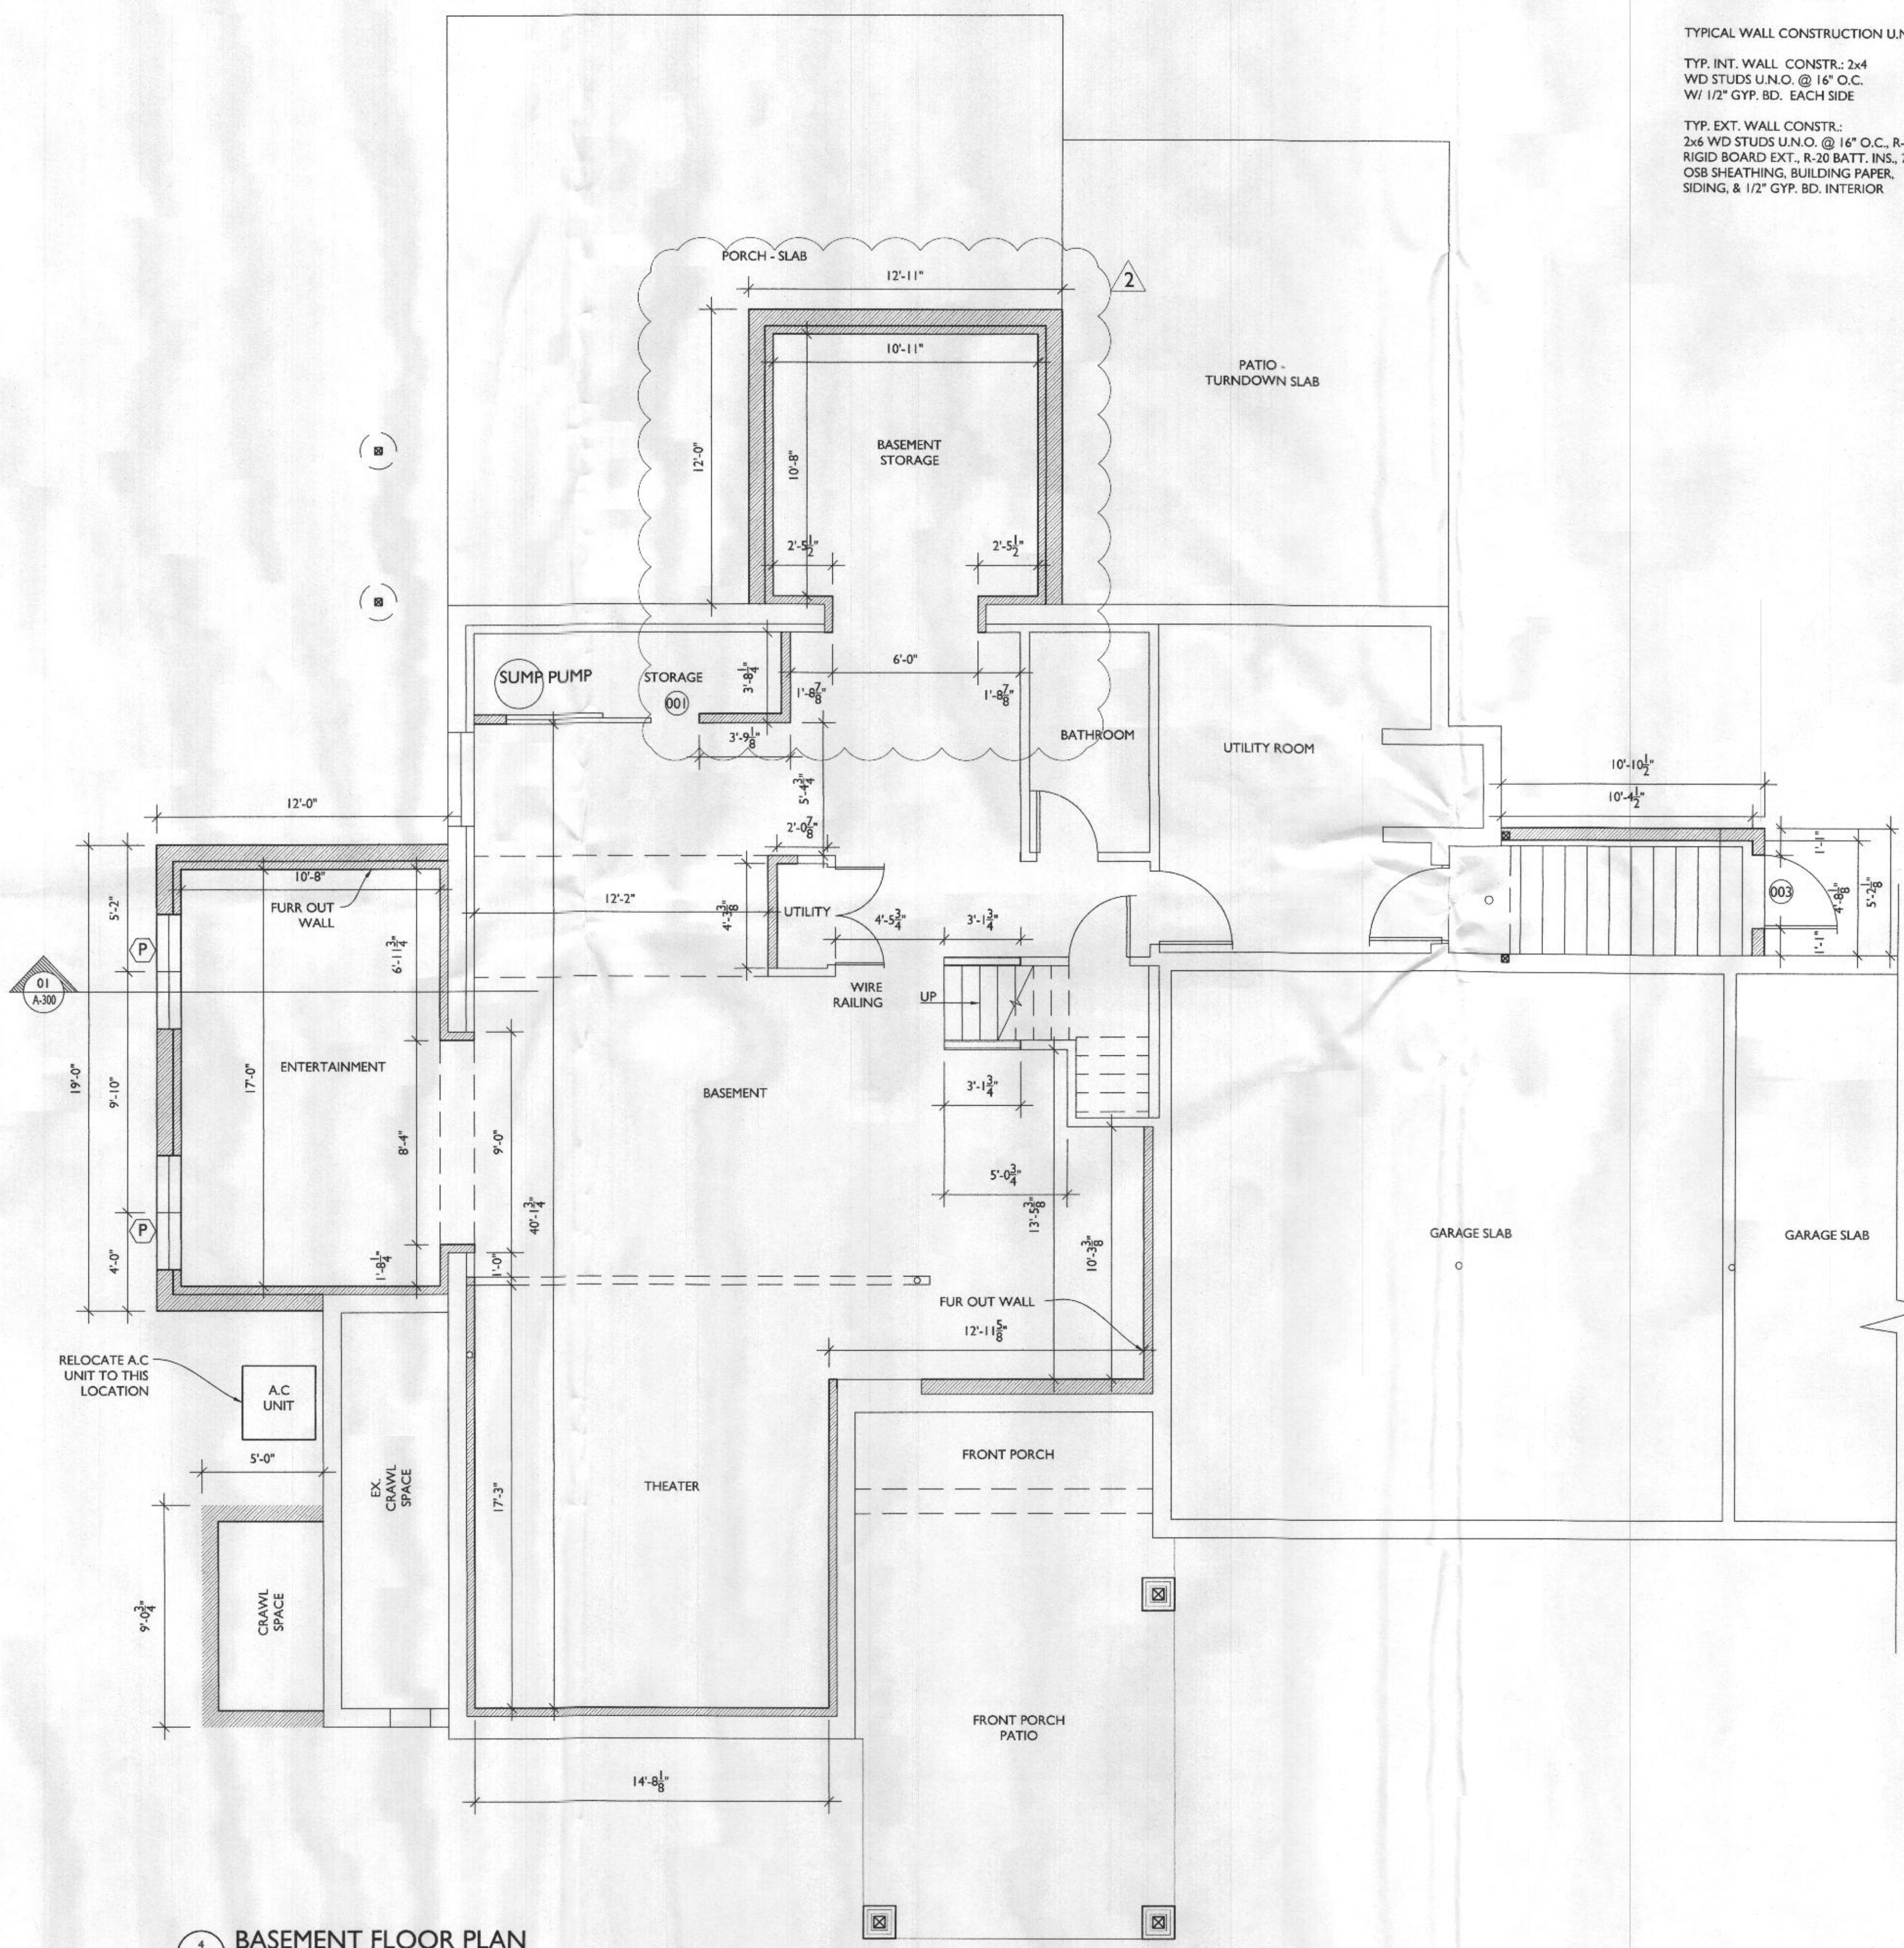

**BASEMENT FLOOR PLAN**  
SCALE: 1/4"=1'-0"

LINE TYPE KEY:  
NEW WALL  
EXIST. WALL  
ABOVE LINE  
FDN. WALL  
DEMO WALL

TYPICAL WALL CONSTRUCTION U.N.O.  
TYP. INT. WALL CONSTR.: 2x4 WD STUDS U.N.O. @ 16" O.C. W/ 1/2" GYP. BD. EACH SIDE  
TYP. EXT. WALL CONSTR.: 2x6 WD STUDS U.N.O. @ 16" O.C., R-5 RIGID BOARD EXT., R-20 BATT. INS., 7/16 OSB SHEATHING, BUILDING PAPER, SIDING, & 1/2" GYP. BD. INTERIOR



13953 Brighton Dam Road  
Clarksville, MD 21029  
301-776-2666  
info@TransformingArchitecture.com  
www.TransformingArchitecture.com



STAMP

I CERTIFY THAT THESE DOCUMENTS WERE PREPARED OR APPROVED BY ME, AND THAT I AM A DULY LICENSED ARCHITECT UNDER THE LAWS OF THE STATE OF MARYLAND. LICENSE NUMBER 13662, EXPIRATION 10-22-2023.

NOTE: THESE DRAWINGS ARE THE PROPERTY OF TRANSFORMING ARCHITECTURE AND, AS SUCH, MAY NOT BE RE-USED OR REPRODUCED, EITHER WHOLLY OR IN PART, WITHOUT PRIOR WRITTEN CONSENT OF TRANSFORMING ARCHITECTURE.

PROJECT PHASE  
**PERMIT**


PROJECT TITLE  
**THE SANYAL RESIDENCE**

6006 Ten Oaks Rd  
Clarksville, MD 21029

REVISIONS		
SYMBOL	DATE	ISSUED FOR
1	10/20/2022	BUILDING REVIEW
2	10/20/2022	ADDED SCOPE

PROJECT NUMBER 19-433  
DATE 08/23/2022  
SCALE AS NOTED  
DRAWING TITLE  
**DEMO PLANS + BASEMENT FLOOR PLAN**  
SHEET NUMBER  
**A-102**



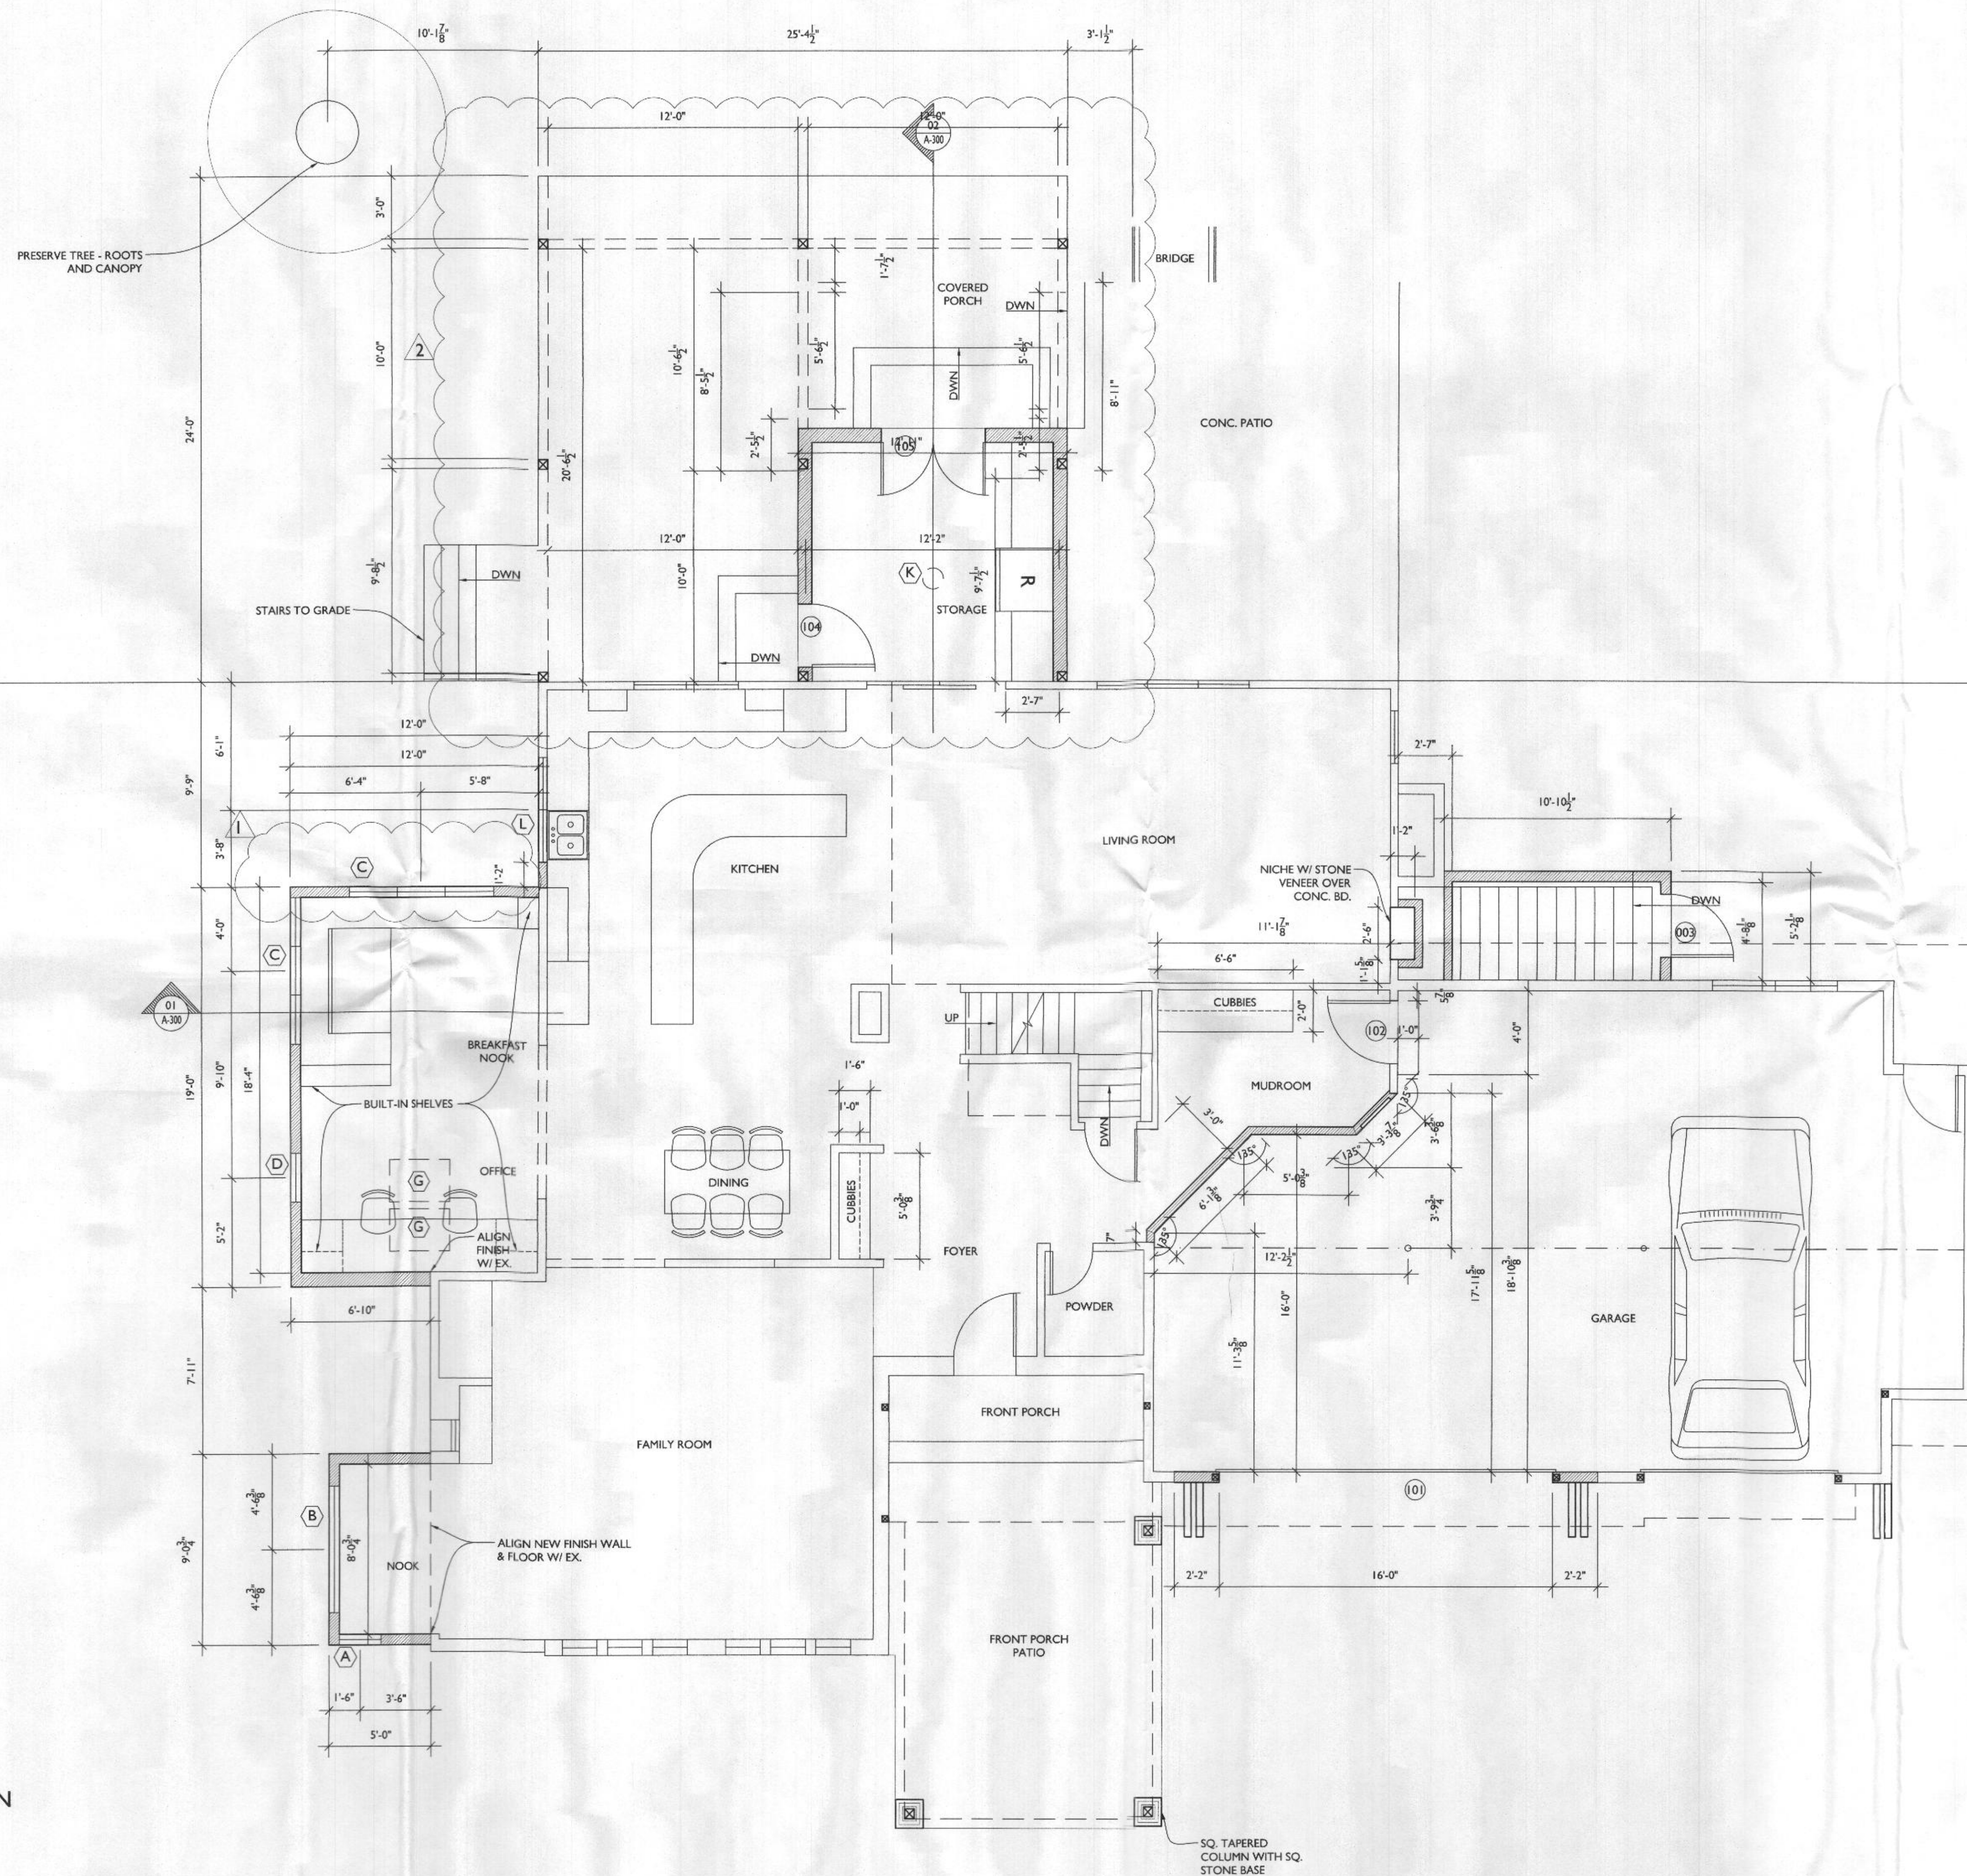

LINE TYPE KEY:  
NEW WALL  
EXIST. WALL  
ABOVE LINE  
FDN. WALL  
DEMO WALL

TYPICAL WALL CONSTRUCTION U.N.O.

TYP. INT. WALL CONSTR.: 2x4  
WD STUDS U.N.O. @ 16" O.C.  
W/ 1/2" GYP. BD. EACH SIDE

TYP. EXT. WALL CONSTR.:  
2x4 WD STUDS U.N.O. @ 16" O.C. R-5  
RIGID BOARD EXT., R-20 BATT. INS., 7/16  
OSB SHEATHING, BUILDING PAPER,  
SIDING, & 1/2" GYP. BD. INTERIOR



13953 Brighton Dam Road  
Clarksville, MD 21029  
301-776-2666  
info@TransformingArchitecture.com  
www.TransformingArchitecture.com



STAMP

I CERTIFY THAT THESE DOCUMENTS WERE  
PREPARED OR APPROVED BY ME, AND THAT I  
AM A DULY LICENSED ARCHITECT UNDER THE  
LAWS OF THE STATE OF MARYLAND, LICENSE  
NUMBER 13662, EXPIRATION 10-22-2023.

NOTE: THESE DRAWINGS ARE THE PROPERTY  
OF TRANSFORMING ARCHITECTURE AND, AS  
SUCH, MAY NOT BE RE-USED OR REPRODUCED,  
EITHER WHOLLY OR IN PART, WITHOUT PRIOR  
WRITTEN CONSENT OF TRANSFORMING  
ARCHITECTURE.

PROJECT PHASE

PERMIT

PROJECT TITLE

THE  
SANYAL  
RESIDENCE

6006 Ten Oaks Rd  
Clarksville, MD 21029

REVISIONS

SYMBOL	DATE	ISSUED FOR
1	10/20/2022	BUILDING REVIEW
2	10/20/2022	ADDED SCOPE

PROJECT NUMBER 19-433

DATE 08/23/2022

SCALE AS NOTED

DRAWING TITLE


FIRST  
FLOOR PLAN

SHEET NUMBER

A-103

1 FIRST FLOOR PLAN  
A103 SCALE: 1/4"=1'-0"



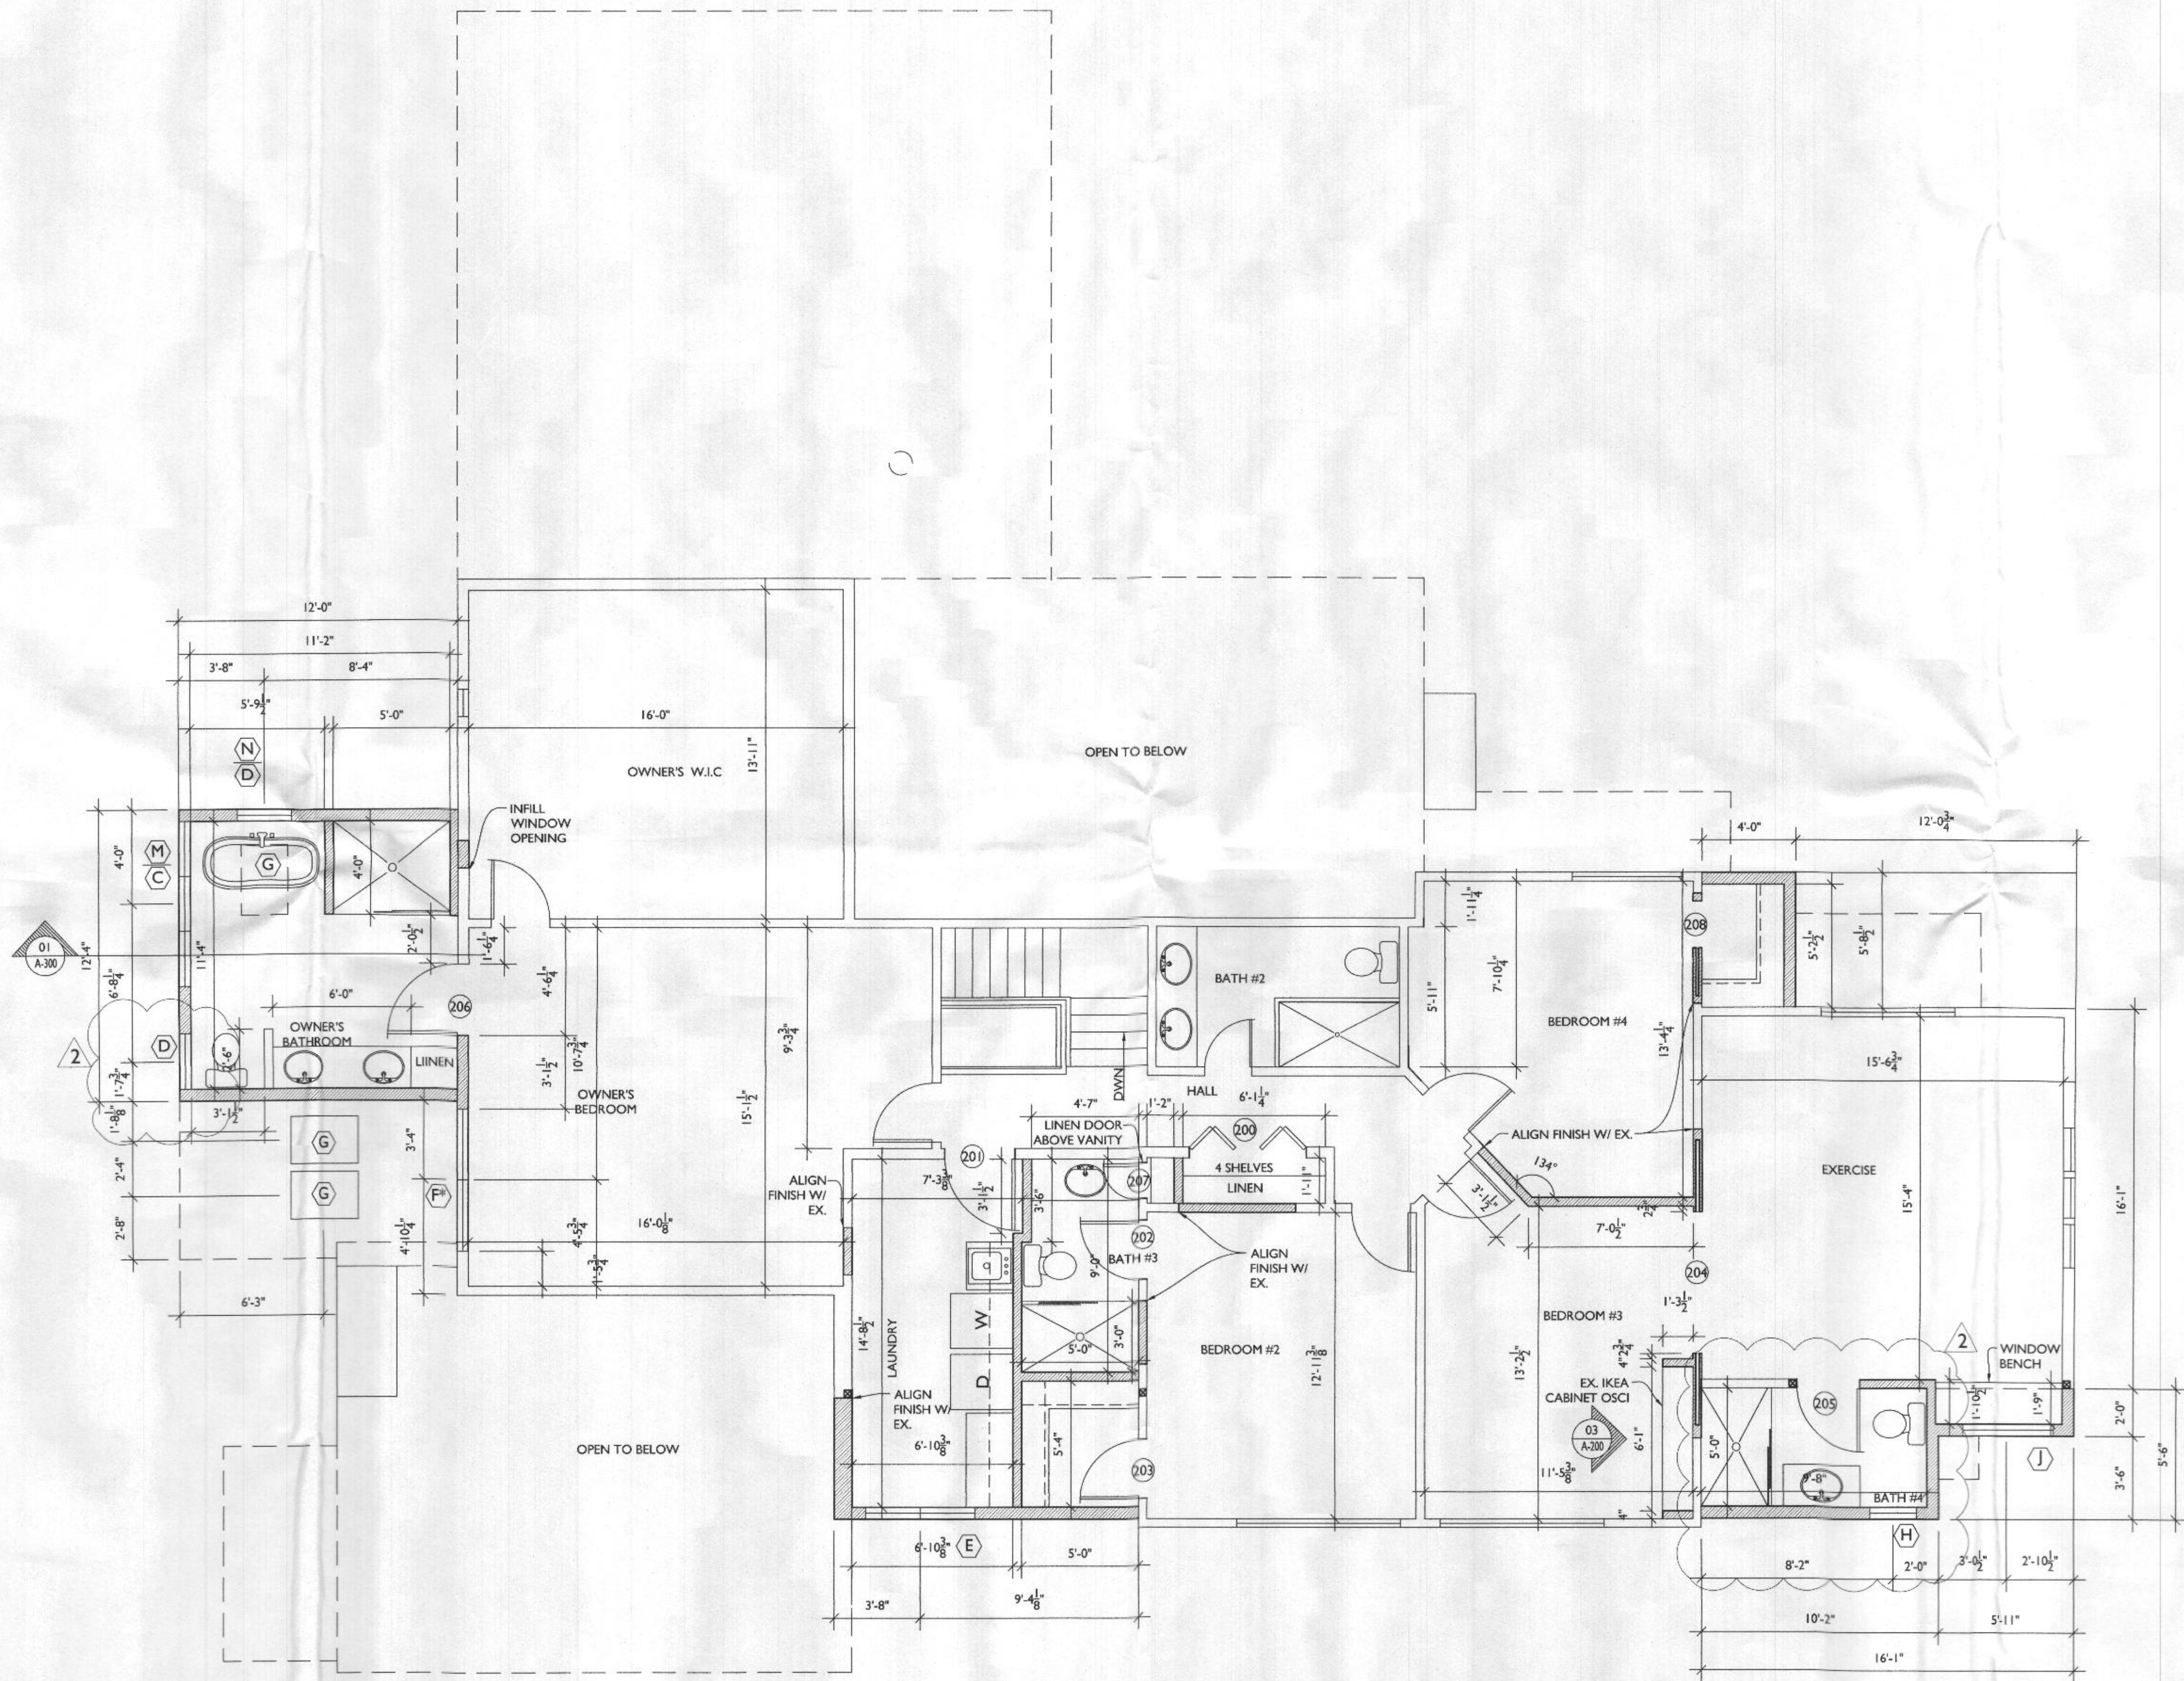

LINE TYPE KEY:  
NEW WALL  
EXIST. WALL  
ABOVE LINE  
FDN. WALL  
DEMO WALL

TYPICAL WALL CONSTRUCTION U.N.O.

TYP. INT. WALL CONSTR.: 2x4  
WD STUDS U.N.O. @ 16" O.C.  
W/ 1/2" GYP. BD. EACH SIDE

TYP. EXT. WALL CONSTR.:  
2x4 WD STUDS U.N.O. @ 16" O.C. R-5  
RIGID BOARD EXT., R-20 BATT. INS., 7/16  
OSB SHEATHING, BUILDING PAPER,  
SIDING, & 1/2" GYP. BD. INTERIOR



13953 Brighton Dam Road  
Clarksville, MD 21029  
301-776-2666  
info@TransformingArchitecture.com  
www.TransformingArchitecture.com



STAMP

I CERTIFY THAT THESE DOCUMENTS WERE  
PREPARED OR APPROVED BY ME, AND THAT I  
AM A DULY LICENSED ARCHITECT UNDER THE  
LAWS OF THE STATE OF MARYLAND, LICENSE  
NUMBER 13662, EXPIRATION 10-22-2023.

NOTE: THESE DRAWINGS ARE THE PROPERTY  
OF TRANSFORMING ARCHITECTURE AND, AS  
SUCH, MAY NOT BE RE-USED OR REPRODUCED,  
EITHER WHOLLY OR IN PART, WITHOUT PRIOR  
WRITTEN CONSENT OF TRANSFORMING  
ARCHITECTURE.

PROJECT PHASE

PERMIT

PROJECT TITLE

THE  
SANYAL  
RESIDENCE

6006 Ten Oaks Rd  
Clarksville, MD 21029

REVISIONS

SYMBOL	DATE	ISSUED FOR
1	10/20/2022	BUILDING REVIEW
2	10/20/2022	ADDED SCOPE

PROJECT NUMBER 19-433

DATE 08/23/2022

SCALE AS NOTED


DRAWING TITLE

SECOND  
FLOOR PLAN

SHEET NUMBER

A-104



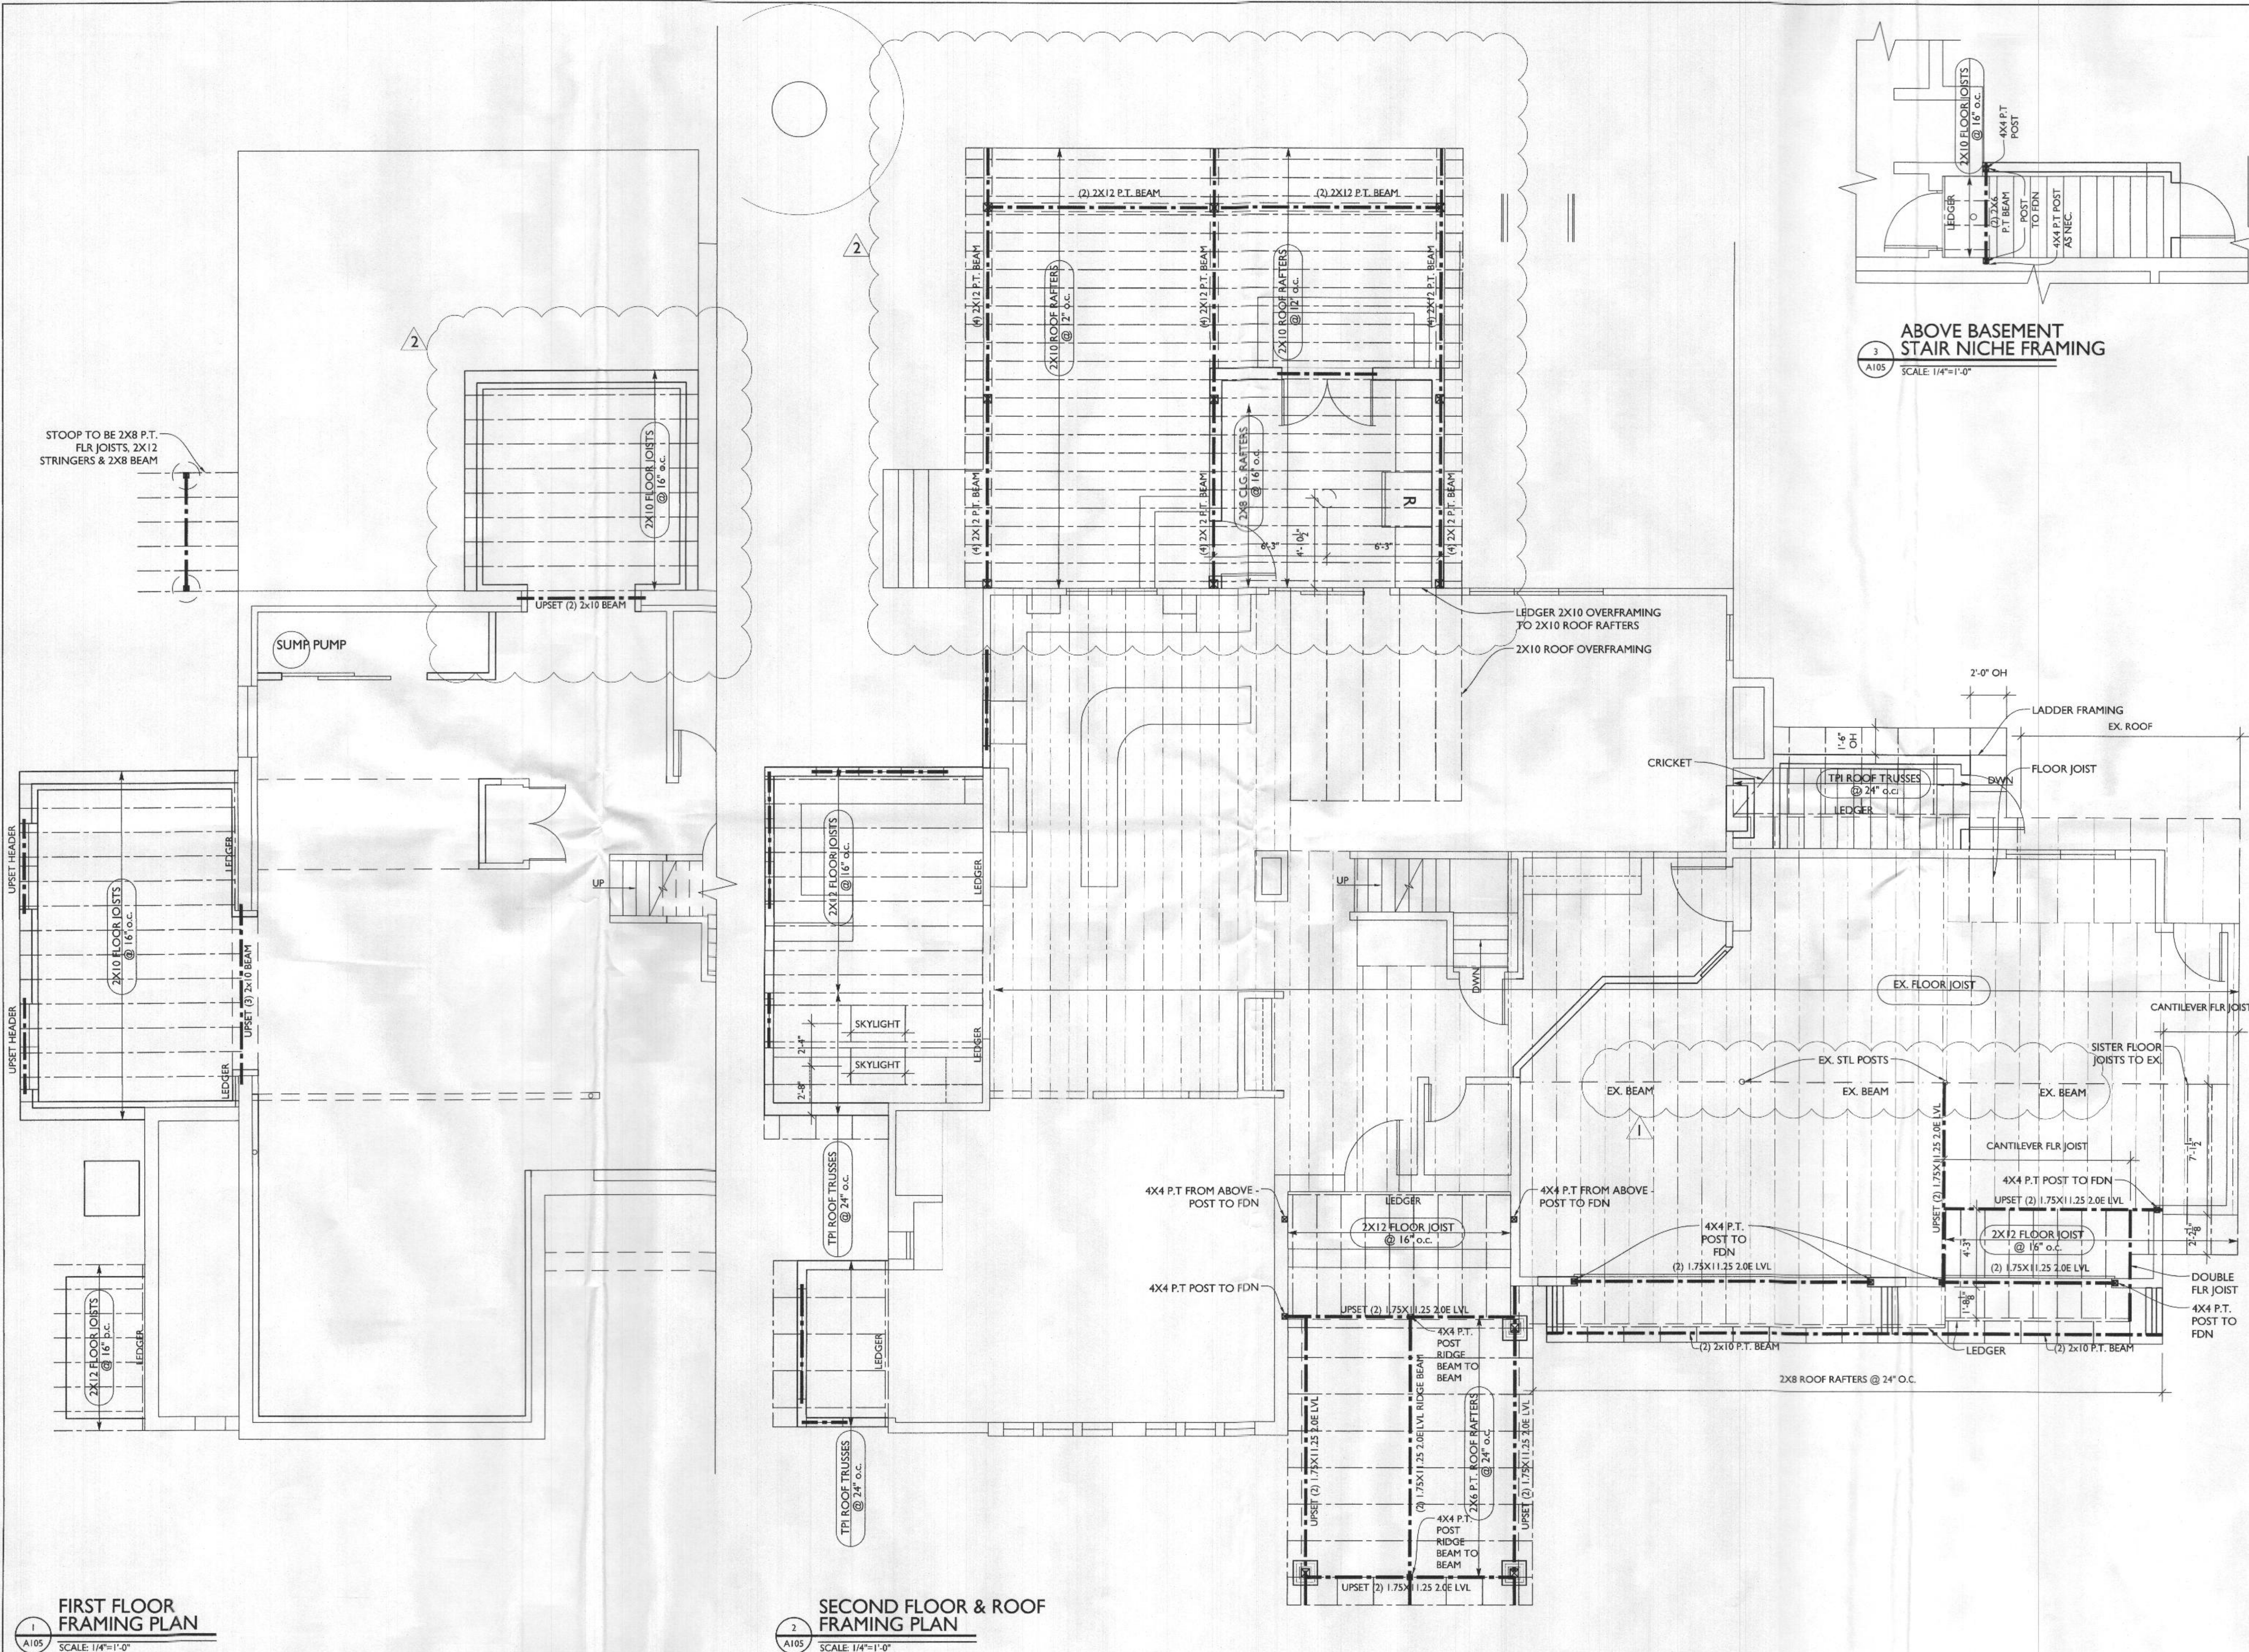

**TRANSFORMING  
ARCHITECTURE**  
■ CUSTOM DESIGNS. FLAT FEES.

13953 Brighton Dam Road  
Clarksville, MD 21029  
301-776-2666  
info@TransformingArchitecture.com  
www.TransformingArchitecture.com

# PERMIT

REVISIONS		
SYMBOL	DATE	ISSUED FOR
1	10/20/2022	BUILDING REVIEW
2	10/20/2022	ADDED SCOPE

PROJECT NUMBER	19-433
DATE	08/23/2022
SCALE	AS NOTED

# FRAMING PLANS

SHEET NUMBER

**A-105**



TABLE R602.3(1)  
FASTENER SCHEDULE FOR STRUCTURAL MEMBERS

ITEM	DESCRIPTION OF BUILDING ELEMENTS	NUMBER AND TYPE OF FASTENER (*a,*b,*c)	SPACING OF FASTENERS
ROOF			
1	BLOCKING BETWEEN JOISTS OR RAFTERS TO TOP PLATE, TOE NAIL	3-8d (2½" x 0.113")	-----
2	CEILING JOISTS TO PLATE, TOE NAIL	3-8d (2½" x 0.113")	-----
3	CEILING JOIST NOT ATTACHED TO PARALLEL RAFTER, LAP OVER PARTITIONS, FACE NAIL	3-10d	-----
4	COLLAR TIE RAFTER, FACE NAIL OR ½" x 20 GAGE RIDGE STRAP	3-10d (3" x 0.128")	-----
5	RAFTER TO PLATE, TOE NAIL	2-16d (¾" x 0.135")	-----
6	ROOF RAFTERS TO RIDGE, VALLEY OR HIP RAFTERS: TOE NAIL FACE NAIL	4-16d (¾" x 0.135") 3-16d (¾" x 0.135")	-----
WALL			
7	BUILT-UP CORNER STUDS	10d (3" x 0.128")	24" o.c.
8	BUILT-UP HEADER, TWO PIECES WITH ½" SPACER	16d (¾" x 0.135")	16" o.c. ALONG EACH EDGE
9	CONTINUED HEADER, TWO PIECES	16d (¾" x 0.135")	16" o.c. ALONG EACH EDGE
10	CONTINUOUS HEADER TO STUD, TOE NAIL	4-8d (2½" x 0.113")	-----
11	DOUBLE STUDS, FACE NAIL	10d (3" x 0.128")	24" o.c.
12	DOUBLE TOP PLATES, FACE NAIL	10d (3" x 0.128")	24" o.c.
13	DOUBLE TOP PLATES, MINIMUM 48-INCH OFFSET OF END JOINTS, FACE NAIL IN LAPPED AREA	8-16d (¾" x 0.135")	-----
14	SOLE PLATE TO JOIST OR BLOCKING, FACE NAIL	16d (¾" x 0.135")	16" o.c.
15	SOLE PLATE TO JOIST OR BLOCKING AT BRACED WALL PANELS	3-16d (¾" x 0.135")	16" o.c.
16	STUD TO SOLE PLATE, TOE NAIL	3-8d (2½" x 0.113") OR 2-16d (¾" x 0.135")	-----
17	TOP OR SOLE PLATE TO STUD, END NAIL	2-16d (¾" x 0.135")	-----
18	TOP PLATES, LAPS AT CORNERS AND INTERSECTIONS, FACE NAIL	3-10d (3" x 0.128")	-----
19	1" BRACE TO EACH STUD AND PLATE, FACE NAIL	2-8d (2½" x 0.113") 2 STAPLES 1½"	-----
20	1" x 6" SHEATHING TO EACH BEARING, FACE NAIL	2-8d (2½" x 0.113") 2 STAPLES 1½"	-----
21	1" x 8" SHEATHING TO EACH BEARING, FACE NAIL	2-8d (2½" x 0.113") 2 STAPLES 1½"	-----
22	WIDER THAN 1" x 8" SHEATHING TO EACH BEARING, FACE NAIL	3-8d (2½" x 0.113") 3 STAPLES 1½"	-----
FLOOR			
23	JOIST TO SILL OR GIRDER, TOE NAIL	3-8d (2½" x 0.113")	-----
24	1" x 6" SUBFLOOR OR LESS TO EACH JOIST, FACE NAIL	2-8d (2½" x 0.113") 2 STAPLES 1½"	-----
25	2" SUBFLOOR TO JOIST OR GIRDER, BLIND AND FACE NAIL	2-16d (¾" x 0.135")	-----
26	RIM JOIST TO TOP PLATE, TOE NAIL (ROOF APPLICATIONS ALSO)	8d (2½" x 0.113")	6" o.c.
27	2" PLANKS (PLANK & BEAM - FLOOR & ROOF)	2-16d (¾" x 0.135")	AT EACH BEARING
28	BUILT-UP GIRDERS AND BEAMS, 2 INCH LUMBER LAYERS	10d (3" x 0.128")	NAIL EACH LAYER AS FOLLOWS: 32" o.c. AT TOP AND BOTTOM AND STAGGERED, TWO NAILS AT ENDS AND AT EACH SPLICE.
29	LEDGER STRIP SUPPORTING JOISTS OR RAFTERS	3-16d (¾" x 0.135")	AT EACH JOIST OR RAFTER

TABLE R602.3(1) - CONTINUED  
FASTENER SCHEDULE FOR STRUCTURAL MEMBERS

ITEM	DESCRIPTION OF BUILDING ELEMENTS	NUMBER AND TYPE OF FASTENER (*b,*c,*e)	SPACING OF FASTENERS
WOOD STRUCTURAL PANELS, SUBFLOOR, ROOF AND INTERIOR WALL SHEATHING TO FRAMING AND PARTICLEBOARD WALL SHEATHING TO FRAMING			
30	¾"-½"	6d common (2" x 0.113") nail (subfloor wall) <sup>f</sup> 8d common (2½" x 0.131") nail (roof)	6 12" g
31	¾"-½"	6d common (2" x 0.113") nail (subfloor, wall) 8d common (2½" x 0.131") nail (roof) <sup>f</sup>	6 12" g
32	1½"-1"	8d common (2½" x 0.131")	6 12" g
33	1½"-1½"	10d common (3" x 0.148") nail or 8d common (2½" x 0.131") deformed nail	6 12
OTHER WALL SHEATHING <sup>h</sup>			
34	½" STRUCTURAL CELLULOSIC FIBERBOARD SHEATHING	½" galvanized roofing nail, ¼" crown or 1" crown staple 16ga., 1½" long	3 6
35	¾" STRUCTURAL CELLULOSIC FIBERBOARD SHEATHING	1½" galvanized roofing nail, ¼" crown or 1" crown staple 16ga., 1½" long	3 6
36	½" GYPSUM SHEATHING <sup>d</sup>	1½" galvanized roofing nail, staple galvanized, 1½" long; 1½" screws, Type W or S	7 7
37	¾" GYPSUM SHEATHING <sup>d</sup>	1½" galvanized roofing nail; staple galvanized, 1½" long; 1½" screws, Type W or S	7 7
WOOD STRUCTURAL PANELS, COMBINATION SUBFLOOR UNDERLAYMENT TO FRAMING			
38	¾" AND LESS	6d deformed (2" x 0.120") nail or 8d common (2½" x 0.131") nail	6 12
39	¾"-1"	8d common (2½" x 0.131") nail or 8d deformed (2½" x 0.120") nail	6 12
40	1½"-1½"	10d common (3" x 0.148") nail or 8d deformed (2½" x 0.120") nail	6 12

- \*a - All nails are smooth-common, box or deformed shanks except where otherwise stated. Nails used for framing and sheathing connections have minimum average bending yield strengths as shown: 80 ksi for shank diameter of 0.192 inch (20d common nail), 90 ksi for shank diameters larger than 0.142 inch but not larger than 0.177 inch, and 100 ksi for shank diameters of 0.142 inches or less.
- \*b - Staples are 16 ga. wire and have a minimum ¼ inch on diameter crown width.
- \*c - Nails shall be spaced at not more than 6 inches on center at all supports where spans are 48 inches or greater.
- \*d - Four-foot-by-8-foot or 4-foot-by-9-foot panels shall be applied vertically.
- \*e - Spacing of fasteners not included in this table shall be based on Table R602.3(2).
- \*f - For regions having a basic wind speed of 110mph or greater, 8d deformed (2½" x 0.120") nails shall be used for attaching plywood and wood structural panel roof sheathing to framing within minimum 48-inch distance from gable end walls, if mean roof height is more than 25 feet, up to 35 feet maximum.
- \*g - For regions having a basic wind speed of 100mph or less, nails for attaching wood structural panel roof sheathing to gable end wall framing shall be spaced 6 inches on center. When basic wind speed is greater than 100mph, nails for attaching panel roof sheathing to intermediate supports shall be spaced 6 inches on center for minimum 48-inch distance from ridges, eaves and gable end walls; and 4-inches on center to gable end wall framing.
- \*h - Gypsum sheathing shall conform to ASTM C 1396 and shall be installed in accordance with GA 253. Fiberboard sheathing shall conform to ASTM C 208.
- \*i - Spacing of fasteners on floor sheathing panel edges applies to panel edges supported by framing members and required blocking and at all floor perimeters only. Spacing of fasteners on roof sheathing panel edges applies to panel edges supported by framing members and required blocking. Blocking of roof or floor sheathing panel edges perpendicular to the framing members need not be provided except as required by other provisions of this code. Floor perimeter shall be supported by framing members or solid blocking.

TABLE R602.10.4.1  
BRACING METHODS

METHOD	MATERIAL	MINIMUM THICKNESS	CONNECTION CRITERIAL
CS-WSP	WOOD STRUCTURAL PANEL	¾"	6d common (2" x 0.113") nails at 6" spacing (panel edges) and at 12" spacing (intermediate supports) or 16ga. x 1½ staples at 3" spacing (panel edges) and 6" spacing (intermediate supports)
CS-G	WOOD STRUCTURAL PANEL ADJACENT TO GARAGE OPENINGS AND SUPPORTING ROOF LOAD ONLY <sup>a,*b</sup>	¾"	See Method CS-WSP
CS-PF	CONTINUOUS PORTAL FRAME	See Section R602.10.4.1.1	See section R602.10.4.1.1


- <sup>a</sup> - Applies to one wall of a garage only.  
<sup>b</sup> - Roof covering dead loads shall be 3 psf or less.

TABLE N1102.4.1.1  
AIR BARRIER AND INSULATION INSPECTION

COMPONENT	CRITERIA
AIR BARRIER AND THERMAL BARRIER	EXTERIOR THERMAL ENVELOPE INSULATION FOR FRAMED WALLS IS INSTALLED IN SUBSTANTIAL CONTACT AND CONTINUOUS ALIGNMENT WITH BUILDING ENVELOPE AIR BARRIER. BREAKS OR JOINTS IN THE AIR BARRIER ARE FILLED OR REPAIRED. AIR-PERMEABLE INSULATION IS NOT USED AS A SEALING MATERIAL.
CEILING/ ATTIC	AIR BARRIER IN ANY DROPPED CEILING/ SOFFIT IS SUBSTANTIALLY ALIGNED WITH INSULATION AND ANY GAPS ARE SEALED. ATTIC ACCESS (EXCEPT UNVENTED ARRIC), KNEE WALL DOOR, OR DROP DOWN STAIR IS SEALED.
WALLS	CORNERS AND HEADERS ARE INSULATED. JUNCTION OF FOUNDATION AND SILL PLATE IS SEALED.
WINDOWS AND DOORS	SPACE BETWEEN WINDOW/ DOOR JAMBS AND FRAMING IS SEALED.
RIM JOISTS	RIM JOISTS ARE INSULATED AND INCLUDE AN AIR BARRIER.
FLOORS (including above garage and cantilevered floors)	INSULATION IS INSTALLED TO MAINTAIN PERMANENT CONTACT WITH UNDERSIDE OF SUBFLOOR DECKING. AIR BARRIER IS INSTALLED AT ANY EXPOSED EDGE OF FLOOR.
CRAWLSPACE WALLS	INSULATION IS PERMANENTLY ATTACHED TO WALLS. EXPOSED EARTH IN UNVENTED CRAWLSPACES IS COVERED WITH CLASS I VAPOR RETARDER WITH OVERLAPPING JOINTS TAPED.
SHAFTS, PENETRATIONS	DUCT SHAFTS, UTILITY PENETRATIONS, KNEE WALLS AND FLUE SHAFTS OPENING TO EXTERIOR OR UNCONDITIONED SPACE ARE SEALED.
NARROW CAVITIES	BATTS IN NARROW CAVITIES ARE CUT TO FIT, OR NARROW CAVITIES ARE FILLED BY SPRAYED/ BLOWN INSULATION.
GARAGE SEPARATION	AIR SEALING IS PROVIDED BETWEEN THE GARAGE AND CONDITIONED SPACES.
RECESSED LIGHTING	RECESSED LIGHT FIXTURES ARE AIRTIGHT, IC RATED AND SEALED TO DRYWALL. EXCEPTION --- FIXTURES IN CONDITIONED SPACE.
PLUMBING AND WIRING	INSULATION IS PLACED BETWEEN OUTSIDE AND PIPED. BATT INSULATION IS CUT TO FIT AROUND WIRING AND PLUMBING, OR SPRAYED/BLOWN INSULATION EXTENDS BEHIND PIPING AND WIRING.
SHOWER/TUB ON EXTERIOR WALL	SHOWERS AND TUBS ON EXTERIOR WALLS HAVE INSULATION AND AN AIR BARRIER SEPARATING THEM FROM THE EXTERIOR WALL.
ELECTRICAL/PHONE BOX ON EXTERIOR WALL	AIR BARRIER EXTENDS BEHIND BOXES OR AIR SEALED TYPE BOXES ARE INSTALLED.
COMMON WALL	AIR BARRIER IS INSTALLED IN COMMON WALL BETWEEN DWELLING UNITS.
HVAC REGISTER BOOTS	HVAC REISTER BOOTS THAT PENETRATE BUILDING ENVELOPE ARE SEALED TO SUBFLOOR OR DRYWALL.
FIREPLACE	FIREPLACE WALLS INCLUDE AN AIR BARRIER.

PRESCRIPTIVE COMPONENT REQUIREMENTS - METHOD 1

- BASED ON R-VALUES OR U-FACTORS
1. THE EXACT LOCATION OF ALL OF THE BUILDING THERMAL ENVELOPE SHALL BE MARKED OUT ON THE PLANS, DETAILS, AND CROSS-SECTIONS.
2. PROVIDE ALL INSULATION R-VALUES OR U-FACTORS, MATERIAL, AND LOCATIONS TO BE INSTALLED (WALLS, CEILINGS, CANTILEVER FLOORS, FLOORS OVER GARAGE, CRAWL SPACE, BASEMENT WALLS, ETC.) PER TABLES 402.1.1 OR 402.1.3 OR 402.2.5 FOR STEEL-FRAMED CONSTRUCTION.
3. PROVIDE ALL FENESTRATION U-FACTORS FOR ALL GLAZING FOR EACH WINDOW AND DOOR PER TABLE 402.1.1 (SCHEDULE SUPPLIED BY DESIGNER)
4. INDICATE HOW ALL AREAS LISTED IN SECTION 402.4.2 (TABLE) WILL BE PROTECTED AGAINST AIR LEAKAGE.
5. INDICATE IF CRAWLSPACE(S) ARE CONDITIONED OR VENTED, MUST HAVE VAPOR BARRIER IF CONDITIONED.
6. INDICATE DUCT INSULATION R-VALUES, MINIMUM R-6, R-8 IN ATTICS.
7. INDICATE DUCT SEALING METHODS PER IRC M1601.4.1
8. INDICATE LOCATION OF HVAC EQUIPMENT ON PLANS (INSIDE OR OUTSIDE THE ENVELOPE)

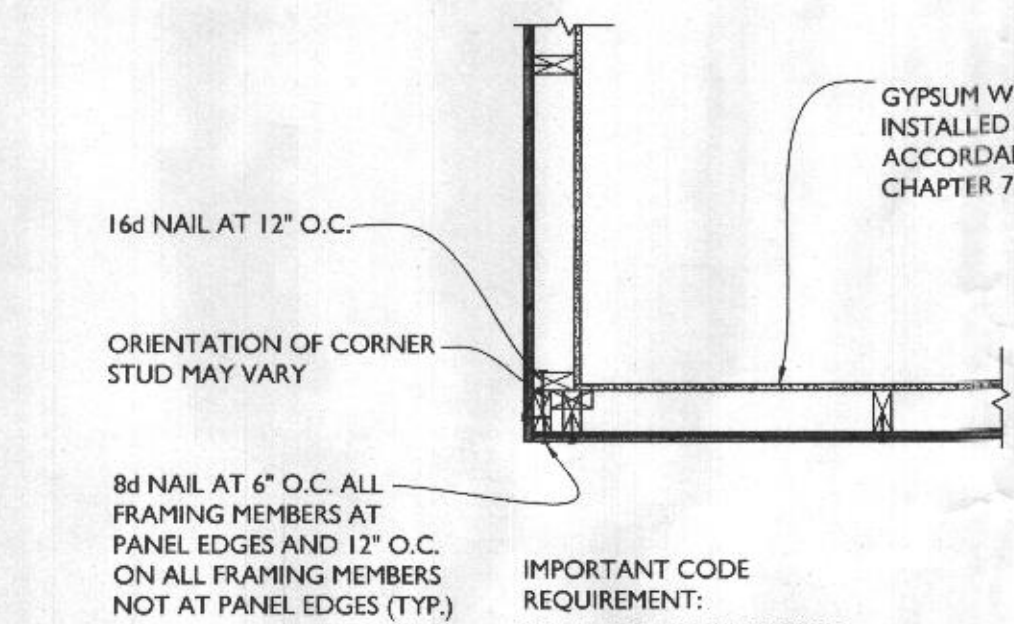

OUTSIDE CORNER DETAIL  
PER IRC R602.10.5

SCALE: 3/4"=1'-0"



FIRST FLOOR  
LATERAL BRACING PLAN

SCALE: 1/8"=1'-0"

WALL BRACING NEEDED & PROVIDED  
IRC R602.10.4 WALL BRACING METHOD  
BRACED PANEL MIN WIDTH FOR  
8" H. CLG = 24"


1ST FLOOR - 13'-0" WALL 'D' BRACING NEEDED: 3.5 x .90 = 3.15' BRACING PROVIDED: 4'-0"	2ND FLOOR - 12'-0" WALL 'A' BRACING NEEDED: 2.0 x .90 = 1.8' BRACING PROVIDED: 2'-0"
1ST FLOOR - 10'-0" WALL 'E' BRACING NEEDED: 3.5 x .90 = 3.15' BRACING PROVIDED: 4'-0"	2ND FLOOR - 12'-0" WALL 'B' BRACING NEEDED: 2.0 x .90 = 1.8' BRACING PROVIDED: 2'-0"
1ST FLOOR - 5'-0" WALL 'F' BRACING NEEDED: 3.5 x .90 = 3.15' BRACING PROVIDED: 4'-0"	2ND FLOOR - 16'-0" WALL 'C' BRACING NEEDED: 3.5x .90 = 3.15' BRACING PROVIDED: 4'-0"
1ST FLOOR - 5'-0" WALL 'G' BRACING NEEDED: 2.0 x .90 = 1.8' BRACING PROVIDED: 1'-6"	2ND FLOOR - 12'-0" WALL '1' BRACING NEEDED: 2.0x .90 = 1.8' BRACING PROVIDED: 2'-0"
1ST FLOOR - 5'-0" WALL 'H' BRACING NEEDED: 2.0 x .90 = 1.8' BRACING PROVIDED: 1'-6"	2ND FLOOR - 6'-0" WALL '2' BRACING NEEDED: 2.0x .90 = 1.8' BRACING PROVIDED: 2'-0"
1ST FLOOR - 19'-0" WALL '3' BRACING NEEDED: 6.5 x .90 = 5.85' BRACING PROVIDED: 6'-0"	
1ST FLOOR - 9'-0" WALL '4' BRACING NEEDED: 2.0x .90 = 1.8' BRACING PROVIDED: 1'-6"	
1ST FLOOR - 10'-0" WALL '5' BRACING NEEDED: 2.0x .90 = 1.8' BRACING PROVIDED: 2'-0"	
1ST FLOOR - 10'-0" WALL '6' BRACING NEEDED: 2.0x .90 = 1.8' BRACING PROVIDED: 4'-0"	

- BRACED WALL PANEL
- WOOD STRUCTURAL PANEL (UNLESS OTHERWISE NOTED)

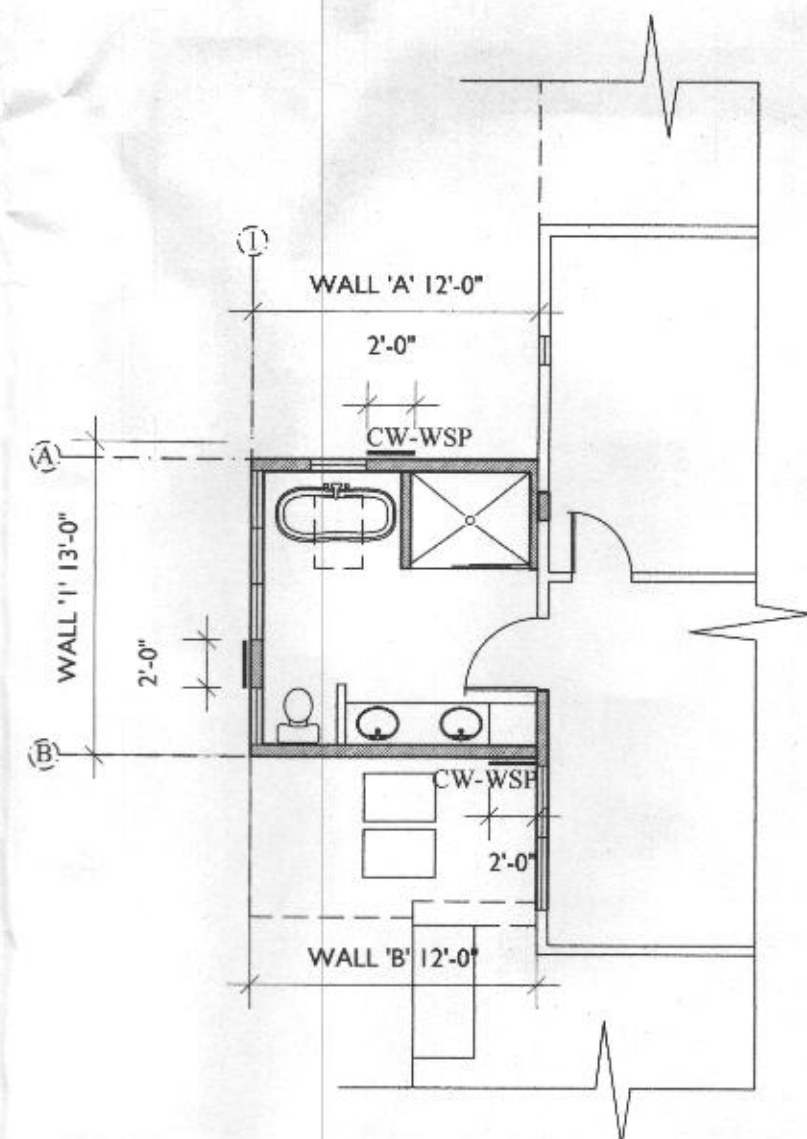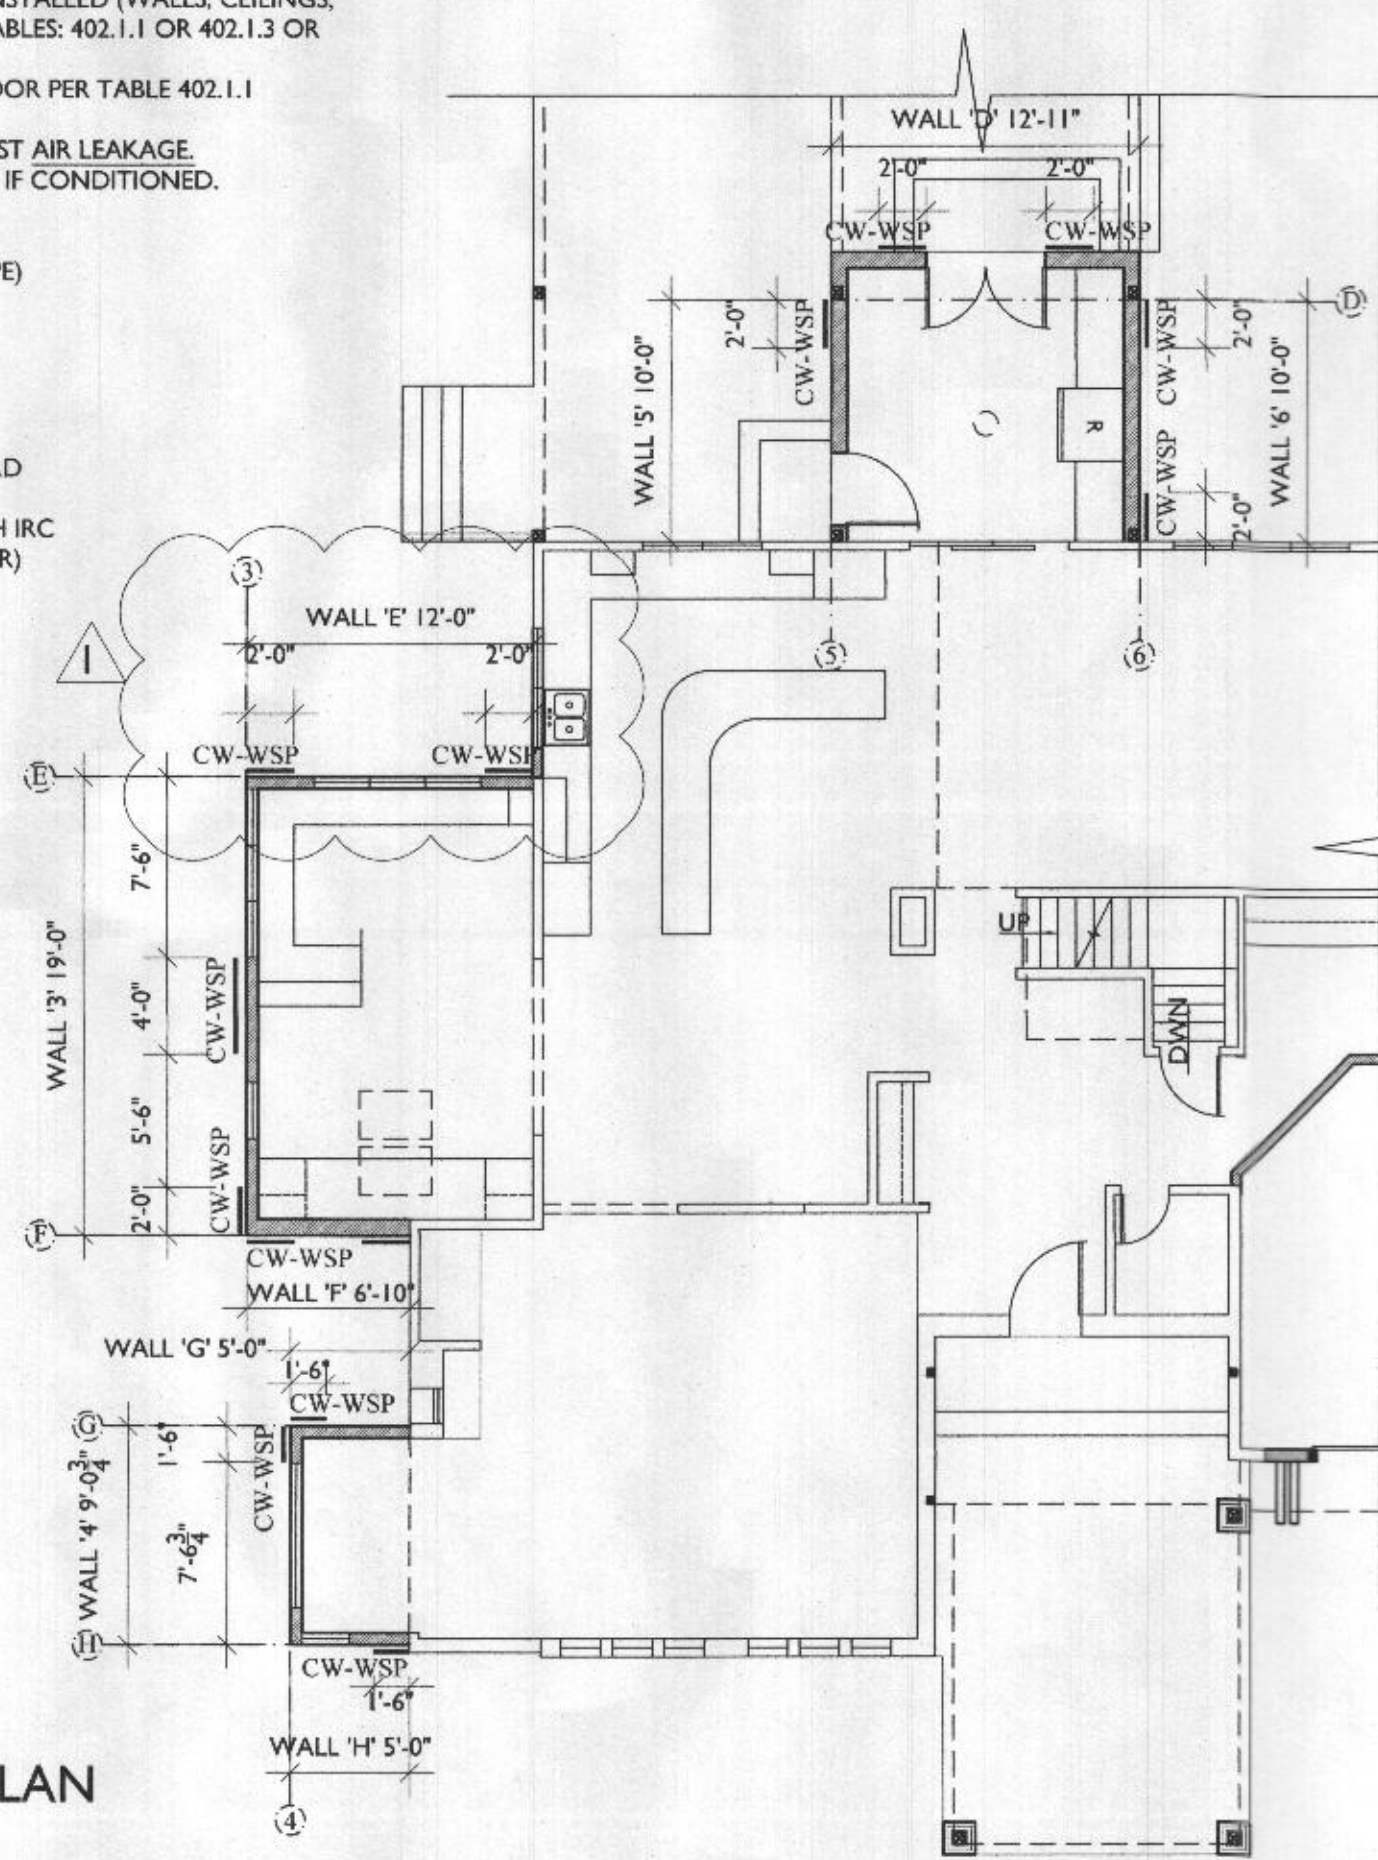

SECOND FLOOR - OWNER'S  
BATH LATERAL BRACING PLAN

SCALE: 1/8"=1'-0"

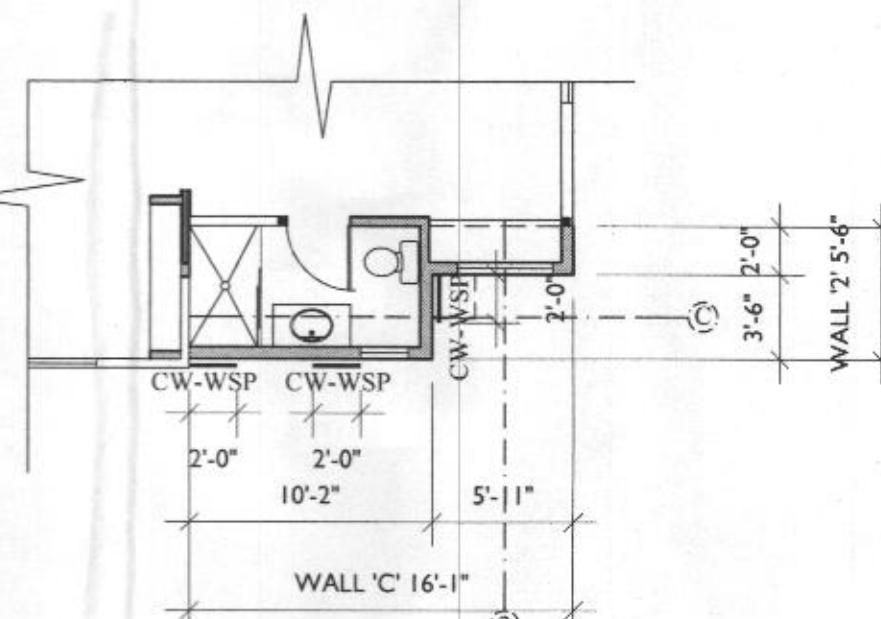

SECOND FLOOR - EXERCISE BATH  
LATERAL BRACING PLAN

SCALE: 1/8"=1'-0"



13953 Brighton Dam Road  
Clarksville, MD 21029  
301-776-2666  
info@TransformingArchitecture.com  
www.TransformingArchitecture.com



STAMP

I CERTIFY THAT THESE DOCUMENTS WERE PREPARED OR APPROVED BY ME AND THAT I AM A DULY LICENSED ARCHITECT UNDER THE LAWS OF THE STATE OF MARYLAND, LICENSE NUMBER 13662, EXPIRATION 10-22-2023.

NOTE: THESE DRAWINGS ARE THE PROPERTY OF TRANSFORMING ARCHITECTURE AND, AS SUCH, MAY NOT BE RE-USED OR REPRODUCED, EITHER WHOLLY OR IN PART, WITHOUT PRIOR WRITTEN CONSENT OF TRANSFORMING ARCHITECTURE.

PROJECT PHASE

PERMIT

PROJECT TITLE

THE  
SANYAL  
RESIDENCE

6006 Ten Oaks Rd  
Clarksville, MD 21029

REVISIONS

SYMBOL	DATE	ISSUED FOR
1	10/20/2022	BUILDING REVIEW
2	10/20/2022	ADDED SCOPE

PROJECT NUMBER 19-433

DATE 08/23/2022

SCALE AS NOTED


DRAWING TITLE

LATERAL BRAC.  
NOTES + PLANS


SHEET NUMBER

A-107




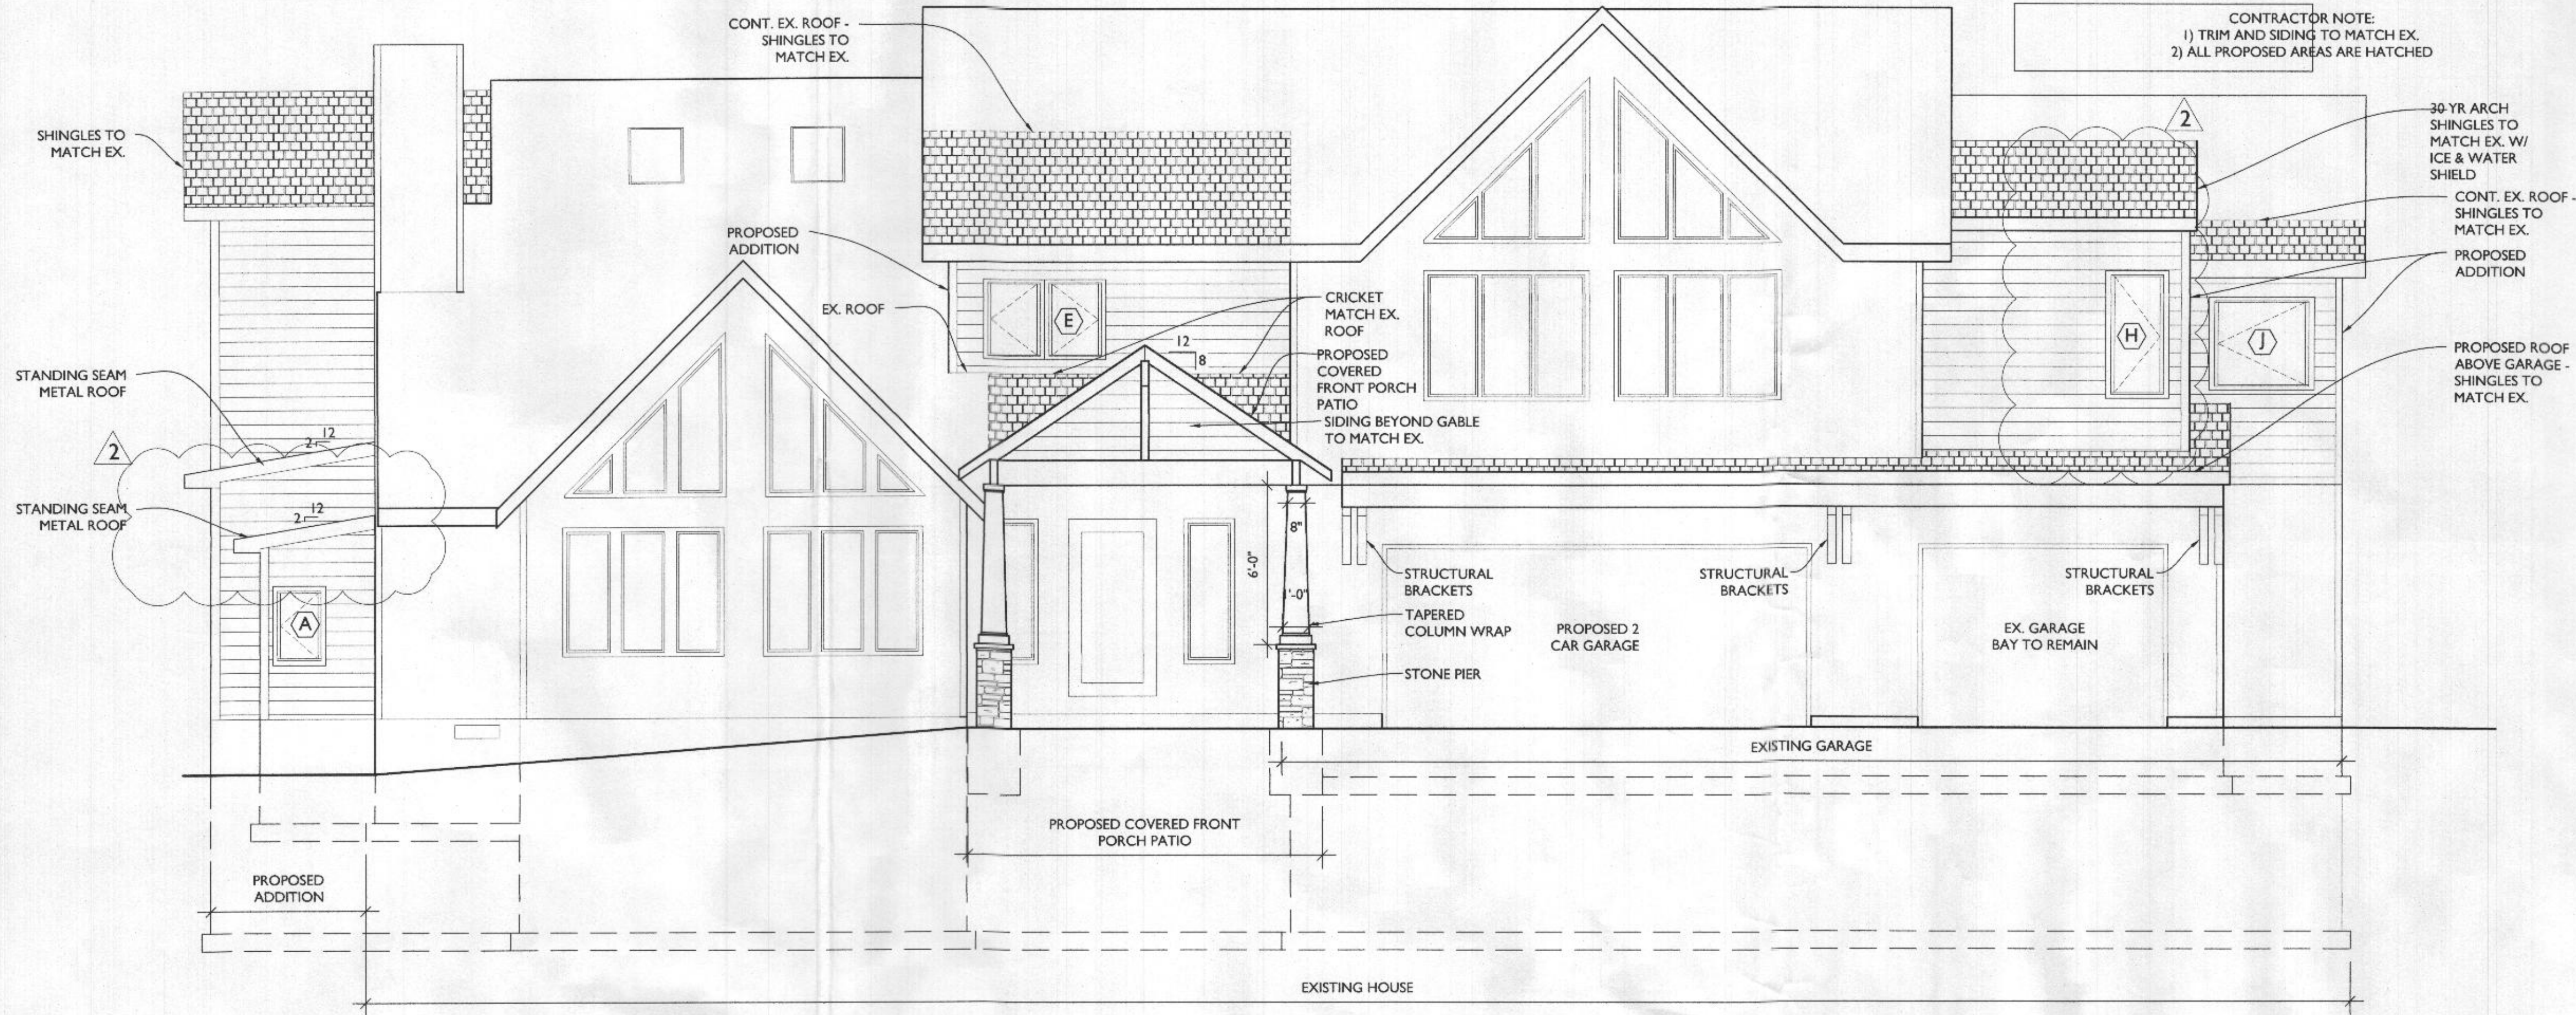

1 FRONT ELEVATION  
SCALE: 1/4"=1'-0"

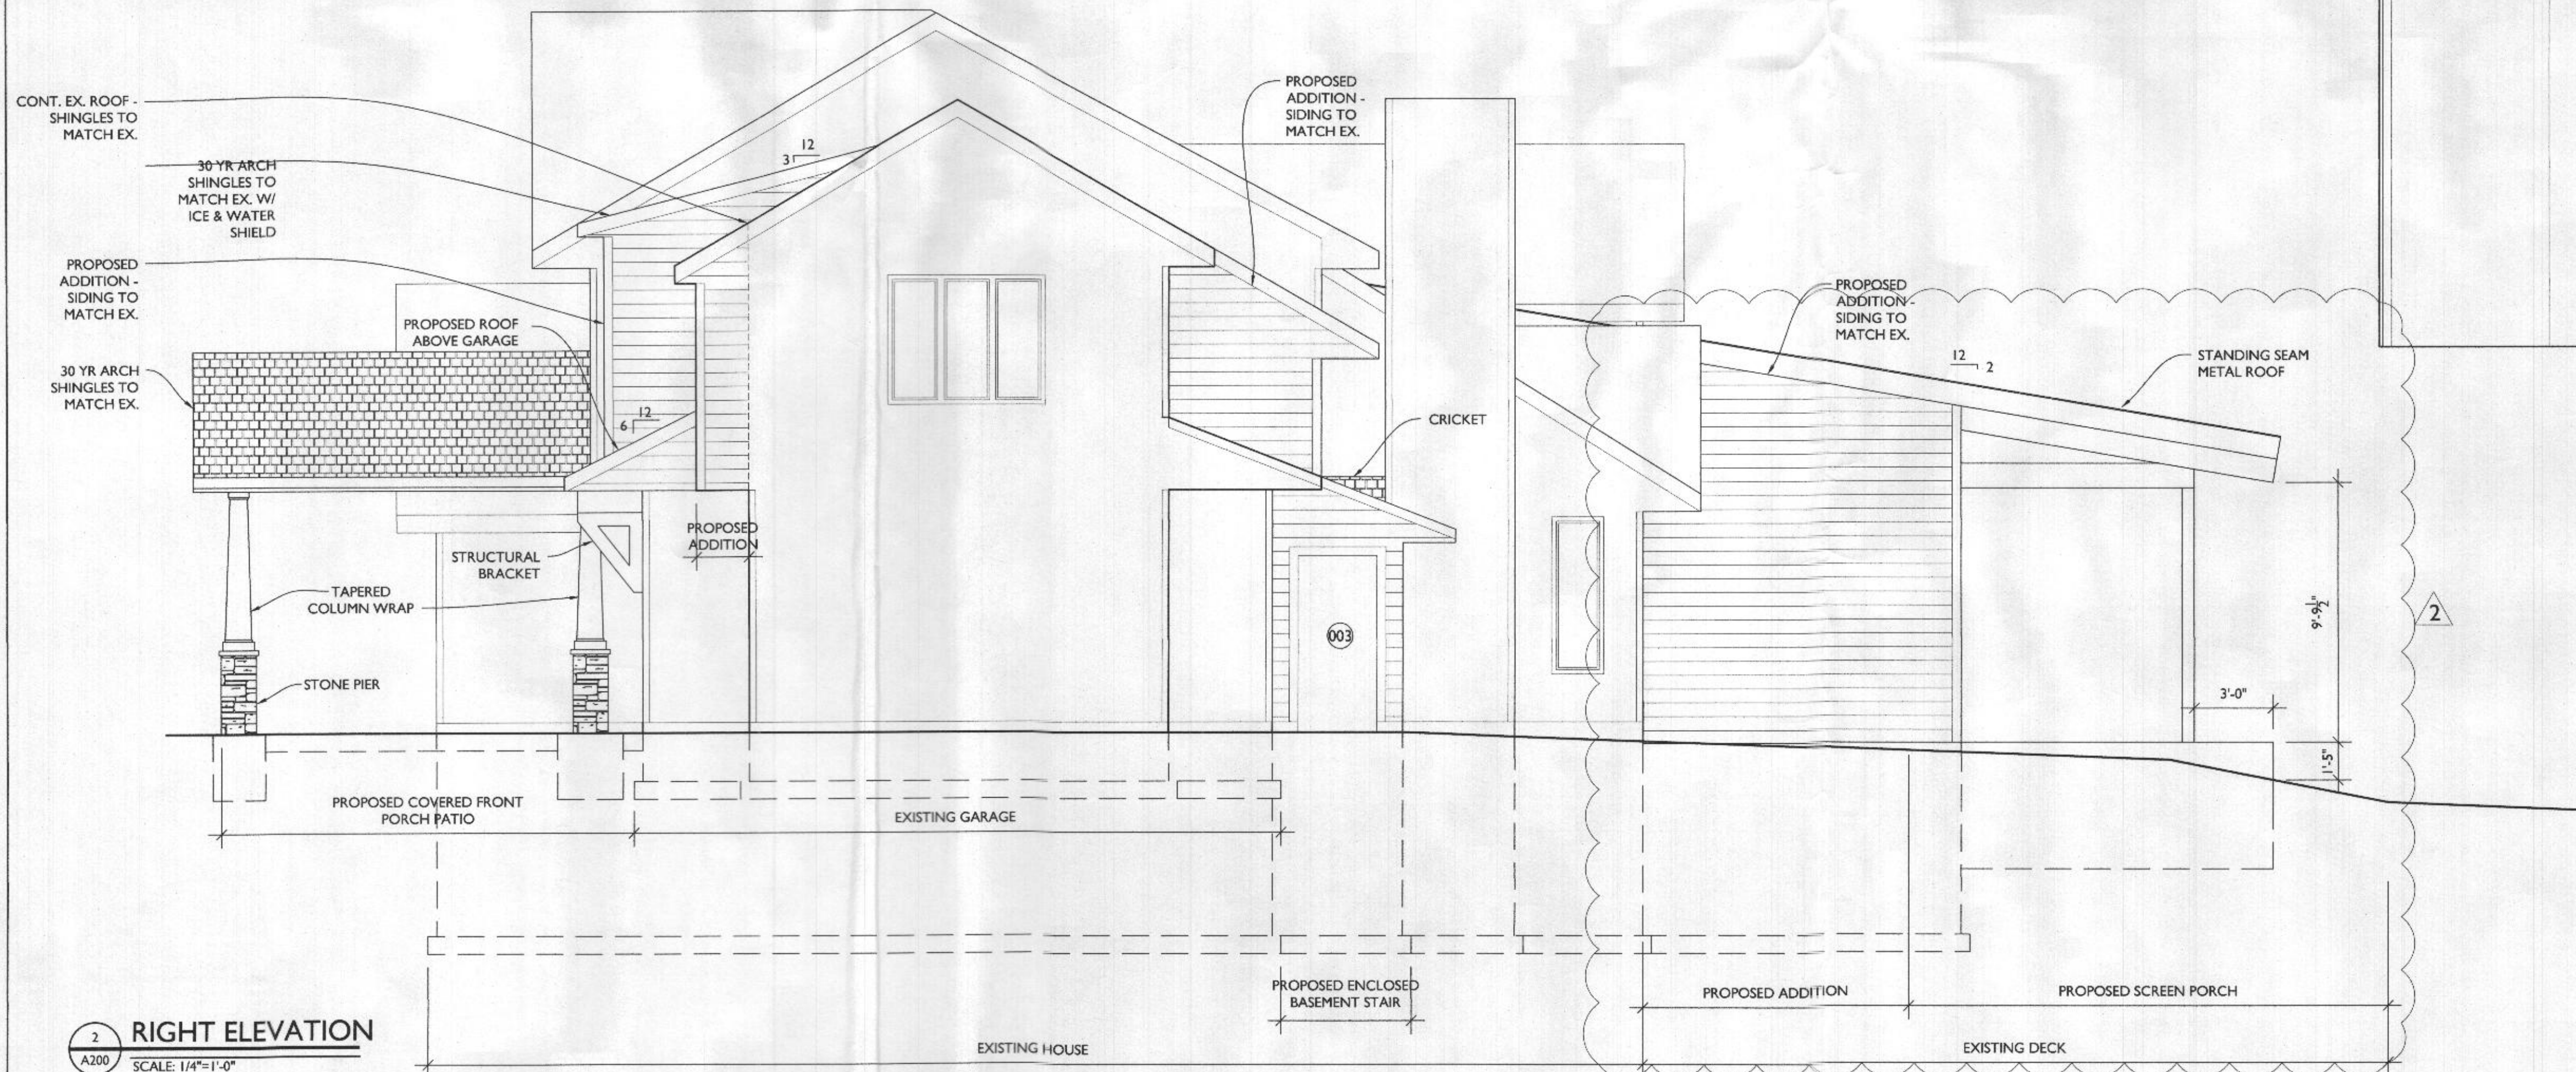

2 RIGHT ELEVATION  
SCALE: 1/4"=1'-0"

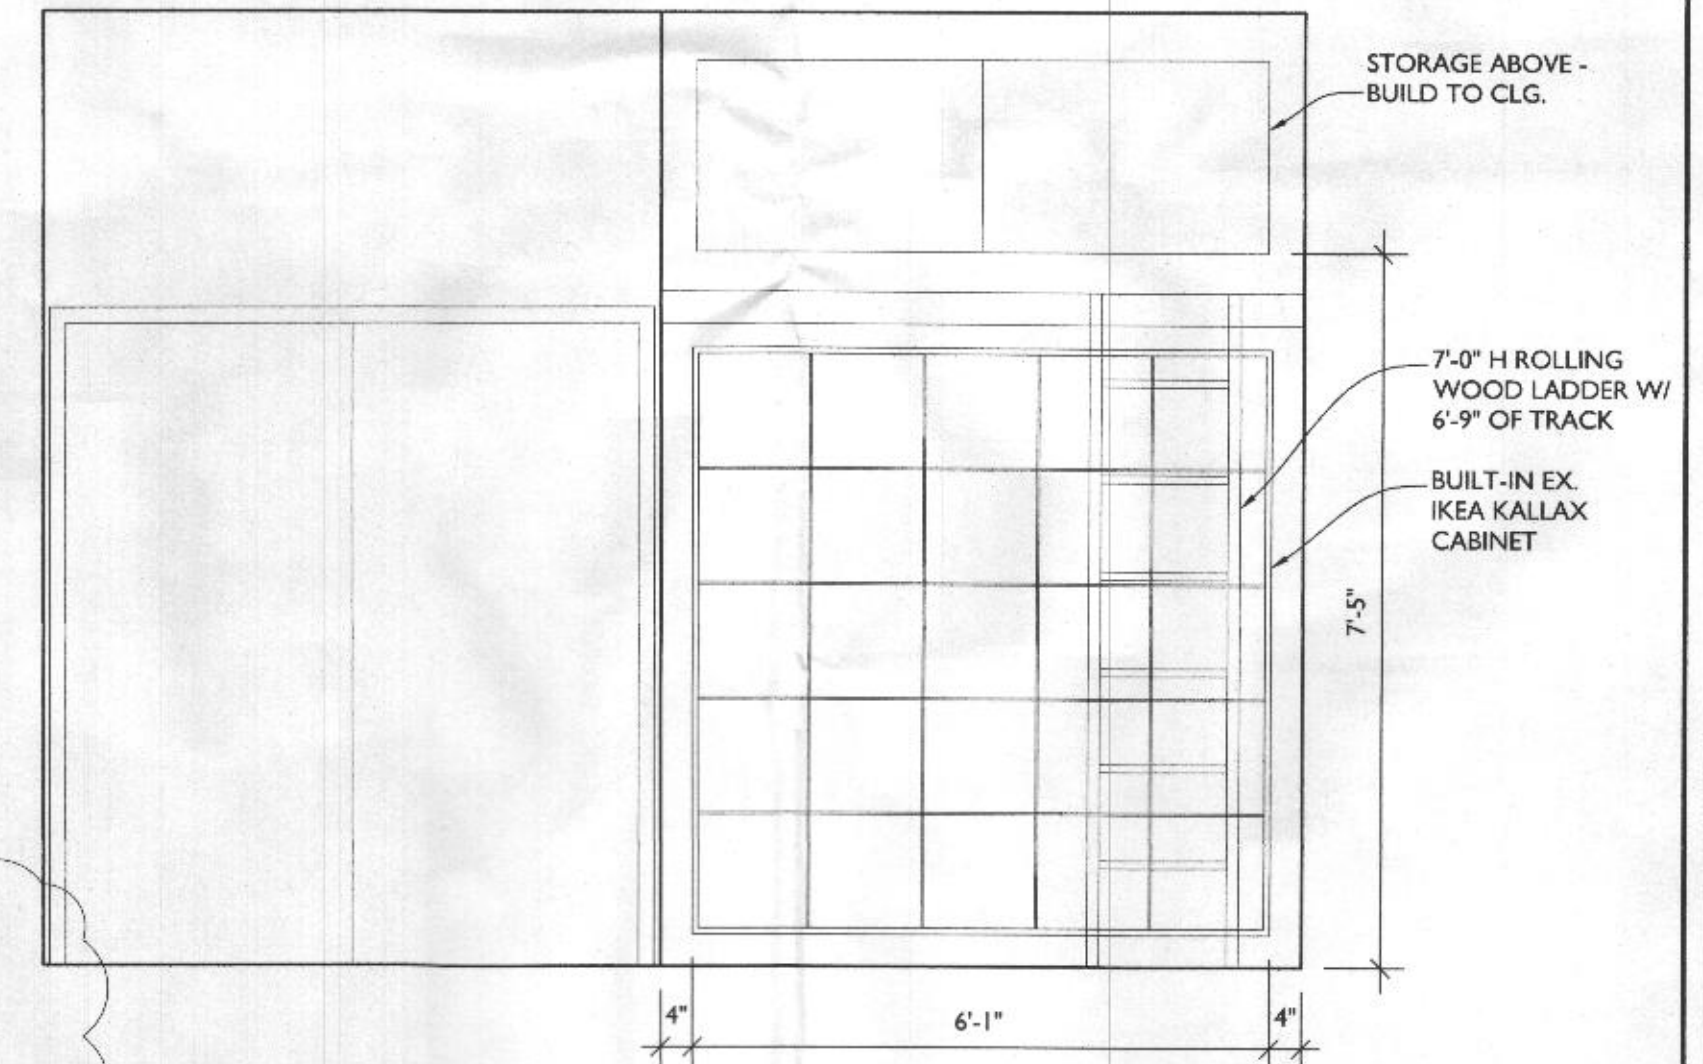

3 BUILT-IN STORAGE  
SCALE: 1/4"=1'-0"



13953 Brighton Dam Road  
Clarksville, MD 21029  
301-776-2666  
info@TransformingArchitecture.com  
www.TransformingArchitecture.com



STAMP

I CERTIFY THAT THESE DOCUMENTS WERE PREPARED OR APPROVED BY ME, AND THAT I AM A DULY LICENSED ARCHITECT UNDER THE LAWS OF THE STATE OF MARYLAND, LICENSE NUMBER 13662, EXPIRATION 10-22-2023.

NOTE: THESE DRAWINGS ARE THE PROPERTY OF TRANSFORMING ARCHITECTURE AND, AS SUCH, MAY NOT BE RE-USED OR REPRODUCED, EITHER WHOLLY OR IN PART, WITHOUT PRIOR WRITTEN CONSENT OF TRANSFORMING ARCHITECTURE.

PROJECT PHASE

PERMIT

PROJECT TITLE

THE SANYAL RESIDENCE

6006 Ten Oaks Rd  
Clarksville, MD 21029

REVISIONS

SYMBOL	DATE	ISSUED FOR
1	10/20/2022	BUILDING REVIEW
2	10/20/2022	ADDED SCOPE

PROJECT NUMBER 19-433

DATE 08/23/2022

SCALE AS NOTED

DRAWING TITLE

EXT. + INT. ELEVATIONS

SHEET NUMBER

A-200





13953 Brighton Dam Road  
Clarksville, MD 21029  
301-776-2666  
info@TransformingArchitecture.com  
www.TransformingArchitecture.com



STAMP

I CERTIFY THAT THESE DOCUMENTS WERE PREPARED OR APPROVED BY ME, AND THAT I AM A DULY LICENSED ARCHITECT UNDER THE LAWS OF THE STATE OF MARYLAND, LICENSE NUMBER 13662, EXPIRATION 10-22-2023.

NOTE: THESE DRAWINGS ARE THE PROPERTY OF TRANSFORMING ARCHITECTURE AND, AS SUCH, MAY NOT BE RE-USED OR REPRODUCED, EITHER WHOLLY OR IN PART, WITHOUT PRIOR WRITTEN CONSENT OF TRANSFORMING ARCHITECTURE.

PROJECT PHASE

PERMIT

PROJECT TITLE

THE  
SANYAL  
RESIDENCE

6006 Ten Oaks Rd  
Clarksville, MD 21029

REVISIONS

SYMBOL	DATE	ISSUED FOR
1	10/20/2022	BUILDING REVIEW
2	10/20/2022	ADDED SCOPE

PROJECT NUMBER 19-433

DATE 08/23/2022

SCALE AS NOTED

DRAWING TITLE


EXT. ELEVATIONS  
CONTINUED

SHEET NUMBER

A-201





1 REAR ELEVATION  
A201 SCALE: 1/4"=1'-0"

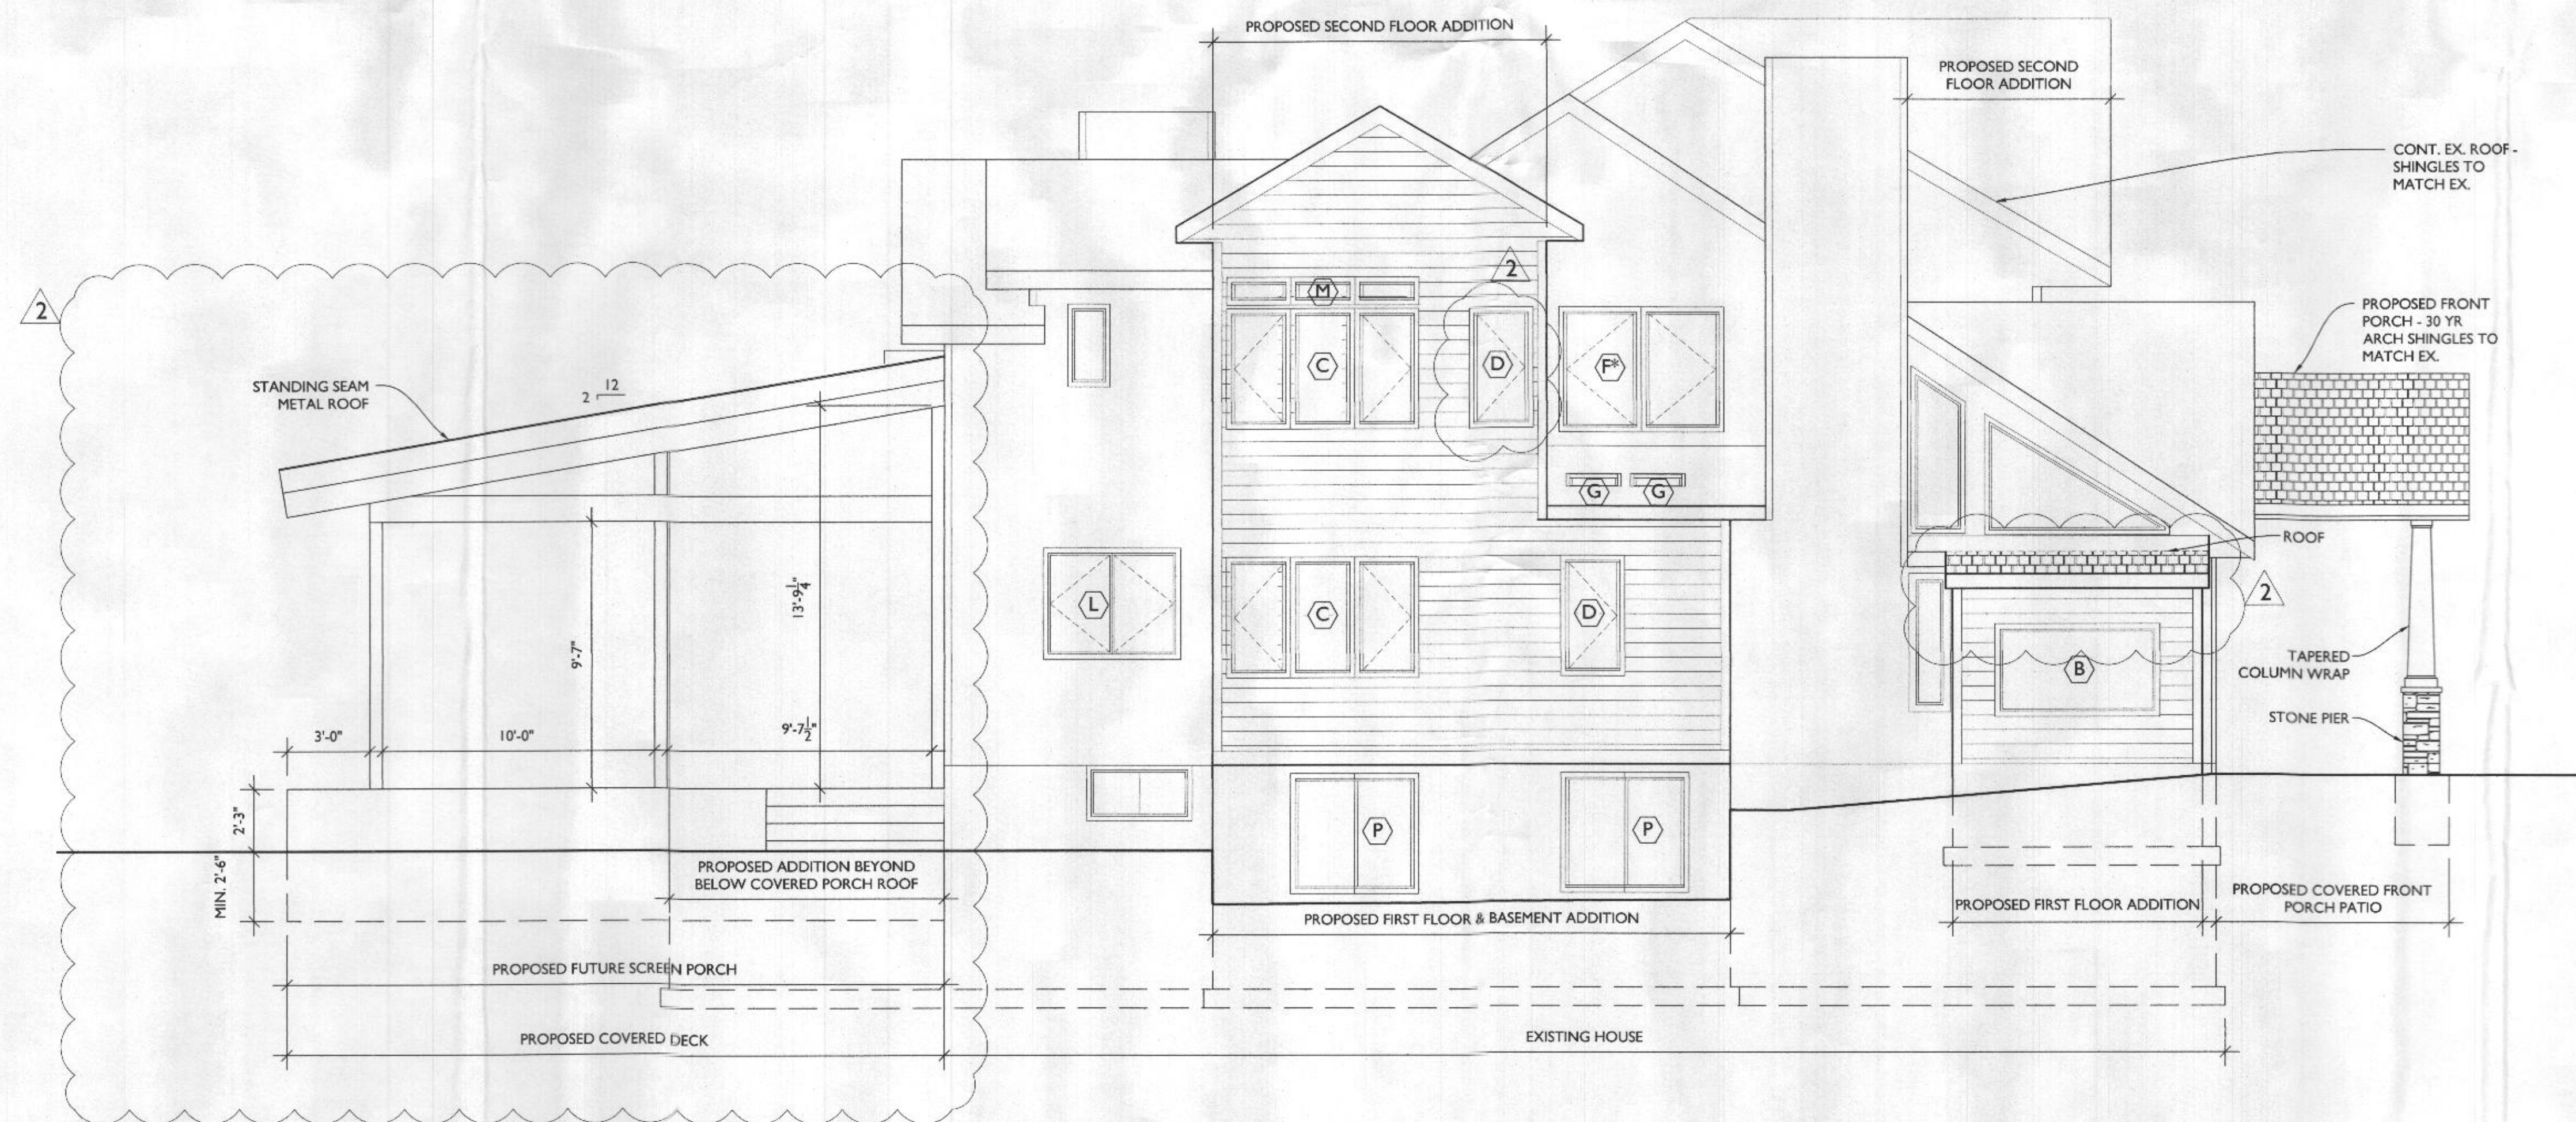


2 LEFT ELEVATION  
A201 SCALE: 1/4"=1'-0"



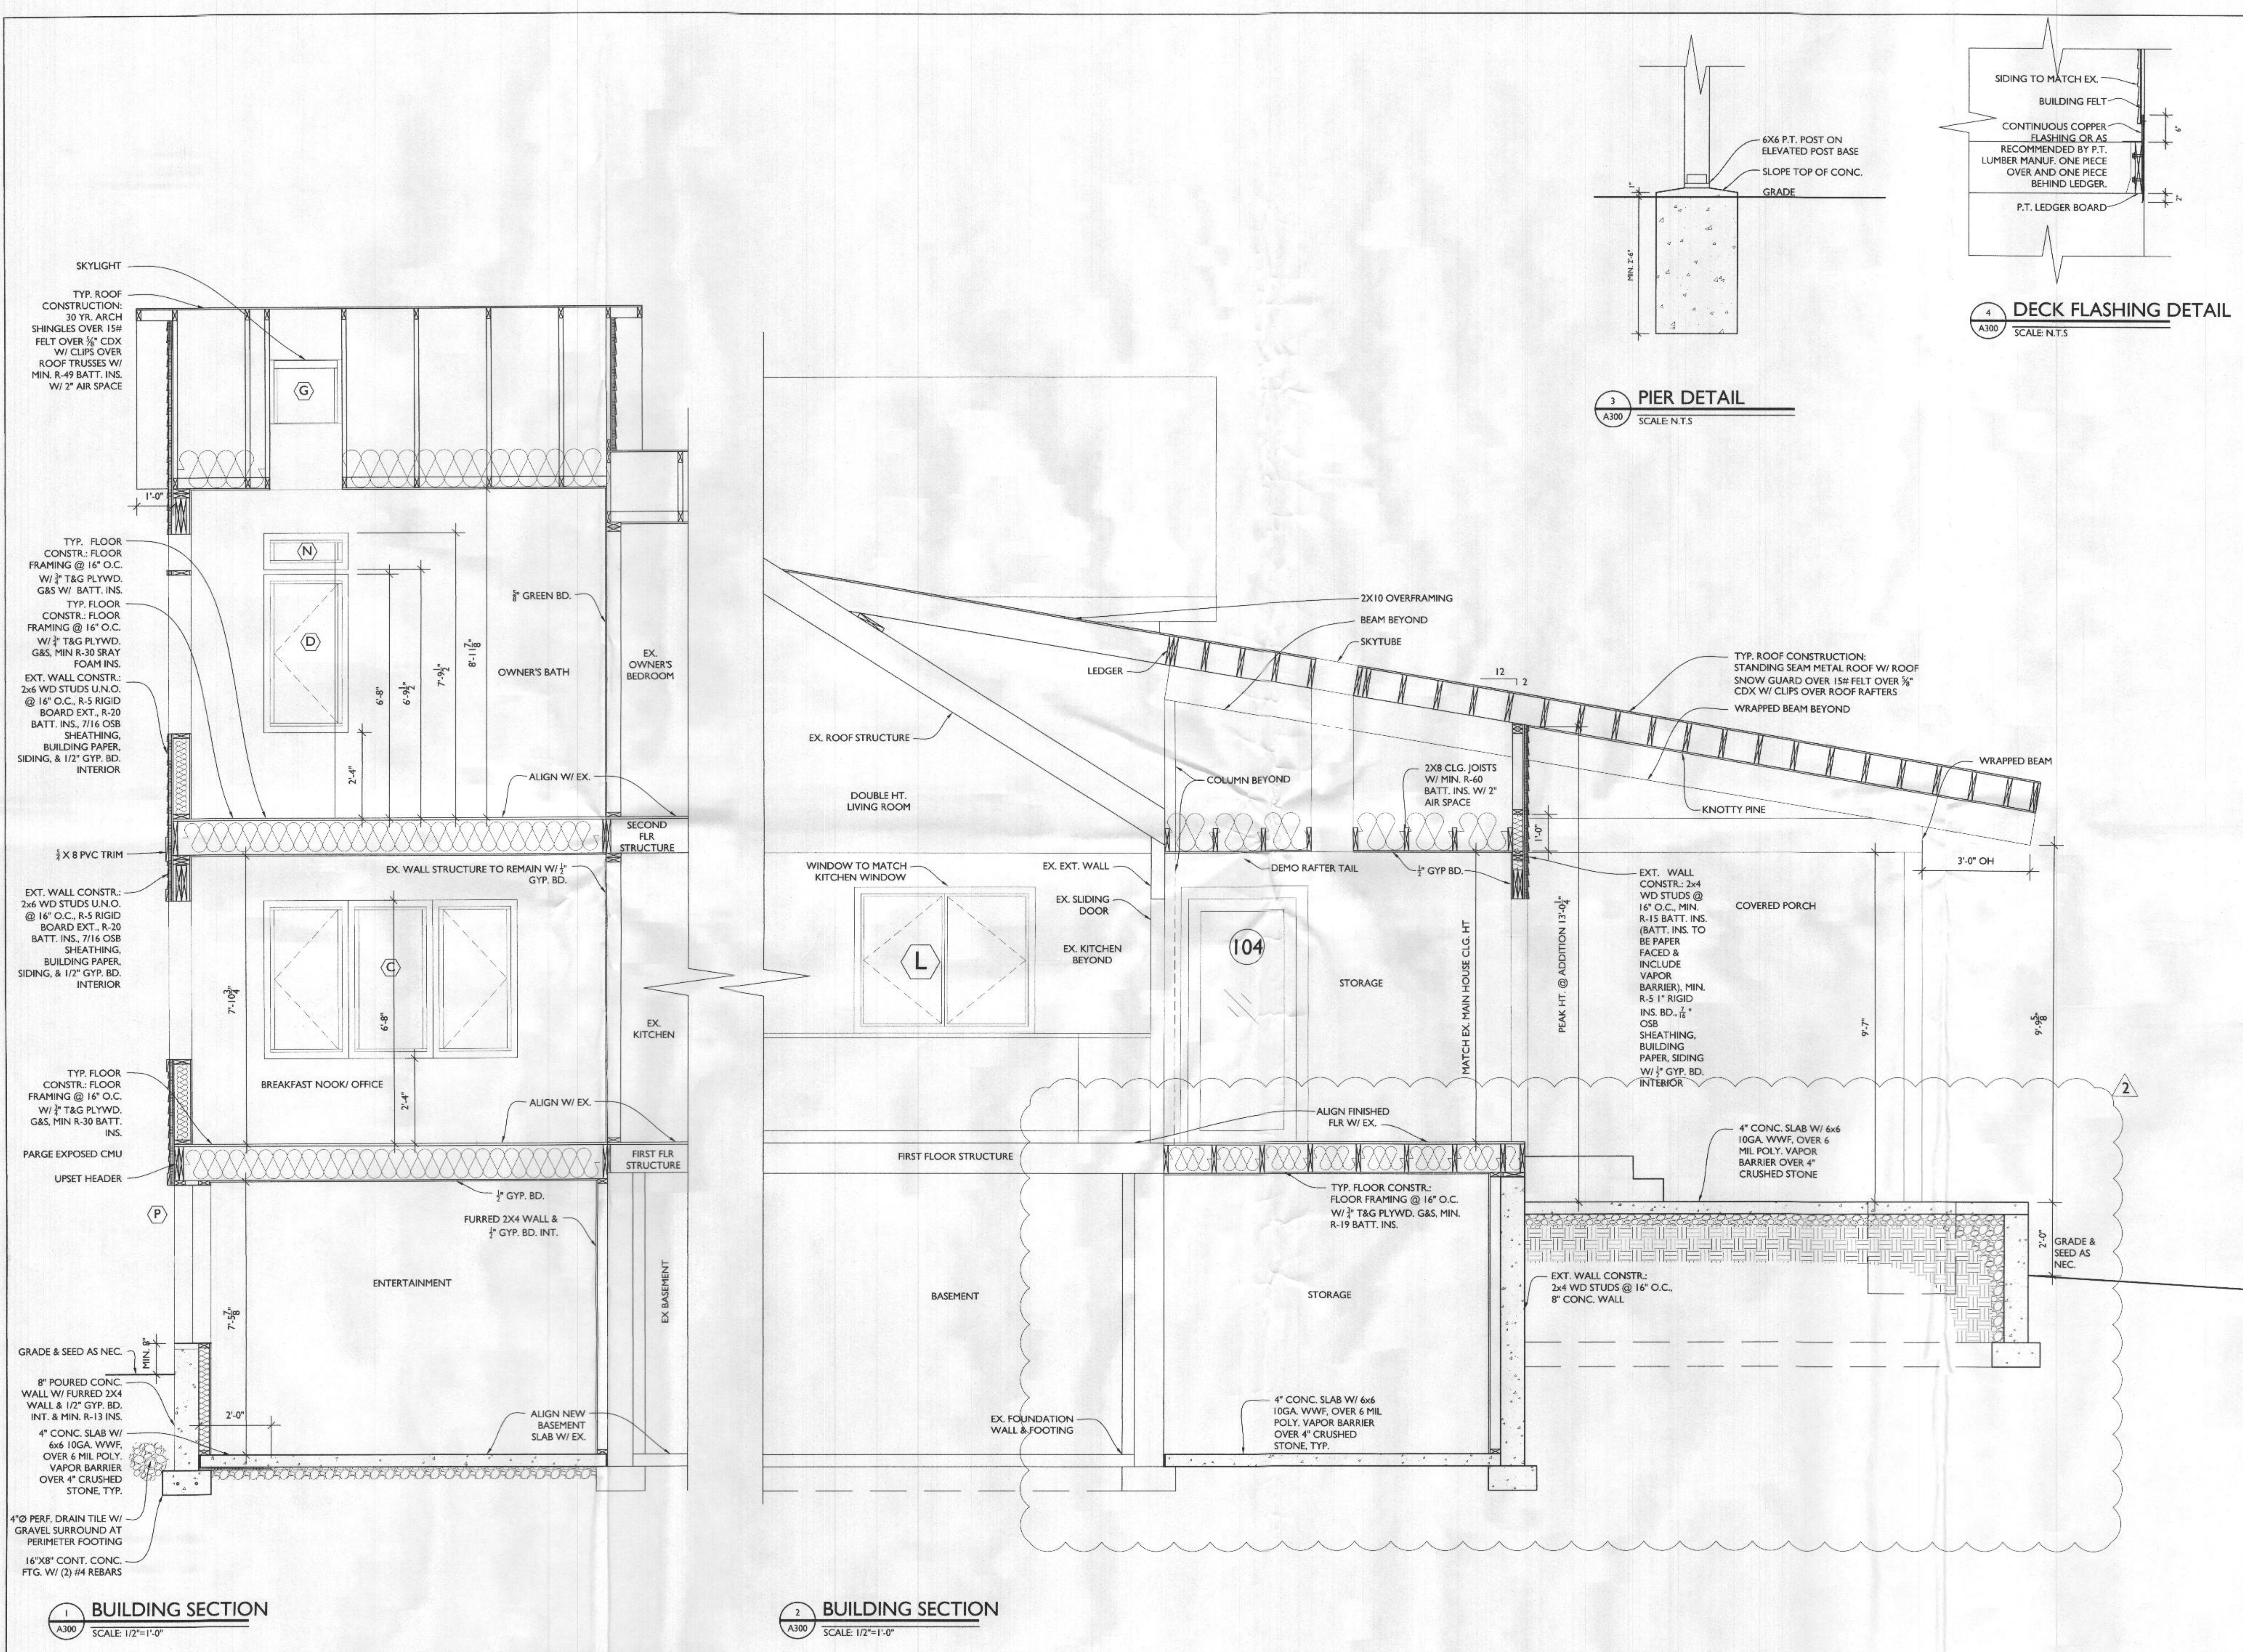



13953 Brighton Dam Road  
Clarksville, MD 21029  
301-776-2666  
info@TransformingArchitecture.com  
www.TransformingArchitecture.com



STAMP

I CERTIFY THAT THESE DOCUMENTS WERE PREPARED OR APPROVED BY ME, AND THAT I AM A DULY LICENSED ARCHITECT UNDER THE LAWS OF THE STATE OF MARYLAND, LICENSE NUMBER 13662, EXPIRATION 10-22-2023.

NOTE: THESE DRAWINGS ARE THE PROPERTY OF TRANSFORMING ARCHITECTURE AND, AS SUCH, MAY NOT BE RE-USED OR REPRODUCED, EITHER WHOLLY OR IN PART, WITHOUT PRIOR WRITTEN CONSENT OF TRANSFORMING ARCHITECTURE.

PROJECT PHASE

**PERMIT**

PROJECT TITLE

**THE SANYAL RESIDENCE**

6006 Ten Oaks Rd  
Clarksville, MD 21029

REVISIONS		
SYMBOL	DATE	ISSUED FOR
1	10/20/2022	BUILDING REVIEW
2	10/20/2022	ADDED SCOPE

PROJECT NUMBER 19-433

DATE 08/23/2022

SCALE AS NOTED

DRAWING TITLE

**BUILDING SECTIONS + DETAILS**

SHEET NUMBER

**A-300**