



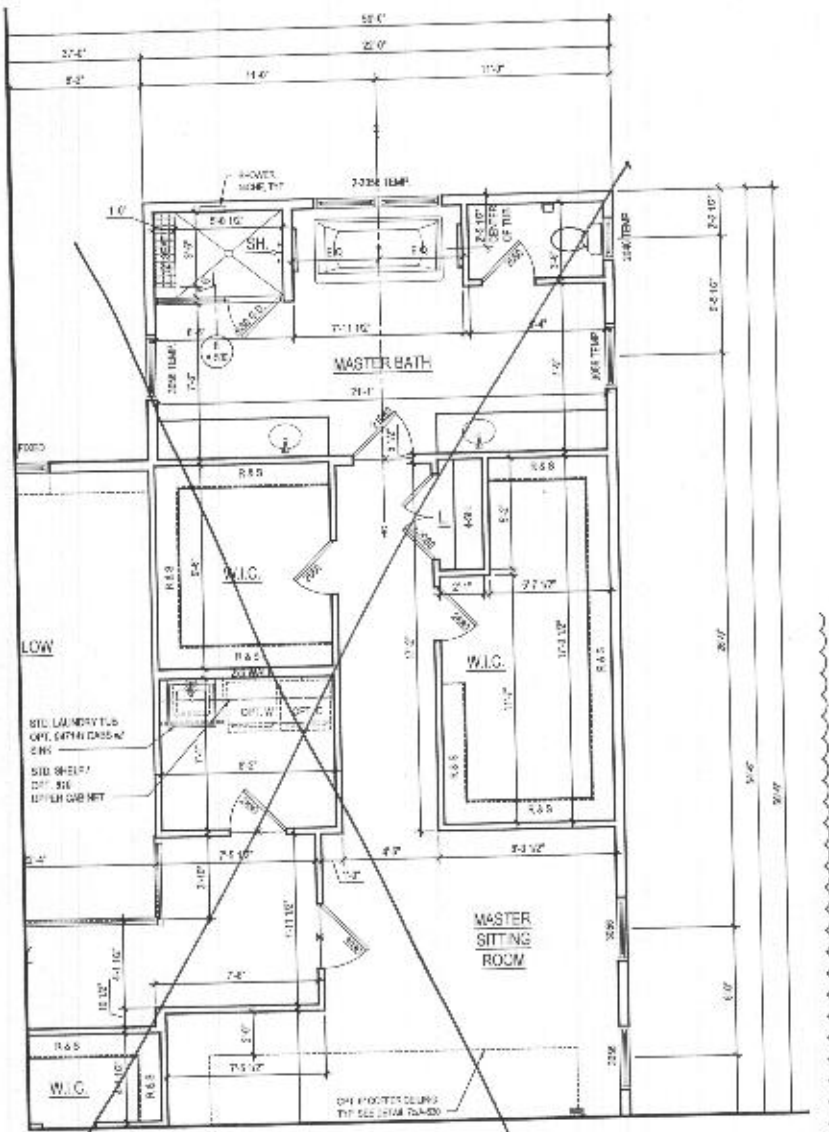

2 PART. SECOND FLOOR PLAN W/ OPT. 030 - ADDITIONAL WALK IN CLOSET
A-120 SCALE 1/4" = 1'-0"

- GENERAL PLAN NOTES**
- ALL WOOD STUD PARTITIONS NOT INDICATED ARE TO BE 2x4 FOR INTERIOR AND 2x6 FOR EXTERIOR WALLS UNLESS OTHERWISE NOTED.
 - ALL THICKER DIMENSIONS ARE TO FACE OF STUD.
 - ALL EXTERIOR DIMENSIONS ARE TO FACE OF STUD.
 - ALL DIMENSIONS GOVERN OVER SCALE.
 - ALL DIMENSIONS ARE TO BE USED IN SUCH A MANNER THAT ADJUSTMENT OF ONE INCH AUTHORITY IS ALL.
 - INDICATED ACCESSORY SPACE UNDER STAIRS SHALL HAVE WALLS AND DOOR FINISHED ON EMPLOYED BLUE WITH 1/2" OF STAIN COORD.
 - ALL DIMENSIONS ARE NOTED IN FEET - INCHES AS MEAS. FROM GRAB TO GRAB.
 - REFER TO ELEVATIONS FOR WINDOW HEAD - HEIGHTS.
 - ALL DOOR SETS TO BE 6' 8" HIGH UNLESS OTHERWISE NOTED.
 - WASHING MACHINES TO BE ON LEFT SIDE OF ENTRY.
 - DISHWASHER ALWAYS TO BE ON RIGHT SIDE OF SINK.

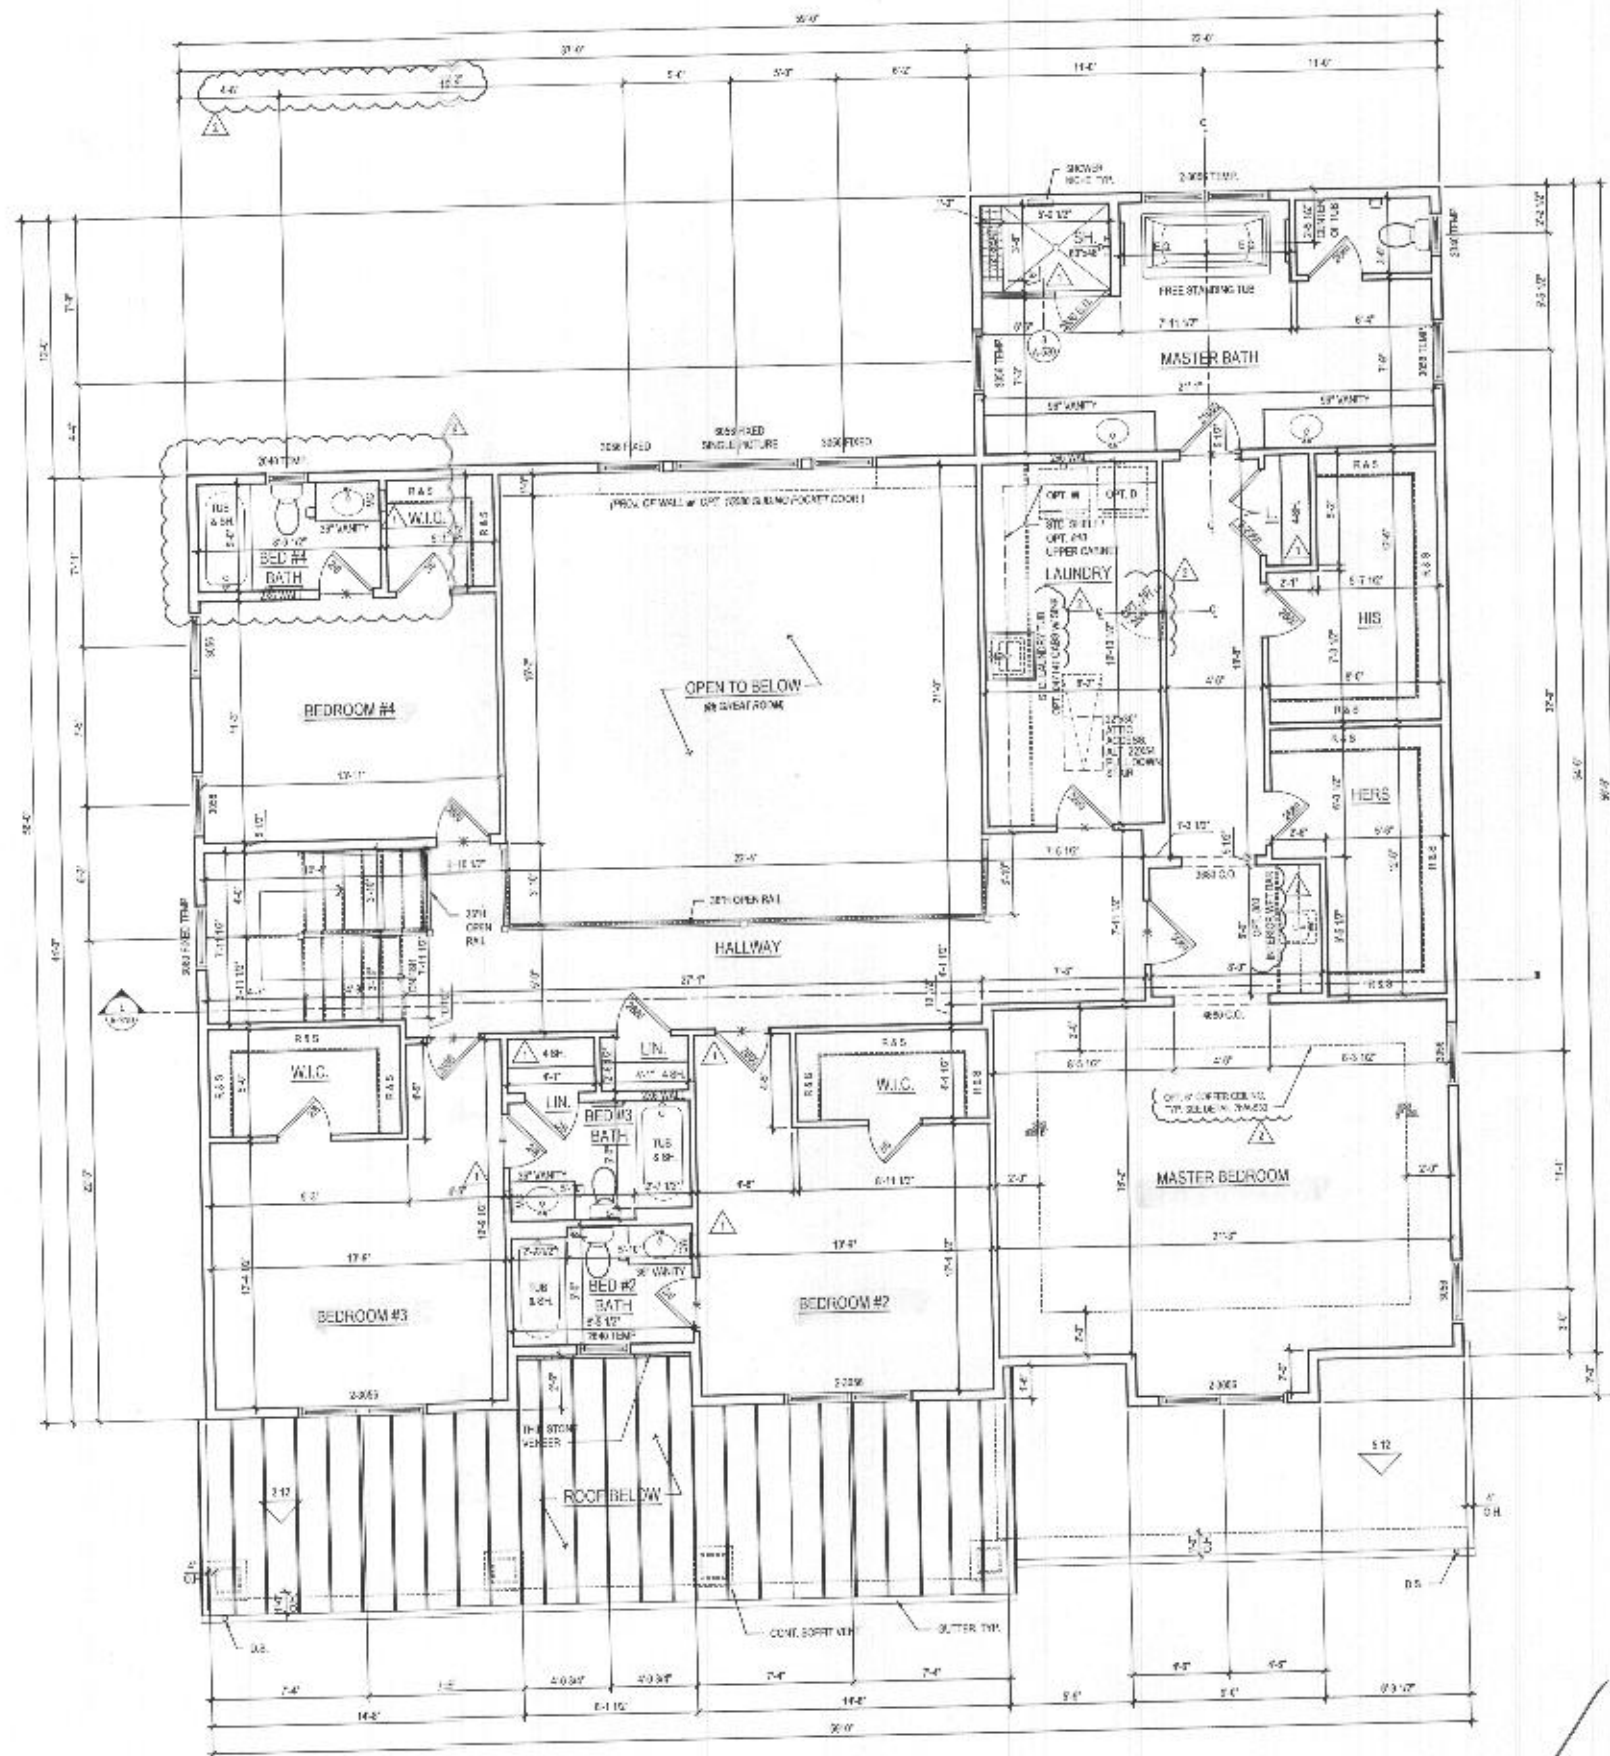

1 SECOND FLOOR PLAN
A-120 SCALE 1/4" = 1'-0"

@ ELEV. 1 - CRAFTSMAN



8571 Leeburg Pike
Suite 700 | Vienna, VA 22182
P: 571.830.1800 | F: 571.830.1801
www.lessarddesign.com

SEAL & SIGNATURE

OWNER:

TOLL BROTHERS
19775 BELMONT EXECUTIVE PLAZA
ASHBURN, VA 20147
P: 571.791.8000
CONTACT: CHRISTINA LEVLEY
christina@tollbrothers.com

MARYLAND

**PARKHURST
FLOOR PLANS**

PROJECT NAME:

SHEET TITLE:


NO.	REVISION / DESCRIPTION	DATE
1	REV. SET	05.20.20
2	PERMIT SET	06.22.20
3	REV. NEW STANDARDS	06.22.20
4	REV. A-120-24	08.11.20

PROJECT NO.:
DRAWN BY:
CHECKED BY:
DATE:
FILE NAME:


A-120




4 PART. RIGHT SIDE ELEVATION w/ OPT. 012 - SIDE LOAD GARAGE
A-400 SCALE: 1/4" = 1'-0"
ELEV. 1 - SHOWN

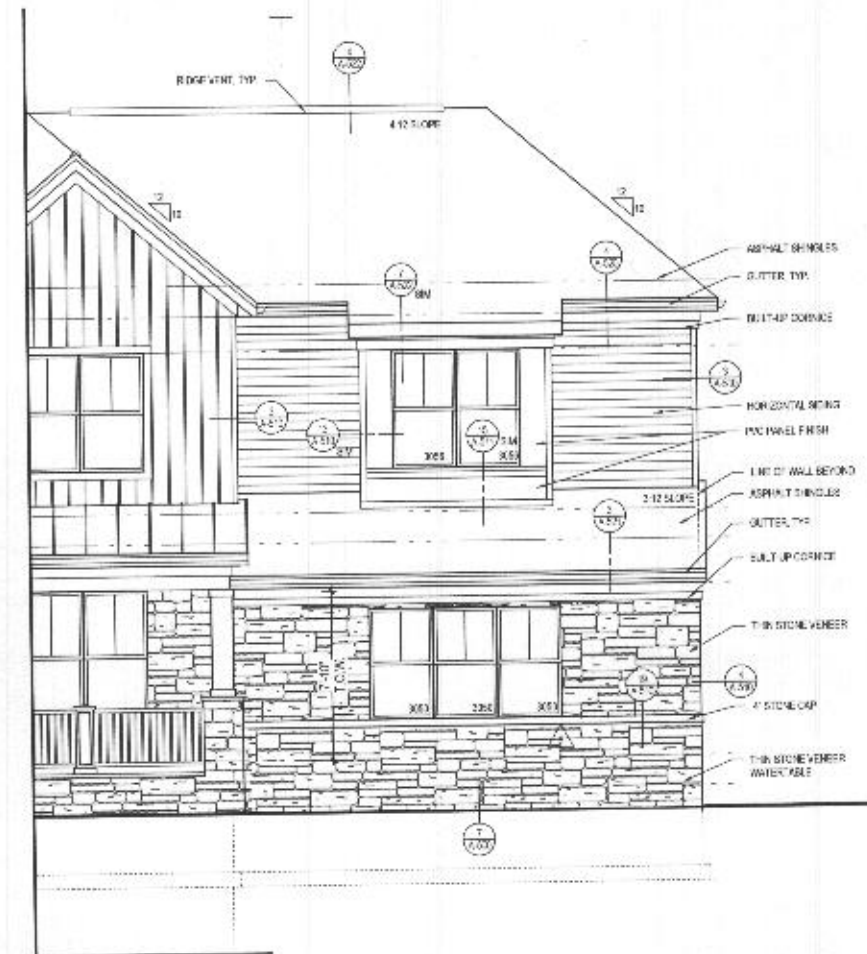

3 PART. FRONT ELEVATION w/ OPT. 012 - SIDE LOAD GARAGE
A-400 SCALE: 1/4" = 1'-0"
ELEV. 1 - SHOWN

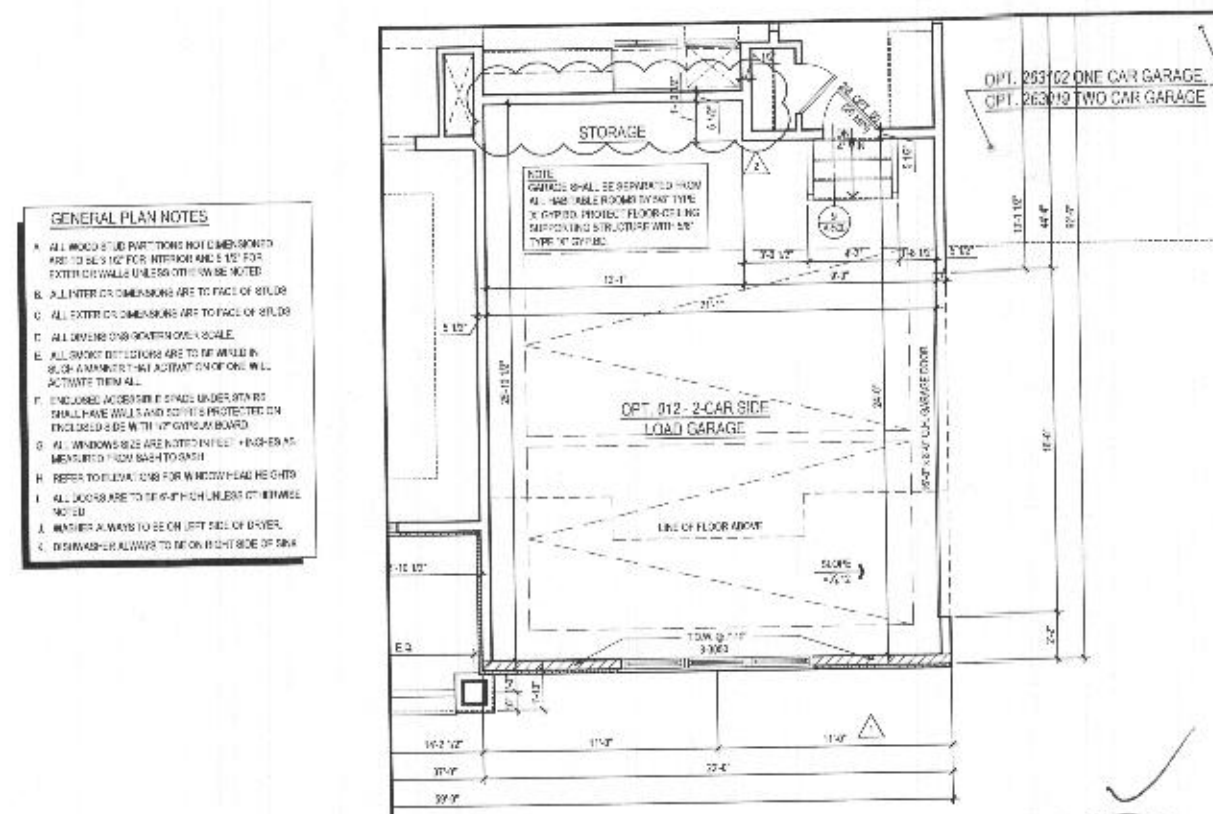

2 PART. FIRST FLOOR PLAN w/ OPT. 012 - SIDE LOAD GARAGE
A-400 SCALE: 1/4" = 1'-0"
CLUMP & MARKING

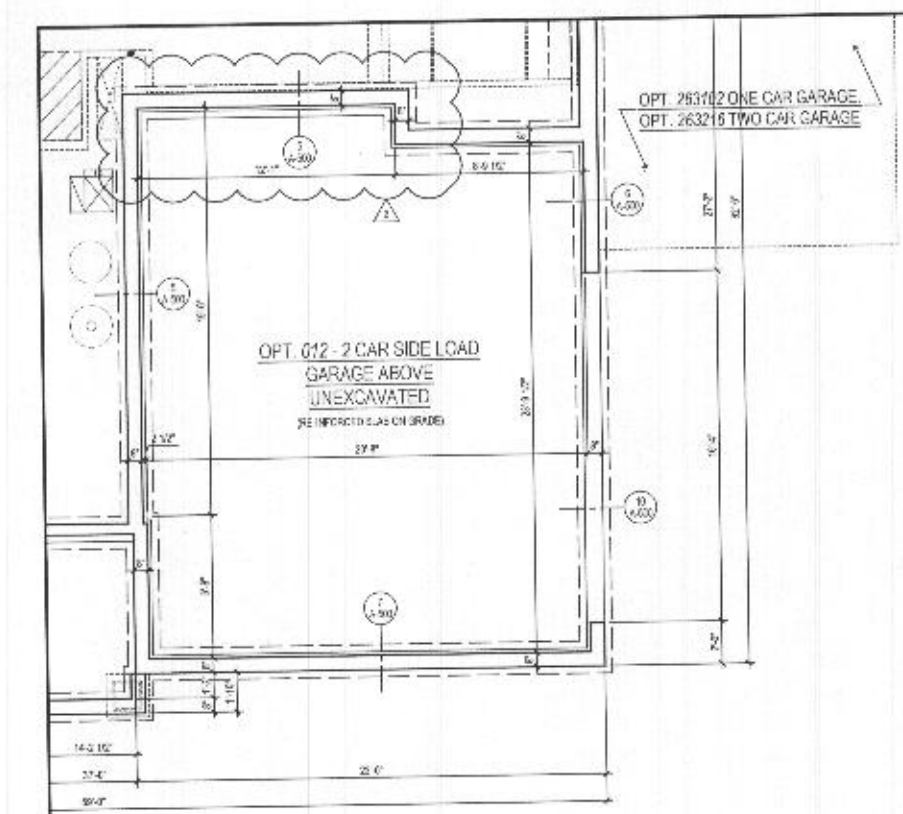

1 PART. BASEMENT FLOOR PLAN w/ OPT. 012 - SIDE LOAD GARAGE
A-400 SCALE: 1/4" = 1'-0"
CLUMP & MARKING

- GENERAL PLAN NOTES**
- ALL WOOD STUD PARTITIONS NOT DIMENSIONED ARE TO BE 1/2" FOR INTERIOR AND 1/2" FOR EXTERIOR WALLS UNLESS OTHERWISE NOTED.
 - ALL INTERIOR DIMENSIONS ARE TO FACE OF STUD.
 - ALL EXTERIOR DIMENSIONS ARE TO FACE OF STUD.
 - ALL DOORS AND WINDOWS ARE TO FACE.
 - ALL DOOR AND WINDOW SIZES ARE TO BE AS SHOWN IN SCHEDULE UNLESS OTHERWISE NOTED. ALL DOORS ARE TO BE 1/2" MIN. UNLESS OTHERWISE NOTED.
 - ALL WINDOWS ARE TO BE 1/2" MIN. UNLESS OTHERWISE NOTED.
 - ALL DOORS ARE TO BE 1/2" MIN. UNLESS OTHERWISE NOTED.
 - ALL DOORS ARE TO BE 1/2" MIN. UNLESS OTHERWISE NOTED.
 - ALL DOORS ARE TO BE 1/2" MIN. UNLESS OTHERWISE NOTED.
 - ALL DOORS ARE TO BE 1/2" MIN. UNLESS OTHERWISE NOTED.

lessard
DESIGN
8521 Lessard Pike
Suite 700 | Vienna, VA 22182
P: 571.830.1800 | F: 571.830.1801
www.lessarddesign.com

TOLL BROTHERS
18775 BELMONT EXECUTIVE PLAZA
ASHBURN, VA 20147
P: 571.251.1000
CONTACT: CHRISTINA LEHLEY
clehley@tollbrothers.com

MARYLAND
PARKHURST
OPTIONS

NO.	DESCRIPTION	DATE
1	ISSUE 1 - REVISION	06/24/23
2	ISSUE 2 - REVISION	06/24/23
3	ISSUE 3 - REVISION	06/24/23
4	ISSUE 4 - REVISION	06/24/23
5	ISSUE 5 - REVISION	06/24/23
6	ISSUE 6 - REVISION	06/24/23
7	ISSUE 7 - REVISION	06/24/23
8	ISSUE 8 - REVISION	06/24/23
9	ISSUE 9 - REVISION	06/24/23
10	ISSUE 10 - REVISION	06/24/23


A-400

GENERAL PLAN NOTES

- ALL WOOD STUD PARTITIONS NOT DIMENSIONED ARE TO BE 2" X 4" FOR INTERIOR AND 2" X 6" FOR EXTERIOR WALLS UNLESS OTHERWISE NOTED.
- ALL INTERIOR DIMENSIONS ARE TO FACE OF STUDS.
- ALL EXTERIOR DIMENSIONS ARE TO FACE OF STUDS.
- ALL DIMENSIONS ON GARAGE OVER SCALE.
- ALL FINISH DOORS ARE TO BE SWUNG IN SUCH A MANNER THAT ACTIVATION OF ONE WILL ACTIVATE THEM ALL.
- ENCLOSED ACCESSIBLE SPACE UNDER STAIRS SHALL HAVE WALLS AND SURFACES PROTECTED ON UNCLOSED SIDE WITH 1/2" O.D. PIPE AT RADIUS.
- ALL WINDOWS SHALL HAVE NOTES INDICATING IF PROTECTIVE FILLS ARE REQUIRED FROM SASH TO SASH.
- REFER TO ELEVATIONS FOR WINDOW HEAD HEIGHTS.
- ALL DOORS ARE TO BE 6' 8" HIGH UNLESS OTHERWISE NOTED.
- WASHERS & NUTS TO BE ON LEFT SIDE OF DOOR.
- DISHWASHER ALWAYS TO BE ON RIGHT SIDE OF SINK.

ROOF VENTILATION CALCULATIONS - TWO CAR GARAGE ROOF


ROOF AREA	=	484.02 SQ. FT.
200	=	1.04 SQ. FT.
200 x 12	=	240.00 SQ. FT.
200 (HOURS)	=	176.00 SQ. FT.
SOFT VENT - REQUIRED (2000 CFM @ 12.5 IN. V.T.C.)	=	16.00 FT.
SOFT VENT - PROVIDED	=	16.00 FT.
SOFT VENT - REQUIRED (2000 CFM @ 12.5 IN. V.T.C.)	=	16.00 FT.
SOFT VENT - PROVIDED	=	16.00 FT.

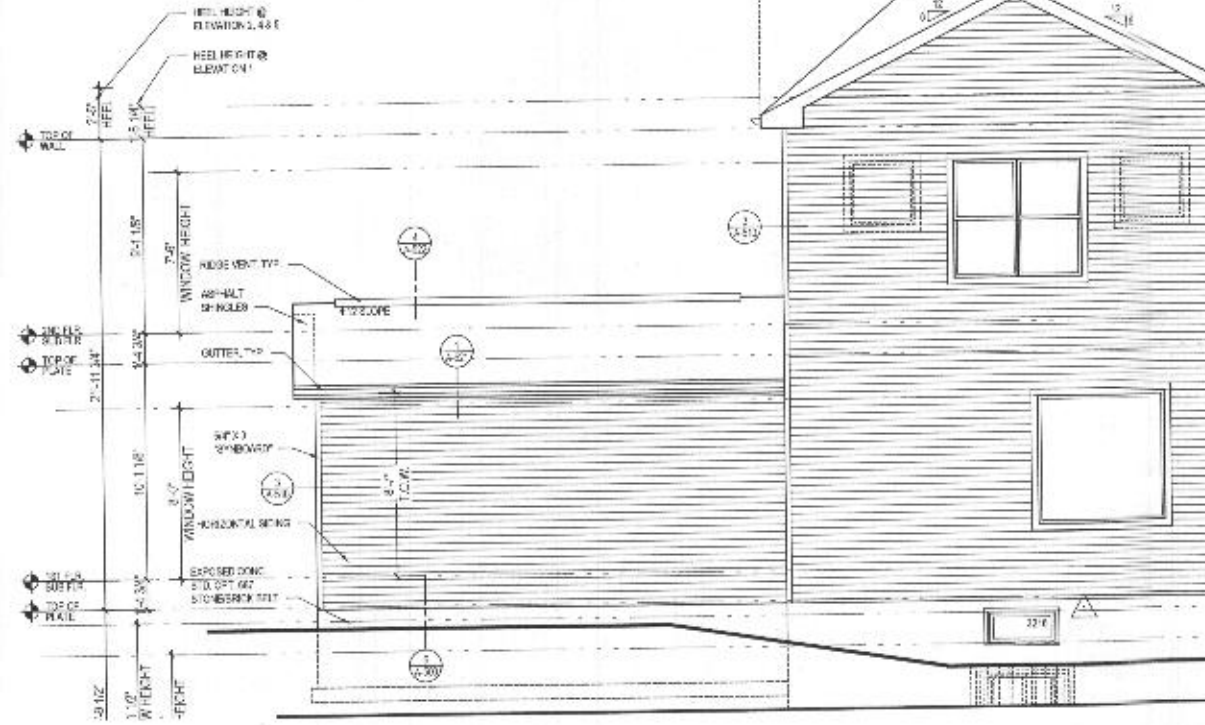


6 PART. REAR ELEVATION w/ OPT. 263019 - ADDITIONAL TWO CAR FRONT ENTRY GARAGE
A-404 SCALE: 1/4" = 1'-0" ELEV. 1 - SHOWN




4 PART. FRONT ELEVATION w/ OPT. 263019 - ADDITIONAL TWO CAR FRONT ENTRY GARAGE
A-404 SCALE: 1/4" = 1'-0" ELEV. 1 - SHOWN

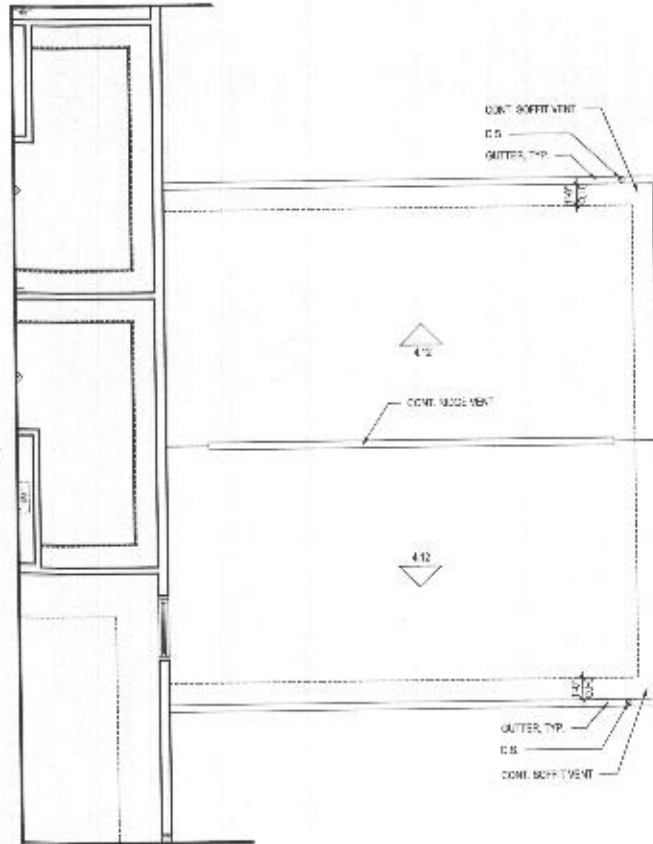

3 P. SECOND FLOOR w/ OPT. 263019 - ADDITIONAL TWO CAR FRONT ENTRY GARAGE
A-404 SCALE: 1/4" = 1'-0"

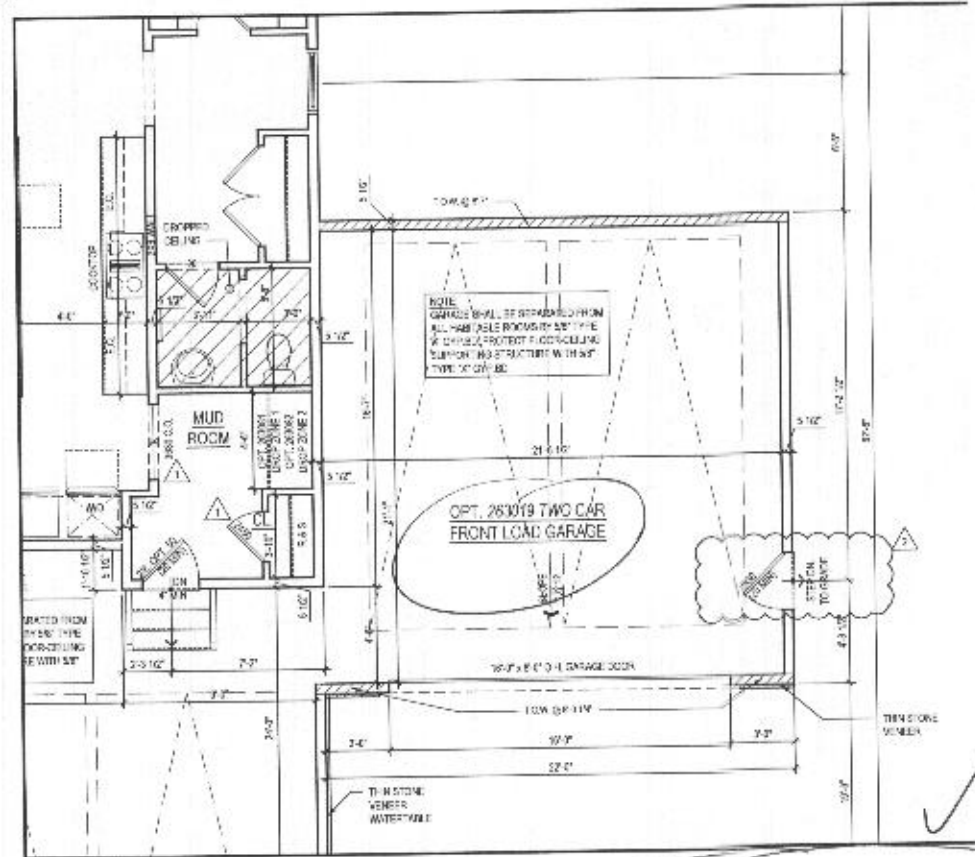

2 PART. FIRST FLOOR PLAN w/ OPT. 263019 - ADDITIONAL TWO CAR FRONT ENTRY GARAGE
A-404 SCALE: 1/4" = 1'-0"

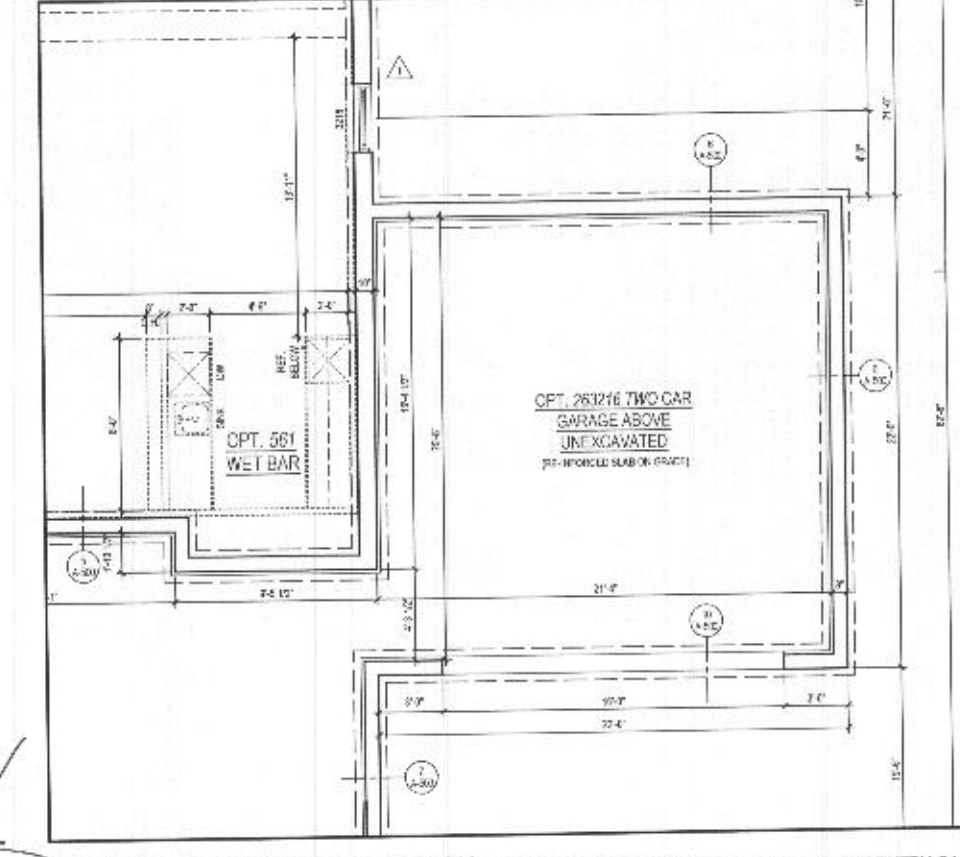

1 PART. BASEMENT FLOOR PLAN w/ OPT. 263019 - ADDITIONAL TWO CAR FRONT ENTRY GARAGE
A-404 SCALE: 1/4" = 1'-0"

lessard
DESIGN
8571 Leesburg Pike
Suite 700 | Vienna, VA 22182
P: 571.830.1800 | F: 571.830.1801
www.lessarddesign.com


TOLL BROTHERS
15775 BELMONT EXECUTIVE PLAZA
ASHBURN, VA 20147
P: 571.291.0700
CONTACT: CHRISTINA LEMLEY
cllemley@tollbrothers.com

MARYLAND
PARKHURST
OPTIONS


NO.	DESCRIPTION	DATE
1	PERMIT SET	05.29.12
2	REVISIONS	06.18.12
3	FINAL	06.18.12

A-404


- [illegible]

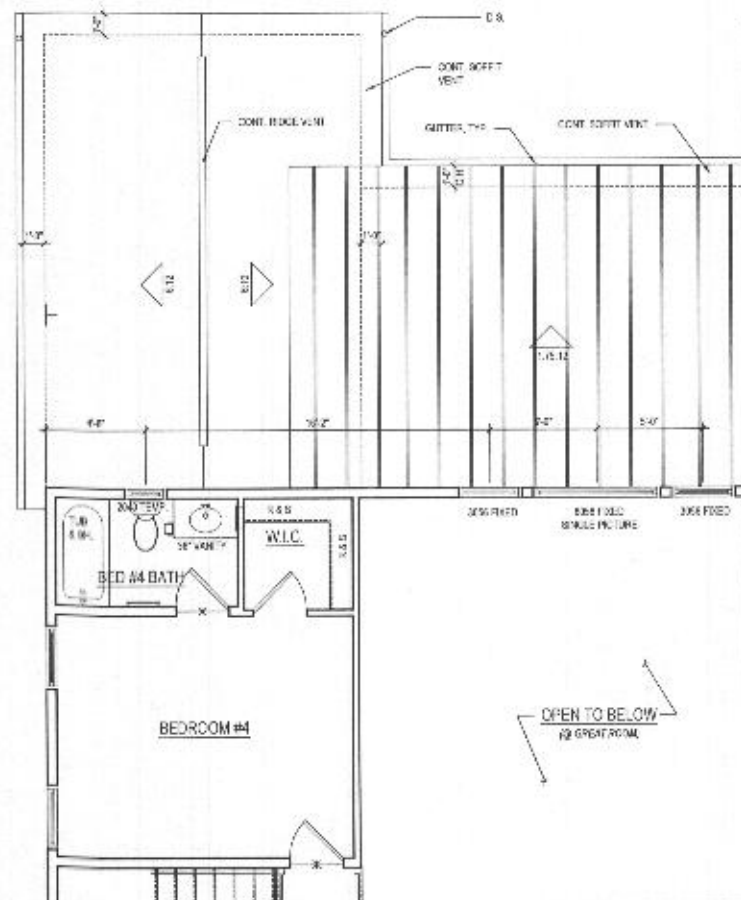W/ OPT. 263073 MULTI-GEN. SUITE
 263073 OUTLINE LIVING @ WALKOUT CONDO.w/ OPT. 263073 MULTI-GEN. SUITE
w/ 2NDY OUTDOOR LIVING & WALKOUT CONDITIO

W/ OPT. 263073 MULTI-GEN. SUITE

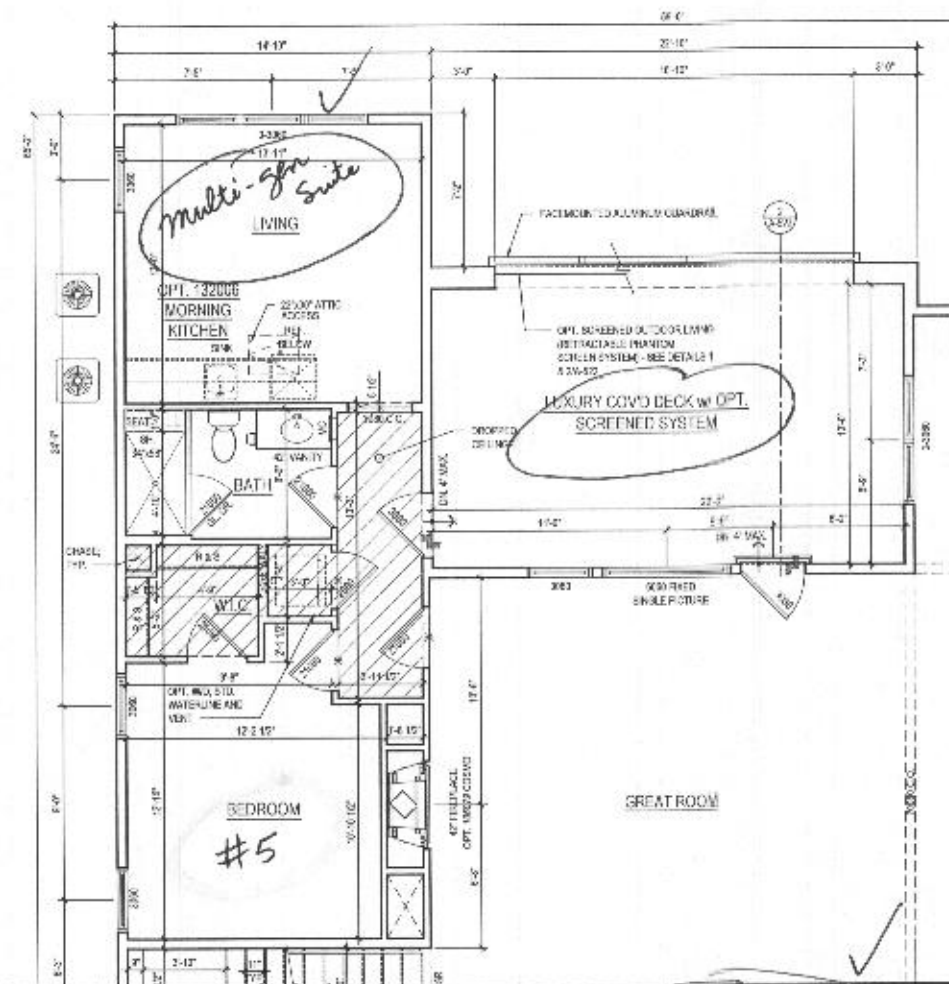

W/ OPT. 263073 MULTI-GEN. SUITE

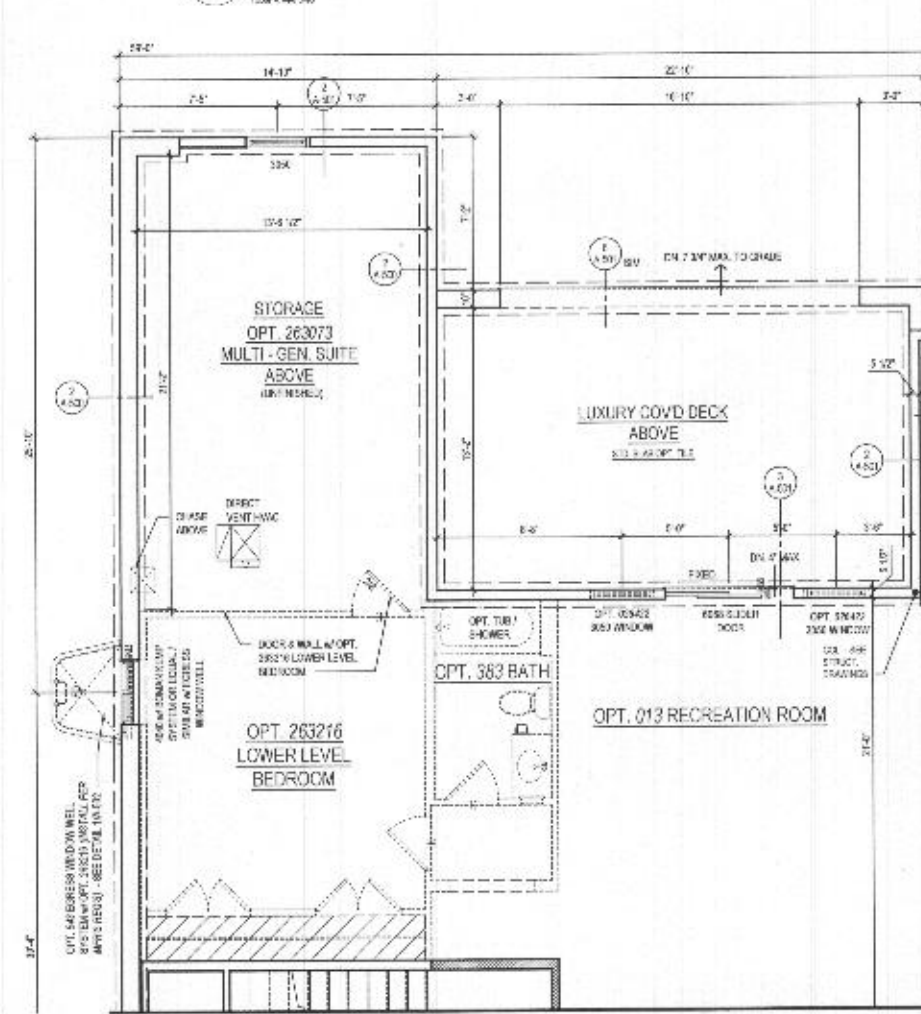w/ OPT. 263073 MULTI-GEN. SUITE
w/ COVD OUTDOOR LIVING & WALKOUT CONDITIO

Health Dept

B27000468

GENERAL PLAN NOTES


1. ALL WOOD STUD PARTITIONS NOT DIMENSIONED ARE TO BE 2" X 4" FOR INTERIOR AND 2" X 6" FOR EXTERIOR WALLS UNLESS OTHERWISE NOTED.
2. ALL INTERIOR DIMENSIONS ARE TO FACE OF STUD.
3. ALL EXTERIOR DIMENSIONS ARE TO FACE OF STUD.
4. ALL DIMENSIONS COVER COVER SIZES.
5. ALL BACK DETECTORS ARE TO BE WIRE IN SUCH A MANNER THAT ACTIVATION OF ONE WILL ACTIVATE THE OTHER.
6. UNLOCATED ACCESSIBLE SPACE UNDER STAIRS SHALL HAVE WALLS AND ROOF PROTECTED ON ENCLOSED SIDS WITH 1/2" GYPSUM BOARD.
7. ALL WINDOWS ARE TO BE NOTED IN PLAN AND ENCLOSED FROM BACK TO RASH.
8. REFER TO ELEVATIONS FOR WINDOW HEAD HEIGHTS.
9. ALL DOORS ARE TO BE 6' 8" HIGH UNLESS OTHERWISE NOTED.
10. WASH-ER ALWAYS TO BE ON LEFT SIDE OF DOOR.
11. DOOR WASH-ER ALWAYS TO BE ON RIGHT SIDE OF DOOR.

10525 Pudding Lane

Lot 30

Kings Forest

(Kingsley Woods)

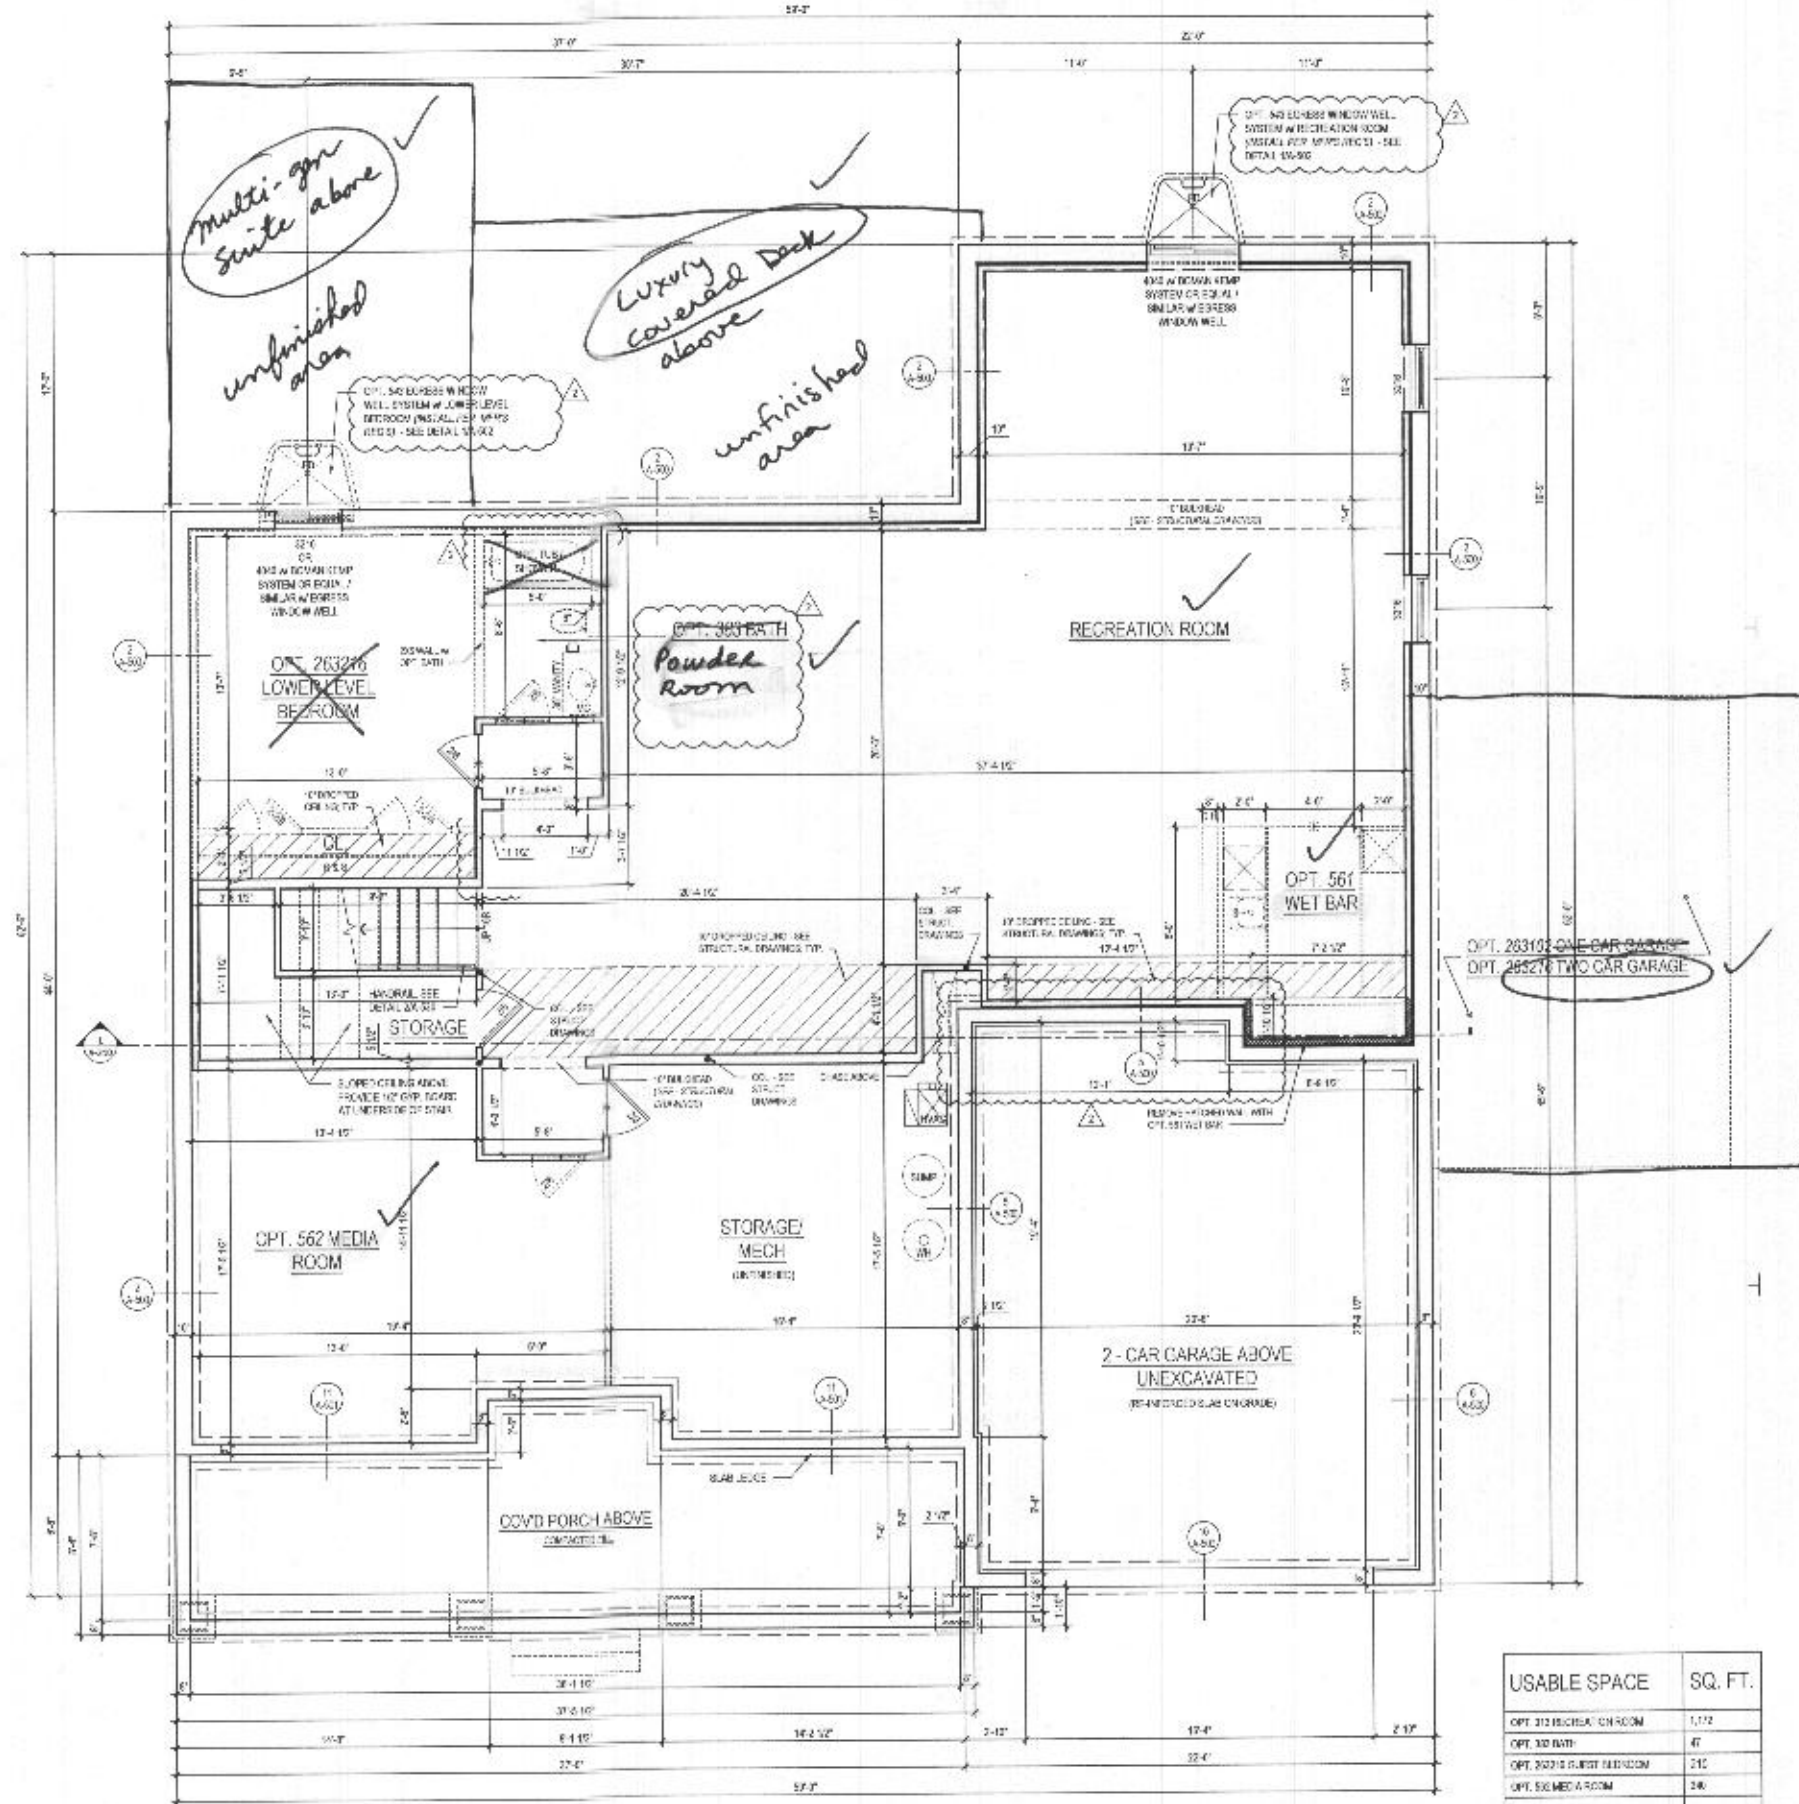

1 BASEMENT FLOOR PLAN
A-100a SCALE: 1/8" = 1'-0"

W/ OPT 013 RECREATION ROOM @ ELEV. 1 - CRAFTSMAN
@ FINISHED CONDITION

USABLE SPACE	SQ. FT.
OPT. 212 RECREATION ROOM	1,172
OPT. 312 BATH	47
OPT. 20212 FIRST BEDROOM	210
OPT. 561 MEDIA ROOM	240
TOTAL	1,669

lessard DESIGN

8521 Leesburg Pike
Suite 700 | Vienna, VA 22182
P: 571.830.1500 | F: 571.830.1801
www.lessarddesign.com

SEAL & SIGNATURE:

TOLL BROTHERS

12775 BELMONT EXECUTIVE PLAZA
ARLINGTON, VA 22207
P: 571.201.2055
CONTACT: CHRISTINA LOWERY
christina@tollbrothers.com

MARYLAND

PARKHURST FLOOR PLANS

DATE: 11/11/20

SCALE: 1/8" = 1'-0"

PROJECT NO: A-100a

DRAWN BY: J. L. L.

CHECKED BY: J. L. L.

DATE: 11/11/20


SCALE: 1/8" = 1'-0"

A-100a


GENERAL PLAN NOTES

- ALL WOOD STUD PARTS NOT DIMENSIONED ARE TO BE 2" X 4" ON CENTER AND 1" X 6" FOR EXTERIOR WALLS UNLESS OTHERWISE NOTED.
- ALL INTERIOR DIMENSIONS ARE TO FACE OF STUDS.
- ALL EXTERIOR DIMENSIONS ARE TO FACE OF STUDS.
- ALL VENTILATION COVERS ARE TO BE 1" X 6" ON CENTER.
- ALL SINKS DETECTORS ARE TO BE INSTALLED IN SUCH A MANNER THAT ACTIVATION OF ONE WILL ACTIVATE THEM ALL.
- ENCLOSURE ACCESSIBLE SPACE UNDER STAIRS SHALL BE PART WALLS AND DOORS PROTECTED ON ENCLOSED FIRST FLOOR ONLY UNLESS OTHERWISE NOTED.
- ALL WINDOWS ARE TO BE 1" X 6" ON CENTER MEASURED FROM FACE TO FACE.
- REFER TO ELEVATIONS FOR WINDOW HEAD HEIGHTS.
- ALL DOORS ARE TO BE 6' 8" HIGH UNLESS OTHERWISE NOTED.
- WALLS ARE ALWAYS TO BE ON RIGHT SIDE OF DOOR.
- DOOR SWINGS ARE ALWAYS TO BE ON RIGHT SIDE OF DOOR.

See detail pages

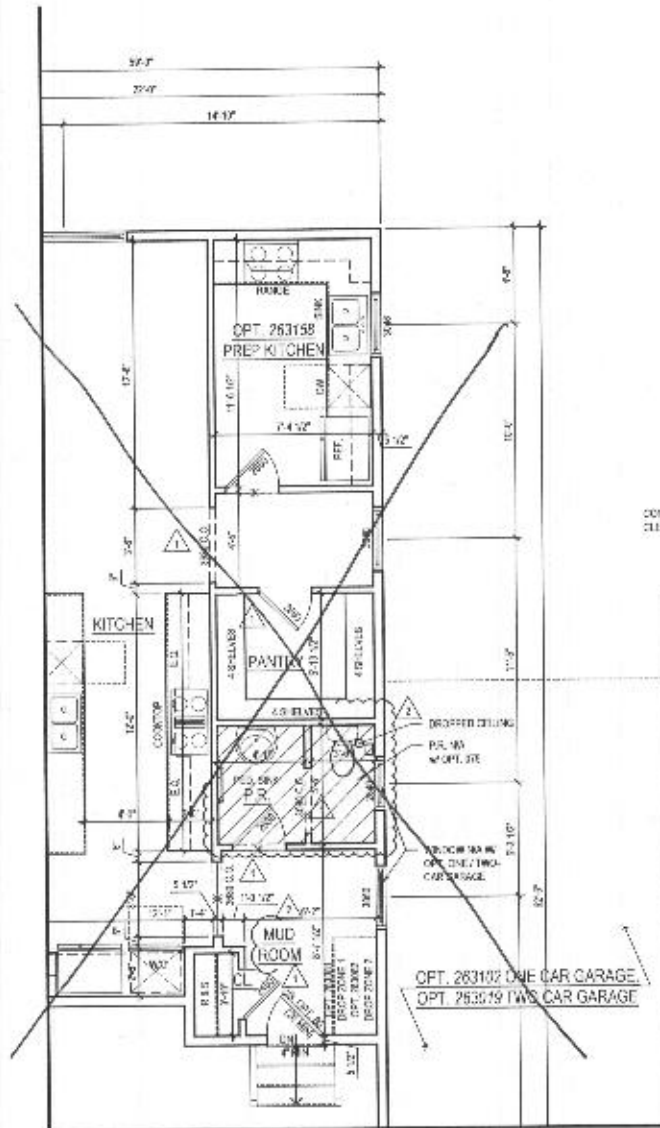

2 PART. FIRST FLOOR PLAN w/ OPT. 263158 - OPT. PREP KITCHEN
A-110 SCALE 1/4" = 1'-0"
TOLUNA

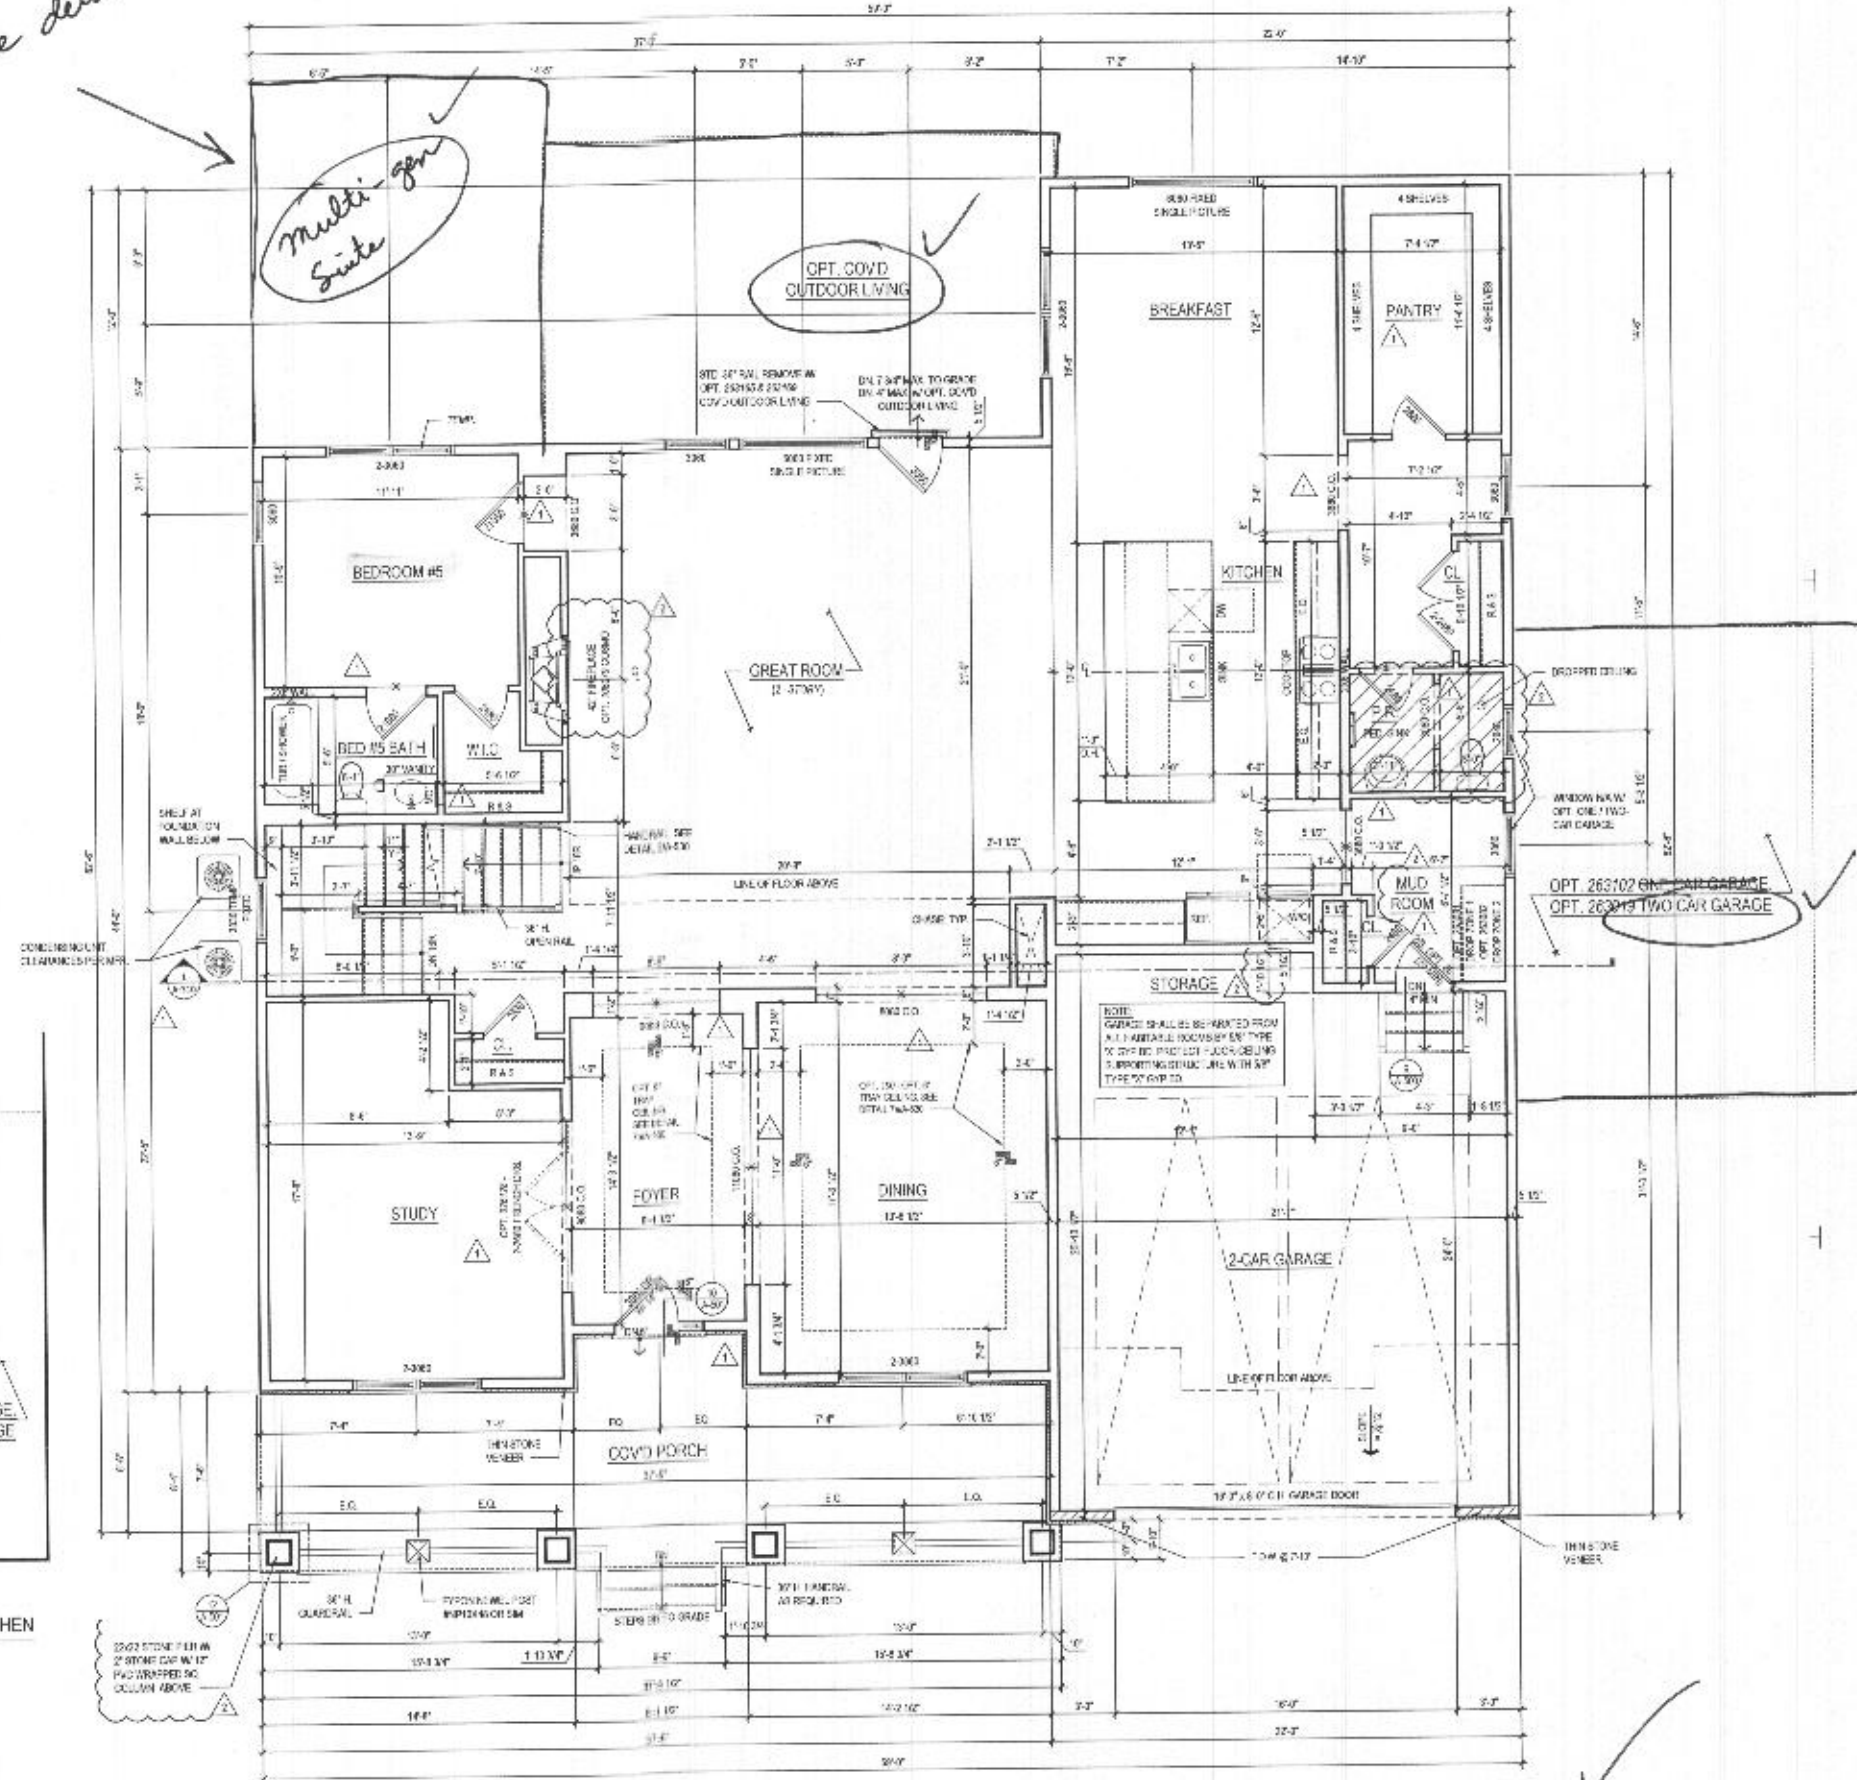

1 FIRST FLOOR PLAN
A-110 SCALE 1/4" = 1'-0"
TOLUNA

ELEV. 1 - CRAFTSMAN

lessard
DESIGN

8531 Leesburg Pike
Suite 700 | Vienna, VA 22182
703.71.830.1800 | 1.71.830.1800
www.lessarddesign.com

STYL & ARCHITECTURE

COWNER:

TOLL BROTHERS

15775 BELMONT EXECUTIVE PLAZA
ASHBURGH, VA 20147
P: 571.281.8058
CONTACT: CHRISTINA LEWLEY
clwley@tollbrothers.com

PROJECT NAME:

MARYLAND

PARKHURST

FLOOR PLANS

ISSUE / REVISION

NO.	DESCRIPTION	DATE
1	ISSUED SET	05.24.19
2	REVISED SET	06.14.19
3	REVISED SET	06.14.19
4	REVISED SET	06.14.19

PROJECT NO: TOLUNA


DRAWN BY: A-110

CHECKED BY: A-110

PLotted DATE: 06.14.19


FILE NAME: TOLUNA_A110.dwg

A-110

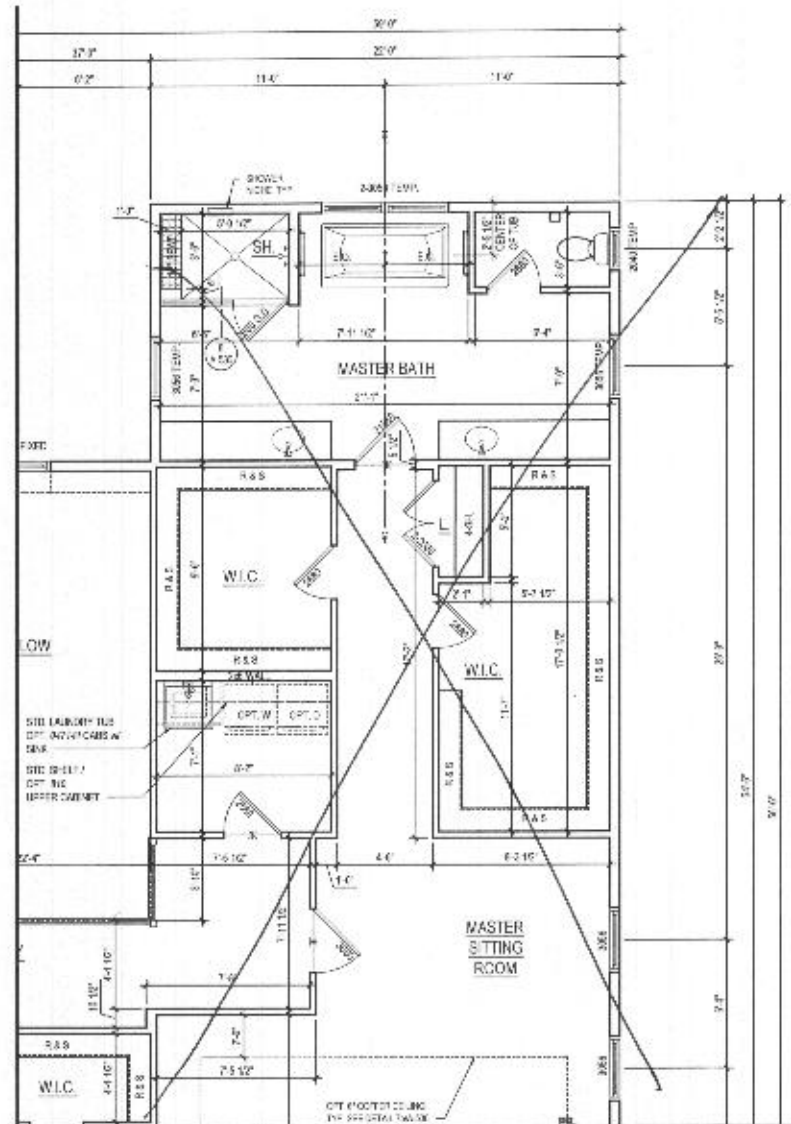

2 PART. SECOND FLOOR PLAN W/ OPT. 030 - ADDITIONAL WALK IN CLOSET
A-120 SCALE 1/8"=1'-0"

- GENERAL PLAN NOTES**
- ALL WOOD STUD PARTITIONS NOT DIMENSIONED ARE TO BE 1 1/2" FOR INTERIOR AND 1 1/2" FOR EXTERIOR WALLS UNLESS OTHERWISE NOTED.
 - ALL INTERIOR DIMENSIONS ARE TO FACE OF STUD.
 - ALL EXTERIOR DIMENSIONS ARE TO FACE OF STUD.
 - ALL DIMENSIONS GOVERN OVER SCALE.
 - ALL DIMENSIONS ARE TO BE SHOWN IN EACH DIRECTION THAT ACTIVATION OF DIM WILL ACTIVATE THE WALL.
 - ENCLOSED ACCESSIBLE SPACE UNDER STAIRS SHALL HAVE WALLS AND BUFF TO PROTECT ON ENCLOSED SIDE WITH 1/2" OFF FROM BOARD.
 - ALL WINDOWS ARE TO BE 1/2" FROM FACE AS MEASURED FROM SASH TO SASH.
 - REFER TO ELEVATIONS FOR WINDOW HEAD HEIGHTS.
 - ALL DOORS ARE TO BE 6'-0" UNLESS OTHERWISE NOTED.
 - WASHER ALWAYS TO BE ON LEFT SIDE OF DRYER.
 - DRY-WASHER ALWAYS TO BE ON RIGHT SIDE OF SINK.

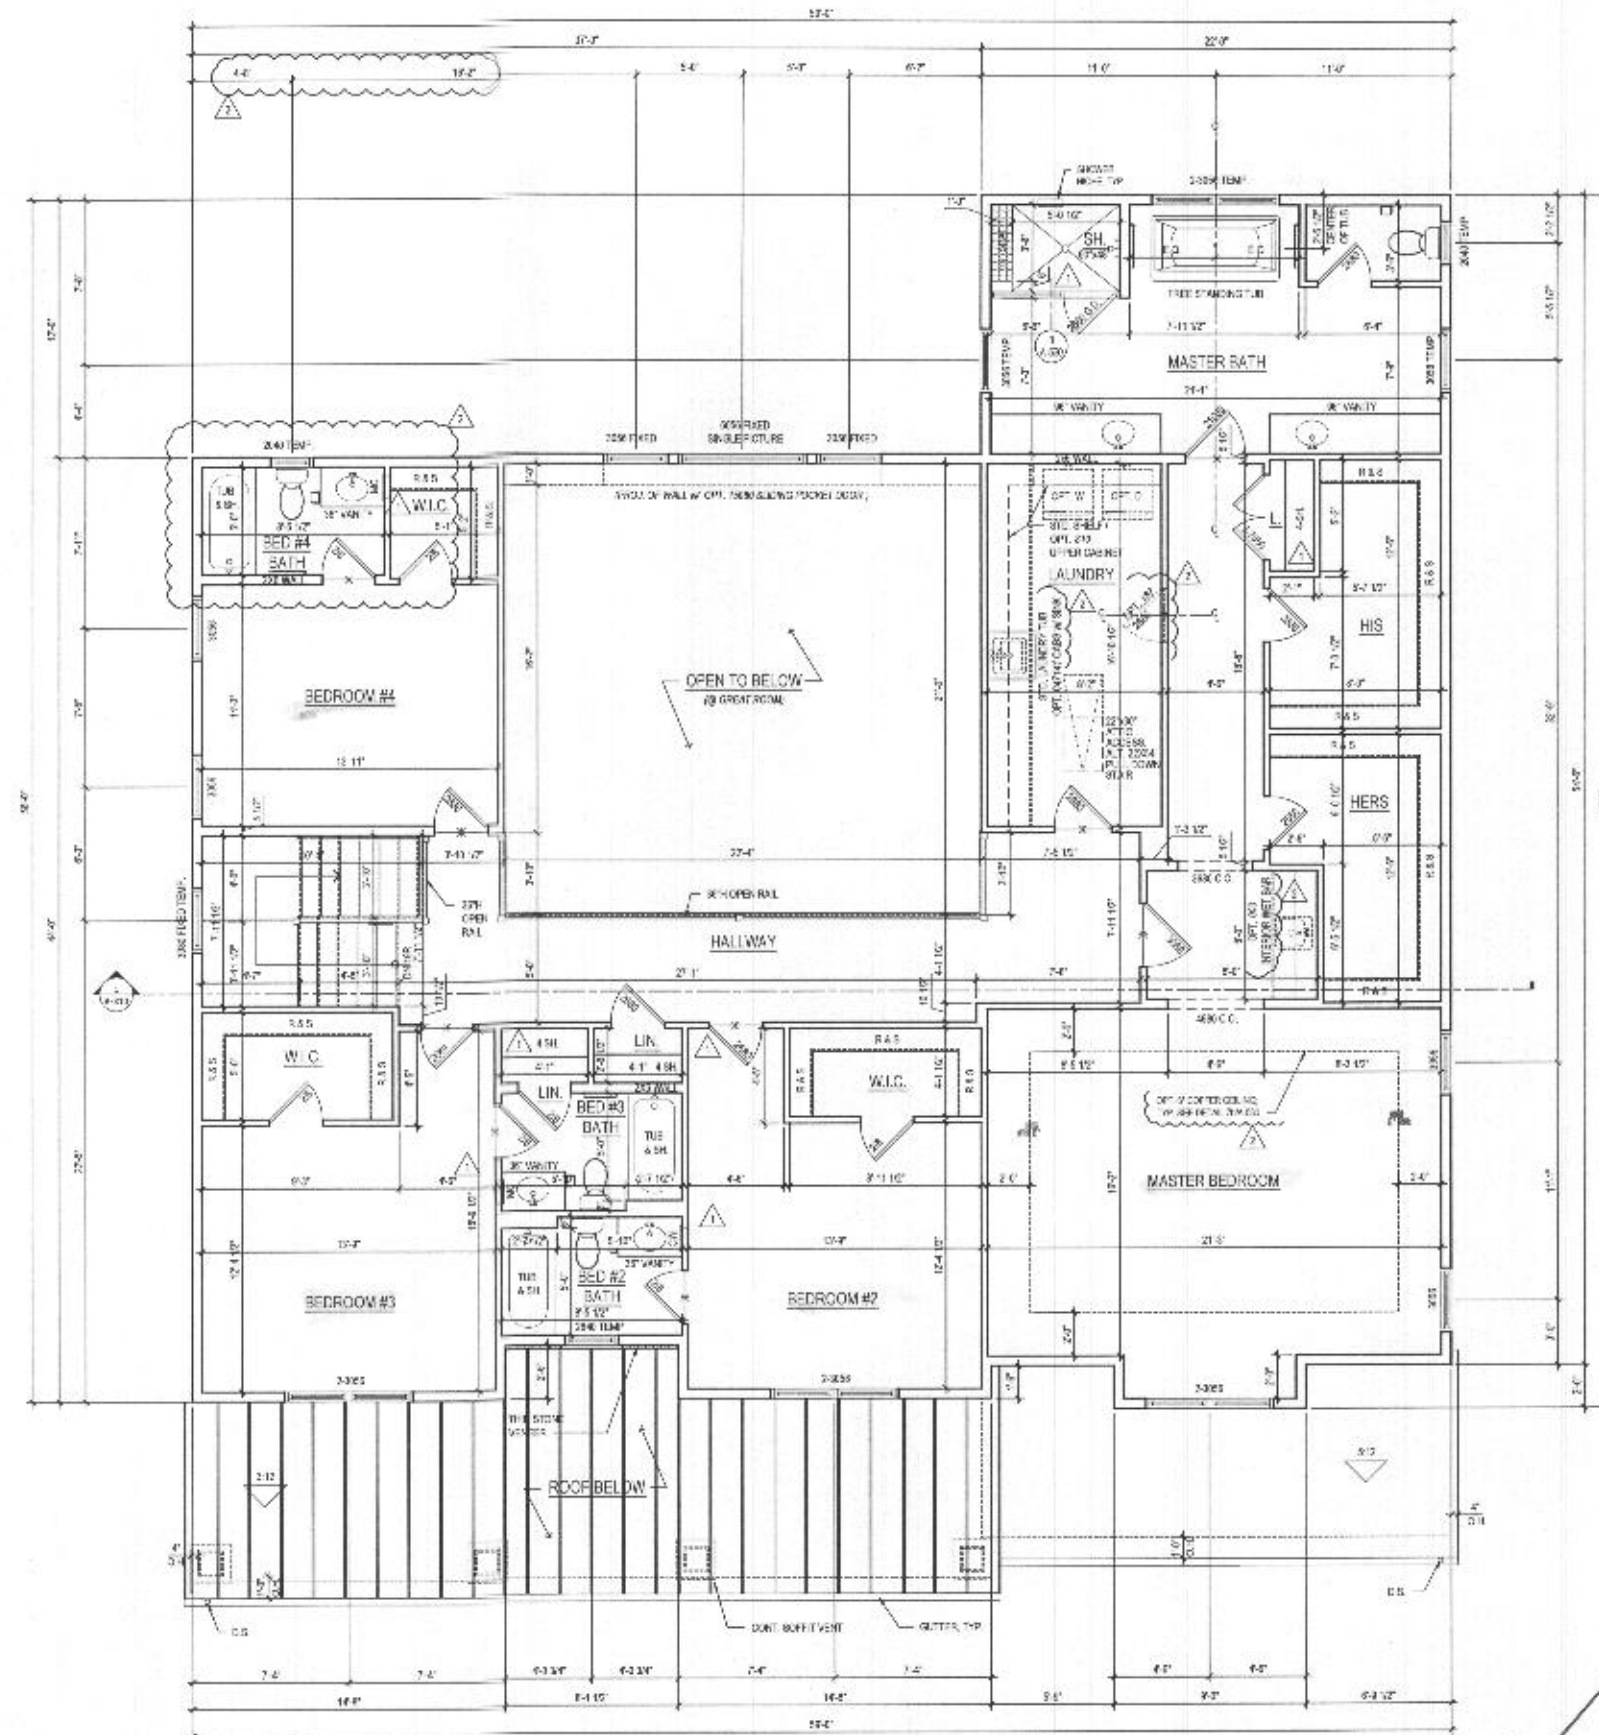

1 SECOND FLOOR PLAN
A-120 SCALE 1/8"=1'-0"

@ ELEV. 1 - CRAFTSMAN

ARCHITECT

lessard DESIGN

8521 Lessard Pike
Suite 700 | Vienna, VA 22182
P: 703.830.1800 | F: 703.830.1801
www.lessarddesign.com

OWNER

TOLL BROTHERS
15775 BELMONT EXECUTIVE PLAZA
ASHBURN, VA 20147
P: 571.220.9058
CONTACT: CHRISTINA LEMLEY
clmley@tollbrothers.com

PROJECT NAME: **PARKHURST FLOOR PLANS**

PROJECT NO: **A-120**

DATE: **05.22.12**

REVISIONS:

NO.	DESCRIPTION	DATE
1	PROJECT SET	05.22.12
2	PROVIDE ANGLE MARKS	05.22.12
3	PROVIDE CLOSET	05.22.12

PROJECT NO: **A-120**

DATE: **05.22.12**

CHECKED BY: **JP**


PLANT DATE: **05.22.12**

FILE NAME: **TOLBRO_A120.dwg**

A-120




4 PART. RIGHT SIDE ELEVATION w/ OPT. D12 - SIDE LOAD GARAGE
 SCALE: 1/4"=1'-0"
 ELEV. 2 - SHOWN

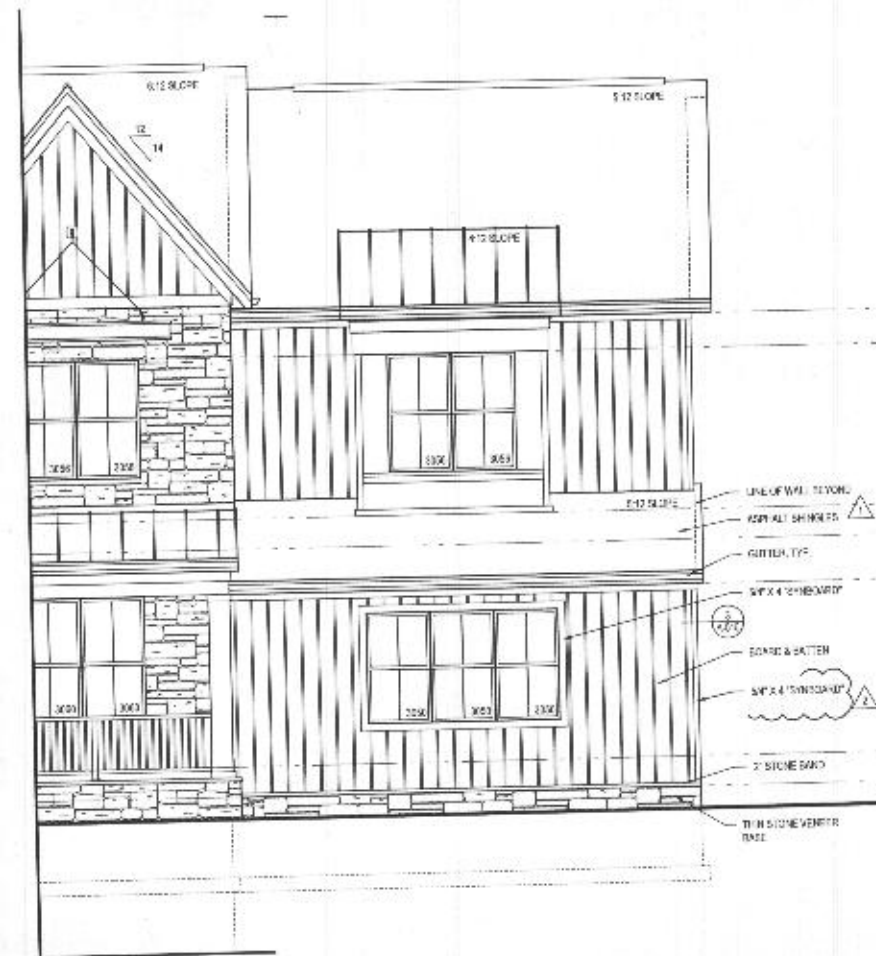


3 PART. FRONT ELEVATION w/ OPT. D12 - SIDE LOAD GARAGE
 SCALE: 1/4"=1'-0"
 ELEV. 2 - SHOWN

- GENERAL PLAN NOTES**
- ALL WOOD STUD PARTITION WALLS UNLESS NOTED ARE TO BE 2" X 12" FOR INTERIOR AND 2" X 10" FOR EXTERIOR WALLS UNLESS OTHERWISE NOTED.
 - ALL INTERIOR DIVIDING WALLS ARE TO FACE OF STUDS.
 - ALL GUTTER OR DRAINAGE ARE TO FACE OF STUDS.
 - ALL DIMENSIONS GOVERN OVER SCALE.
 - ALL SMOKE DETECTORS ARE TO BE WIRED IN SUCH A MANNER THAT ACTIVATION OF ONE WILL ACTIVATE THEM ALL.
 - ENCLOSURE ACCESSIBLE TRAP UNDER STAIRS SHALL HAVE HANDS AND SCISSOR PHOTOGRAPHIC ENCLOSED WITH 1/2" PROTRUSION BOARD.
 - ALL WINDOWS ARE TO BE NOTED IN FLOOR PLANS AS INDICATED FROM DASH TO DASH.
 - REFER TO ELEVATIONS FOR WINDOW HEAD HEIGHTS.
 - ALL DOORS ARE TO BE 6'-0" HIGH UNLESS OTHERWISE NOTED.
 - WASHERS ALWAYS TO BE ON LEFT SIDE OF DOOR.
 - DOORWAYS ALWAYS TO BE ON RIGHT SIDE OF DOOR.

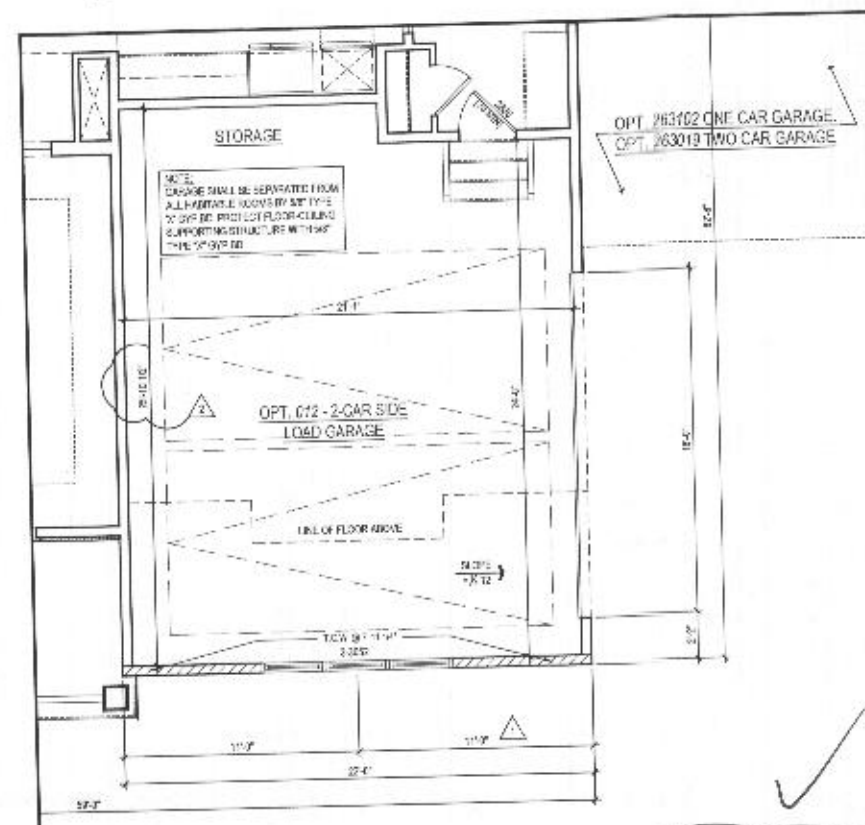

2 PART. FIRST FLOOR PLAN w/ OPT. D12 - SIDE LOAD GARAGE
 SCALE: 1/4"=1'-0"
 ELEV. 2 - SHOWN

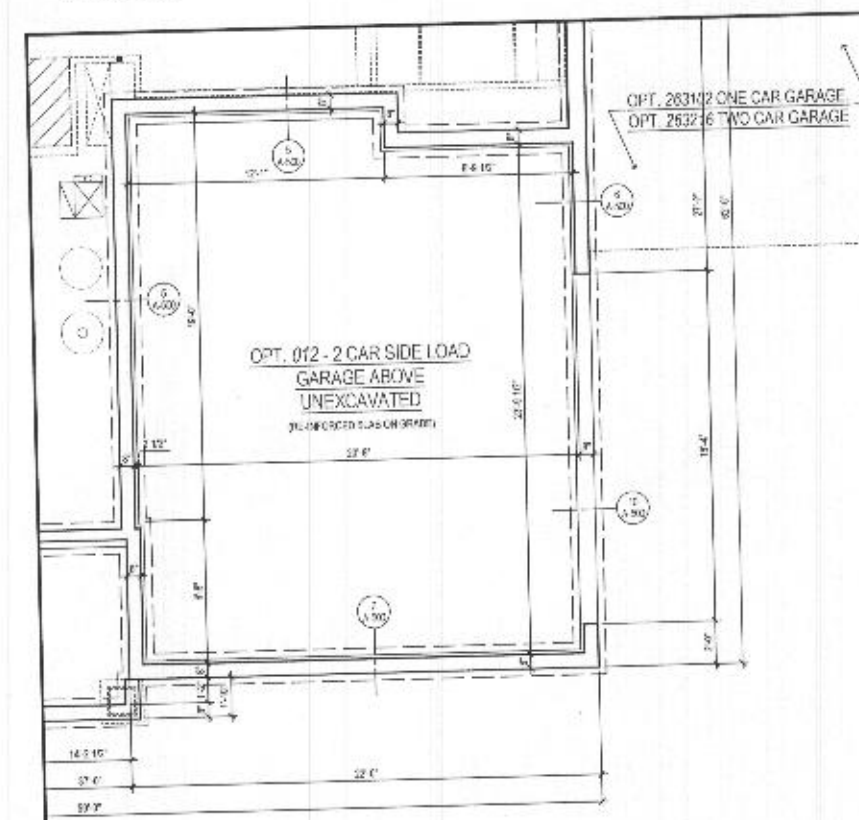

1 PART. BASEMENT FLOOR PLAN w/ OPT. D12 - SIDE LOAD GARAGE
 SCALE: 1/4"=1'-0"
 ELEV. 2 - SHOWN

lessard DESIGN
 8521 Leesburg Pike
 Suite 700 | Vienna, VA 22182
 P: 571.830.1800 | F: 571.830.1801
 www.lessarddesign.com

STYL & SIGNATURE

OWNER:

TOLL BROTHERS
 12775 BELMONT EXECUTIVE PLAZA
 ALEXANDRIA, VA 22304
 P: 571.701.4588
 CONTACT: CHRISTINA LEMLEY
 clemley@tollbrothers.com

ESSEX HOMES
 MARYLAND

PARKHURST
OPTIONS

PROJECT NAME:

SHEET TITLE:

ISSUE / REVISION	
NO.	DESCRIPTION
1	REVISED
2	REVISED
3	REVISED
4	REVISED
5	REVISED
6	REVISED
7	REVISED
8	REVISED
9	REVISED
10	REVISED

PROJECT NO. 104-011
 DRAWN BY: MGR
 CHECKED BY: MGR
 PLOT DATE: 10/11/11
 PLOT NAME: 104-011-01


A-400b

GENERAL PLAN NOTES

- ALL WOOD STUD PARTITIONS NOT DIMENSIONED ARE TO BE 2" FOR INTERIOR AND 4" FOR EXTERIOR WALLS UNLESS OTHERWISE NOTED.
- ALL INTERIOR DIMENSIONS ARE TO FACE OF STUDS.
- ALL EXTERIOR DIMENSIONS ARE TO FACE OF STUDS.
- ALL DIMENSIONS CONTAIN OVER SCALE.
- ALL PARTITION WALLS ARE TO BE WEDGED IN SUCH A MANNER THAT ACTIVATION OF ONE WILL ACTIVATE THE OTHER.
- ENCLOSED ACCESSIBLE SPACE UNDER STAIRS SHALL HAVE WALLS AND SLOTTED PROTECTORS ON ENCLOSED SIDS WITH 1" X 10" UPSTAIR BOARD.
- ALL WINDOWS ARE TO BE NOTED IN THIS AS MEASURED FROM CASH TO CASH.
- REFER TO ELEVATIONS FOR WINDOW HEAD HEIGHTS.
- ALL DOORS ARE TO BE 36" WIDE UNLESS OTHERWISE NOTED.
- WALLS ALWAYS TO BE ON LEFT SIDE OF DOOR.
- DISHWASHER ALWAYS TO BE ON RIGHT SIDE OF SINK.

ROOF VENTILATION CALCULATIONS - TWO CAR GARAGE ROOF


ROOF AREA	=	484.00 SQ. FT.
1800	=	1.61 SQ. FT.
12 x 12	=	144.00 SQ. IN.
20% (MINIMUM)	=	113.76 SQ. IN.
ROOF VENT - REQUIRED (MINIMUM @ 12" X 12" @ 1 FT.)	=	10.64 FT.
ROOF VENT - PROVIDED	=	70.00 FT.
20% (MINIMUM)	=	113.76 SQ. IN.
ROOF VENT - REQUIRED (OUTSIDE @ 14" X 14" @ 1 FT.)	=	8.24 FT.
ROOF VENT - PROVIDED	=	19.36 FT.

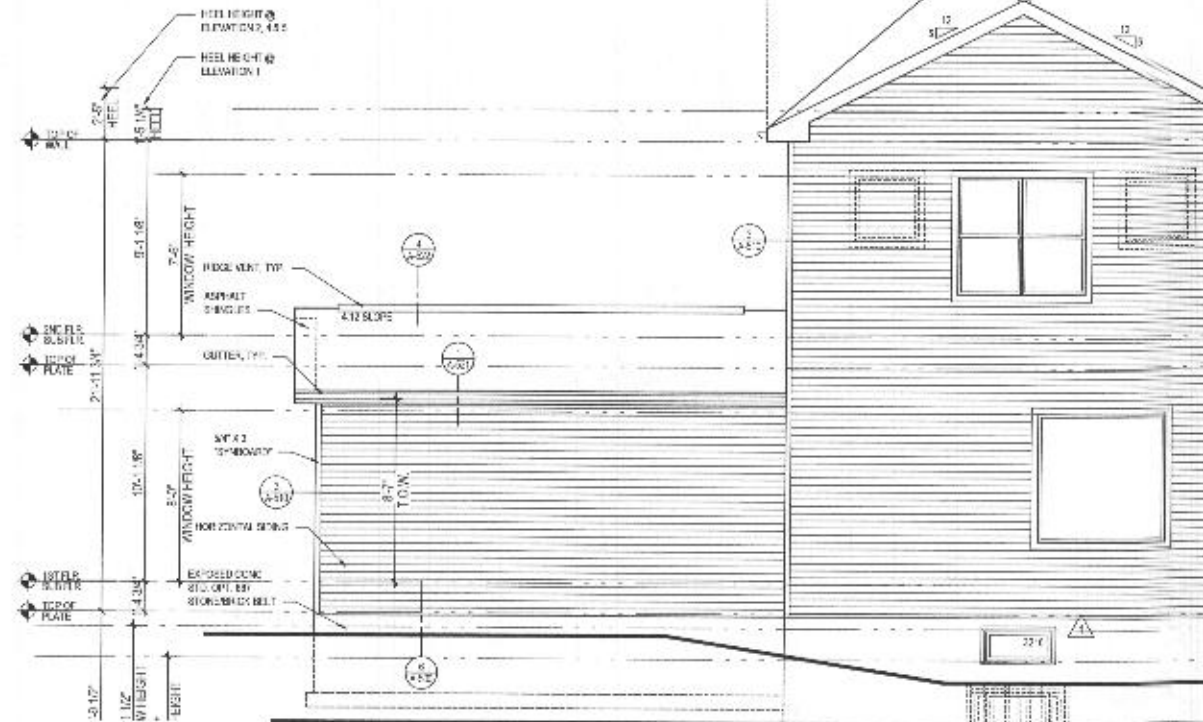


6 PART. REAR ELEVATION w/ OPT. 263019 - ADDITIONAL TWO CAR FRONT ENTRY GARAGE
ELEV. 1 - SHOWN
A-404 SCALE: 1/4" = 1'-0"




4 PART. FRONT ELEVATION w/ OPT. 263019 - ADDITIONAL TWO CAR FRONT ENTRY GARAGE
ELEV. 1 - SHOWN
A-404 SCALE: 1/4" = 1'-0"

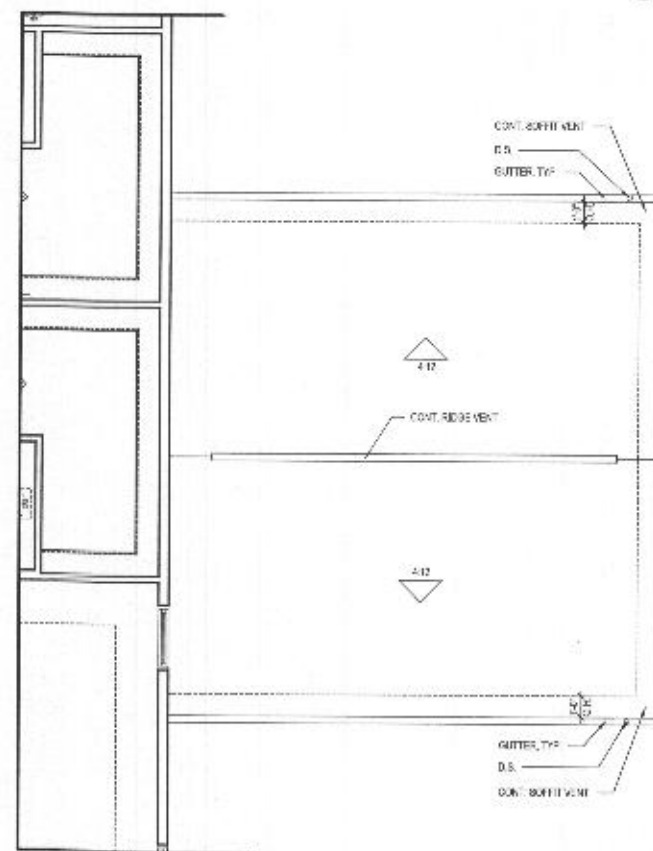

3 P. SECOND FLOOR w/ OPT. 263019 - ADDITIONAL TWO CAR FRONT ENTRY GARAGE
A-404 SCALE: 1/8" = 1'-0"

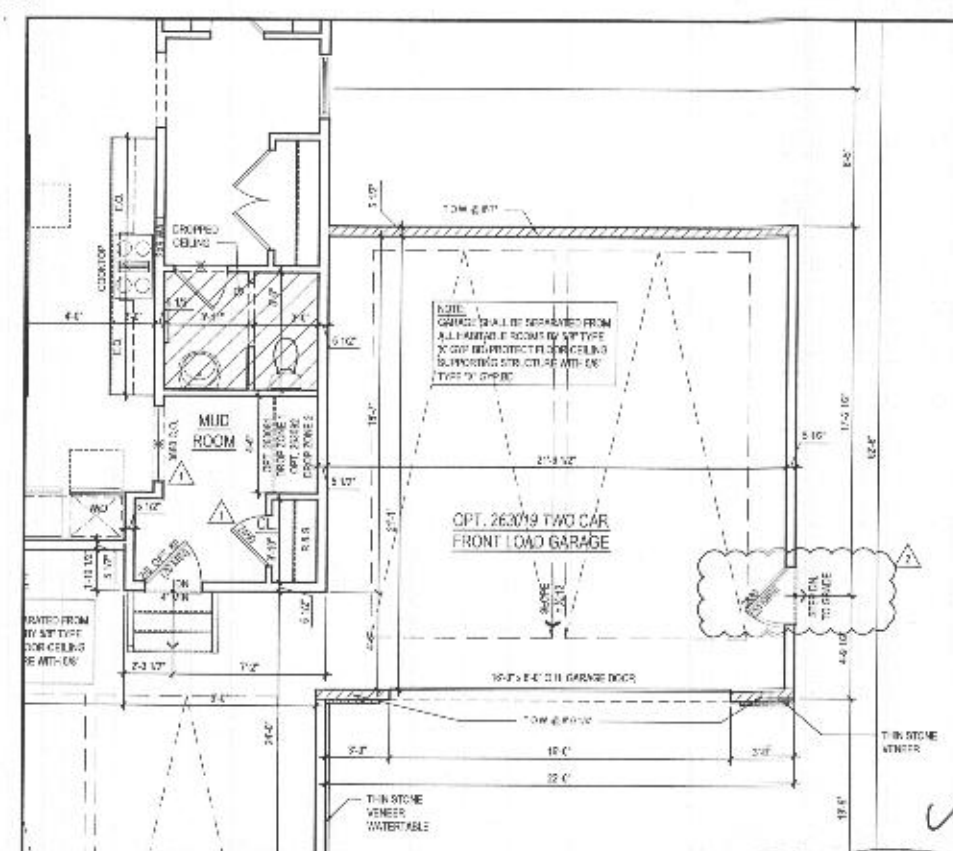

2 PART. FIRST FLOOR w/ OPT. 263019 - ADDITIONAL TWO CAR FRONT ENTRY GARAGE
A-404 SCALE: 1/8" = 1'-0"

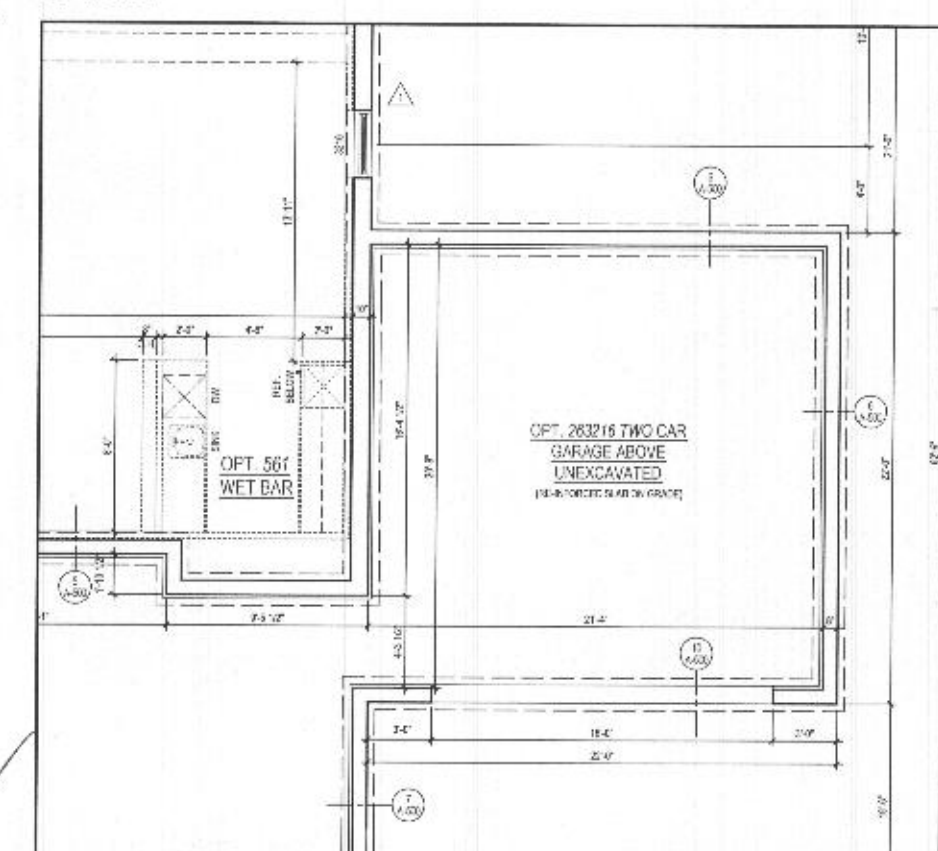

PART. BASEMENT FLOOR PLAN w/ OPT. 263019 - ADDITIONAL TWO CAR FRONT ENTRY GARAGE
A-404 SCALE: 1/8" = 1'-0"

lessard
DESIGN

8521 Leesburg Pike
Suite 700 | Vienna, VA 22182
P: 571.830.1800 | F: 571.830.1801
www.lessarddesign.com

8541 S. 5000 RD.

OWNER:

TOLL BROTHERS

15775 BELMONT EXECUTIVE PLAZA
A9 BLVD, VA 20147
P: 703.251.1000
CONTACT: CHAUNCEY LEMLEY
dlemley@tollbrothers.com

PROJECT NAME:

MARYLAND

PROJECT TITLE:

PARKHURST
OPTIONS

DATE / REVISION

NO.	DESCRIPTION	DATE
1	REVISED	03.19.19
2	REVISED	06.18.19
3	REVISED	09.18.19
4	REVISED	12.11.19

PROJECT NO.

DRAWN BY:

CHECKED BY:


DATE:

BY HAND:

A-404

GENERAL PLAN NOTES

- ALL WOOD STUD PARTITIONS NOT DIMENSIONED ARE TO BE 2"X8" FOR INTERIOR AND 2"X6" FOR EXTERIOR AND 1"X6" FOR PORCHES.
- ALL INTERIOR DIMENSIONS ARE TO FACE OF STUDS.
- ALL EXTERIOR DIMENSIONS ARE TO FACE OF STUDS.
- ALL DIMENSIONS GIVEN ON SCALE.
- ALL WINDOW DETECTORS ARE TO BE WIRED IN SUCH A MANNER THAT ACTIVATION OF ONE WILL ACTIVATE THEM ALL.
- ENVELOPED ACCESSIBLE SPACE UNDER 2"X8" STUDS SHALL HAVE WALLS AND DOORS PROTECTED ON THE EXTERIOR SIDE WITH 1/2" THICK POLYURETHANE BOARD.
- ALL WINDOW SILL ARE NOTED IN FEET - INCHES AS MEASURED FROM FINISH TO SILL.
- REFER TO ELEVATIONS FOR WINDOW HEAD HEIGHTS.
- ALL DOORS ARE TO BE 34" HIGH UNLESS OTHERWISE NOTED.
- WALLS ALWAYS TO BE ON LEFT SIDE OF DOOR.
- DOORSWITCH ALWAYS TO BE ON RIGHT SIDE OF DOOR.

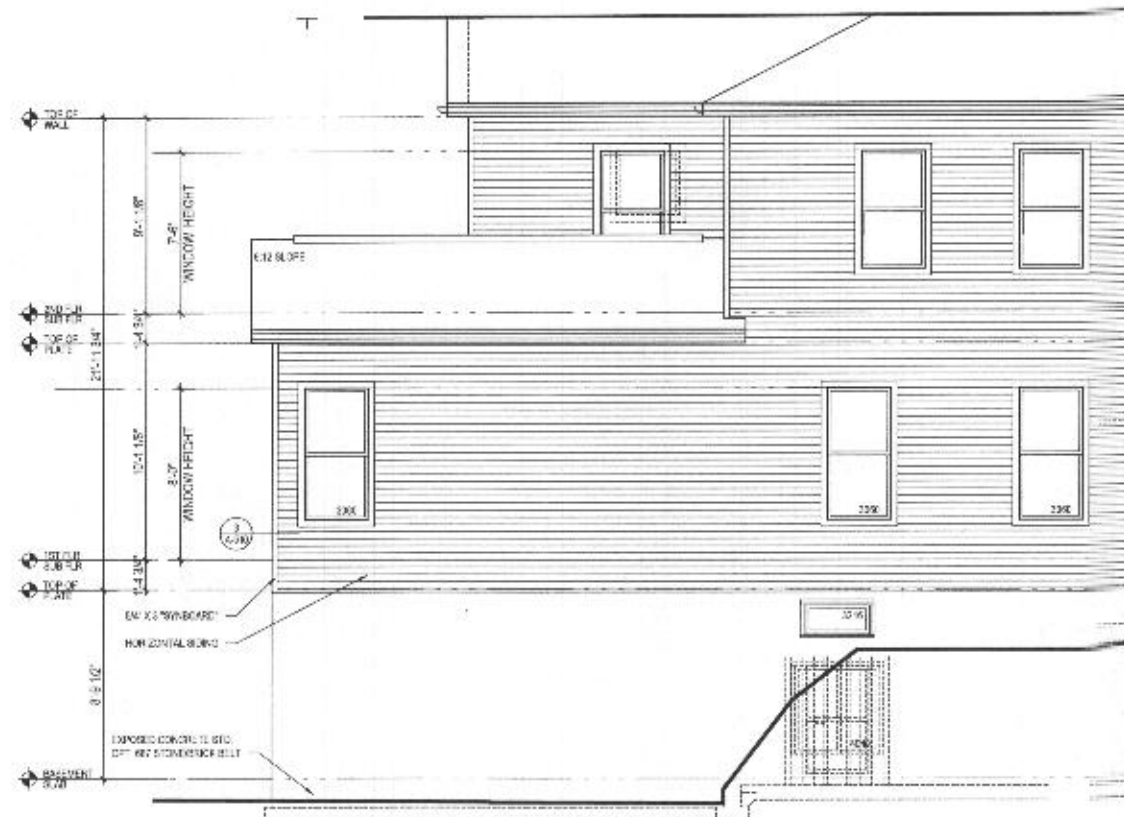


5 PART. LEFT ELEV.
A-407 SCALE: 1/4"=1'-0"

W/ OPT. 263073 MULTI-GEN. SUITE
W/ COVD OUTDOOR LIVING & WALKOUT DECK




4 REAR ELEVATION
A-407 SCALE: 1/4"=1'-0"

W/ OPT. 263073 MULTI-GEN. SUITE
W/ COVD OUTDOOR LIVING & WALKOUT DECK

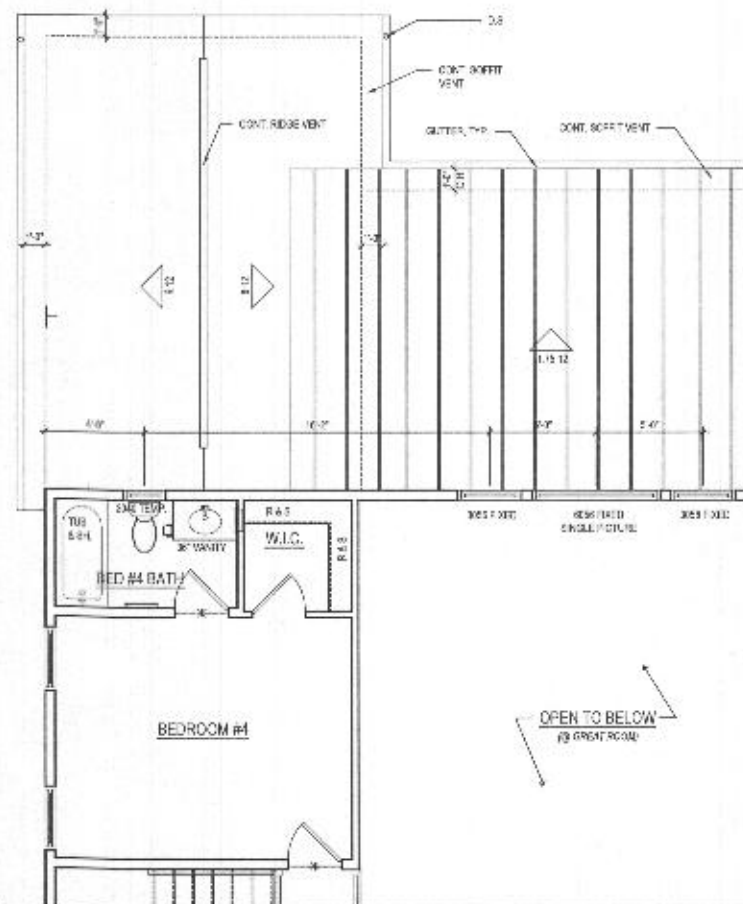


3 PART. SECOND FLOOR PLAN
A-407 SCALE: 1/4"=1'-0"

W/ OPT. 263073 MULTI-GEN. SUITE
W/ COVD OUTDOOR LIVING & WALKOUT DECK

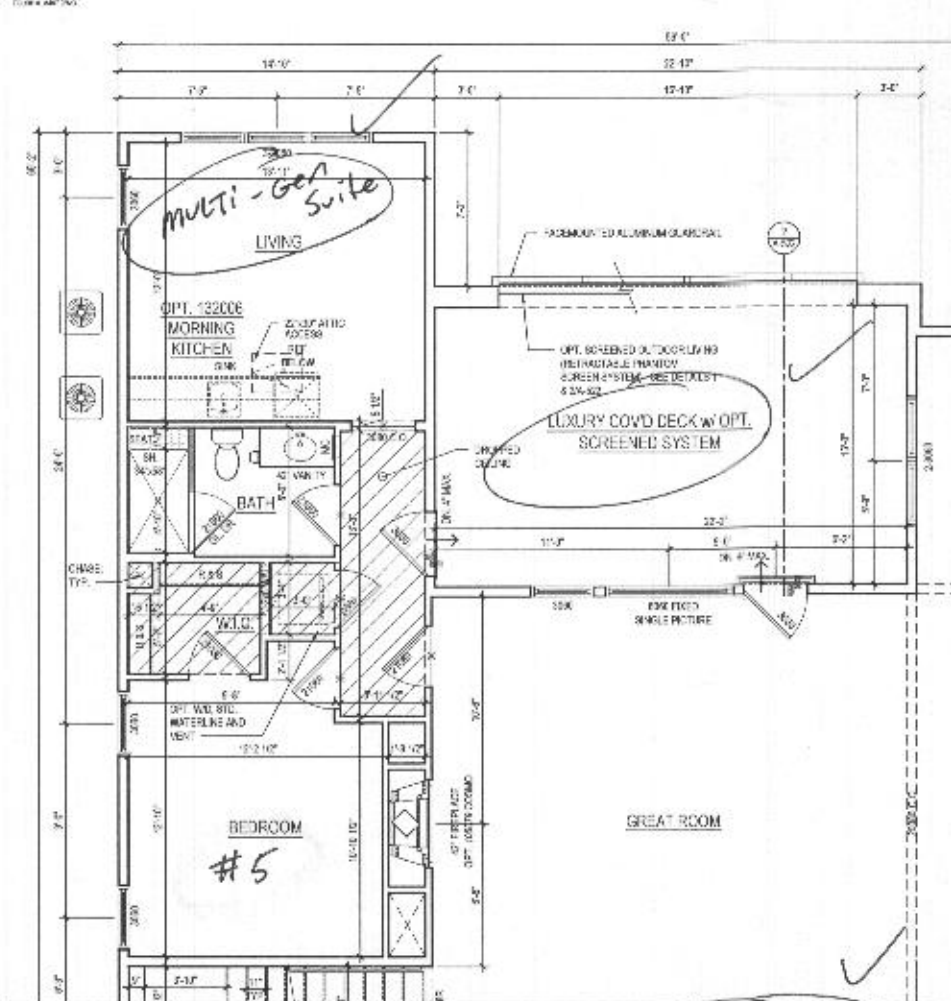

2 PART. FIRST FLOOR PLAN
A-407 SCALE: 1/4"=1'-0"

W/ OPT. 263073 MULTI-GEN. SUITE
W/ COVD OUTDOOR LIVING & WALKOUT DECK

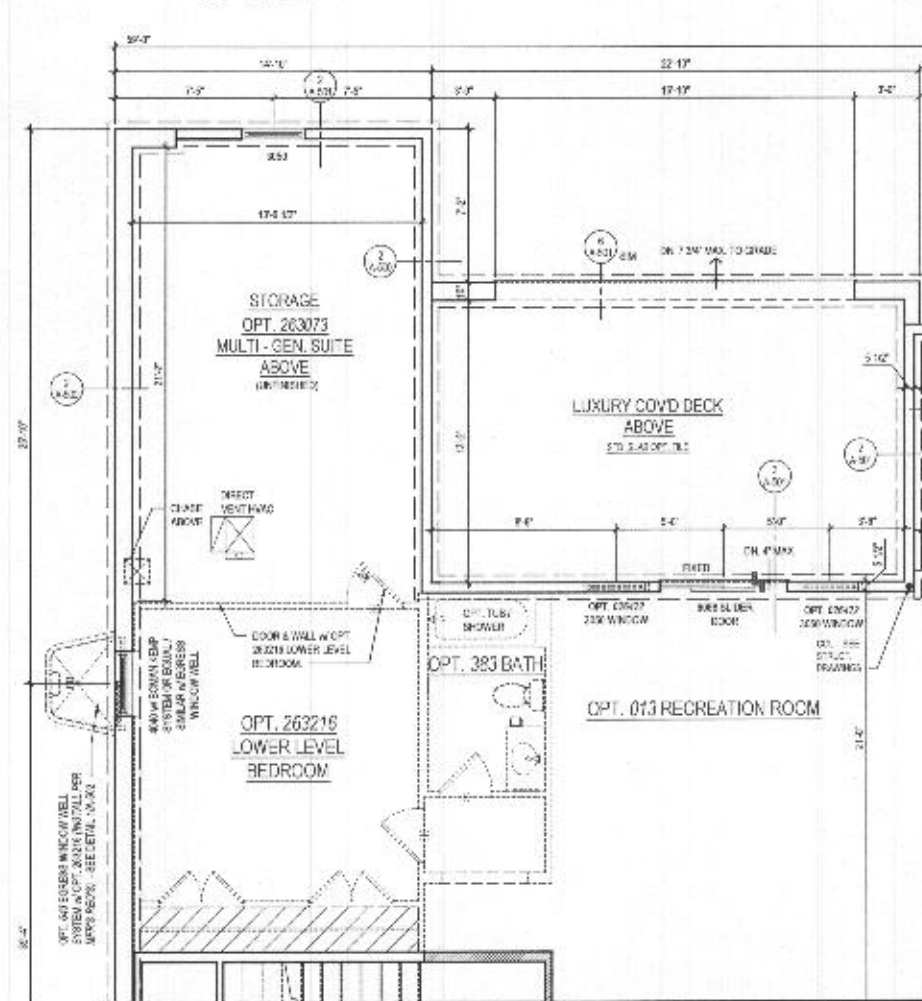

1 PART. BASEMENT PLAN
A-407 SCALE: 1/4"=1'-0"

W/ OPT. 263073 MULTI-GEN. SUITE
W/ COVD OUTDOOR LIVING & WALKOUT DECK

lessard
DESIGN

8531 Lessard Pike
Suite 200 | Vienna, VA 22182
P: 571.830.1800 | F: 571.830.1801
www.lessarddesign.com

SEA. & SIGNATURE:

TOLL BROTHERS

19775 BELMONT EXECUTIVE PLAZA
FARMERSBURG, VA 22047
P: 571.251.0000
CONTACT: CHRISTINA LEHLEY
clehley@tollbrothers.com

MARYLAND

PARKHURST
OPTIONS

PROJECT NAME: PARKHURST
SHEET TITLE: OPTIONS

NO.	DESCRIPTION	DATE
1	PRELIMINARY	08.26.19
2	PERMIT SET	08.26.19
3	FOR NEW STANDARDS	08.26.19
4	FOR #220248	07.11.20

PROJECT NO: 1901
DRAWN BY: JKL
CHECKED BY: JKL
DATE: 08.26.19
FILE NAME: TOLC001A_A-407.dwg

A-407