**Bureau of Environmental Health**

8930 Stanford Boulevard, Columbia, MD 21045

Main: 410-313-2640 | Fax: 410-313-2648

TDD 410-313-2323 | Toll Free 1-866-313-6300

[www.hchealth.org](http://www.hchealth.org)Facebook: [www.facebook.com/hocohealth](https://www.facebook.com/hocohealth)

Maura J. Rossman, M.D., Health Officer

RECEIPT DATE: 1/21/22**ONSITE SEWAGE DISPOSAL SYSTEM**P 570919APPROVAL DATE: 01/26/2022 **PERMIT:****Minor Repair**

A \_\_\_\_\_

PROPERTY ADDRESS: 3638 Sharp RoadSUBDIVISION: Justice TractLOT: 1F TAX ID: \_\_\_\_\_CONTRACTOR: Fogles Septic Clean Inc.EMAIL: [kim@foglesinc.com](mailto:kim@foglesinc.com)CONTRACTOR ADDRESS: 580 Obrecht Road, Sykesville, MD 21784PHONE: 410-795-5670PROPERTY OWNER: Andrea Murphy

EMAIL: \_\_\_\_\_

OWNER ADDRESS: 3638 Sharp Road, Glenwood, MD 21738

PHONE: \_\_\_\_\_

SEPTIC TANK SIZE (GALLONS): EXISTING PUMP CHAMBER CAPACITY (GALLONS): \_\_\_\_\_PUMP SIZE: ✓

NUMBER OF BEDROOMS: \_\_\_\_\_ HOUSE SQ. FT. \_\_\_\_\_

APPLICATION RATE: \_\_\_\_\_


DISTRIBUTION SYSTEM: GRAVITY FED ☒LOW PRESSURE DOSED ☐

TRENCHES:	LINEAR FEET REQUIRED: <u>EXISTING</u>	INLET DEPTH: _____
	TRENCH WIDTH: _____	MAXIMUM BOTTOM DEPTH: _____
	MINIMUM SPACE BETWEEN TRENCHES: _____	EFFECTIVE AREA BEGINNING DEPTH: _____
LOCATION:	TO BE STAKED BY SANITARIAN DURING PRE-CONSTRUCTION INSPECTION.	
NOTES:		

ISSUED BY: \_\_\_\_\_ ISSUE DATE: \_\_\_\_\_ EXPIRATION DATE: \_\_\_\_\_

**NOTE: CONTRACTOR MUST SCHEDULE A PRE-CONSTRUCTION INSPECTION PRIOR TO BEGINNING ANY INSTALLATION****NOTE: CONTRACTOR MUST SCHEDULE AN INSPECTION AND GAIN APPROVAL OF ALL COMPONENTS PRIOR TO COVERING****NOTE: STONE MUST BE APPROVED BY HEALTH DEPARTMENT AND GRAVEL TICKET MUST BE AVAILABLE FOR REVIEW.****NOTE: WATERTIGHT SEPTIC TANKS REQUIRED****NOTE: ALL PARTS OF SEPTIC SYSTEM SHALL BE AT LEAST 100 FEET DOWNGRADIENT FROM ANY WATER WELL****NOTE: MANHOLE RISERS REQUIRED ON ALL SEPTIC TANKS AND PUMP CHAMBERS****NOTE: AN ELECTRICAL PERMIT IS REQUIRED FOR INSTALLATION OF ANY ELECTRICAL COMPONENTS OF THE SYSTEM**☐ ELECTRICAL PERMIT ISSUED E \_\_\_\_\_**NOTE: THE HCHD DOES NOT WARRANTY ANY SYSTEM AND CANNOT GUARANTEE THE PERFORMANCE OF THIS SYSTEM AS DESIGNED. BY ACCEPTING THIS PERMIT, THE OWNER AND/OR APPLICANT ACKNOWLEDGE THAT THE SPECIFICATIONS DETAILED IN THIS DESIGN ARE ONE POSSIBLE OPTION AND THAT THE HCHD WILL REVIEW OTHER PROPOSALS. YOU HAVE THE OPTION TO SEEK THE ADVICE OF A QUALIFIED DESIGN CONSULTANT OR PROFESSIONAL ENGINEER FOR FURTHER GUIDANCE.****NOTE: MDE RECOMMENDS SEPTIC TANKS, BAT, AND OTHER PRETREATMENT UNITS BE PUMPED AT A FREQUENCY ADEQUATE TO ENSURE THAT SOLIDS ARE NOT DISCHARGED TO THE DISPOSAL AREA****NEITHER THE HOWARD COUNTY COUNCIL NOR THE HEALTH DEPARTMENT IS RESPONSIBLE FOR THE SUCCESSFUL OPERATION OF ANY SYSTEM.****PERMITTEE RESPONSIBLE FOR OBTAINING FINAL APPROVAL ON THIS PERMIT.****CALL 410-313-1771 TO SCHEDULE INSPECTIONS.**

NOT TO SCALE

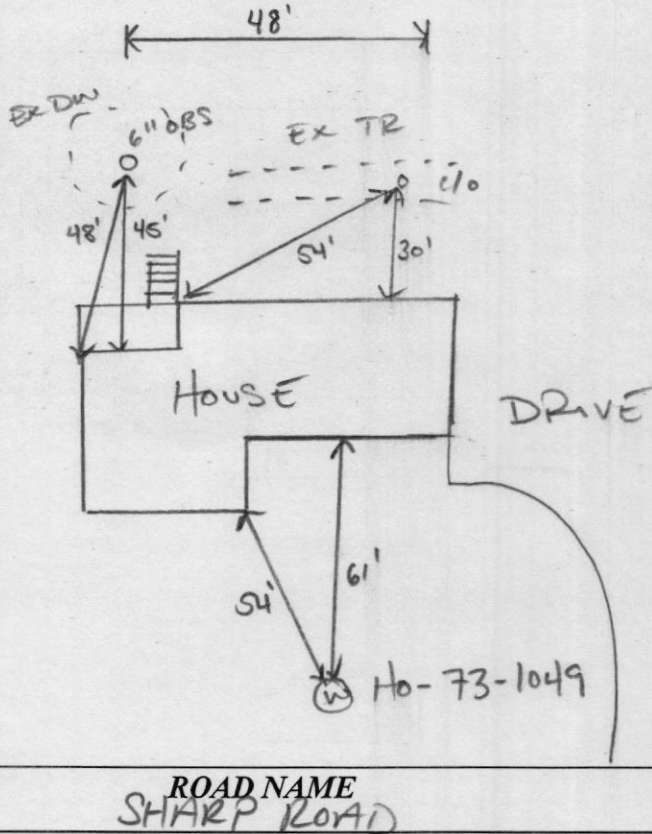

**TRENCH/DRAINFIELD DATA**

WIDTH INLET BOTTOM

EXISTING

NUMBER OF TRENCHES \_\_\_\_\_

TOTAL LENGTH \_\_\_\_\_

ABSORPTION AREA \_\_\_\_\_

DISTRIBUTION BOX LEVEL \_\_\_\_\_

DISTRIBUTION BOX BAFFLE \_\_\_\_\_

DISTRIBUTION BOX PORT \_\_\_\_\_

**SEPTIC TANK DATA**

SEPTIC TANK 1 LEVEL \_\_\_\_\_

MANUFACTURER \_\_\_\_\_

CAPACITY \_\_\_\_\_ GAL

SEAM LOC \_\_\_\_\_

TANK LID DEPTH \_\_\_\_\_

BAFFLES \_\_\_\_\_

BAFFLE FILTER \_\_\_\_\_

MANHOLE LOC \_\_\_\_\_

6" PORT LOC \_\_\_\_\_

WATERTIGHT TEST \_\_\_\_\_

SLOTTED \_\_\_\_\_

DATE ON LID \_\_\_\_\_

PUMP/SEPTIC TANK LEVEL \_\_\_\_\_

MANUFACTURER \_\_\_\_\_

CAPACITY \_\_\_\_\_ GAL

SEAM LOC \_\_\_\_\_

TANK LID DEPTH \_\_\_\_\_

BAFFLES \_\_\_\_\_

BAFFLE FILTER \_\_\_\_\_

MANHOLE LOC \_\_\_\_\_

6" PORT LOC \_\_\_\_\_

WATERTIGHT TEST \_\_\_\_\_

SLOTTED \_\_\_\_\_

DATE ON LID \_\_\_\_\_

PRE-CONSTRUCTION:

INSTALLATION: 01/26/2022 C/O ADDED TO EX TR; EX DW EXPOSED, ROOT BLOCKAGE REMOVED, SECTION OF ORANGEBOURG PERFORATED PIPE REPLACED W/ SCH 40 PERF. PVC. 6" OBS ADDED TO EX DW

FINAL INSPECTOR

*[Signature]*

DATE OF APPROVAL

01/26/2027



**FOGLE'S SEPTIC CLEAN, INC.**  
580 Obrecht Road • Sykesville • Maryland 21784  
(410) 795-5670



# SEPTIC EVALUATION

<input checked="" type="checkbox"/> Buyer / <input type="checkbox"/> Seller	Date: 11/11/21	Time: 12:30pm	Occupied? <input checked="" type="checkbox"/> Yes / <input type="checkbox"/> No
Client: Andrea Murphy	Ordered By:	If vacant, how long?	
Property Address:	Phone: 240-462-8234	Last pumped: ?	
3638 Sharp Rd	email: Hemurphy530@gmail.com	Property age: 1976	# Bedrooms: 4
Glenwood, MD	Weather: 10m	County Records: <input type="checkbox"/> Requested <input checked="" type="checkbox"/> Not Received	
	Ground Conditions:	Confirmed: <input checked="" type="checkbox"/> Yes <input type="checkbox"/> Left Message	

Liquid level: <input type="checkbox"/> Above Normal / <input checked="" type="checkbox"/> Normal / <input type="checkbox"/> Below normal	Depth of tank: 3'
Maintenance Appears: <input type="checkbox"/> Good / <input checked="" type="checkbox"/> Fair / <input type="checkbox"/> Poor	Access to tank: mH
Effluent Filter present? <input type="checkbox"/> Yes / <input checked="" type="checkbox"/> No	Pump system: <input type="checkbox"/> Yes / <input checked="" type="checkbox"/> No

Type of Tank	Tank Composition & Size	Type of Absorption System
<input checked="" type="checkbox"/> Septic Tank (1 tank)	<input type="checkbox"/> Metal <input checked="" type="checkbox"/> Concrete <input type="checkbox"/> Unknown	<input checked="" type="checkbox"/> Drainfield
<input type="checkbox"/> Cesspool	Tank Size: 1000g	<input checked="" type="checkbox"/> Drywell
<input type="checkbox"/> Aeration System	Baffles intact? <input checked="" type="checkbox"/> Yes / <input type="checkbox"/> No Terra Catia	<input type="checkbox"/> Sandmound
<input type="checkbox"/> Other:		<input type="checkbox"/> Other:

Inspected System Appears:	Inspector's Comments	Sketch of System
<input type="checkbox"/> Functional <input type="checkbox"/> Marginal <input checked="" type="checkbox"/> Unsatisfactory	Septic tank is relatively clean. Drywell is over full. There appears to be a drainfield w/ dry clean stone. We recommend contacting ACHD to determine replacing pipe to field or bypassing drywell for future use. Approx cost \$1000-\$3000.	
Inspector:		
Signature: K. Bassell		
Inspection Fee: 300		
Locate/Hand Digging Fee:		
Water Test: <input checked="" type="checkbox"/> U&O <input type="checkbox"/> Lead <input type="checkbox"/> Nitrite		
Water Test Other: 200		
Amount Due:		
Check #		

single poly

## IMPORTANT:

- This is a subjective and visual inspection only, based upon many unknown and unseen factors.
- The condition of the Sewage Disposal system is reported as of the above date.
- This report does not WARRANT nor GUARANTEE continued functional Sewage Disposal System operations.
- If house has been unoccupied, this report may not be accurate. Little or no use of the septic system could have allowed the problems to temporarily clear themselves.
- If a larger family is moving in than is presently occupying the house, the septic system may be subject to failure.
- If the general ground condition is wet, this report may not be accurate, as ground moisture may cover or hide actual septic effluent on the surface.
- In the above cases, it is strongly suggested that the septic system be re-certified in 3 to 6 months.
- If the system is rated below as marginal or unsatisfactory, it is suggested that the local health department be contacted to inspect and confirm the findings.

**Payment for this inspection signifies understanding and acceptance of above clauses.**



# HOWARD COUNTY HEALTH DEPARTMENT

70919

DATE  
1/24/22

Received  
From

Fogles Sophie

PHONE #

410-795-5670

For

Minor Repair / 3638  
Sharp

☐ CASH

☒ CHECK

NO.

4570

Dollars

\$

55.00

Received By

J King