

Menu Refine Search GIS Help My Filters --Select-- ▼ Modul

Showing 1 of 1

☐ <u>Permit #</u>	<u>Status</u>	<u>Record Type Alias</u>	<u>Street #</u>	<u>Street Name</u>	<u>Type</u>	<u>Unit Type</u>	<u>Unit #</u>	<u>City</u>
☐ <u>B22002525</u>	Review In Process	Residential Pavilion Permit	15263	RIDGE HUNT	DR			WOODB

Page 1 of 1




Approved Septic System Plan
Howard County Health Department
DBernard 7-18-22
Signature Date

2) SUBJECT PROPERTY IS SHOWN IN ZONE C ON THE NATIONAL FLOOD INSURANCE PROGRAM FLOOD INSURANCE RATE MAP OF HOWARD COUNTY, MARYLAND, COMMUNITY PANEL No. 2400440008 B, EFFECTIVE DATE: DEC. 3, 1986.
 3) THE OFFSETS FROM BUILDING LINE TO PROPERTY LINE AS SHOWN ON THE PLAT HEREON ARE TO AN ACCURACY OF 1' PLUS OR MINUS (±).

PROPERTY ADDRESS:
 15263 RIDGE HUNT DRIVE
 WOODBINE, MD 21797

JUNE 23, 2022

RIDGE HUNT DRIVE

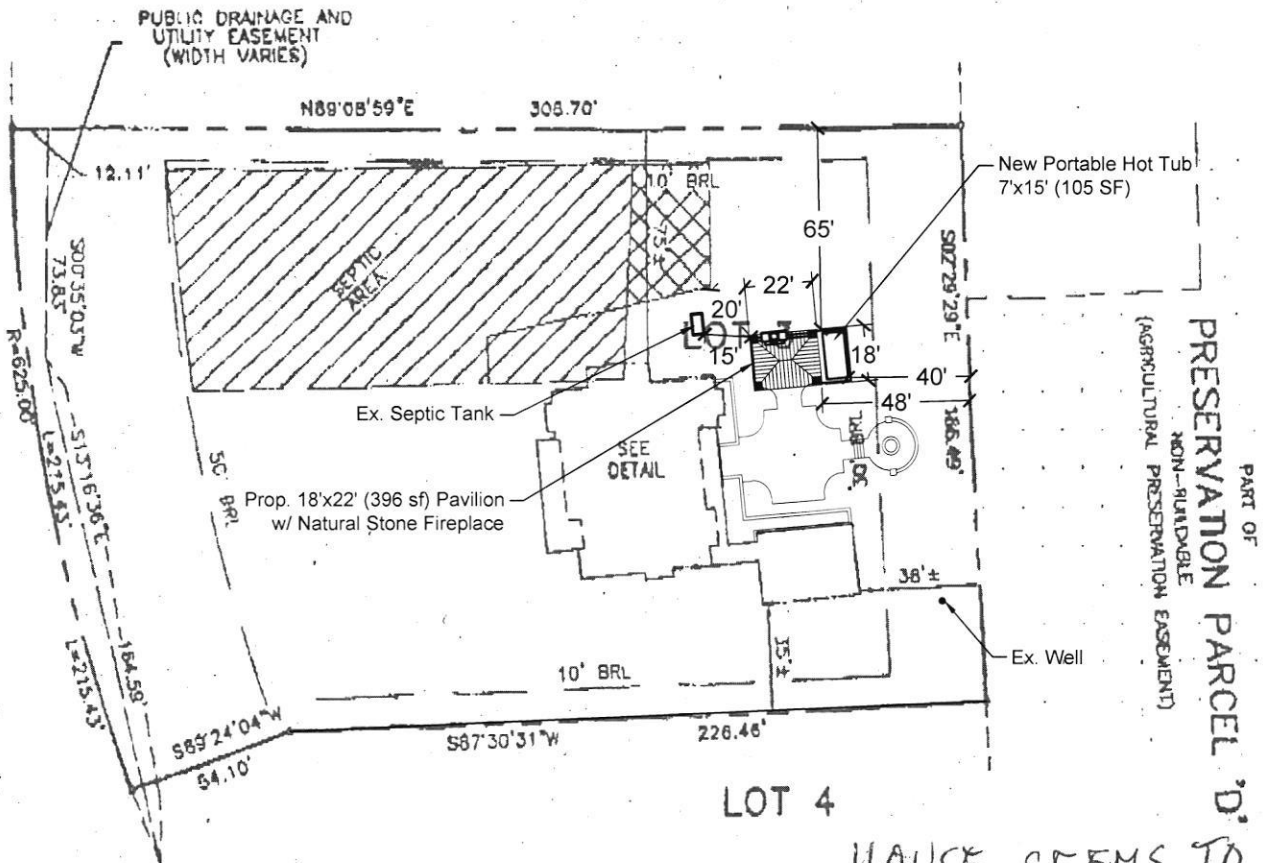

HOUSE SEEMS TO HAVE MOVED ~3' TOWARD SEPTIC AREA; SPECS ADJUSTED - OK


MP2

1-60

PRIVATE SEWAGE DISPOSAL AREA AS PER PLAT #13008

REVISED SEWAGE DISPOSAL AREA AS PER HOWARD COUNTY HEALTH DEPARTMENT

— BUILDING RESTRICTION LINE
 — FOUNDATION ELEV. -590.3'±

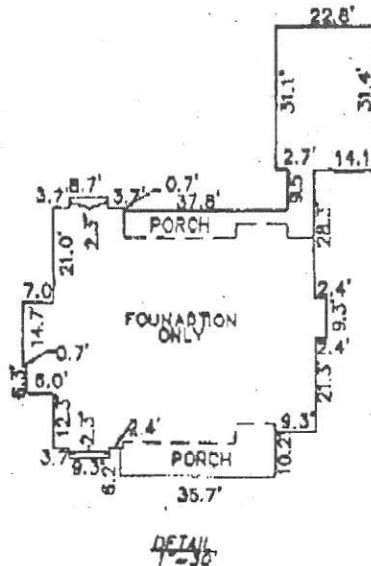

LOT 3
 RIDGE VIEW HUNT
 LOTS 1-28 AND PRESERVATION
 PARCELS A THRU F
 4TH ELECTION DISTRICT
 HOWARD COUNTY, MARYLAND
 PLAT REF. 13011