

**COMPLETE THIS FORM WHEN DROPPING OFF ANY
CORRESPONDENCE AND/OR PLANS TO THE HOWARD COUNTY
DEPARTMENT OF INSPECTIONS, LICENSES AND PERMITS COUNTER:**

Date: 4/21/2022

To: ~~Do Summer~~ Health
(Person's Name and Division)

From: CHIDI UGBAM (301) 404-6872
(Your Name, Company Name and Telephone Number)

Subject: Project name _____
Project site address 6126 Thompson dr. Clarksville MD 21029
Permit # B22001459 SDP # _____
Other information pertinent to this project _____

☒ Please check the attachments below that you are submitting with this transmittal:

☐ Letter of response to address plan review comment letter

☒ Revised plans and/or revised details: When submitting for a complete re-review, **duplicate sets shall be submitted.**

☐ Letter Summarizing Changes

☐ Energy conservation calculations

☐ Copies of _____ (be specific). Needs site visit
No well record. 8/8 5/3/22

☐ _____ Health Department Request ☐ _____ DPZ/ DED Request ☐ _____ Applicant's Request

☐ Two sets of single family dwelling model plans to be placed on permanent file: Model name and/or # _____

☒ Other Plot

Contact Person Information: (Required)

Please Print Name

Telephone No:

E-Mail Address:

PLEASE ASSURE ALL DOCUMENTS AND/OR REVISIONS ARE APPROPRIATELY SIGNED AND SEALED, IF NECESSARY, BY A LICENSED ARCHITECT OR ENGINEER. PLEASE BE ADVISED THAT INSUFFICIENT INFORMATION MAY RESULT IN THE DELAY OF REVIEW BY THE PLANS EXAMINER. THE DEPARTMENT OF INSPECTIONS, LICENSES AND PERMITS WILL CONTACT YOU IF THERE IS A PROBLEM. IN ADDITION, ONCE THE BUILDING PERMIT IS APPROVED BY THE PLAN REVIEW DIVISION AND ALL OTHER REQUIRED SIGNATORY AGENCIES, AND THE BUILDING PERMIT IS READY FOR ISSUANCE, THE PERMIT DIVISION WILL NOTIFY THE APPROPRIATE CONTACT PERSON FOR PERMIT PICK UP. ALL PERMIT STATUS INQUIRIES SHALL BE DIRECTED TO THE PERMIT DIVISION AT 410-313-2455. CODE RELATED QUESTIONS AND PLAN REVIEW INQUIRIES SHALL BE DIRECTED TO THE PLAN REVIEW DIVISION AT 410-313-2436. PLEASE ALLOW A MINIMUM OF FIVE (5) WORKING DAYS FOR ANY PLAN SUBMITTALS TO BE REVIEWED. THANK YOU.

Received by Myf

Revision
CC zoning
Health

OK for approval.
8/8 7/18/22

REVISED

Date: 4-21-22

Comments: _____

SAE
TITLE GROUP

PREPARED FOR:

This is page one of a two page document. The advice found on the affixed page is an integral part of this drawing, and is not valid without all pages.

The purpose of this drawing is to locate, describe, and represent the positions of buildings and substantial improvements affecting the property shown hereon, being known as:
Lot 13, Block C, on a plat entitled,
"Heritage Heights, Section 1"
recorded among the land records of Howard County, Maryland in Plat Book 4, folio 14


NOTE: 1) THE FENCE APPEARS TO LIE AT, NEAR, OR OVER THE PROPERTY LINE.
2) THE CONCRETE PATIO APPEARS TO LIE AT, NEAR, OR OVER THE PROPERTY LINE.



NTT Associates, Inc.
16205 Old Frederick Rd.
Mt. Airy, Maryland 21771
Phone: (410) 442-2031
Fax: (410) 442-1315
www.nttsurveyors.com

Scale: 1" = 30'
Date: 10/21/2021
Field By: DRA
Drawn By: DRA
File No.: 338718H0CS
Page No.: 1 of 2

LOCATION DRAWING
6126 THOMPSON DRIVE
5th ELECTION DISTRICT
HOWARD COUNTY, MARYLAND

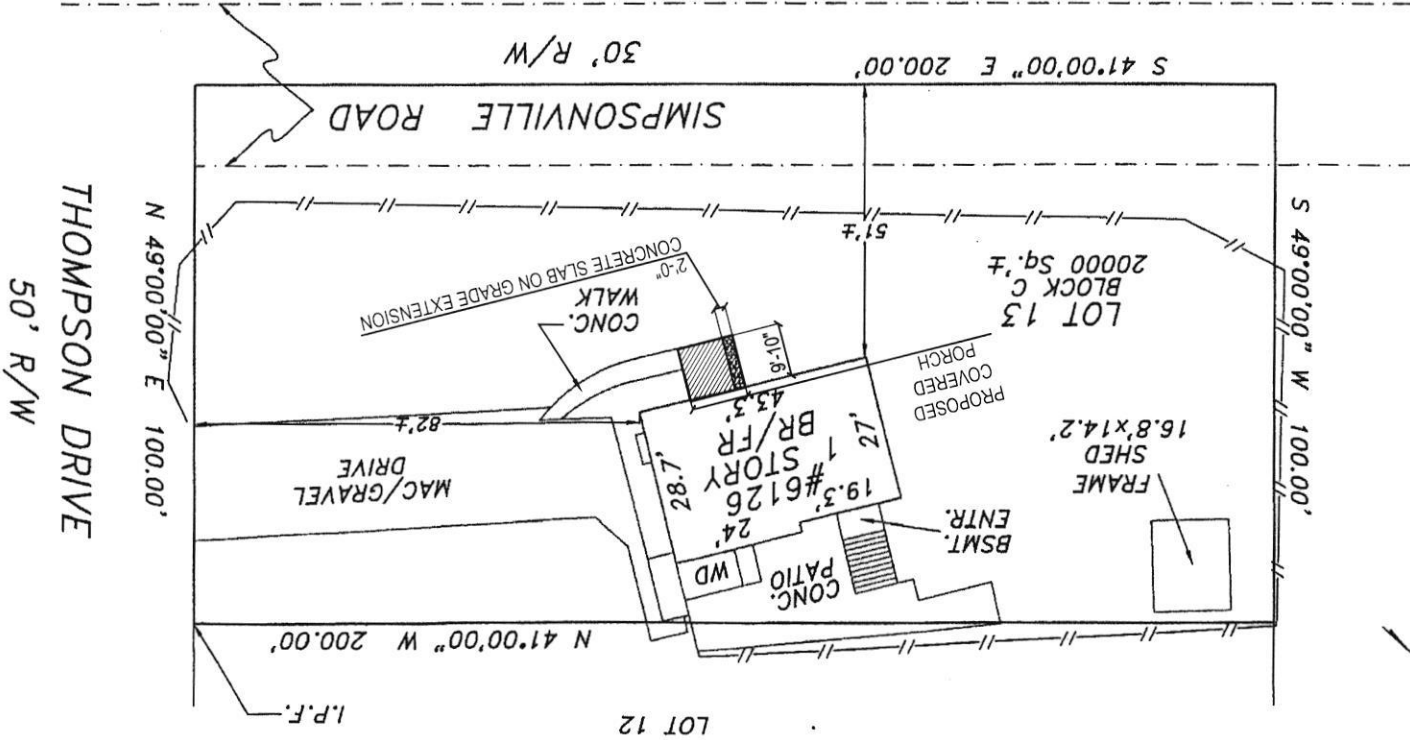

REVISED

Date: 4-21-22

Comments: _____

SAE
TITLE GROUP

PREPARED FOR:

This is page one of a two page document. The advice found on the affixed page is an integral part of this drawing, and is not valid without all pages.

The purpose of this drawing is to locate, describe, and represent the positions of buildings and substantial improvements affecting the property shown hereon, being known as:
Lot 13, Block C, on a plat entitled,
"Heritage Heights, Section 1"
recorded among the land records of Howard County, Maryland in Plat Book 4, folio 14


NOTE: 1) THE FENCE APPEARS TO LIE AT, NEAR, OR OVER THE PROPERTY LINE.
2) THE CONCRETE PATIO APPEARS TO LIE AT, NEAR, OR OVER THE PROPERTY LINE.



NTT Associates, Inc.
16205 Old Frederick Rd.
Mt. Airy, Maryland 21771
Phone: (410) 442-2031
Fax: (410) 442-1315
www.nttsurveyors.com

Scale: 1" = 30'
Date: 10/21/2021
Field By: DRA
Drawn By: DRA
File No.: 338718H0CS
Page No.: 1 of 2

LOCATION DRAWING
6126 THOMPSON DRIVE
5TH ELECTION DISTRICT
HOWARD COUNTY, MARYLAND

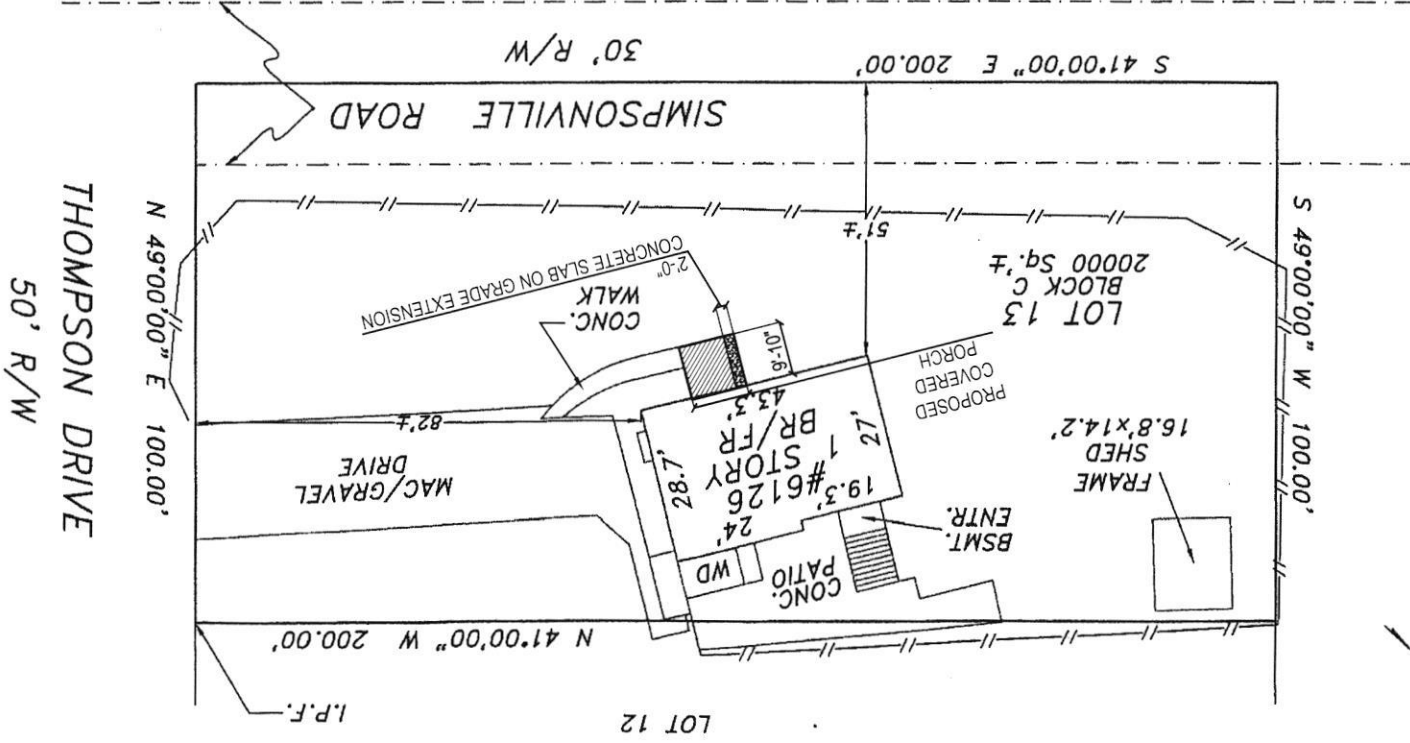


SITE INSPECTION SHEET

OWNER: Shade Anifowashe PHONE #: ?
ADDRESS: 6126 Thompson Dr. CONTRACTOR: Custom Carpentry Construction - 202-679-0260
Clarksville, MD 21029 WELL TAG #: N/A
SUBDIVISION: Heritage Heights LOT: 13 COUNTY #: 05363721
PROPOSAL: Residential Interior Alteration SFD - reconfigure main level to create master suite, remove bedroom, add stairs to basement, finish basement to add lounge, study, full bath & storage room

LOCATION DIAGRAM

Associated permit B22001459

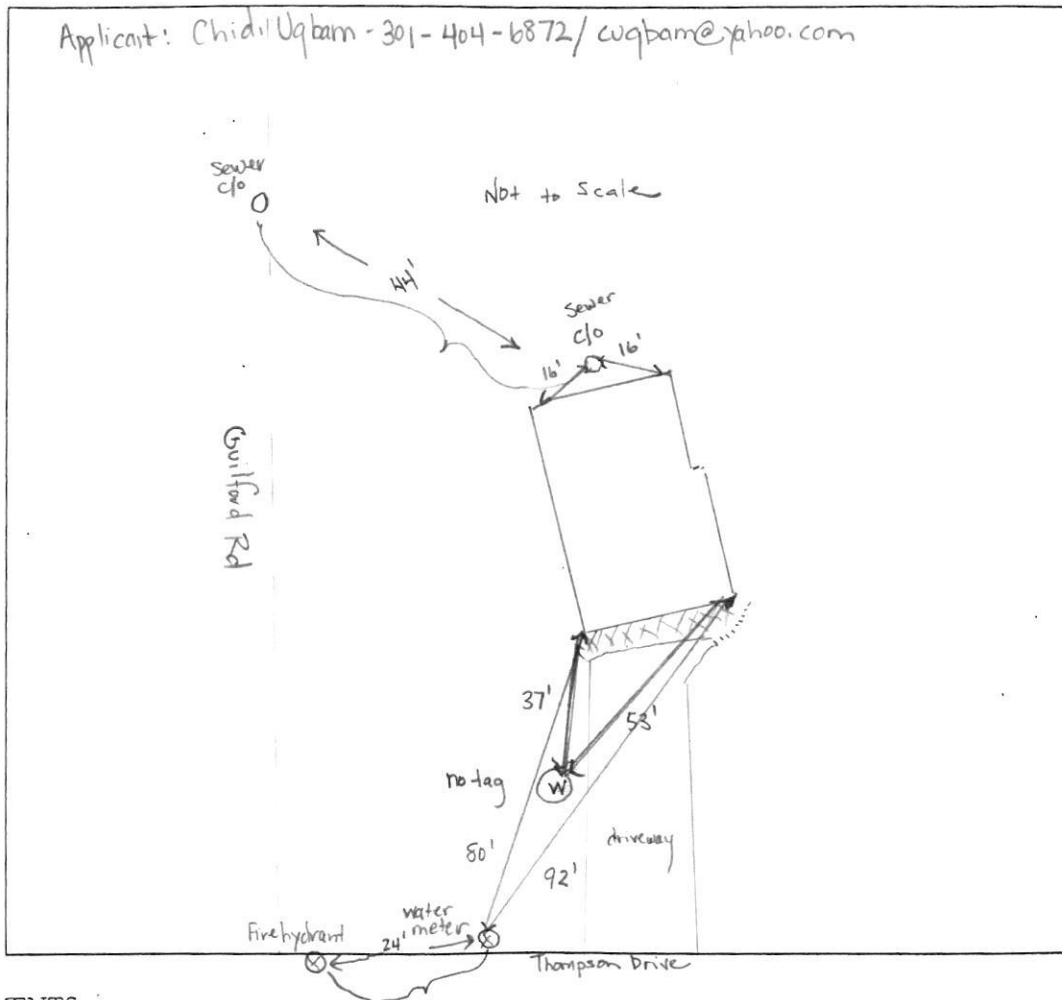


COMMENTS:

The well on the property is in poor condition, one piece cap which is loose enough to lift of casing, conduit loose, no well tag. Spoke to DPW to confirm they only pay for public sewer. No bill for water but there is public water access for this property if needed in the future. Sewer c/o's look ok.

DATE: 5/4/22

INSPECTOR: R. Rappaport

NOTE: The plan states that the cross street is Simpsonville Rd., there is no such road in HC. Cross street is Guilford Rd.

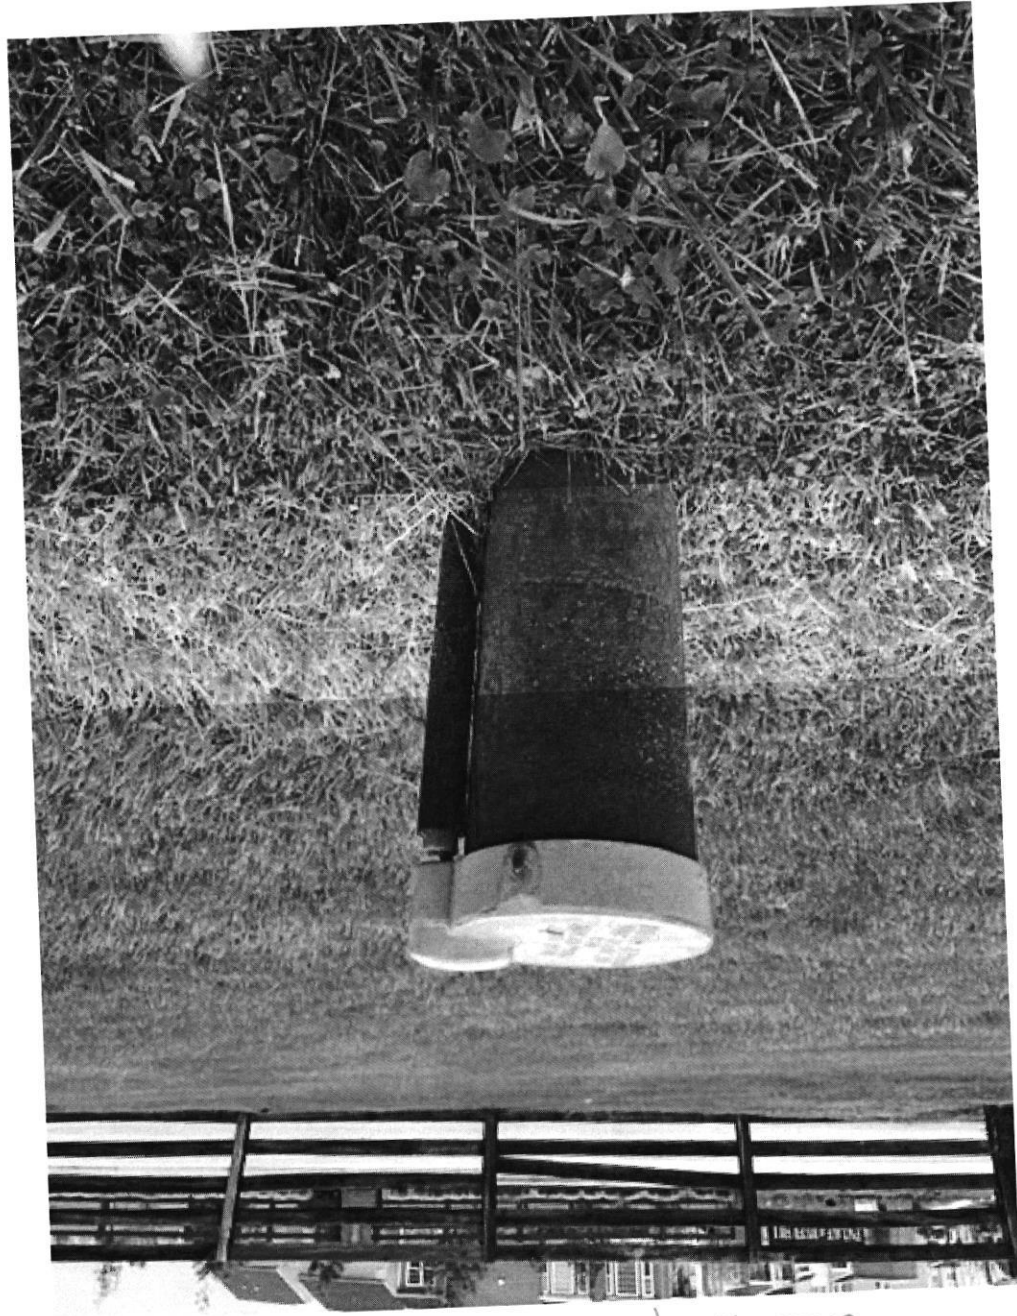

B2200 1459
6126 Thompson Dr. - well

Access to public H₂O if needed

