

**COMPLETE THIS FORM WHEN DROPPING OFF ANY  
CORRESPONDENCE AND/OR PLANS TO THE HOWARD COUNTY  
DEPARTMENT OF INSPECTIONS, LICENSES AND PERMITS COUNTER:**

Date: 10/19/2020

To: George Martin/Jeff Williams Plans Review/Health Department  
(Reviewer/Requestor's Name) (Division)

From: Ashley Schaeffer, All About Permits LLC (410) 530-8863  
(Your Name, Company Name) (Phone Number)

Subject: Project name \_\_\_\_\_  
Project site address 3435 Shady Lane  
Permit # B20003153 SDP # \_\_\_\_\_  
Other information pertinent to this project \_\_\_\_\_

☒ Please check the attachments below that you are submitting with this transmittal:

- ☐ Letter of response to address plan review comment letter
- ☒ Revised plans and/or revised details: When submitting for a complete re-review, **duplicate sets shall be submitted.**
- ☒ Letter Summarizing Changes
- ☐ Energy conservation calculations
- ☐ Copies of \_\_\_\_\_ (be specific).  
☐ Health Department Request ☐ DPZ/ DED Request ☐ Applicant's Request
- ☐ Two sets of single-family model plans to be placed on permanent file: Model Name/ # \_\_\_\_\_
- ☐ Other \_\_\_\_\_

**Contact Person Information: (Required)**

Ashley Schaeffer  
Please Print Name

Telephone No: (410) 530-8863  
E-Mail Address: allaboutpermits@hotmail.com

**PLEASE ASSURE ALL DOCUMENTS AND/OR REVISIONS ARE APPROPRIATELY SIGNED AND SEALED, IF NECESSARY, BY A LICENSED ARCHITECT OR ENGINEER. PLEASE BE ADVISED THAT INSUFFICIENT INFORMATION MAY RESULT IN THE DELAY OF REVIEW BY THE PLANS EXAMINER. THE DEPARTMENT OF INSPECTIONS, LICENSES AND PERMITS WILL CONTACT YOU IF THERE IS A PROBLEM. IN ADDITION, ONCE THE BUILDING PERMIT IS APPROVED BY THE PLAN REVIEW DIVISION AND ALL OTHER REQUIRED SIGNATORY AGENCIES, AND THE BUILDING PERMIT IS READY FOR ISSUANCE, THE PERMIT DIVISION WILL NOTIFY THE APPROPRIATE CONTACT PERSON FOR PERMIT PICK UP. ALL PERMIT STATUS INQUIRIES SHALL BE DIRECTED TO THE PERMIT DIVISION AT 410-313-2455 OPTION #4 OR BY VISITING MYHOWARD.INFO. CODE RELATED QUESTIONS AND PLAN REVIEW INQUIRIES SHALL BE DIRECTED TO THE PLAN REVIEW DIVISION AT 410-313-2436. PLEASE ALLOW A MINIMUM OF FIVE (5) WORKING DAYS FOR ANY PLAN SUBMITTALS TO BE REVIEWED. THANK YOU.**

Received by \_\_\_\_\_

*approved*  
*11/2/20*  
*JS*

October 19, 2020

TO: Department of License and Permits

From: All About Permits LLC

Re: Updated Plans per Health Dept comment



Please amend the permits to the addresses listed below:

<b>Permit#</b>	<b>Lot#</b>	<b>Address</b>	<b>Revision</b>
B20003153	Lot 6	3435 Shady Ln	Updated plans Showing Health Dept Changes

Thank you,



Ashley Schaeffer  
All About Permits LLC  
7905 Solley Road  
Glen Burnie, MD 21060  
410-733-0433  
allaboutpermits@hotmail.com

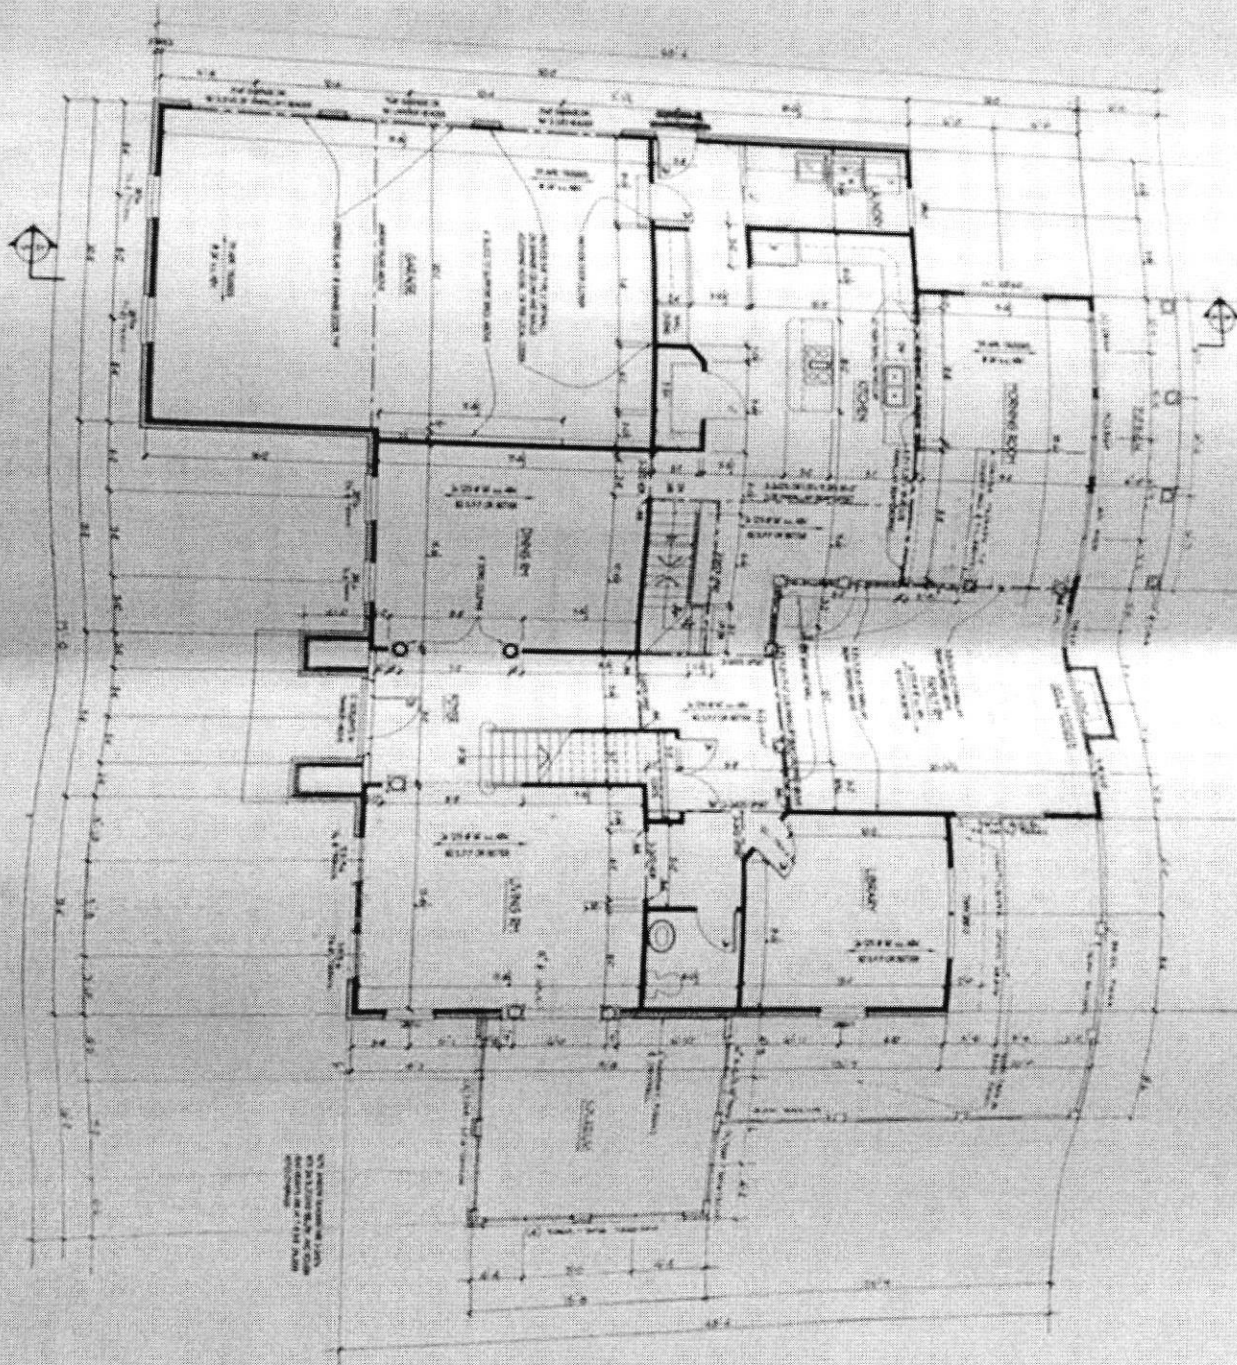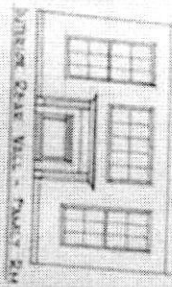

FINAL SET 7/20/03

Drawing: FIRST FLOOR PLAN

Project: JST BUILDERS  
CUSTOM HOME

Date: 12/1/03


Scale: 1/4" = 1'-0"

Drawn:

Checked:

DATE	REVISION	BY	REVISION

ROSS RESIDENCE

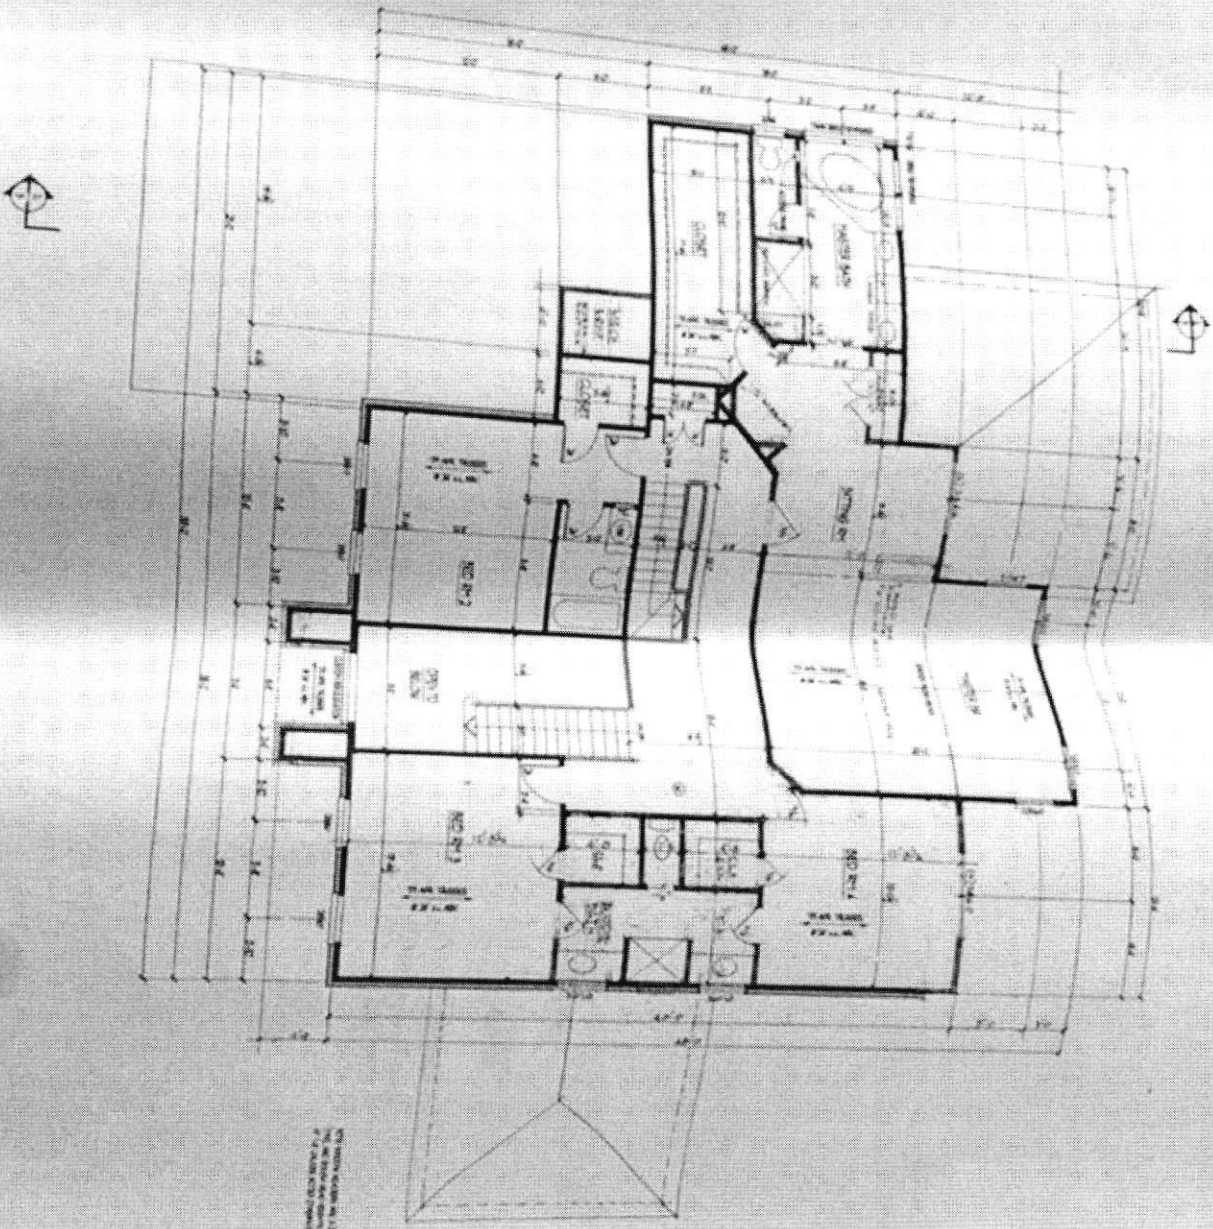

FINAL SET 12/24/03

4

PROJECT NO.

Drawing: SECOND FLOOR PLAN

Project: JST BUILDERS  
CUSTOM HOME

Date: 1/18/03

Scale: 1/4"=1'-0"


Drawn:

Checked:

DATE	REVISION	DATE	REVISION

2055 RESIDENCE

## FLOOR PLAN

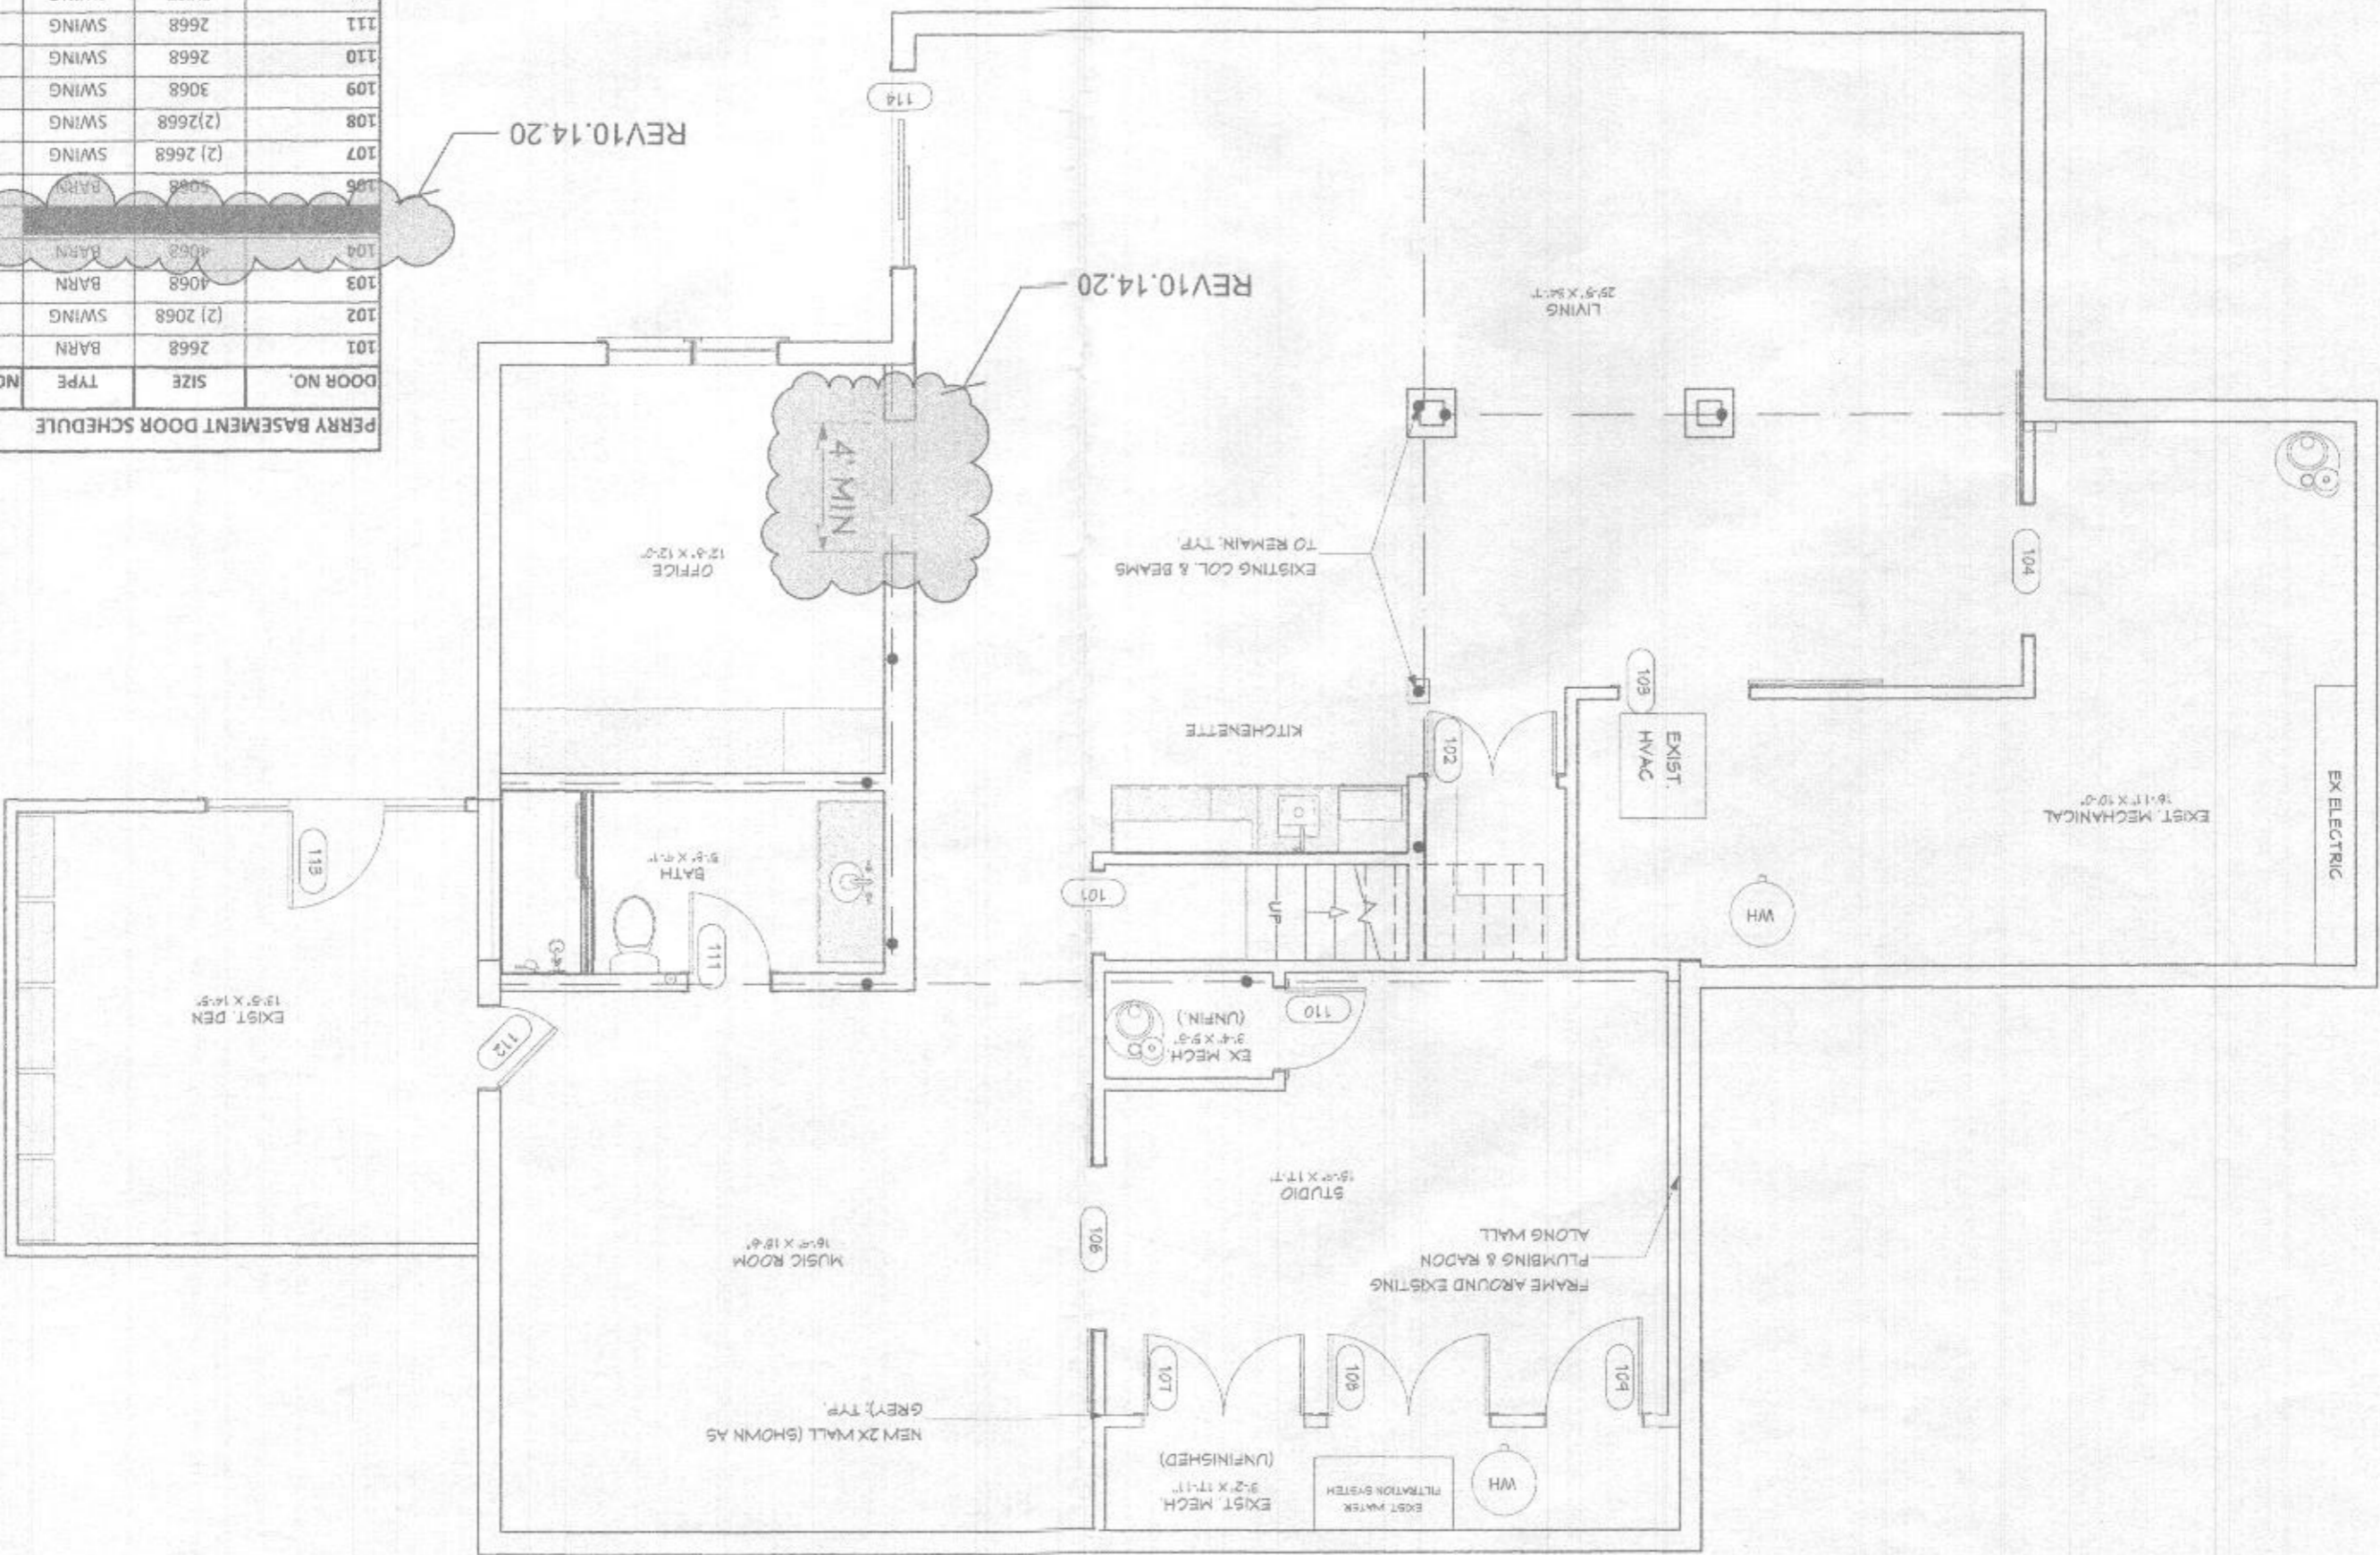

PERRY BASEMENT DOOR SCHEDULE			
DOOR NO.	SIZE	TYPE	NOTES
101	2668	BARN	
102	(2) 2068	SWING	
103	4068	BARN	
104	4068	BARN	
106	5068	BARN	
107	(2) 2668	SWING	
108	(2) 2668	SWING	
109	3068	SWING	
110	2668	SWING	
111	2668	SWING	
112	EXIST	SWING	
113	3068	SWING	EXTERIOR
114	EXIST	SLIDER	EXTERIOR

PROJECT DESCRIPTION:

Penny Permit


THIS PLANS IS THE PROPERTY OF OWINGS HOME SERVICES. ALL RIGHTS RESERVED. DUPLICATION OF THIS DRAWING IN ANY FORM IS NOT PERMITTED WITHOUT THE EXPRESSED WRITTEN CONSENT OF OWINGS HOME SERVICES.

DATE: 9/9/20

9/9/20

SCALE:

 $3/16"=1'-0"$ 

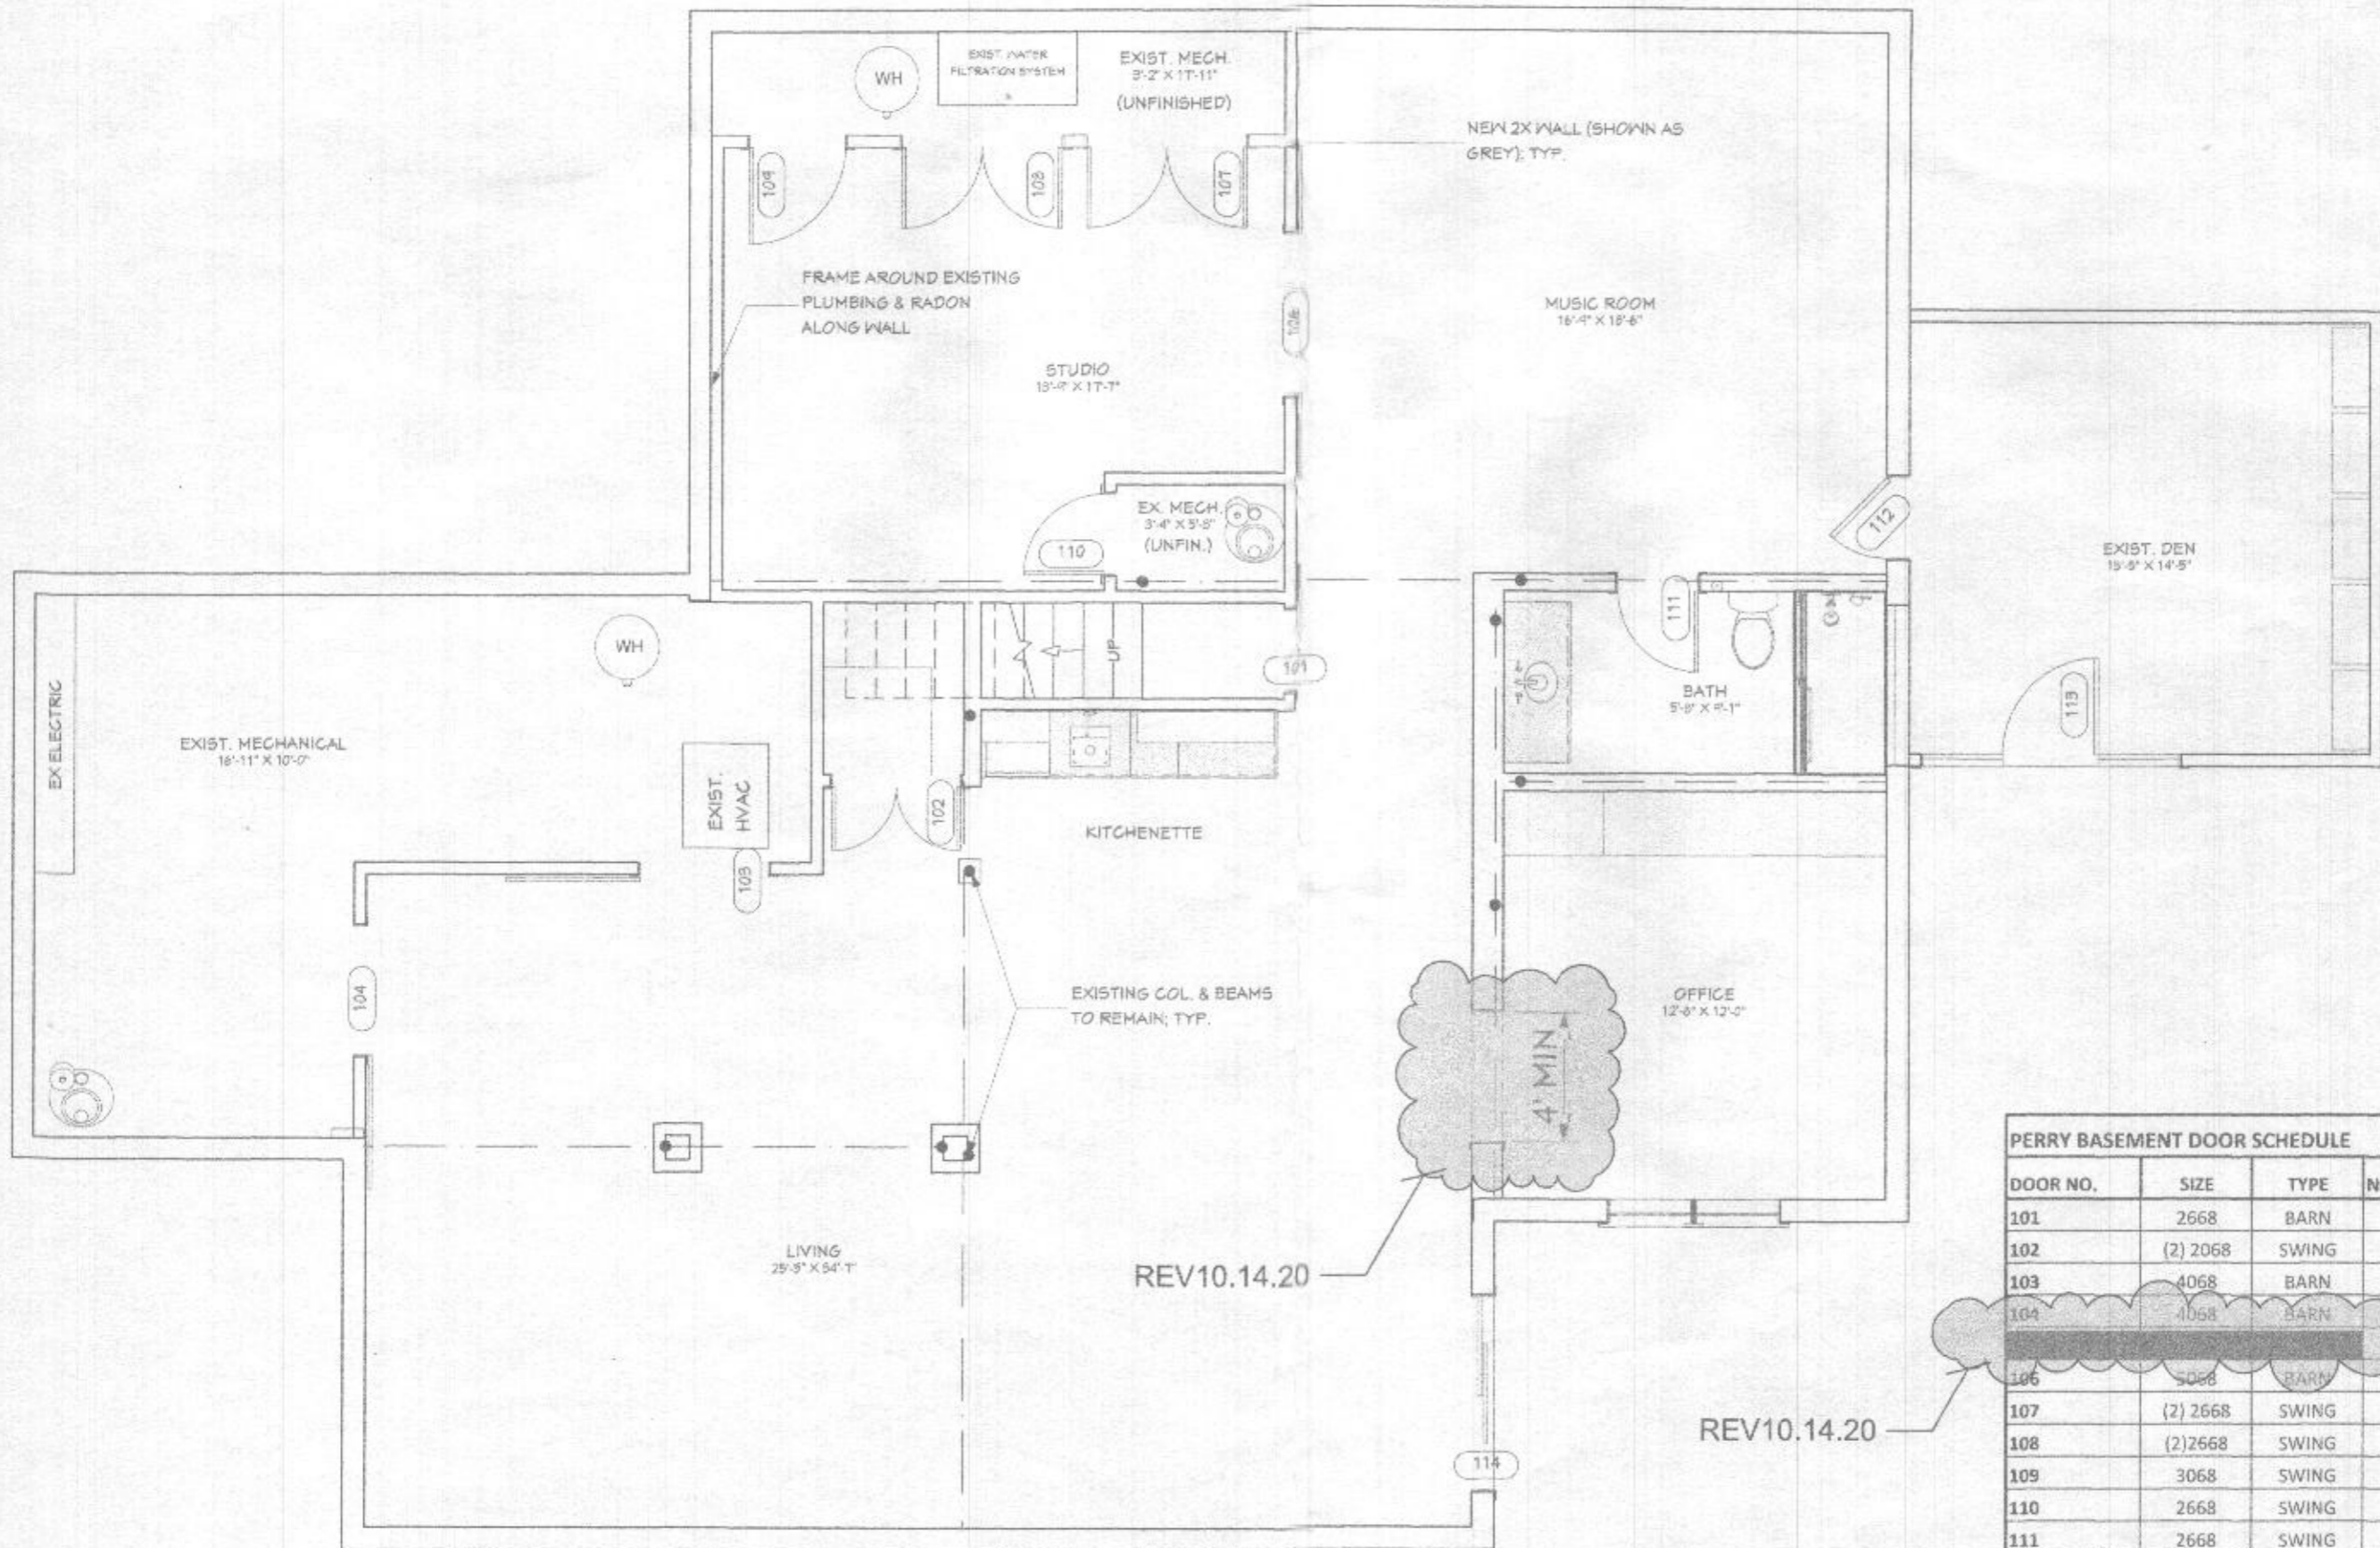


FLOOR PLAN

PERRY BASEMENT DOOR SCHEDULE			
DOOR NO.	SIZE	TYPE	NOTES
101	2668	BARN	
102	(2) 2068	SWING	
103	4068	BARN	
104	4068	BARN	
106	5068	BARN	
107	(2) 2668	SWING	
108	(2) 2668	SWING	
109	3068	SWING	
110	2668	SWING	
111	2668	SWING	
112	EXIST	SWING	
113	3068	SWING	EXTERIOR
114	EXIST	SLIDER	EXTERIOR

PROJECT DESCRIPTION

Perry Permit

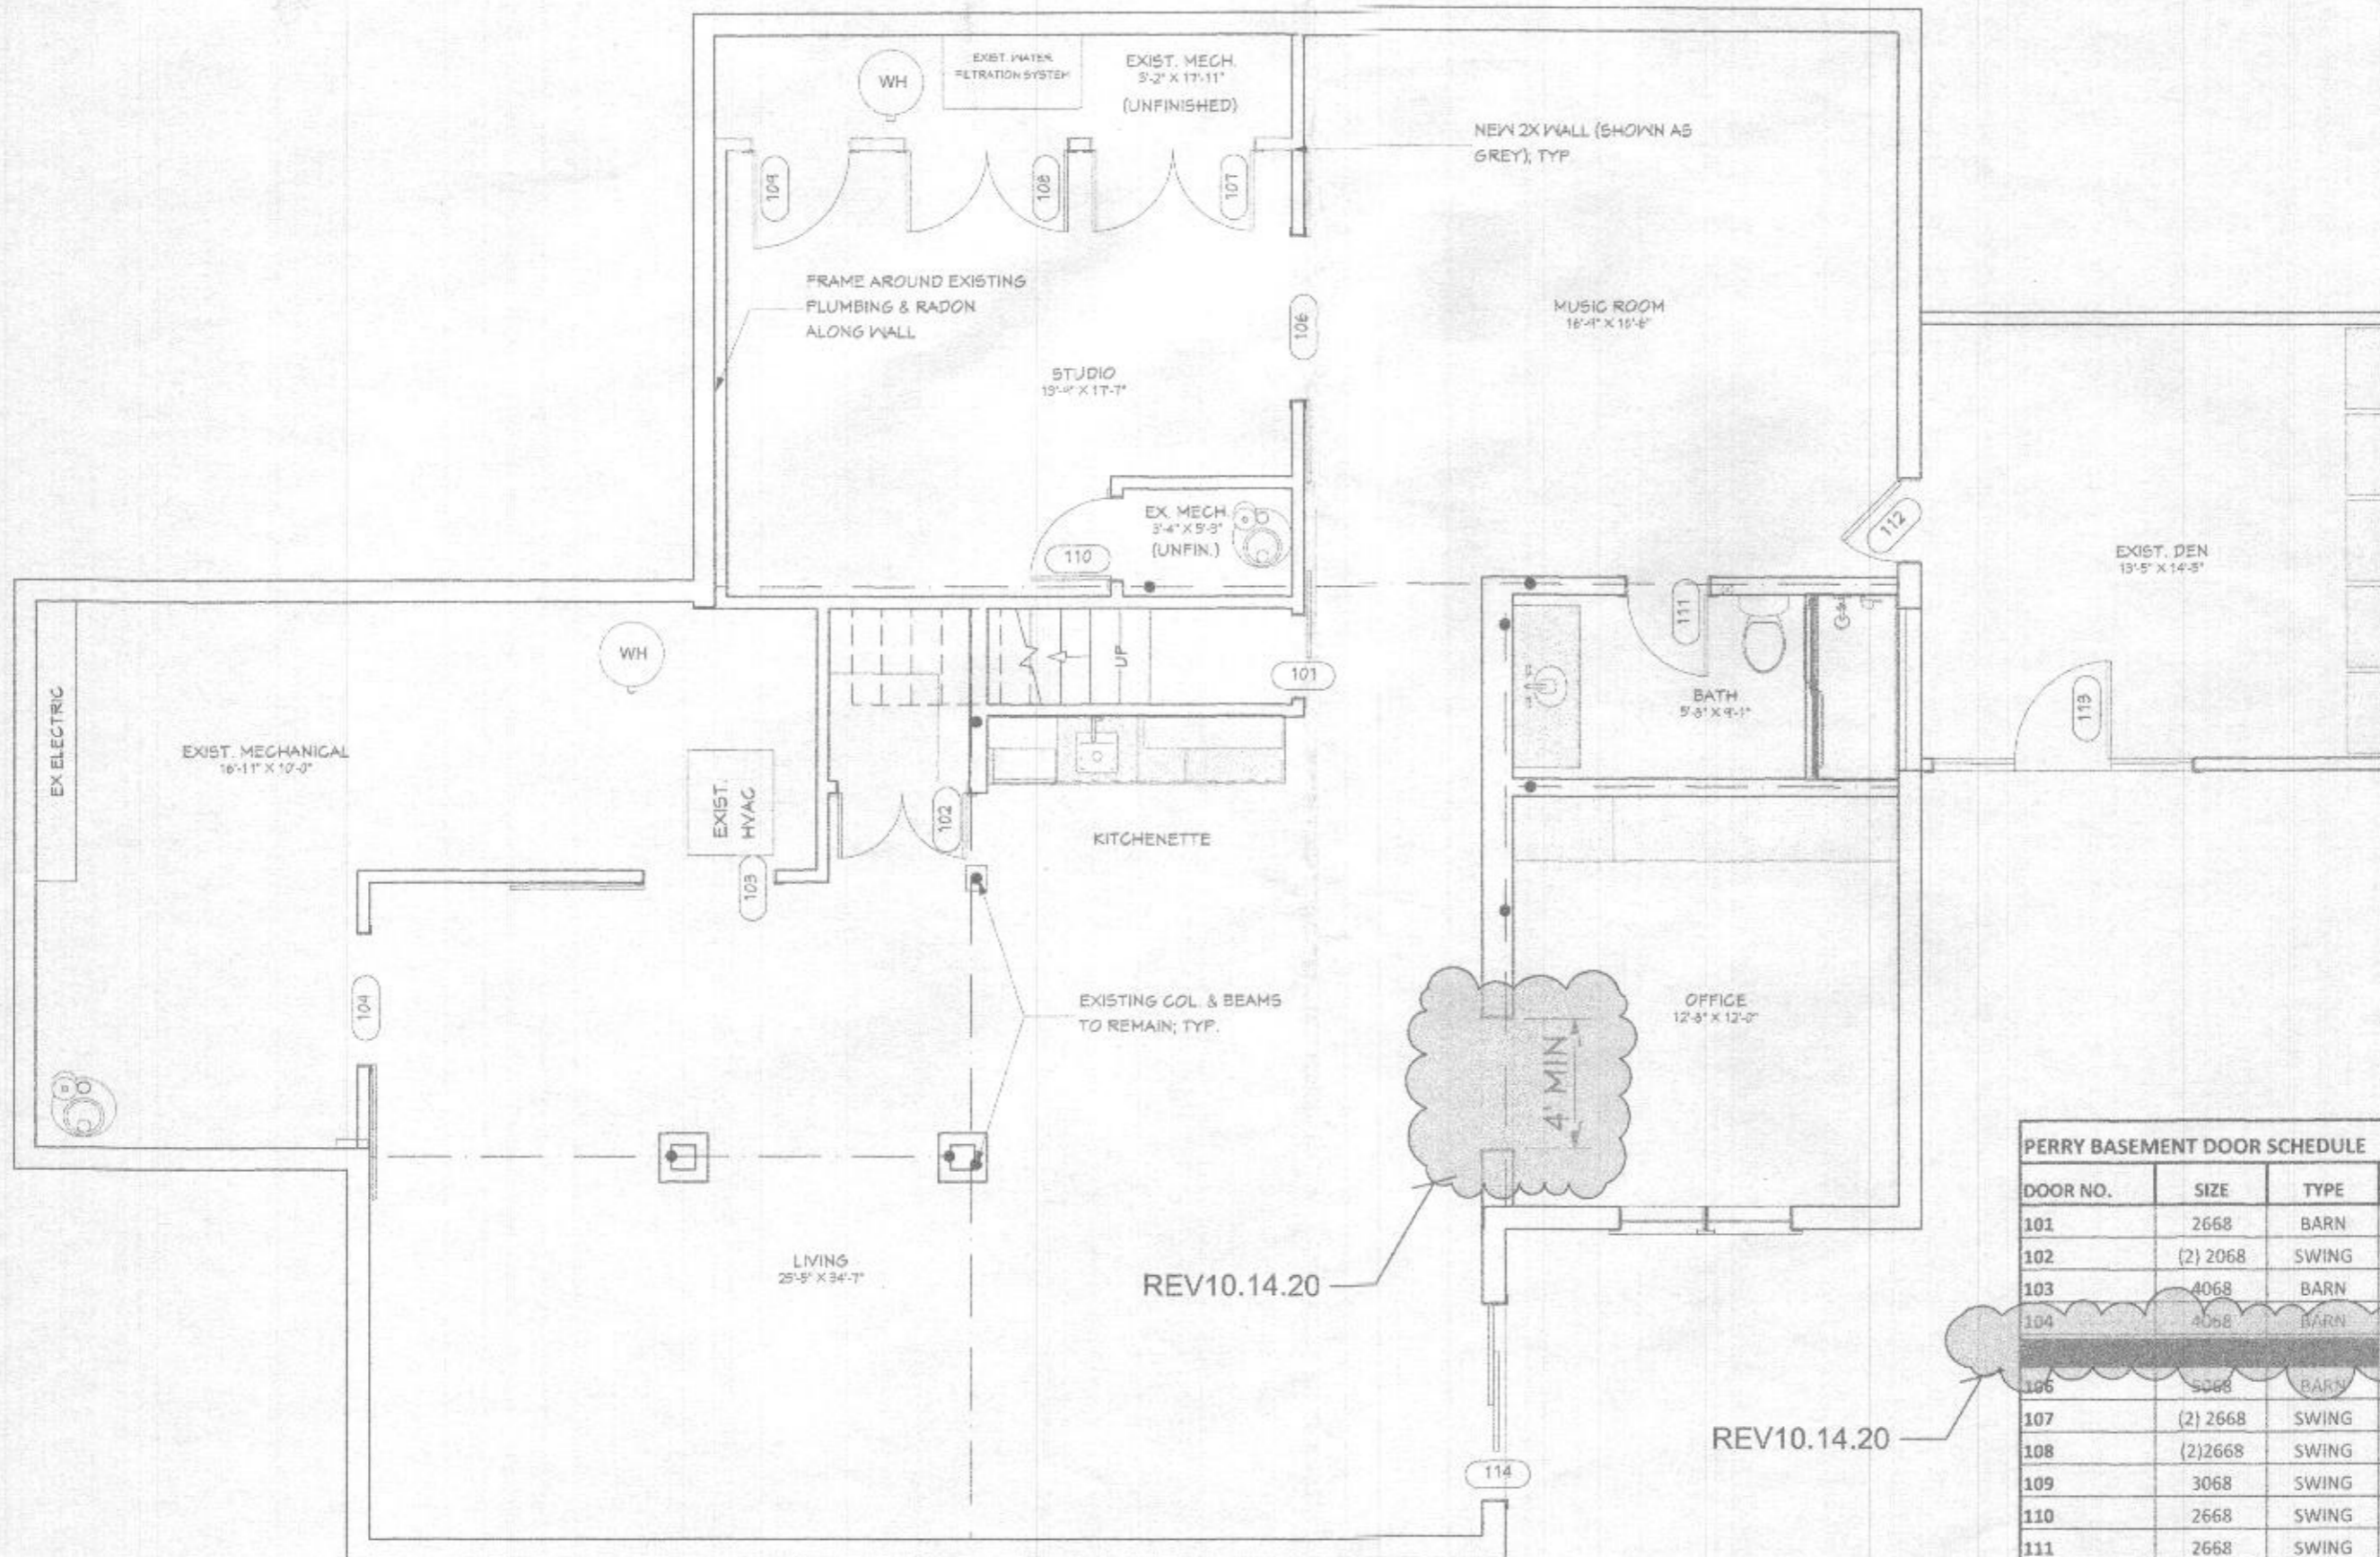

FLOOR PLAN

PERRY BASEMENT DOOR SCHEDULE			
DOOR NO.	SIZE	TYPE	NOTES
101	2668	BARN	
102	(2) 2068	SWING	
103	4068	BARN	
104	4068	BARN	
106	5068	BARN	
107	(2) 2668	SWING	
108	(2) 2668	SWING	
109	3068	SWING	
110	2668	SWING	
111	2668	SWING	
112	EXIST	SWING	
113	3068	SWING	EXTERIOR
114	EXIST	SLIDER	EXTERIOR