

HOWARD COUNTY PERMIT APPLICATION

PERMIT NUMBER

B09000321

Building Address 15282 Roxbury Rd
Glenc, MD 21737

Suite/Apt. # _____ SDP/WR/Petition # _____

Census Tract _____ Subdivision _____

Section _____ Area _____ Lot _____

Tax Map 21 Parcel 27 Grid 15

Zoning R6D Map Coordinates _____ Lot size 5.15

Property Owner's Name Craig T. Garrison
Garrison - Morgan

Address 15282 Roxbury Rd

City Glenc State MD Zip Code 21737

Phone 410-467-0851 Phone 240-567-5237

Applicant's Name & Mailing Address, (if other than stated hereon):

Phone _____ Fax _____

Existing Use Residential

Proposed Use Residential

Estimated Construction Cost \$ 200,000

Description of Work Remove existing addition
Replace with same use addition
18 x 30 2-story addition

Contractor Company
Home Master Inc. Construction

Contact Person _____

Address _____

City _____ State _____ Zip Code _____

License No. _____

Phone _____ Fax _____

Occupant or Tenant _____

Contact Name _____

Address _____

City _____ State _____ Zip Code _____

Phone _____ Fax _____

Engineer or Architect Company _____

Contact Person _____

Address _____

City _____ State _____ Zip Code _____

Phone _____ Fax _____

BUILDING DESCRIPTION - COMMERCIAL

BUILDING DESCRIPTION - RESIDENTIAL

Building Characteristics

Height: _____

No. of stories: _____

Gross area, sq. ft. per floor: _____

Use group: _____

Construction type:
☐ Reinforced Concrete
☐ Structural Steel
☐ Masonry
☐ Wood Frame
☐ State Certified Modular

Utilities

Water Supply:
☐ Public
☐ Private

Sewage Disposal:
☐ Public
☐ Private

Electric Yes ☐ No ☐
 Gas Yes ☐ No ☐

Heating System:
 Electric ☐ Oil ☐
 Natural Gas ☐
 Propane Gas ☐

Sprinkler system: N/A ☐
☐ Full
☐ Partial
☐ Other Suppression
 # of Heads _____

Building Characteristics

SF Dwelling ☒ SF Townhouse ☐

Depth _____ Width _____

1st floor: 15' x 21'

2nd floor: 15' x 18' x 32'

Basement: 15' x 31'

Finished Basement ☐ Unfinished Basement ☐

Crawl space ☐ Slab on Grade ☐

No. of Bedrooms 1

Height: _____

Multi-family dwellings:
 No. of efficiency units: _____
 No. of 1 BR units: _____
 No. of 2 BR units: _____
 No. of 3 BR units: _____

Other Structure: _____

Dimensions: _____

Footings: _____

Roof Height: _____

☐ State Certified Modular
☐ Manufactured Home

Utilities

Water Supply:
☐ Public
☒ Private

Sewage Disposal:
☐ Public
☒ Private

Electric Yes ☐ No ☐
 Gas Yes ☐ No ☒

Heating System:
 Electric ☒ Oil ☐
 Natural Gas ☐
 Propane Gas ☐

Sprinkler system: N/A ☐
☐ NFPA #13D
☐ NFPA #13R
☐ Other:

THE UNDERSIGNED HEREBY CERTIFIES AND AGREES AS FOLLOWS: (1) THAT HE/SHE IS AUTHORIZED TO MAKE THIS APPLICATION; (2) THAT THE INFORMATION IS CORRECT; (3) THAT HE/SHE WILL COMPLY WITH ALL REGULATIONS OF HOWARD COUNTY WHICH ARE APPLICABLE THERETO; (4) THAT HE/SHE WILL PERFORM NO WORK ON THE ABOVE REFERENCED PROPERTY NOT SPECIFICALLY DESCRIBED IN THIS APPLICATION; (5) THAT HE/SHE GRANTS COUNTY OFFICIALS THE RIGHT TO ENTER ONTO THIS PROPERTY FOR THE PURPOSE OF INSPECTING THE WORK PERMITTED AND POSTING NOTICES.

Craig T. Garrison
Applicant's Signature

Craig T. Garrison - Morgan
Print Name
March 3 2009
Date

Title/Company

Checks payable to: **DIRECTOR OF FINANCE OF HOWARD COUNTY**
 ** PLEASE WRITE NEATLY AND LEGIBLY. **
 FOR OFFICE USE ONLY

AGENCY	DATE	SIGNATURE	APPROVAL
✓ Land Development, DPZ			
State Highways			
✓ Building Official			
Dev. Engineering, DPZ			
✓ Health	<u>3/16/09</u>	<u>William Stolt</u>	
Fire Protection			
Is Sediment Control approval required prior to issuance?			
YES ☐ NO ☐			

DPZ SETBACK INFORMATION		PROPERTY ID#:
Front: _____	Filing fee	\$ <u>200</u>
Rear: _____	Permit fee	\$ _____
Side: _____	Excise tax	\$ _____
Side St: _____	Add'l per. fee	\$ _____
All minimum setbacks met?	TOTAL FEES	\$ _____
YES ☐ NO ☐	Sub-total paid	\$ _____
Is Entrance Permit required?	Balance due	\$ _____
YES ☐ NO ☐	Check	# <u>4720</u>
Historic District?	Validation	# _____
YES ☐ NO ☐		
Lot Coverage for NewTown Zone _____		
SDP/Red-line approval date _____		


CONTINGENCY CONSTRUCTION START: ☐
 ONE STOP SHOP: ☐

Distribution of Copies- White: Building Official Green: LDD, DPZ Yellow: DED, DPZ Pink: Health Gold: SHA

T:\forms\PERMIT.FRM

Accepted by _____

Rev. 11/4/04

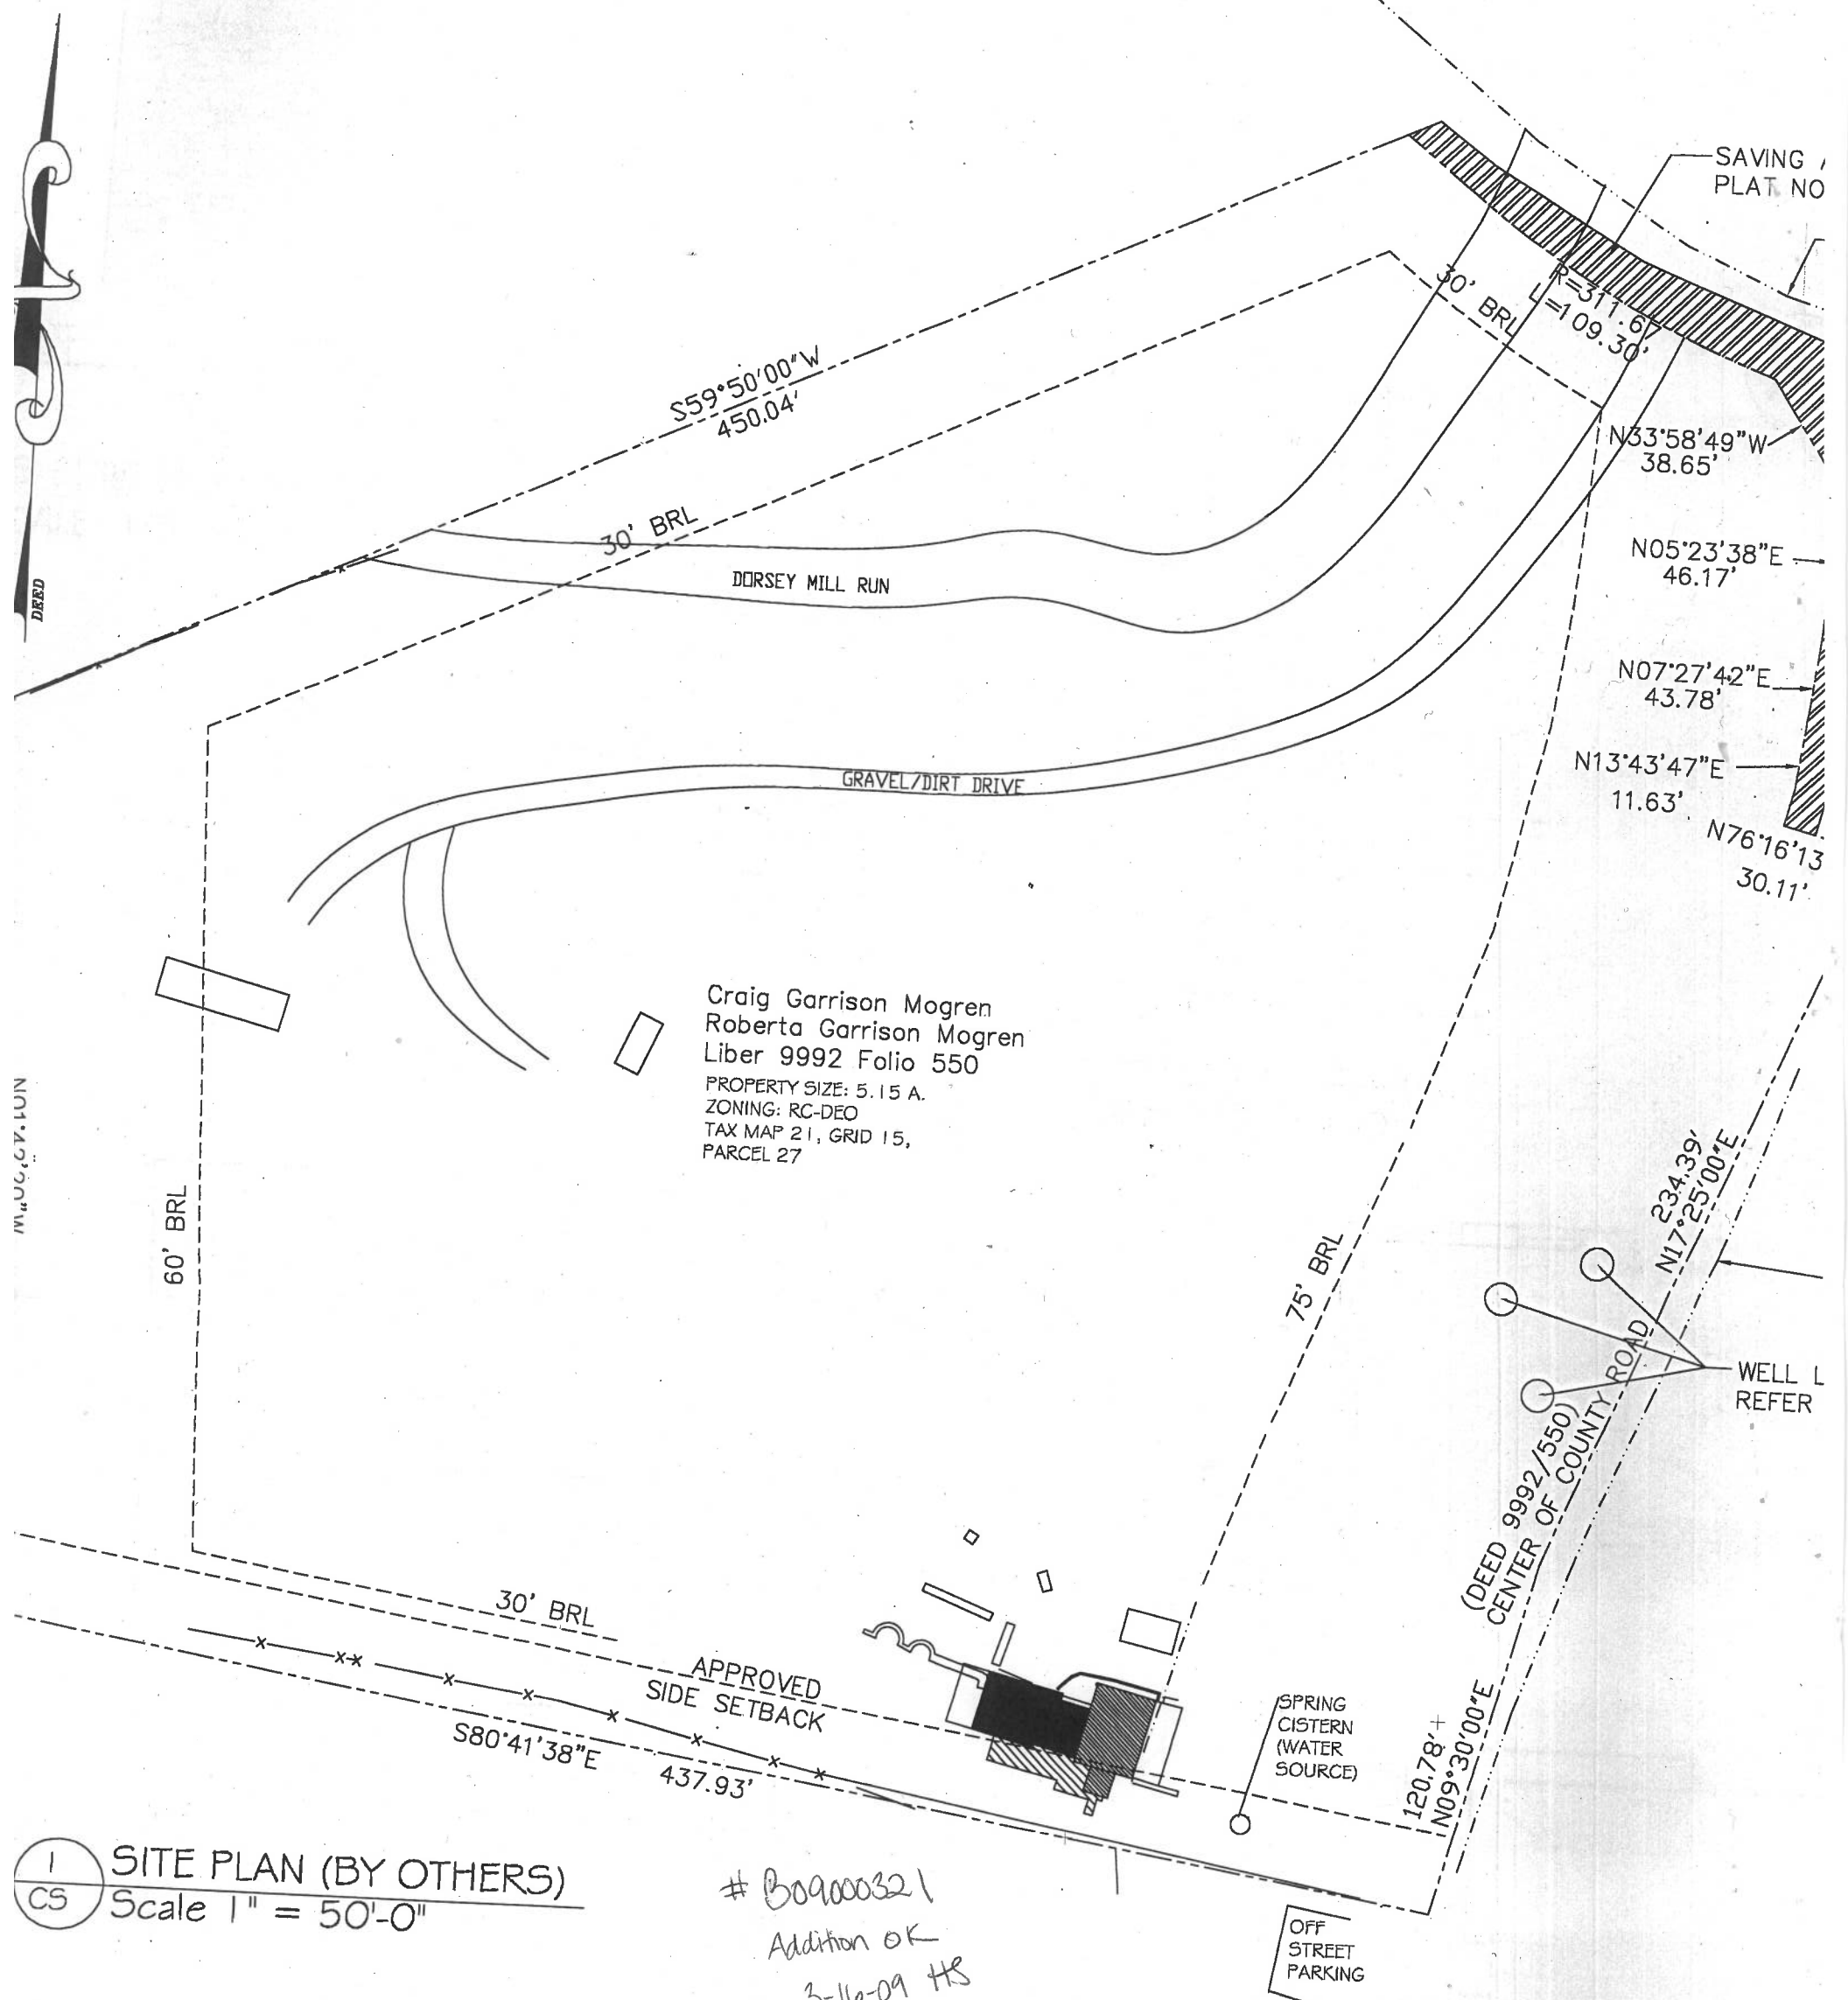

1 SITE PLAN (BY OTHERS)
CS Scale 1" = 50'-0"

ASSOCIATES L.L.C.
ENGINEERING-LAND PLANNING
VENUE ELLICOTT CITY, MARYLAND
747-8738 FAX (410)747-8547