

PUB. SEWER STATUS VERIFIED BY _____

ISSUE DATE: _____

PERMIT

P 535188

APPROVAL DATE: 6/16/11

A REPAIR

Septic Repair ON-SITE SEWAGE DISPOSAL SYSTEM HOWARD COUNTY HEALTH DEPARTMENT BUREAU OF ENVIRONMENTAL HEALTH

Fogles Septic Clean Inc. IS PERMITTED TO INSTALL ☐ ALTER ☒

ADDRESS: 580 Obrecht Road Sykesville, MD 21784 PHONE NUMBER: 410-795-5670

SUBDIVISION: _____ LOT NUMBER: 4

ADDRESS: 5240 Talbots Landing PROPERTY OWNER: John Buttrum

SEPTIC TANK CAPACITY (GALLONS): N/A

PUMP CHAMBER CAPACITY (GALLONS): _____

NUMBER OF BEDROOMS: 3

SQUARE FEET OF HOUSE: _____

LINEAR FEET OF TRENCH REQUIRED: 200'

0.6 App. rate

TRENCHES:	<u>2' wide</u> <u>Inlet - 5' Bottom - 11' 6' of stone below pipe</u>
LOCATION:	<u>Install trenches just below existing system.</u> <u>New D box to be used obs. pipes in trenches</u>
PURPOSE:	<u>2 x 70' trenches running to N NW and 1 x 66'</u> <u>trench running in opp. direction.</u>

PLANS APPROVED: K. Wolf DATE: 6/2/11

NOTE: PERMIT VOID AFTER 2 YEARS

NOTE: CONTRACTOR RESPONSIBLE FOR SCHEDULING A PRE-CONSTRUCTION INSPECTION FOR ALL INSTALLATIONS


NOTE: WATERTIGHT SEPTIC TANKS REQUIRED

NOTE: ALL PARTS OF SEPTIC SYSTEM SHALL BE 100 FEET FROM ANY WATER WELL

NOTE: MANHOLE RISERS REQUIRED ON ALL SEPTIC TANKS AND PUMP CHAMBERS

**NEITHER THE HOWARD COUNTY COUNCIL OR THE HEALTH DEPARTMENT IS
RESPONSIBLE FOR THE SUCCESSFUL OPERATION OF ANY SYSTEM
PERMITTEE RESPONSIBLE FOR OBTAINING FINAL APPROVAL ON THIS PERMIT
CALL 410-313-1771 FOR INSPECTION OF SEPTIC SYSTEM**

HO-73-374

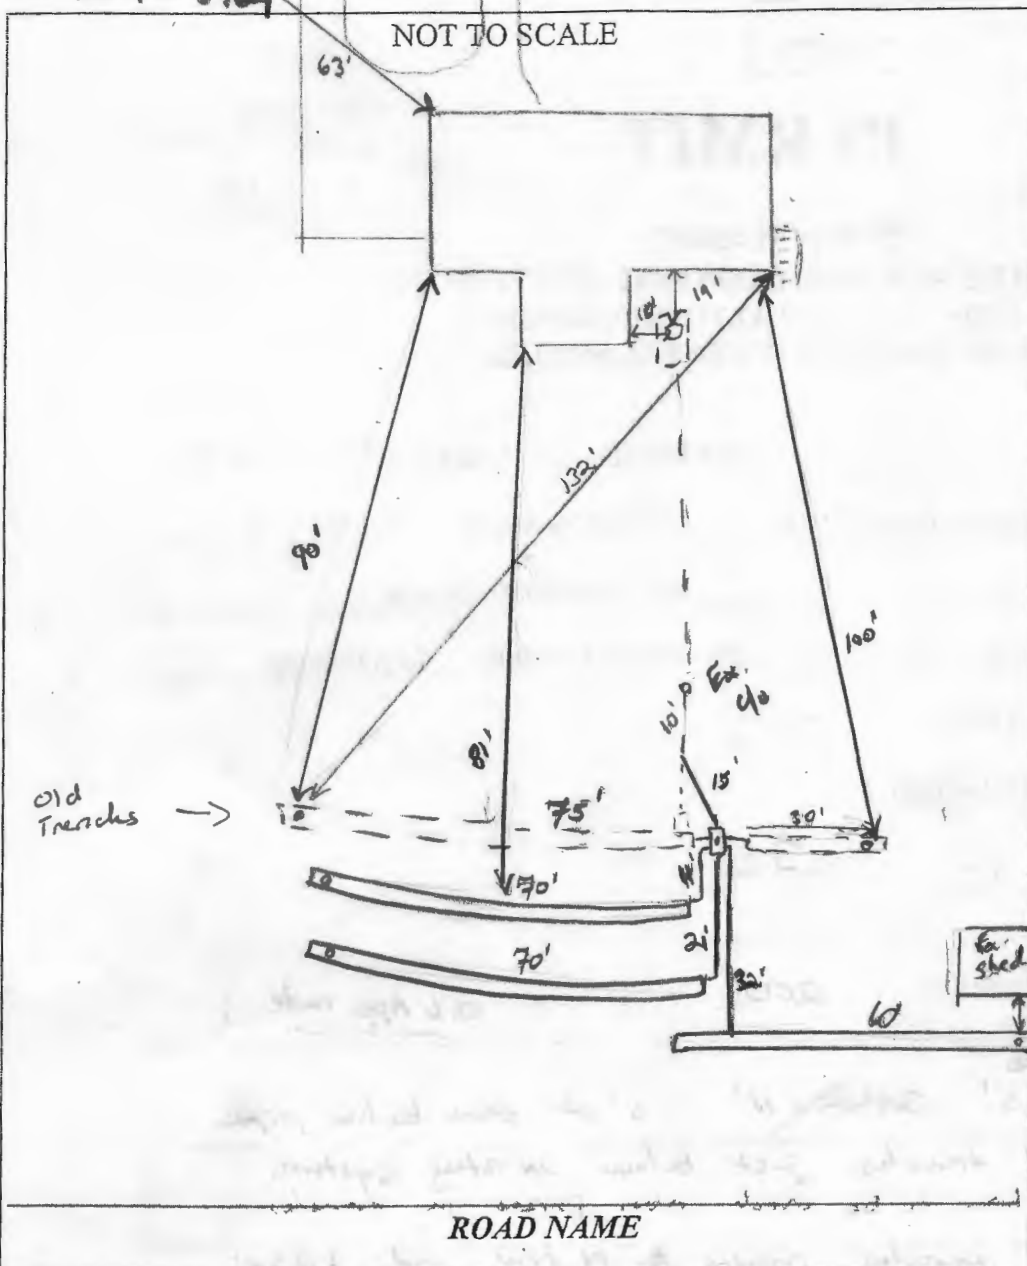

TRENCH/DRAINFIELD DATA		
WIDTH	INLET	BOTTOM

WIDTH	INLET	BOTTOM
<u>2</u>	<u>5</u>	<u>11</u>
NUMBER OF TRENCHES	<u>3 + 2 ex</u>	
TOTAL LENGTH	<u>200 + Existing</u>	
ABSORPTION AREA	<u>400' + SW</u>	
DISTRIBUTION BOX LEVEL	<u>Level 6</u>	
DISTRIBUTION BOX BAFFLE	<u>Yes</u>	
DISTRIBUTION BOX PORT	<u>Yes</u>	

SEPTIC TANK DATA

SEPTIC TANK 1 LEVEL Yes
MANUFACTURER ?
CAPACITY 1500 GAL
SEAM LOC Top
TANK LID DEPTH 3'
BAFFLES Yes
BAFFLE FILTER —
MANHOLE LOC Front
6" PORT LOC none
WATERTIGHT TEST —
SLOTTED no
DATE ON LID —

PUMP/SEPTIC TANK LEVEL _____

MANUFACTURER _____

CAPACITY _____ GAL

SEAM LOC _____

TANK LID DEPTH _____

BAFFLES _____

BAFFLE FILTER _____

MANHOLE LOC _____

6" PORT LOC _____

WATERTIGHT TEST

SLOTTED

DATE ON LID _____

PRE-CONSTRUCTION:

5/20/11 System laid out tentatively. Will check on public sewer & H₂O for home owner (KW) 5/23/11 Contact w/ public Works confirmed this address is part of the metropolitan area and is therefore not available for public sewer @ this time. (KW) 6/13/11 Received call from contractor (Fogel) gave specs on design via phone call. Will stop out on-site later in pm to check install process. Trenches will be installed on contour just below ex. system. (KW)

INSTALLATION:

INSTALLATION: just before ex. system. (K) 6/14/11 Top trench being dug. Contractor found another Dbox w/ broken pipe but was clogged. Told contractor to expose and we may be in do new Dbox. Speedy levelers will be installed to adjust flow to new system. OK to connect 6/15/11 Both 7' trenches installed. Starting 60' trench. Contractor exposed ends of ex. trench. Clean stone. Add obs. pipes to both ends. (K) 6/16/11 System complete. Dbox leveled. Turned levelers up to 80% flow on existing pipes. OK to cover all work

FINAL INSPECTOR

DATE OF APPROVAL _____

6/16/11

Fee Paid \$ 330.00
Receipt # P 535188

SEPTIC SYSTEM REPAIR / UPGRADE / EVALUATION REQUEST

Please fill out this form completely and check off the reason for the request:

Date requested: _____

Reason for Request

Failing System (includes surface discharge or inadequate treatment zone) ☒

Has the contractor verified through excavation/pumping evaluation, that there are no pipe blockages? _____

In support of a building permit. Type of building addition: _____

*System relocation for proposed addition for setback compliance _____

*Verification of adequate system capacity per COMAR 26.04.02.02D (4) _____

To replace collapsed septic tank or upgrade tank capacity _____

To replace collapsed drywell _____

Septic Contractor:

Fogle's Septic Clean Inc.

Contractor's Address:

580 Obrecht Rd.

Sykesville, MD 21784

Contractor's Phone #:

410 795-5670

Property Address:

5240 Talbots Landing

Property (Subdivision) & Lot #

Lot 4 Talbots Landing

Owner's Name:

John Buttrum

Is public sewer available/nearby: _____

Names of Any Previous Owners: _____

Year House Built:

1982

of Existing Bedrooms:

3

of Bedrooms after completion of addition: _____

Has this request been discussed previously with a Sanitarian, who? _____

If public sewer is close, further research will be performed to verify availability and possible hook up to public sewer.

A Sanitarian will be in contact within three business days depending upon the urgency of the situation to coordinate the scheduling of the repair /upgrade/evaluation. No inspection will be performed without fee collection at the office.

Environmental Sanitarian tentatively assigned _____

FAX TO 410-313-2648



HOWARD COUNTY HEALTH DEPARTMENT

35188

DATE
5 / 16 / 11

Received
From

Fogel's Super Clean Inc

PHONE # *410-715-5170*

☐ CASH
☒ CHECK

NO.

35381

For

*House Apprais 5040 Teller's Landing
2nd fl Teller's Landing*

Three hundred thirty Dollars

\$

330.00

Received By

[Signature]