

APPLICATION

SEWAGE DISPOSAL TESTING

MARYLAND STATE DEPARTMENT OF HEALTH

HOWARD COUNTY

ELLICOTT CITY

DISTRICT 5

DATE 9/24/71

A 16332

P _____

TO: THE COUNTY HEALTH OFFICER
ELLICOTT CITY, MARYLAND

I, HEREBY, APPLY FOR THE NECESSARY TESTS IN ORDER TO CONSTRUCT (OR RECONSTRUCT) A SEWAGE DISPOSAL SYSTEM.

PROPERTY OWNER John J. Fyock

ADDRESS Ten Oaks Road, Glenelg, Maryland

PHONE 286-2939

PROPERTY LOCATION:

SUBDIVISION _____ LOT NO. B

ROAD AND DESCRIPTION Ten Oaks Road, across from 3926 Ten Oaks Rd. beyond Fyock's
Garage toward Clarksville

OCCUPANT _____ PHONE _____

PERSON TO CONSTRUCT SYSTEM _____

ADDRESS _____ PHONE _____

SIZE OF LOT 40,000 sq. ft. TYPE BLDG. 3 or 4 Bedrooms

NUMBER OF BEDROOMS

IF NOT SINGLE RESIDENCE DESCRIBE Single Family Dwlg.

SIGNATURE OF APPLICANT s/ Jack Fyock

APPROVED BY Raymond Hodge FOR Dry Well DATE 11/12/71

(KIND OF SYSTEM)


REJECTED BY _____ FOR _____ DATE _____

(KIND OF SYSTEM)

HOLD PENDING FURTHER TESTS _____ DATE _____

REASONS FOR REJECTION OR HOLDING _____

THIS IS NOT A PERMIT

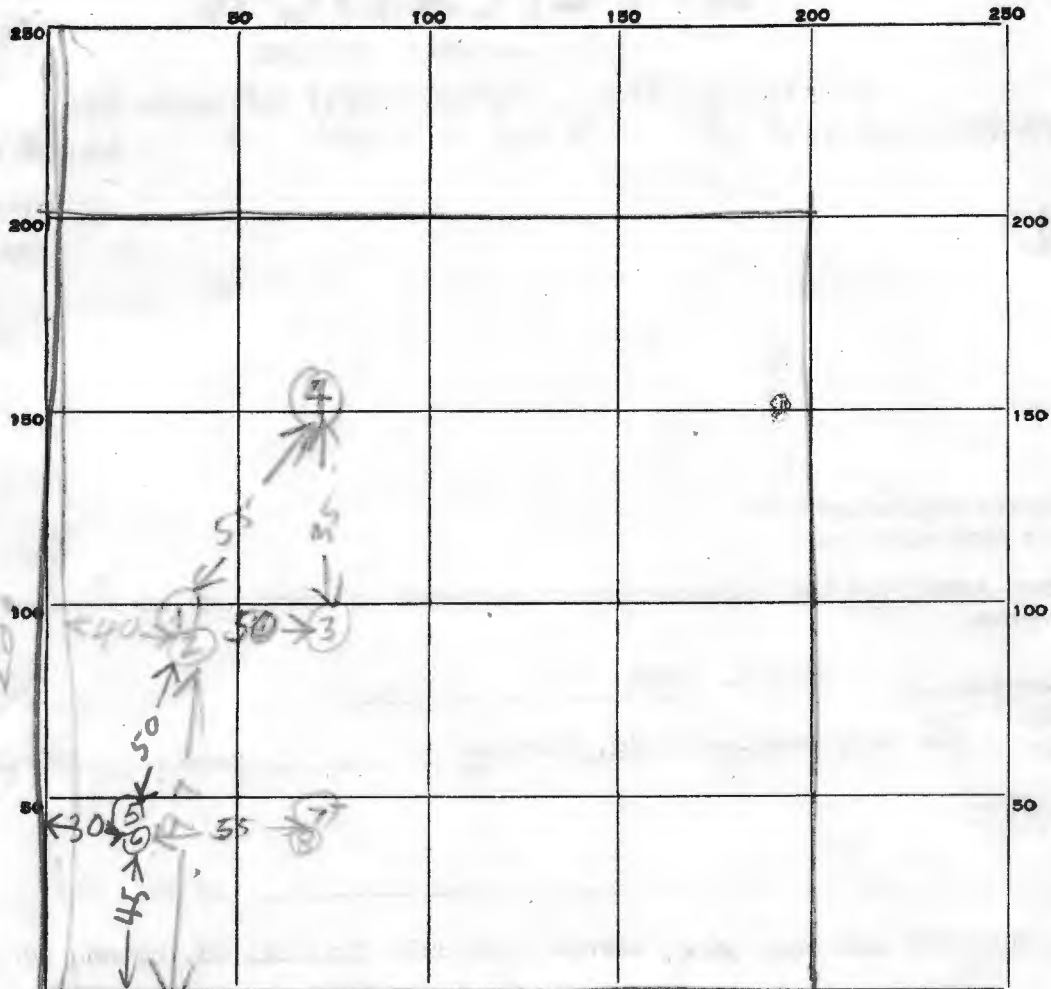

INDICATE NORTH. - NAME ADJOINING ROADWAY AS BASE LINE.


TEN OAKS Bldg

DATE	TEST NO.	DEPTH	PRE-WET		TEST - 1" DROP		TIME
			START	STOP	START	STOP	
9/29/71	1	11	1058	1057	1057	1059	2
	2	4	1055	1103	1103	1128	25
	3	5	HIT ROCK				
	4	11	NOT TESTED				
	5	6	ALL SAND				
	6	11 1/2	TESTED				
	7	12					
	8	6 1/2	1202	1207	1207	1213	6

SOIL AUGER FINDING

TESTED BY

REMARKS

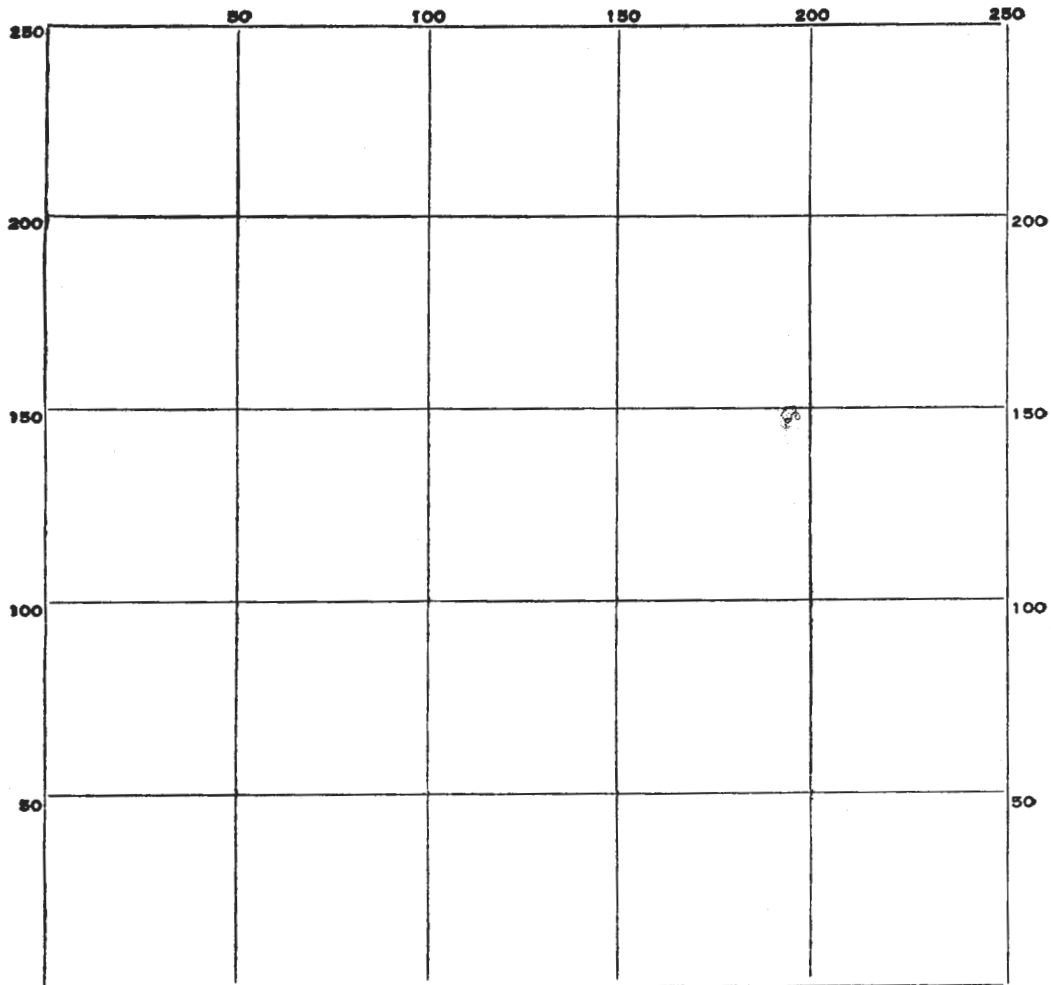

INDICATE NORTH. — NAME ADJOINING ROADWAY AS BASE LINE.

DATE	TEST NO.	DEPTH	PRE-WET		TEST - 1" DROP		TIME
			START	STOP	START	STOP	

SOIL AUGER FINDING _____

TESTED BY _____

REMARKS _____



NOTE: The lot shown hereon complies with the minimum ownership width and lot area as required by the Md. State Dept of Health Regulations.

Approved: Private Water & Private Sewer

John R. Shop June 14, 1971
County Health Officer Date

PLAT OF SURVEY
FOR
JOHN J. FYOCK
FIFTH ELECTION DISTRICT OF HOWARD COUNTY
GLENELG, MARYLAND
SCALE: 1 IN. = 50 FT. JUNE 14, 1971

Claude M. Skinner Jr.

Claude M. Skinner Jr. Reg. Eng. & Land Surveyor No. 2237





NOTE: The lot shown hereon complies with the minimum ownership width and lot area as required by the Md. State Dept of Health Regulations.

Approved: Private Water & Private Sewer

County Health Officer

Date

PLAT OF SURVEY
FOR
JOHN J. FYOCK
FIFTH ELECTION DISTRICT OF HOWARD COUNTY
GLENELG, MARYLAND
SCALE: 1 IN. = 50 FT. JUNE 14, 1971

Claude M. Skinner, Jr.

Claude M. Skinner Jr. Reg. Eng. & Land Surveyor No. 2237



A-3120

APPLICATION

SEWAGE DISPOSAL TESTING

MARYLAND STATE DEPARTMENT OF HEALTH

A 16332

P

HOWARD COUNTY

ELLICOTT CITY

DISTRICT 5

DATE 9/24/71

1000 Gal Tank

1250 Gal Tank

Dry Well 300 sq ft. sidewalk area below the inlet

Dry Well 400 sq ft sidewalk area below the inlet

Dry Well Inlet to be no deeper than 5 FT and bottom of Dry Well to be no deeper than 12 FT

TO: THE COUNTY HEALTH OFFICER
ELLICOTT CITY, MARYLAND

I, HEREBY, APPLY FOR THE NECESSARY TESTS IN ORDER TO CONSTRUCT (OR RECONSTRUCT) A SEWAGE DISPOSAL SYSTEM.

PROPERTY OWNER

ADDRESS Ten Oaks Road, Glenelg, Maryland

PHONE 286-2939

PROPERTY LOCATION:

SUBDIVISION

LOT NO. B

ROAD AND DESCRIPTION Ten Oaks Road, across from 3926 Ten Oaks Rd, beyond Fyock's

Garage toward Clarksville

OCCUPANT

PHONE

PERSON TO CONSTRUCT SYSTEM

ADDRESS

PHONE

SIZE OF LOT

40,000 sq. ft.

TYPE BLDG.

3 or 4 Bedrooms

NUMBER OF BEDROOMS

IF NOT SINGLE RESIDENCE DESCRIBE

Single Family Dwlg.

SIGNATURE OF APPLICANT

s/ Jack Fyock

APPROVED BY

FOR

(KIND OF SYSTEM)

DATE

REJECTED BY

FOR

(KIND OF SYSTEM)

DATE

HOLD PENDING FURTHER TESTS

DATE

REASONS FOR REJECTION OR HOLDING

9/29/71 Hold for final
11/4/71 Shop signed final BH

THIS IS NOT A PERMIT

250	50	100	150	200	250
200					200
150					150
100					100
50					50

INDICATE NORTH. — NAME ADJOINING ROADWAY AS BASE LINE.

DATE	TEST NO.	DEPTH	PRE-WET		TEST - 1" DROP		TIME
			START	STOP	START	STOP	

SOIL AUGER FINDING_____

TESTED BY_____

REMARKS_____