

# APPLICATION

SEWAGE DISPOSAL TESTING

MARYLAND STATE DEPARTMENT OF HEALTH

HOWARD COUNTY

ELLICOTT CITY

DISTRICT 3

DATE 6/30/72

A 17190

P \_\_\_\_\_

TO: THE COUNTY HEALTH OFFICER  
ELLICOTT CITY, MARYLAND

I, HEREBY, APPLY FOR THE NECESSARY TESTS IN ORDER TO CONSTRUCT (OR RECONSTRUCT) A SEWAGE DISPOSAL SYSTEM.

PROPERTY OWNER Ferdinand P. Kelly

ADDRESS 2508 N. Calvert St., Balto., Md. 21218 PHONE Ho 5-1635

PROPERTY LOCATION:

SUBDIVISION \_\_\_\_\_ LOT NO. 2

ROAD AND DESCRIPTION Triadelphia Mill Road

OCCUPANT \_\_\_\_\_ PHONE \_\_\_\_\_

PERSON TO CONSTRUCT SYSTEM \_\_\_\_\_

ADDRESS \_\_\_\_\_ PHONE \_\_\_\_\_

SIZE OF LOT 1.072 acres TYPE BLDG. 3 or 4 bedrooms  
NUMBER OF BEDROOMS

IF NOT SINGLE RESIDENCE DESCRIBE \_\_\_\_\_

SIGNATURE OF APPLICANT /s/ William G. Rasch, II


APPROVED BY \_\_\_\_\_ FOR \_\_\_\_\_ DATE \_\_\_\_\_  
(KIND OF SYSTEM)

REJECTED BY Robert Tane FOR Any System DATE 7/14/72  
(KIND OF SYSTEM)

HOLD PENDING FURTHER TESTS \_\_\_\_\_ DATE \_\_\_\_\_

REASONS FOR REJECTION OR HOLDING \_\_\_\_\_

# THIS IS NOT A PERMIT

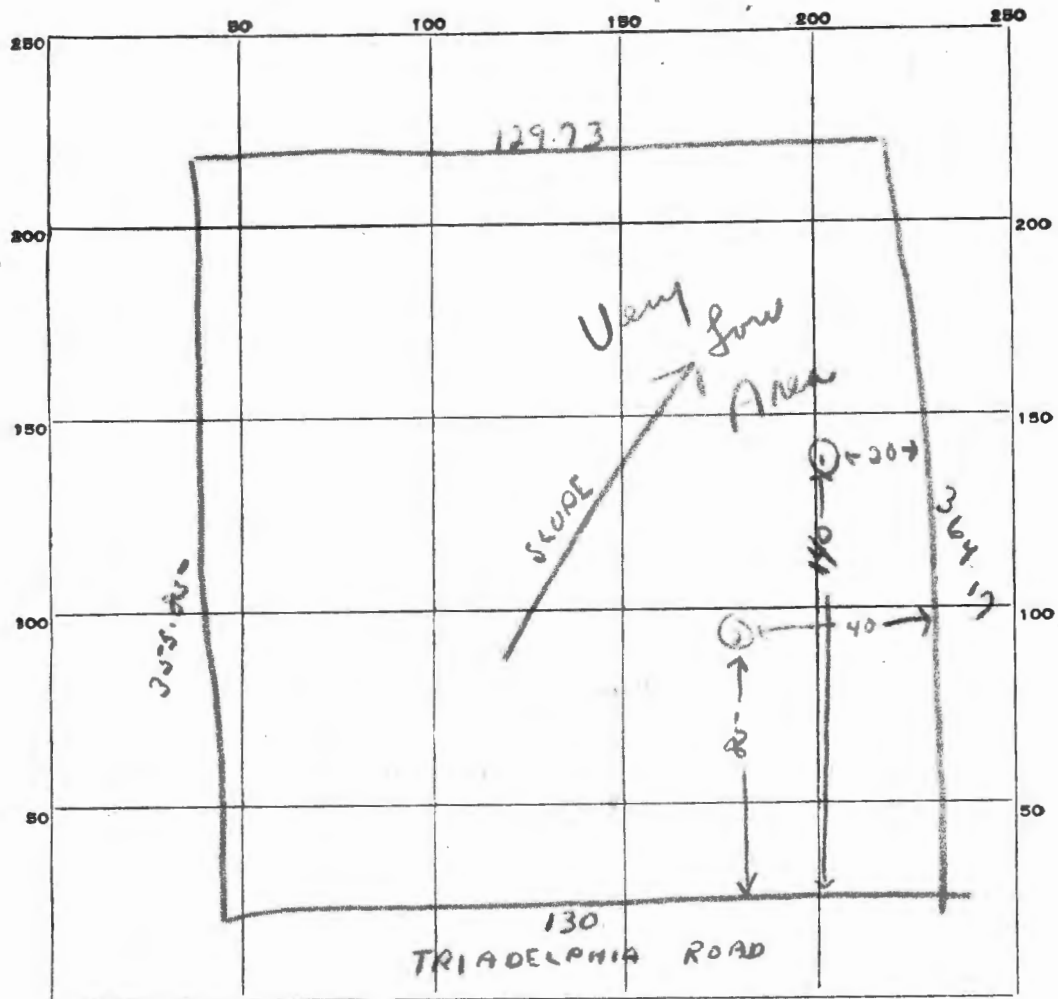

INDICATE NORTH. - NAME ADJOINING ROADWAY AS BASE LINE.

DATE	TEST NO.	DEPTH	PRE-WET		TEST - 1" DROP		TIME
			START	STOP	START	STOP	
7/14/22	1	8ft	Water	Chang	from 5 ft		
	2	8ft	Water	"	"		
5/14/22							

SOIL AUGER FINDING

TESTED BY

R. Tuna

REMARKS

# APPLICATION

SEWAGE DISPOSAL TESTING

MARYLAND STATE DEPARTMENT OF HEALTH

HOWARD COUNTY

ELLICOTT CITY

DISTRICT 3

DATE 6/30/72

A 17190

P \_\_\_\_\_

TO: THE COUNTY HEALTH OFFICER  
ELLICOTT CITY, MARYLAND

I, HEREBY, APPLY FOR THE NECESSARY TESTS IN ORDER TO CONSTRUCT (OR RECONSTRUCT) A SEWAGE DISPOSAL SYSTEM.

PROPERTY OWNER Ferdinand P. Kelly

ADDRESS 2508 N. Calvert St., Balto., Md. 21218 PHONE Ho 5-1635

PROPERTY LOCATION:

SUBDIVISION \_\_\_\_\_ LOT NO. 2

ROAD AND DESCRIPTION Triadelphia Mill Road

OCCUPANT \_\_\_\_\_ PHONE \_\_\_\_\_

PERSON TO CONSTRUCT SYSTEM \_\_\_\_\_

ADDRESS \_\_\_\_\_ PHONE \_\_\_\_\_

SIZE OF LOT 1.072 acres TYPE BLDG. 3 or 4 bedrooms  
NUMBER OF BEDROOMS

IF NOT SINGLE RESIDENCE DESCRIBE \_\_\_\_\_

SIGNATURE OF APPLICANT /s/ William G. Rasch, II


APPROVED BY \_\_\_\_\_ FOR \_\_\_\_\_ DATE \_\_\_\_\_  
(KIND OF SYSTEM)

REJECTED BY Robert Tane FOR Any System DATE 7/14/72  
(KIND OF SYSTEM)

HOLD PENDING FURTHER TESTS \_\_\_\_\_ DATE \_\_\_\_\_


REASONS FOR REJECTION OR HOLDING \_\_\_\_\_

# THIS IS NOT A PERMIT

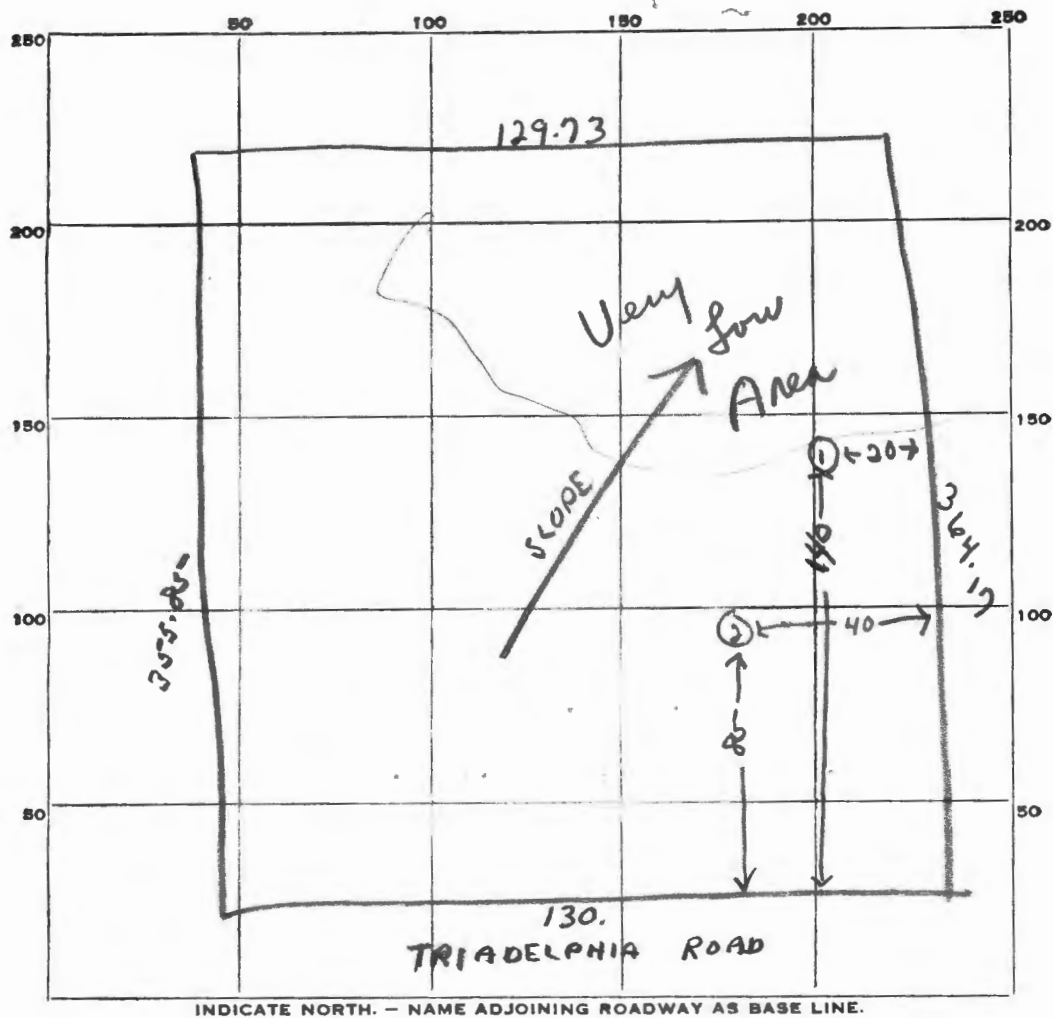[illegible]

NOTE: THE LOTS SHOWN HEREON COMPLY WITH MINIMUM GULF WIDTH AND LOT AREA AS REQUIRED BY THE MARYLAND STATE DEPARTMENT OF HEALTH REGULATIONS.


TOTAL NUMBER OF LOTS - 2  
 TOTAL AREA OF LOTS - 2.119 AC.±  
 AREA FOR PUBLIC USE - 0.134 AC.±  
 TOTAL AREA - 2.253 AC.±  
 PROPERTY SHOWN (HEREON)  
 LOCATED ON TAX MAP 16  
 PARCEL 170.  
 TITLE REFERENCE W.H.H. 422/428

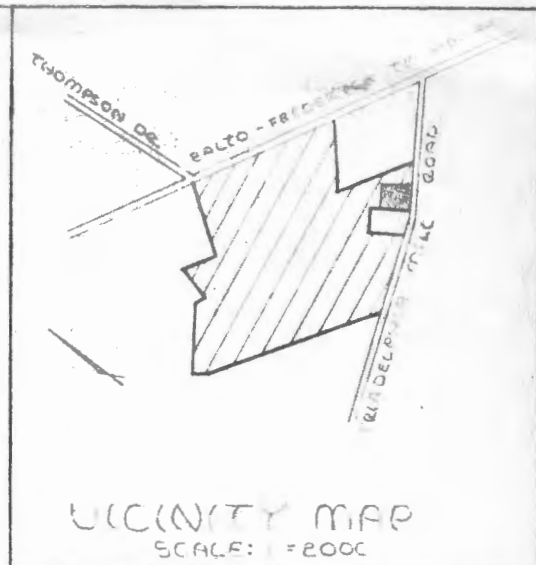

OWNER:  
 FERDINAND P. KELLY  
 2508 NORTH CALVERT ST  
 BALTIMORE, MARYLAND 21218

FERDINAND P. KELLY  
 W.H.H. 422/428

ROBERT A. BENTHOFF  
 W.H.H. 374/55

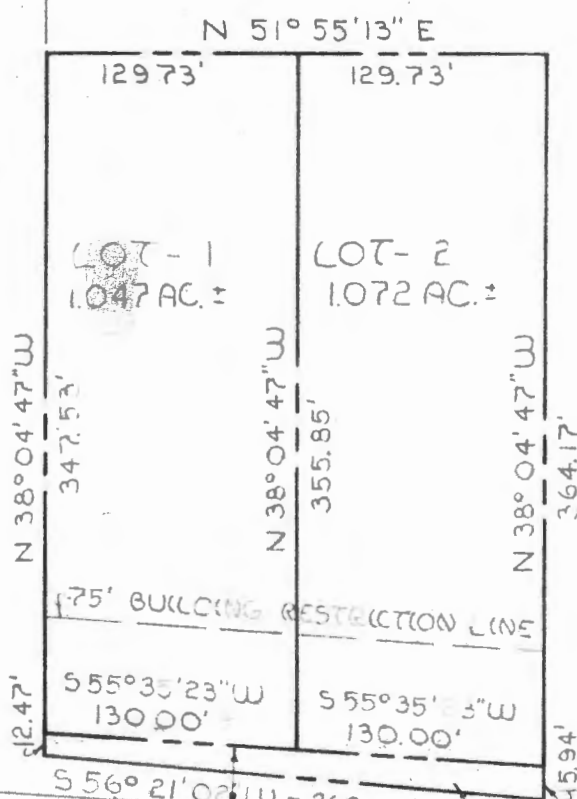

*William E. Rasch II*  
 WILLIAM E. RASCH II,  
 REG. NO. 4575

TRIADAPHELIA MILL ROAD

OWNER CERTIFICATE:

I THE UNDERSIGNED OWNER OF THE PROPERTY SHOWN HEREON MY HEIRS OR ASSIGNS, ADOPT THIS PLAN OF SUBDIVISION AND DO HEREBY ESTABLISH THE BUILDING SETBACK RESTRICTION LINE SHOWN HEREON IN ORDER TO COMPLY WITH THE GENERAL PLAN OF HIGHWAYS OF HOWARD COUNTY.

*Ferdinand P. Kelly*

APPROVED: FOR PRIVATE WATER AND PRIVATE SEWAGE.

DR. THEODORE E. SHARP  
 COUNTY HEALTH OFFICER

APPROVED: OFFICE OF PLANNING AND ZONING

THOMAS G. HARRIS, JR.  
 PLANNING DIRECTOR

PURDUM & JESCHKE  
 ENGINEERS AND LAND SURVEYORS  
 3697 PARK AVE  
 ELLICOTT CITY, MARYLAND 21043

PROPERTY OF  
 FERDINAND P. KELLY  
 3<sup>rd</sup> ELEC. DIST. - HOWARD COUNTY, MD.  
 JUNE 26, 1972 SCALE: 1" = 100'