

APPLICATION

SEWAGE DISPOSAL TESTING

MARYLAND STATE DEPARTMENT OF HEALTH

HOWARD COUNTY

ELLICOTT CITY

DISTRICT 5

DATE 7/8/68

A 13714

P _____

TO: THE COUNTY HEALTH OFFICER
ELLICOTT CITY, MARYLAND

I, HEREBY, APPLY FOR THE NECESSARY TESTS IN ORDER TO CONSTRUCT (OR RECONSTRUCT) A SEWAGE DISPOSAL SYSTEM.

PROPERTY OWNER E. Lee Cavey

ADDRESS Ten Oaks Rd., Glenelg, Md. PHONE 489-4973

PROPERTY LOCATION:

SUBDIVISION _____ LOT NO. _____

ROAD AND DESCRIPTION Ten Oaks Road - turn on Old Rt. 32 at Burnt Woods Rd.

2nd house on right on Old Rt. 32 now Ten Oaks Rd.

OCCUPANT _____ PHONE _____

PERSON TO CONSTRUCT SYSTEM _____

ADDRESS _____ PHONE _____

SIZE OF LOT 275' x 475' TYPE BLDG. Existing house
3
NUMBER OF BEDROOMS

IF NOT SINGLE RESIDENCE DESCRIBE _____

SIGNATURE OF APPLICANT Louis W. Jenkins

APPROVED BY _____ FOR _____ DATE _____

(KIND OF SYSTEM)

REJECTED BY _____ FOR _____ DATE _____

(KIND OF SYSTEM)

HOLD PENDING FURTHER TESTS W. Managham DATE 7/10/68

REASONS FOR REJECTION OR HOLDING 7/10/68 - no perc - high water table - to

try for pump system on higher part of lot

THIS IS NOT A PERMIT

APPLICATION

SEWAGE DISPOSAL TESTING

MARYLAND STATE DEPARTMENT OF HEALTH

HOWARD COUNTY

ELLICOTT CITY

DISTRICT 5

DATE 7/8/68

TO: THE COUNTY HEALTH OFFICER
ELLICOTT CITY, MARYLAND

I, HEREBY, APPLY FOR THE NECESSARY TESTS IN ORDER TO CONSTRUCT (OR RECONSTRUCT) A SEWAGE DISPOSAL SYSTEM.

PROPERTY OWNER E. Lee Cavey

ADDRESS Ten Oaks Rd., Glenelg, Md.

PHONE 489-4973

PROPERTY LOCATION:

SUBDIVISION _____

LOT NO. _____

ROAD AND DESCRIPTION Ten Oaks Road - turn on Old Rt. 32 at Burnt Woods Rd.

2nd house on right on Old Rt. 32 now Ten Oaks Rd.

OCCUPANT _____

PHONE _____

PERSON TO CONSTRUCT SYSTEM _____

ADDRESS _____

PHONE _____

SIZE OF LOT 275' x 475'

TYPE BLDG. Existing house

NUMBER OF BEDROOMS 3

IF NOT SINGLE RESIDENCE DESCRIBE _____

SIGNATURE OF APPLICANT Louis W. Jenkins

APPROVED BY _____

FOR _____

(KIND OF SYSTEM)

DATE _____

REJECTED BY _____

FOR _____

(KIND OF SYSTEM)

DATE _____


HOLD PENDING FURTHER TESTS 10/10/68

DATE 7/10/68

REASONS FOR REJECTION OR HOLDING 7/10/68 - no per. high water table

big for pump system in higher part of lot, below

THIS IS NOT A PERMIT

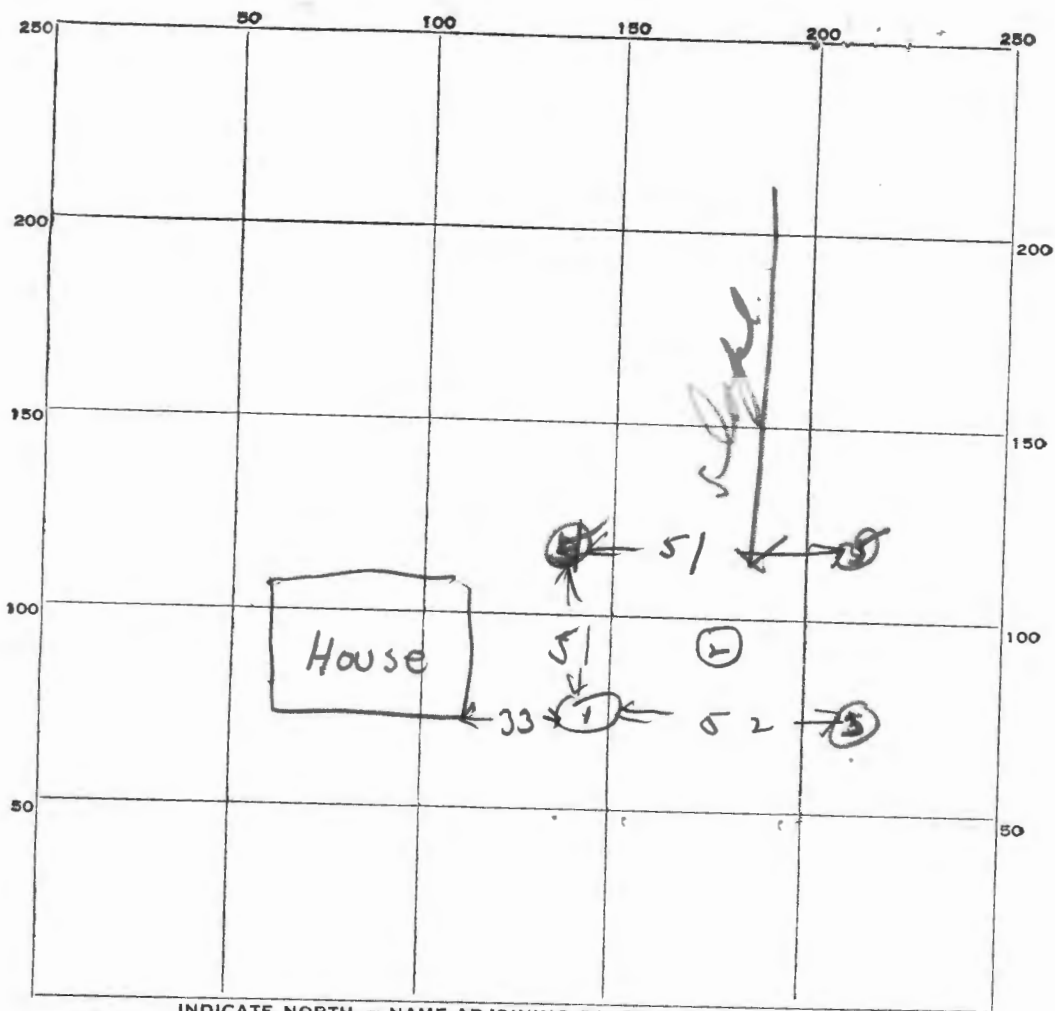

INDICATE NORTH. - NAME ADJOINING ROADWAY AS BASE LINE.

DATE	TEST NO.	DEPTH	PRE-WET		TEST - 1" DROP		TIME
			START	STOP	START	STOP	
7/10/8	1	3ft	not tested				
	2		water - 3ft from grade				
	3	3ft	water 3ft 8 inches from grade				
	4	3ft	1 ⁴⁷	stop test - no perc.			
	5	3ft	1 ⁴⁸	stop test - no perc.			

SOIL AUGER FINDING

TESTED BY

REMARKS

done 7/10/8 - Louis Perkins