

APPLICATION

SEWAGE DISPOSAL TESTING

MARYLAND STATE DEPARTMENT OF HEALTH

HOWARD COUNTY *Septic Tank - 1250 gal.*

ELLICOTT CITY

DISTRICT 3rd

DATE 2/14/73

Dry Well - 400 sq. ft. absorbent sidewall area to begin below the first 4 1/2 ft. of non-porous soil. Maximum depth permitted for dry well is 11 ft. below original grade. Locate drywell 75 ft. from left side line and 25 ft. from front lot line from left side line and 25 ft. from front lot line

TO: THE COUNTY HEALTH OFFICER *as seen from Thompson Drive.*
ELLICOTT CITY, MARYLAND

I, HEREBY, APPLY FOR THE NECESSARY TESTS IN ORDER TO CONSTRUCT (OR RECONSTRUCT) A SEWAGE DISPOSAL SYSTEM.

PROPERTY OWNER Joseph N. Selby Sr. (Ronald Sines - Contract Purchaser)
148 Elvaton Road, Millersville, Md. 21108 768-8315

ADDRESS Thompson Drive PHONE 988-9387
Ellicott City, Maryland

PROPERTY LOCATION:

SUBDIVISION _____ LOT NO. _____

ROAD AND DESCRIPTION Thompson Drive - just off Route 144 - approx. 1/8 mile in on
left hand side of Thompson Drive.

OCCUPANT _____ PHONE _____

PERSON TO CONSTRUCT SYSTEM _____

ADDRESS _____ PHONE _____

SIZE OF LOT 5.275 acres TYPE BLDG. 4 bedrooms
NUMBER OF BEDROOMS _____

IF NOT SINGLE RESIDENCE DESCRIBE _____

SIGNATURE OF APPLICANT Joan C. Sines


APPROVED BY Robert V. Fane FOR Dry Well DATE 2/27/73
(KIND OF SYSTEM)

REJECTED BY _____ FOR _____ DATE _____
(KIND OF SYSTEM)

HOLD PENDING FURTHER TESTS _____ DATE _____

REASONS FOR REJECTION OR HOLDING _____

THIS IS NOT A PERMIT

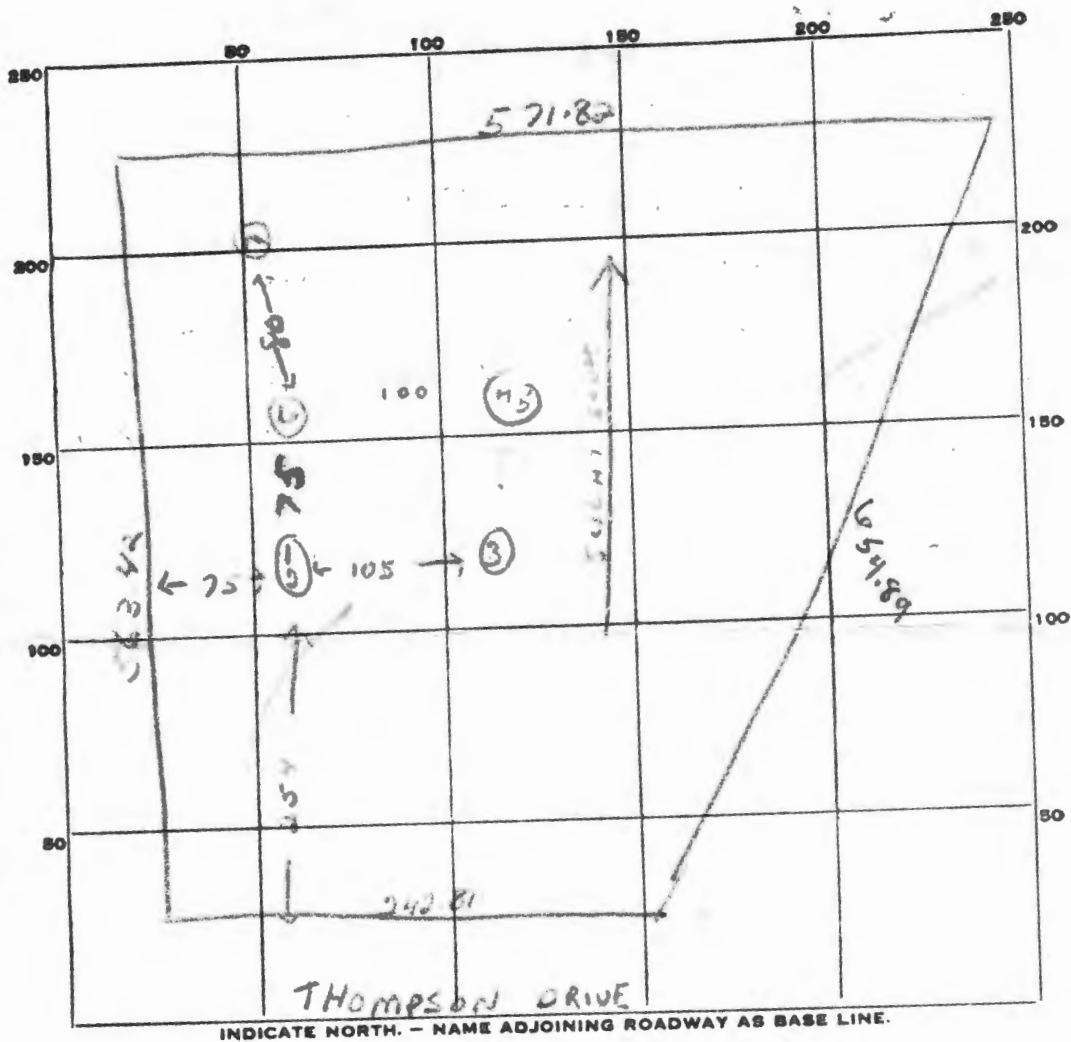

DATE	TEST NO.	DEPTH	PRE-WET		TEST - 1" DROP		TIME
			START	STOP	START	STOP	
2/15/73	1	11 ft	1 30			1 35	5 min
	2	5 ft	1 30	1 35	1 35	1 41	6 min
	3	11 ft	Long hole				
	4	11 ft	1 41			1 46	5 min
	5	4 1/2 ft	1 41	1 43	1 43	1 49	6 min
	6	11 ft	Dry - long hole		Long hole		Hole
	7	9 ft	Water - 4 1/2 ft		Long hole		

SOIL AUGER FINDING _____

TESTED BY _____

REMARKS _____

APPLICATION

SEWAGE DISPOSAL TESTING

MARYLAND STATE DEPARTMENT OF HEALTH

HOWARD COUNTY *Septic Tank - 1250 gal*

ELLICOTT CITY

DISTRICT 3rd

DATE 2/14/73

*Dry Well - 400 sq ft absorbent sidewalk area to
8 ft below the first 4 1/2 ft of non-porous
soil. Maximum depth permitted for dry well
is 11 ft below original grade. Locate dry well 75 ft
from left side line and 25 ft from front lot line
from Thompson Drive.*

TO: THE COUNTY HEALTH OFFICER
ELLICOTT CITY, MARYLAND

I, HEREBY, APPLY FOR THE NECESSARY TESTS IN ORDER TO CONSTRUCT (OR RECONSTRUCT) A SEWAGE DISPOSAL SYSTEM.

PROPERTY OWNER Joseph N. Selby Sr. (Ronald Sines - Contract Purchaser)
148 Elvaton Road, Millersville, Md. 21108 768-8315
ADDRESS Thompson Drive PHONE 988-9387
Ellicott City, Maryland

PROPERTY LOCATION:

SUBDIVISION _____ LOT NO. _____

ROAD AND DESCRIPTION Thompson Drive - just off Route 144 - approx. 1/8 mile in on
left hand side of Thompson Drive.

OCCUPANT _____ PHONE _____

PERSON TO CONSTRUCT SYSTEM _____

ADDRESS _____ PHONE _____

SIZE OF LOT 5.275 acres TYPE BLDG. 4 bedrooms
NUMBER OF BEDROOMS

IF NOT SINGLE RESIDENCE DESCRIBE _____

SIGNATURE OF APPLICANT Joan C. Sines


APPROVED BY Robert V. June FOR Dry Well DATE 2/27/73
(KIND OF SYSTEM)

REJECTED BY _____ FOR _____ DATE _____
(KIND OF SYSTEM)

HOLD PENDING FURTHER TESTS _____ DATE _____

REASONS FOR REJECTION OR HOLDING _____

THIS IS NOT A PERMIT

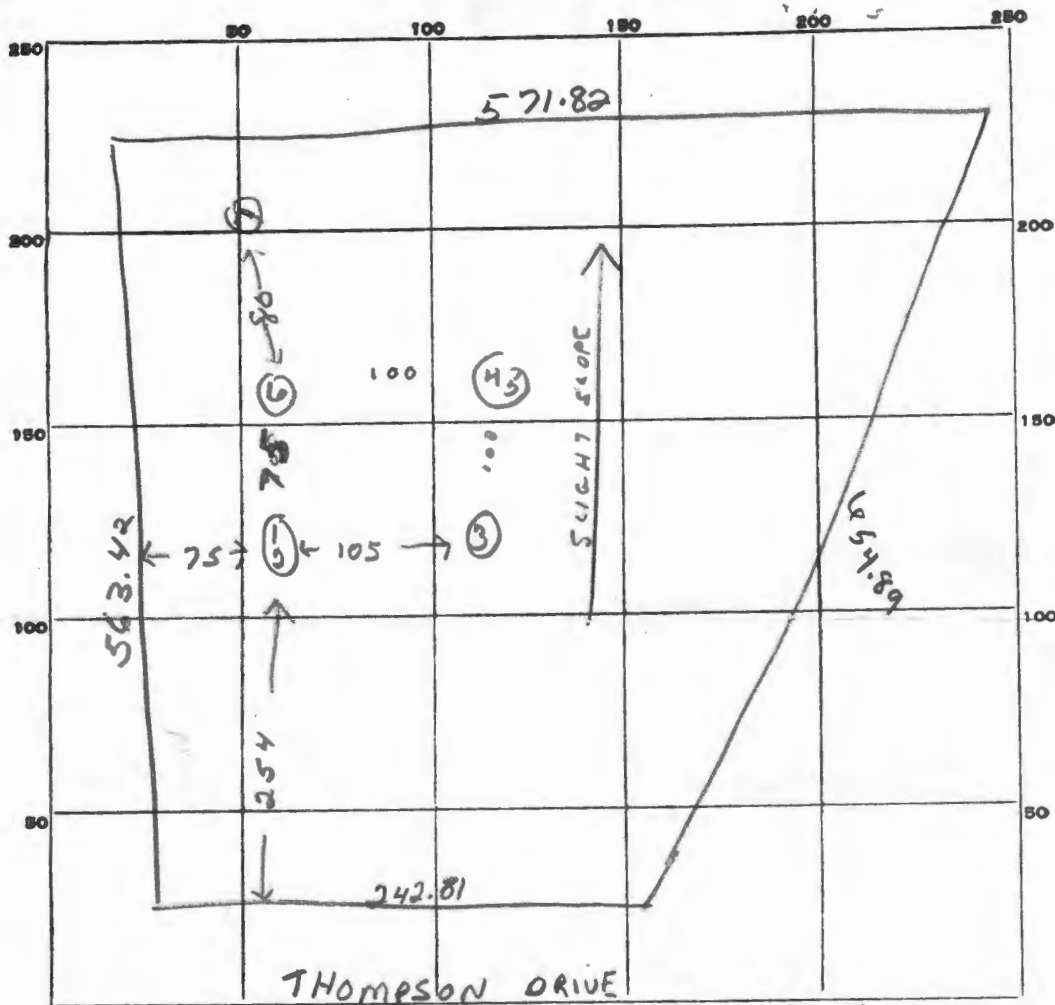


DATE	TEST NO.	DEPTH	PRE-WET		TEST - 1" DROP		TIME
			START	STOP	START	STOP	
2/12/73	1	11 ft.	1 30	—	—	1 35	5 min
	2	5 ft.	1 30	1 35	1 35	1 41	6 min
	3	11 ft.	Same Soil				
	4	11 ft.	1 41	—	—	1 46	5 min
	5	4 1/2 ft.	1 41	1 43	1 43	1 49	6 min
	6	11 ft.	Dry - Same Soil - Lowest Hole				
	7	9 ft.	Water - 4 1/2 ft. of Sand Soil				

SOIL AUGER FINDING

TESTED BY

REMARKS

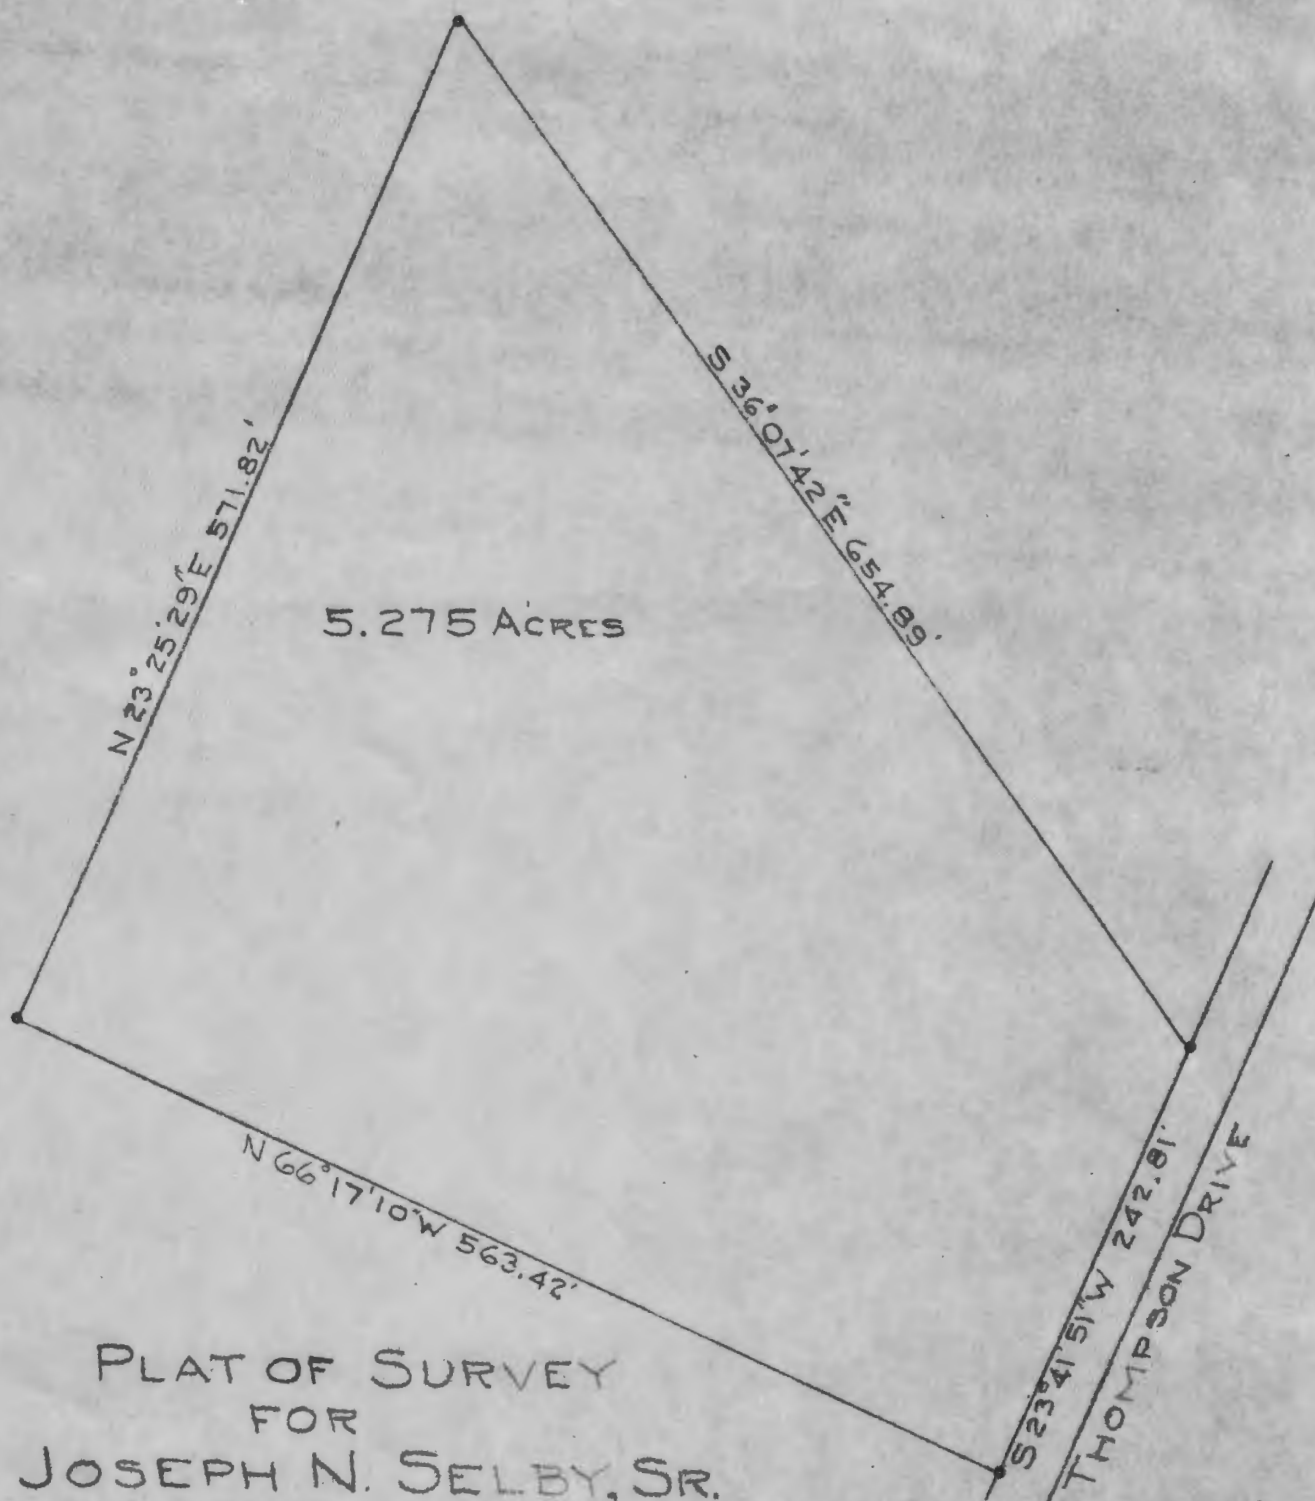

5.275 ACRES

PLAT OF SURVEY
FOR
JOSEPH N. SELBY, SR.
THIRD ELECTION DIST. HOWARD COUNTY,
ELLCOTT CITY, MARYLAND
SCALE: 1/4" = 100 FT
DECEMBER 8, 1969



Claude M. Skinner, Jr.

A 3559