

APPLICATION

SEWAGE DISPOSAL TESTING

MARYLAND STATE DEPARTMENT OF HEALTH

HOWARD COUNTY

ELLICOTT CITY

750 GALLON TANK

DISTRICT 2

DATE 4-20-59

375 SQ FT BOTTOM AREA IN TILE FIELD

PLACE SOME LINES ABOUT 60' FROM BRINKLEIGH LOT
AND 100 - 160 FROM THE ROAD

TO: THE COUNTY HEALTH OFFICER
ELLICOTT CITY, MARYLAND

I, HEREBY, APPLY FOR THE NECESSARY TESTS IN ORDER TO CONSTRUCT (OR RECONSTRUCT) A SEWAGE DISPOSAL SYSTEM.

PROPERTY OWNER John W. Boone

ADDRESS St. Johns Lane, Ellicott City PHONE E.C. 2197 J

PROPERTY LOCATION:

SUBDIVISION _____ LOT NO. _____

ROAD AND DESCRIPTION St. John's Lane - rd. lot next to Brinkleigh Manor
nr. Noel Dr. - Mr. Boone will meet sanitarian on rd. across from school.

OCCUPANT _____ PHONE _____

PERSON TO CONSTRUCT SYSTEM _____

ADDRESS _____ PHONE _____

SIZE OF LOT 1 1/2 acre TYPE BLDG. 5 NUMBER OF BEDROOMS _____

IF NOT SINGLE RESIDENCE DESCRIBE _____

SIGNATURE OF APPLICANT _____

APPROVED BY Raymond Hodges FOR Tile Field (KIND OF SYSTEM)

DATE 4/22/59


REJECTED BY _____ FOR _____ (KIND OF SYSTEM)

DATE _____

HOLD PENDING FURTHER TESTS _____ DATE _____

REASONS FOR REJECTION OR HOLDING 7/23/59 - Failed to keep appointment

THIS IS NOT A PERMIT

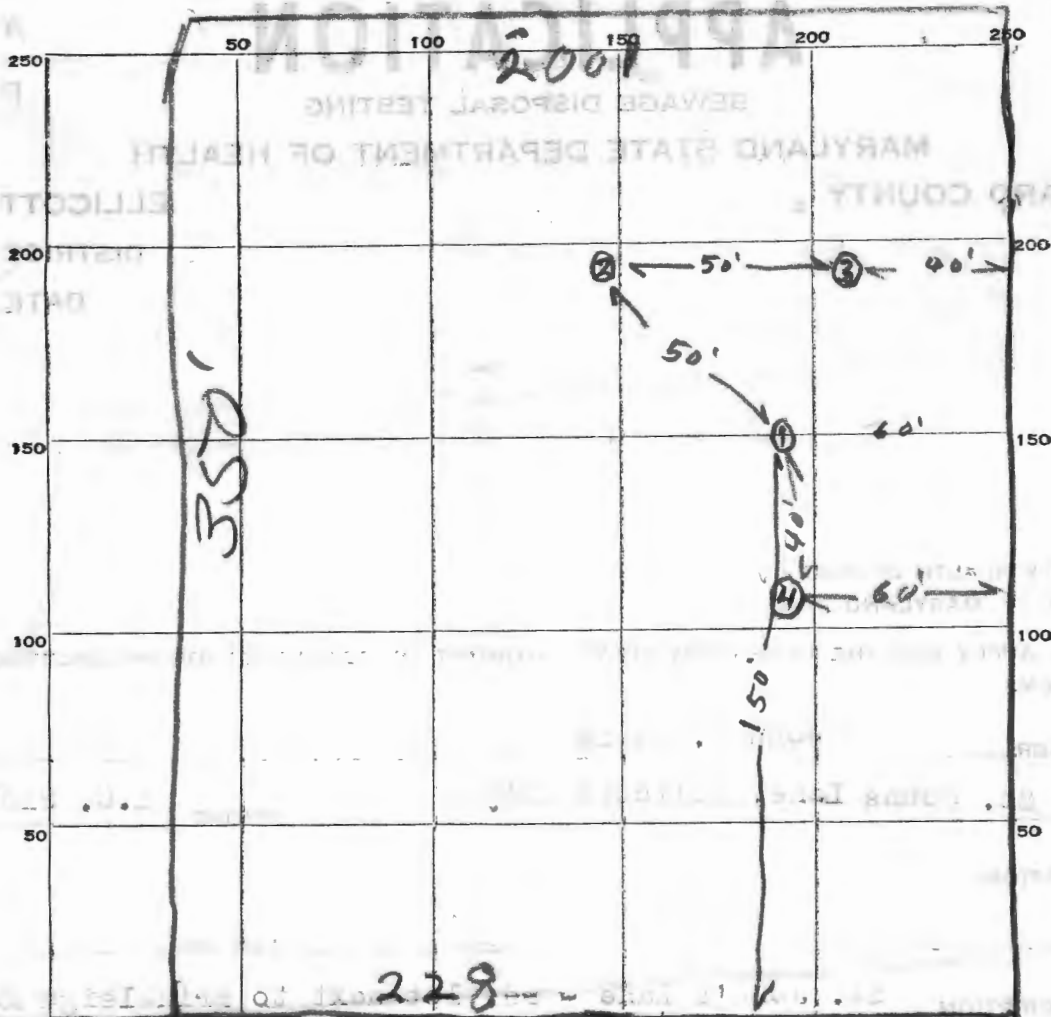

INDICATE NORTH. - NAME ADJOINING ROADWAY AS BASE LINE.

ST. JOHN'S LANE

DATE	TEST NO.	DEPTH	PRE-WET		TEST - 1" DROP		TIME
			START	STOP	START	STOP	
4/22/59	1	3'	1:08	1:13	1:13	1:21	8 min
4/22/59	2	3'	1:10	1:48	38 min	1/4"	
4/22/59	3	3'	1:12	1:50	38 min	no perc.	
4/22/59	4	3'	1:36	1:40	1:40	1:45	5 min

SOIL AUGER FINDING

TESTED BY

Raymond Hodges

REMARKS

ALSO PRESENT

William A. Brown

LOT NO.

STATE OF MARYLAND

HOWARD COUNTY HEALTH DEPARTMENT ELLICOTT CITY, MARYLAND

Date

4-20-

19

Name

John Barnes

Telephone No.

636-2197

DETAILED LOCATION OF SITE, DEVELOPMENT
SECTION, ROAD, LOT NO. & ELECTION DISTRICT

St. Johns Lane 2nd
across from St. Johns E. School

PRIVATE SEWAGE DISPOSAL SYSTEMS

Testing and Inspection

\$

10.00

Installation Permit

\$

Received
Payment

John Barnes

400782

DUPLICATE

THIS RECEIPT IS NOT
A PERMIT AND IT IS
NOT A WARRANTY OF
PERFORMANCE OF
THE SYSTEM THAT
IS INSTALLED

PERMIT

SEWAGE DISPOSAL SYSTEM

MARYLAND STATE DEPARTMENT OF HEALTH

HOWARD COUNTY

ELLICOTT CITY

DISTRICT 2

DATE _____

IS PERMITTED TO INSTALL _____ ALTER _____

ADDRESS _____

PHONE _____

A SEWAGE DISPOSAL-SYSTEM LOCATED AT St. John's Lane - lot next to Brinkleigh Manor
nr. Noel Drive.

SUBDIVISION _____

ROAD _____

LOT _____

PROPERTY OWNER Boone, John W.

ADDRESS St. John's Lane, Ellicott City

SPECIFICATIONS

DRAIN FIELD I DEPTH 3 FEET, BOTTOM AREA 375 SQ. FT.

SEEPAGE PITS _____ ABSORBENT SIDE-WALL AREA _____ SQ. FT.

SEPTIC TANK CAPACITY 750 GALLONS

FOR GARBAGE GRINDER, INCREASE DISPOSAL AREA 22% & TANK CAPACITY 50%.

OTHER Place some lines about 60 ft. from Brinkleighs lot and 100 - 160 feet
from the road.

PLANS APPROVED BY Raymond Hodges

DATE

4/22/59

FILL SEPTIC TANK AND DISTRIBUTION BOX WITH WATER BEFORE CALLING FOR AN INSPECTION. COVER NO WORK UNTIL INSPECTED AND APPROVED.

NEITHER THE HOWARD COUNTY COMMISSIONERS NOR THE HEALTH DEPARTMENT IS RESPONSIBLE FOR THE SUCCESSFUL OPERATION OF ANY SYSTEM.