

APPLICATION

SEWAGE DISPOSAL TESTING

A 02191

P _____

MARYLAND STATE DEPARTMENT OF HEALTH

HOWARD COUNTY

ELLICOTT CITY

DISTRICT 2nd.

DATE 2/27/60

3 dry wells 10 ft in dia and 12 ft deep below the inlet. Locate dry wells on hill above slaughter house, approximately 195 ft from the road and at least 15 ft off the right side property line. Connect dry wells in a series with no distribution box.

TO: THE COUNTY HEALTH OFFICER
ELLICOTT CITY, MARYLAND

I, HEREBY, APPLY FOR THE
DISPOSAL SYSTEM.

Install a 750 gal. grease trap on building sewer close to building approximately 5 to 10 ft from building. Effluent must reach grease trap before entering septic tank.

PROPERTY OWNER

Howard County Meat Mart

ADDRESS

Ellicott City

PHONE

158 E.C.

PROPERTY LOCATION:

SUBDIVISION

LOT NO.

ROAD AND DESCRIPTION

3rd. lot from St. John Lane near freezer locker

OCCUPANT

PHONE

PERSON TO CONSTRUCT SYSTEM

ADDRESS

PHONE

SIZE OF LOT

125 X 150

TYPE BLDG.

commercial bldg. 4 emp.

NUMBER OF BEDROOMS

IF NOT SINGLE RESIDENCE DESCRIBE

SIGNATURE OF APPLICANT

Kenneth R. Neek

APPROVED BY

James Henneigan

FOR

Tile Field

(KIND OF SYSTEM)

DATE

4-29-60

REJECTED BY

FOR

(KIND OF SYSTEM)

DATE


HOLD PENDING FURTHER TESTS

DATE

REASONS FOR REJECTION OR HOLDING

THIS IS NOT A PERMIT

000

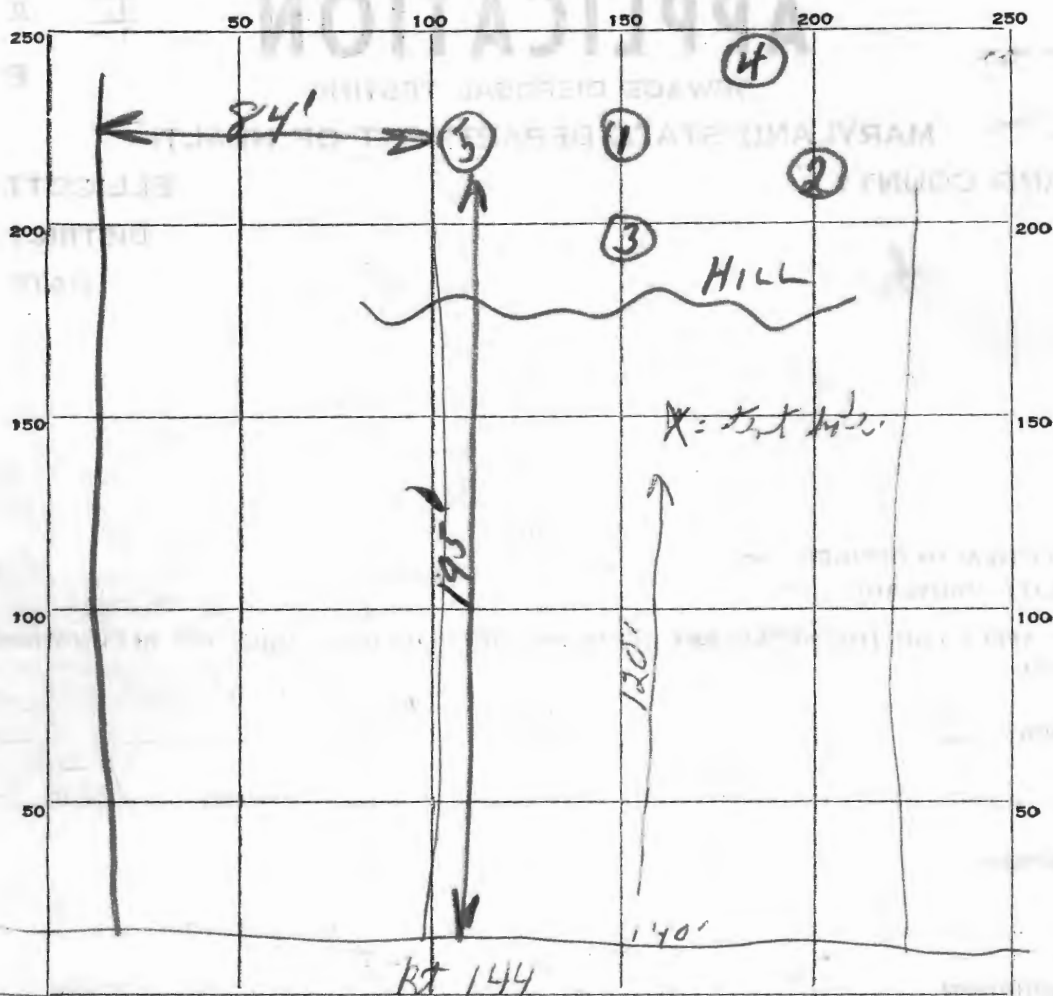

75-28
12/5

DATE	TEST NO.	DEPTH	PRE-WET		TEST - 1" DROP		TIME
			START	STOP	START	STOP	
3/1/60	1#	8'-9"	1:25	1:39	1:39	2:30	stopped - 1/2" up to ground
4-29-60	1	9FT	9:36	9:45	9:45	10:07	22 Min. 2nd punch
	2	3FT	9:37	10:00	10:00	10:28	28 Min.
	3		9:38	9:48	10:00	10:05	11 55 Min.
	4		9:41	9:47	9:47	9:59	12 Min.
	5		10:30	10:34	10:34	10:41	7 Min.

SOIL AUGER FINDING sand - tight - front of 2nd wet

TESTED BY Wine (8' to be graded off top of test hole location)

REMARKS 4-29-60 RR neck

ALSO PRESENT RR neck LOT NO. +