

*Prel.*

# APPLICATION

SEWAGE DISPOSAL TESTING

STATE OF MARYLAND - DEPARTMENT OF HEALTH AND MENTAL HYGIENE

HOWARD COUNTY HEALTH DEPARTMENT  
ENVIRONMENTAL HEALTH SERVICES

P. O. BOX 473 ELLICOTT CITY, MARYLAND 21043  
TELEPHONE: 992-2330

A 3/31/8

P \_\_\_\_\_

DISTRICT 2<sup>ND</sup>

DATE 3-31-81

TO: THE COUNTY HEALTH OFFICER  
ELLICOTT CITY, MARYLAND

I, HEREBY, APPLY FOR THE NECESSARY TEST IN ORDER TO CONSTRUCT (OR RECONSTRUCT) A SEWAGE DISPOSAL SYSTEM.

PROPERTY OWNER THOMAS M. + LINDA A. MUKA

ADDRESS 9639 SEA SHADOW COLUMBIA MD 21046 PHONE 776-7678

PROP. REP CHUCK KERESZTURI Realtor @ cit 4/30/81

PROPERTY LOCATION:

SUBDIVISION ST. JOHN'S VILLAGE LOT NO. 14, Block A

ROAD AND DESCRIPTION DUNLOGGON COURT TO PRIVATE DRIVE

SIZE OF LOT 1.47 ACRES TYPE BLDG. RESIDENCE - 3 or 4 bedroom  
(NUMBER OF BEDROOMS)

THE SYSTEM INSTALLED UNDER THIS APPLICATION IS ACCEPTABLE ONLY UNTIL PUBLIC FACILITIES BECOME AVAILABLE. I FULLY UNDERSTAND THE  
FEE CONNECTED WITH THE FILING OF THIS PERC TEST APPLICATION IS NON-REFUNDABLE UNDER ANY CIRCUMSTANCES. I ALSO AGREE TO COMPLY

WITH ALL M.O.S.H.A. REQUIREMENTS IN TESTING THIS LOT. [Signature]  
(SIGNATURE OF APPLICANT)

APPROVED BY \_\_\_\_\_ FOR \_\_\_\_\_ DATE \_\_\_\_\_

REJECTED BY \_\_\_\_\_ FOR \_\_\_\_\_ DATE \_\_\_\_\_

HOLD PENDING FURTHER TESTS C.B. Stueker DATE 4/30/81

REASONS FOR REJECTION OR HOLDING 4/30/81 SOUTH CARROLL EQUIPMENT AT SITE;

HOLD PUBLIC WATER + SEWER TO ADJACENT PROP. 904  
DUNLOGGON COURT; FOR SEWER MORTGOREUM - HOLD.  
LIGHT RAIN + INHOLE WATER @ SEEPING OUT OF SIDEWALL; HOLD  
FOR MORE TESTS IN WET SEASON POSSIBLY. C.B. + PLAT WITH HOUSE  
SITE SHOWN + B.R. LINES, C.B. discussed briefly with Frank Skinner 4/30/81  
C.B.S.

# THIS IS NOT A PERMIT



Pres.

# APPLICATION

SEWAGE DISPOSAL TESTING

STATE OF MARYLAND - DEPARTMENT OF HEALTH AND MENTAL HYGIENE

HOWARD COUNTY HEALTH DEPARTMENT  
ENVIRONMENTAL HEALTH SERVICES

P. O. BOX 473, ELLICOTT CITY, MARYLAND 21043  
TELEPHONE: 992-2330

A 3/3/8

P \_\_\_\_\_

DISTRICT 2nd

DATE 3-31-81

APR 8 9 54 AM '81  
ELLICOTT CITY  
HOWARD COUNTY  
DEPARTMENT OF HEALTH AND MENTAL HYGIENE

TO: THE COUNTY HEALTH OFFICER  
ELLICOTT CITY, MARYLAND

I, HEREBY, APPLY FOR THE NECESSARY TEST IN ORDER TO CONSTRUCT (OR RECONSTRUCT) A SEWAGE DISPOSAL SYSTEM.

PROPERTY OWNER Thomas M. + Linda D. Munk

ADDRESS 9639 SEA SHADOW PHONE 776-7678

PROPERTY LOCATION:

SUBDIVISION St. John's Village LOT NO. 14, Block D

ROAD AND DESCRIPTION DUNLOGAN COURT & PRIVATE DRIVE

SIZE OF LOT 1.47 ACRES TYPE BLDG. RESIDENCE - 3rd  
(NUMBER OF BEDROOMS)

THE SYSTEM INSTALLED UNDER THIS APPLICATION IS ACCEPTABLE ONLY UNTIL PUBLIC FACILITIES BECOME AVAILABLE. I FULLY UNDERSTAND THE FEE CONNECTED WITH THE FILING OF THIS PERC TEST APPLICATION IS NON-REFUNDABLE UNDER ANY CIRCUMSTANCES. I ALSO AGREE TO COMPLY WITH ALL M.O.S.H.A. REQUIREMENTS IN TESTING THIS LOT.

(SIGNATURE OF APPLICANT)

APPROVED BY \_\_\_\_\_ FOR \_\_\_\_\_ DATE \_\_\_\_\_


REJECTED BY \_\_\_\_\_ FOR \_\_\_\_\_ DATE \_\_\_\_\_

HOLD PENDING FURTHER TESTS \_\_\_\_\_ DATE \_\_\_\_\_

REASONS FOR REJECTION OR HOLDING \_\_\_\_\_

## THIS IS NOT A PERMIT

FIELD SHEET

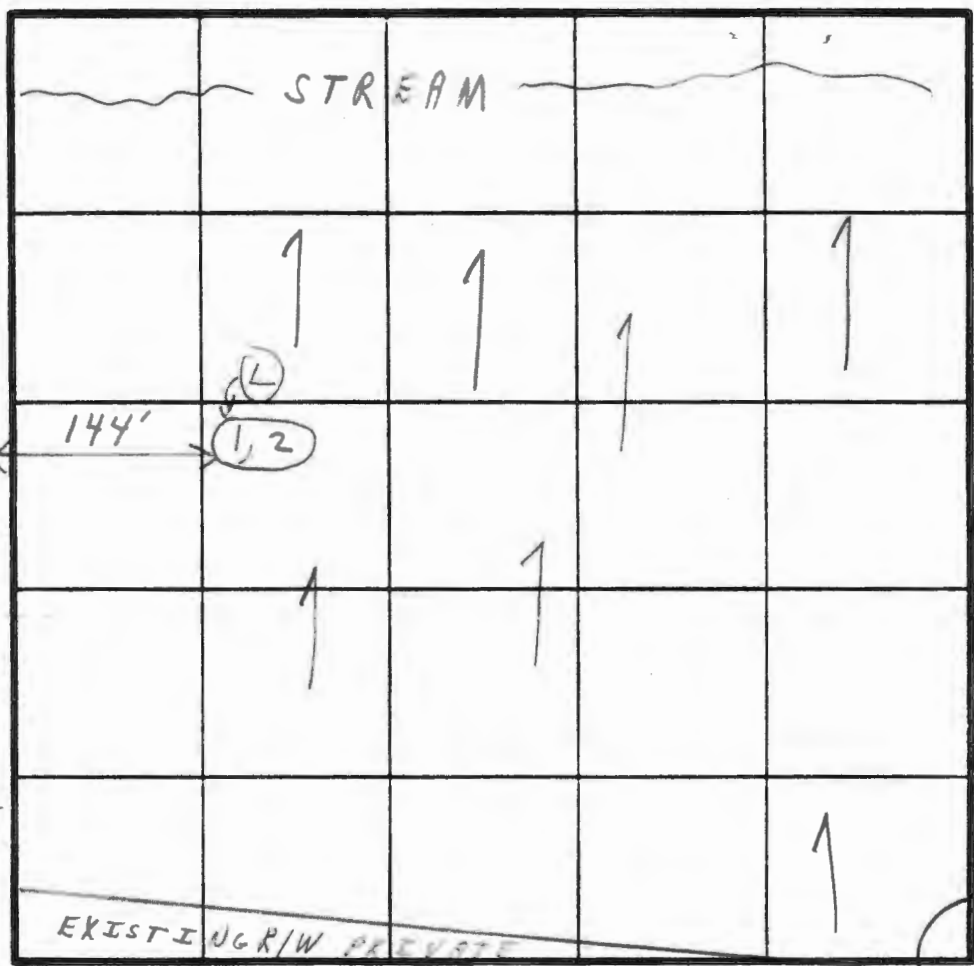

CUL DE  
SAC.

INDICATE NORTH - NAME ADJOINING ROADWAY AS BASE LINE. *DRIVE*

[illegible]

REMARKS

TYPE OF SOIL

TESTED BY

ALSO PRESENT

~~KELLY-DICKER~~  
KENNYSCHISSLER  
CHUCK KERESZTHAI  
PROP. REP.

LIGHT RAIN


FIELD SHEET FOR 14D OFF DUNLOGGIN COURT  
ST. JOHN'S VILLAGE

1'-4" 1  
CR 4'  
4'-11' ② 11'  
Sandy 10-110  
Dark  
Mottled


1"	2"	3"
10:03	10:08	10:39

(1/2" - 3/4" @ most)  
{ 9' sleep bags out of schedule }  
{ Hold for wet season }  
{ 1/2" redesign }

Machine leaking oil  
Paul Schiller co. Keny  
Backhoe Operator

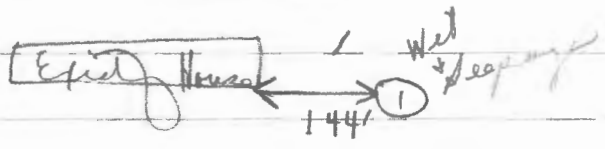

97  
47  
144'

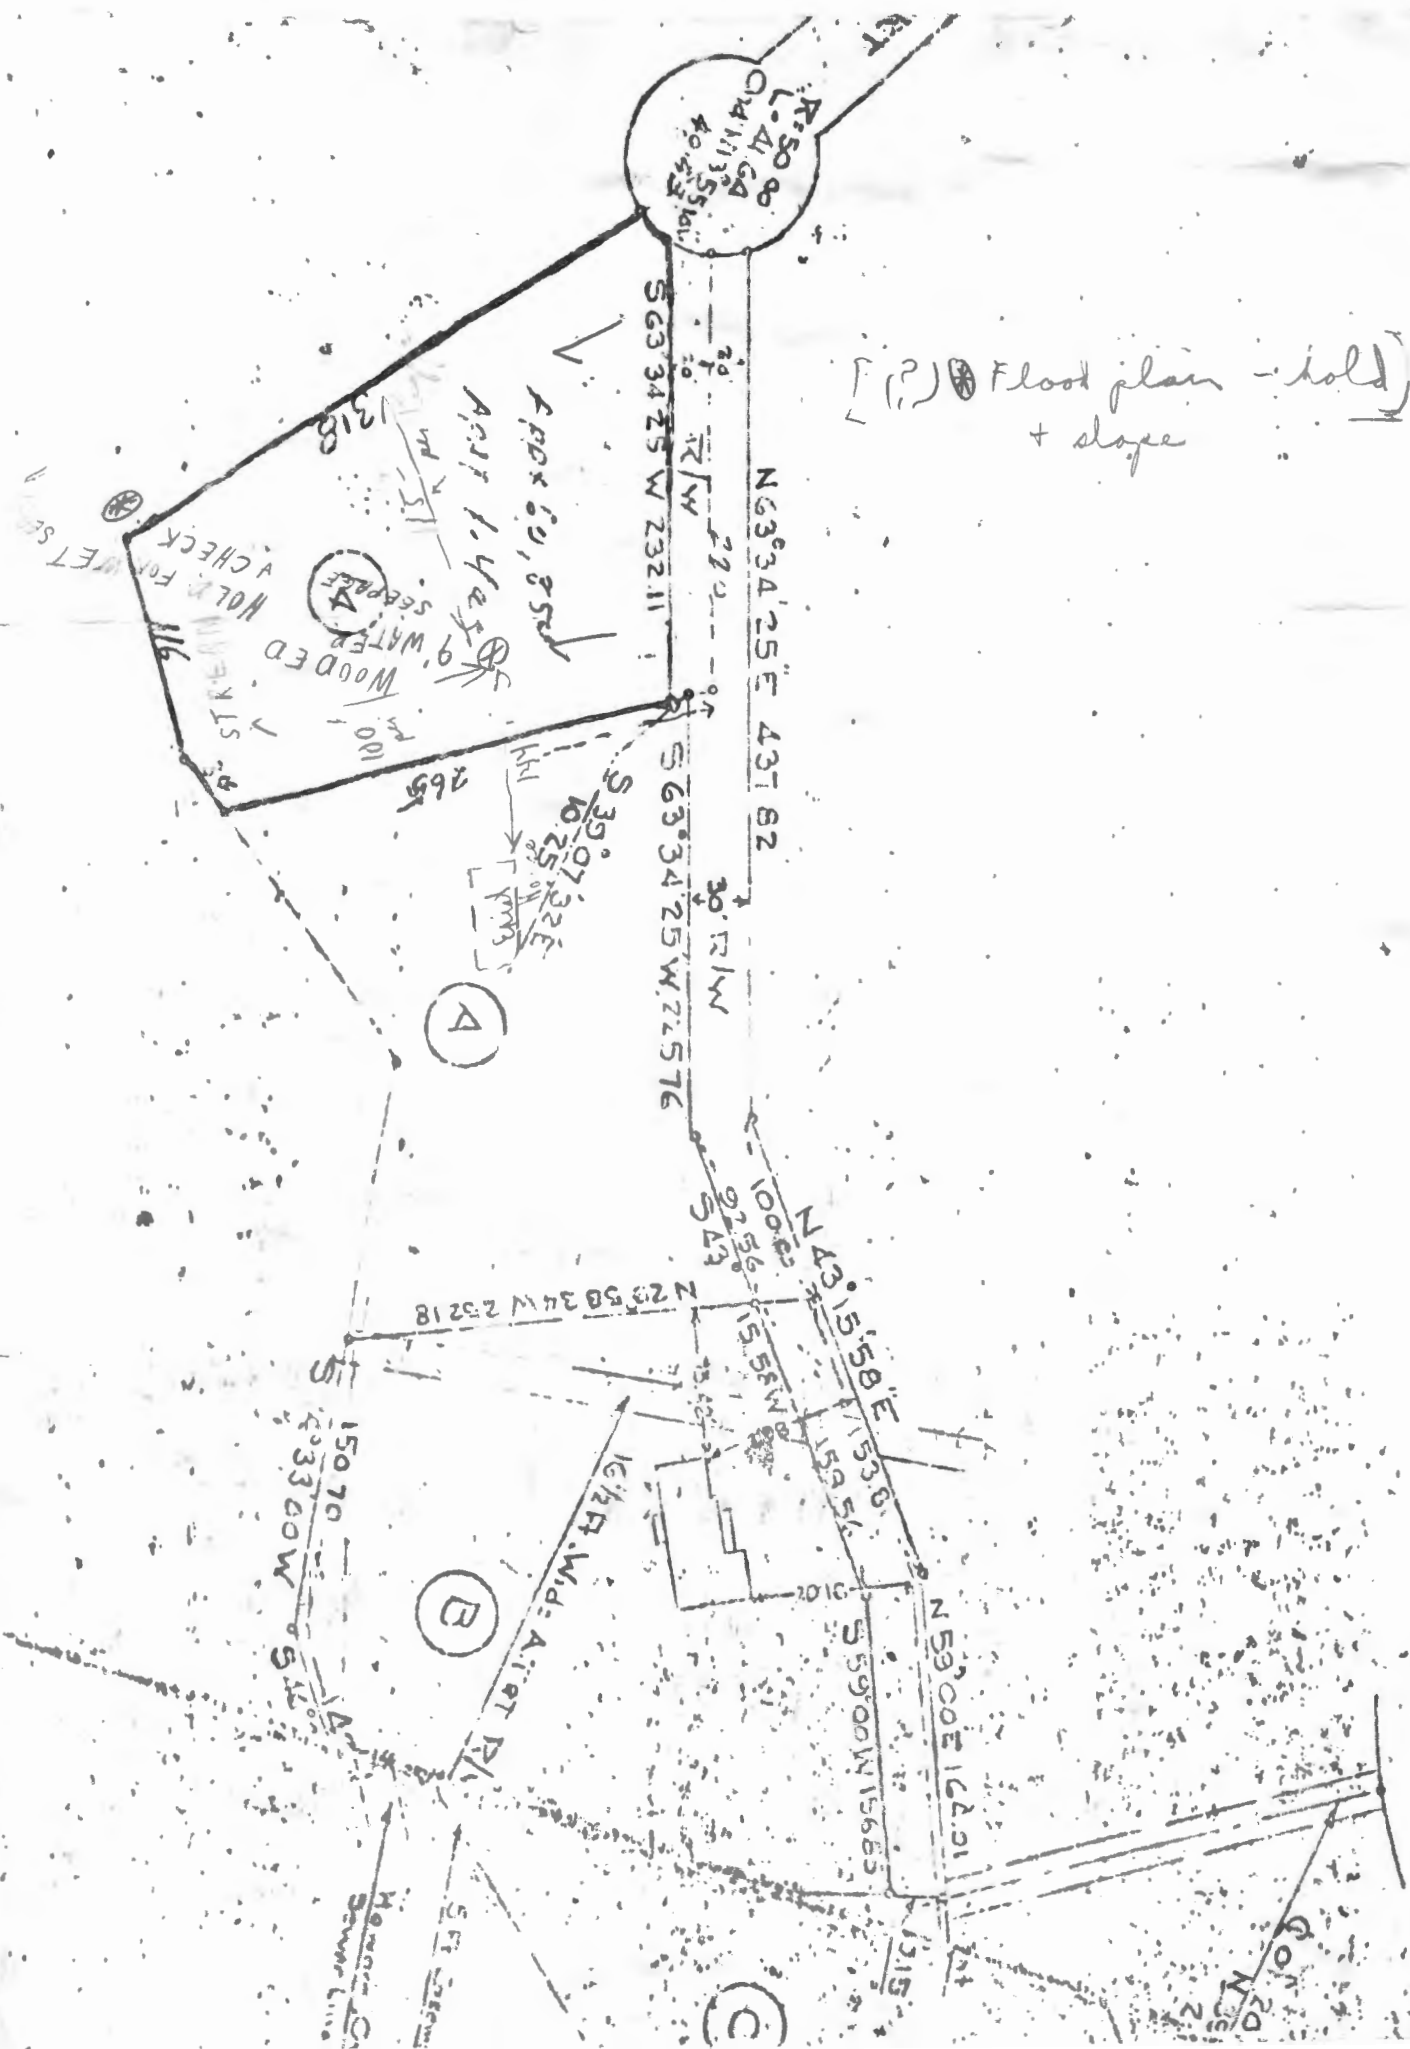

N



112500  
112500  
112500