


BOUNDARY SURVEY 3.000 ACR- PARCEL
 PROPERTY TO CONVEYED TO KENNETH L. JOHNSON & WIFE
 3RD ELECTION DISTRICT HOWARD COUNTY, MARYLAND

JANUARY 5, 1972

SCALE 1"=100'

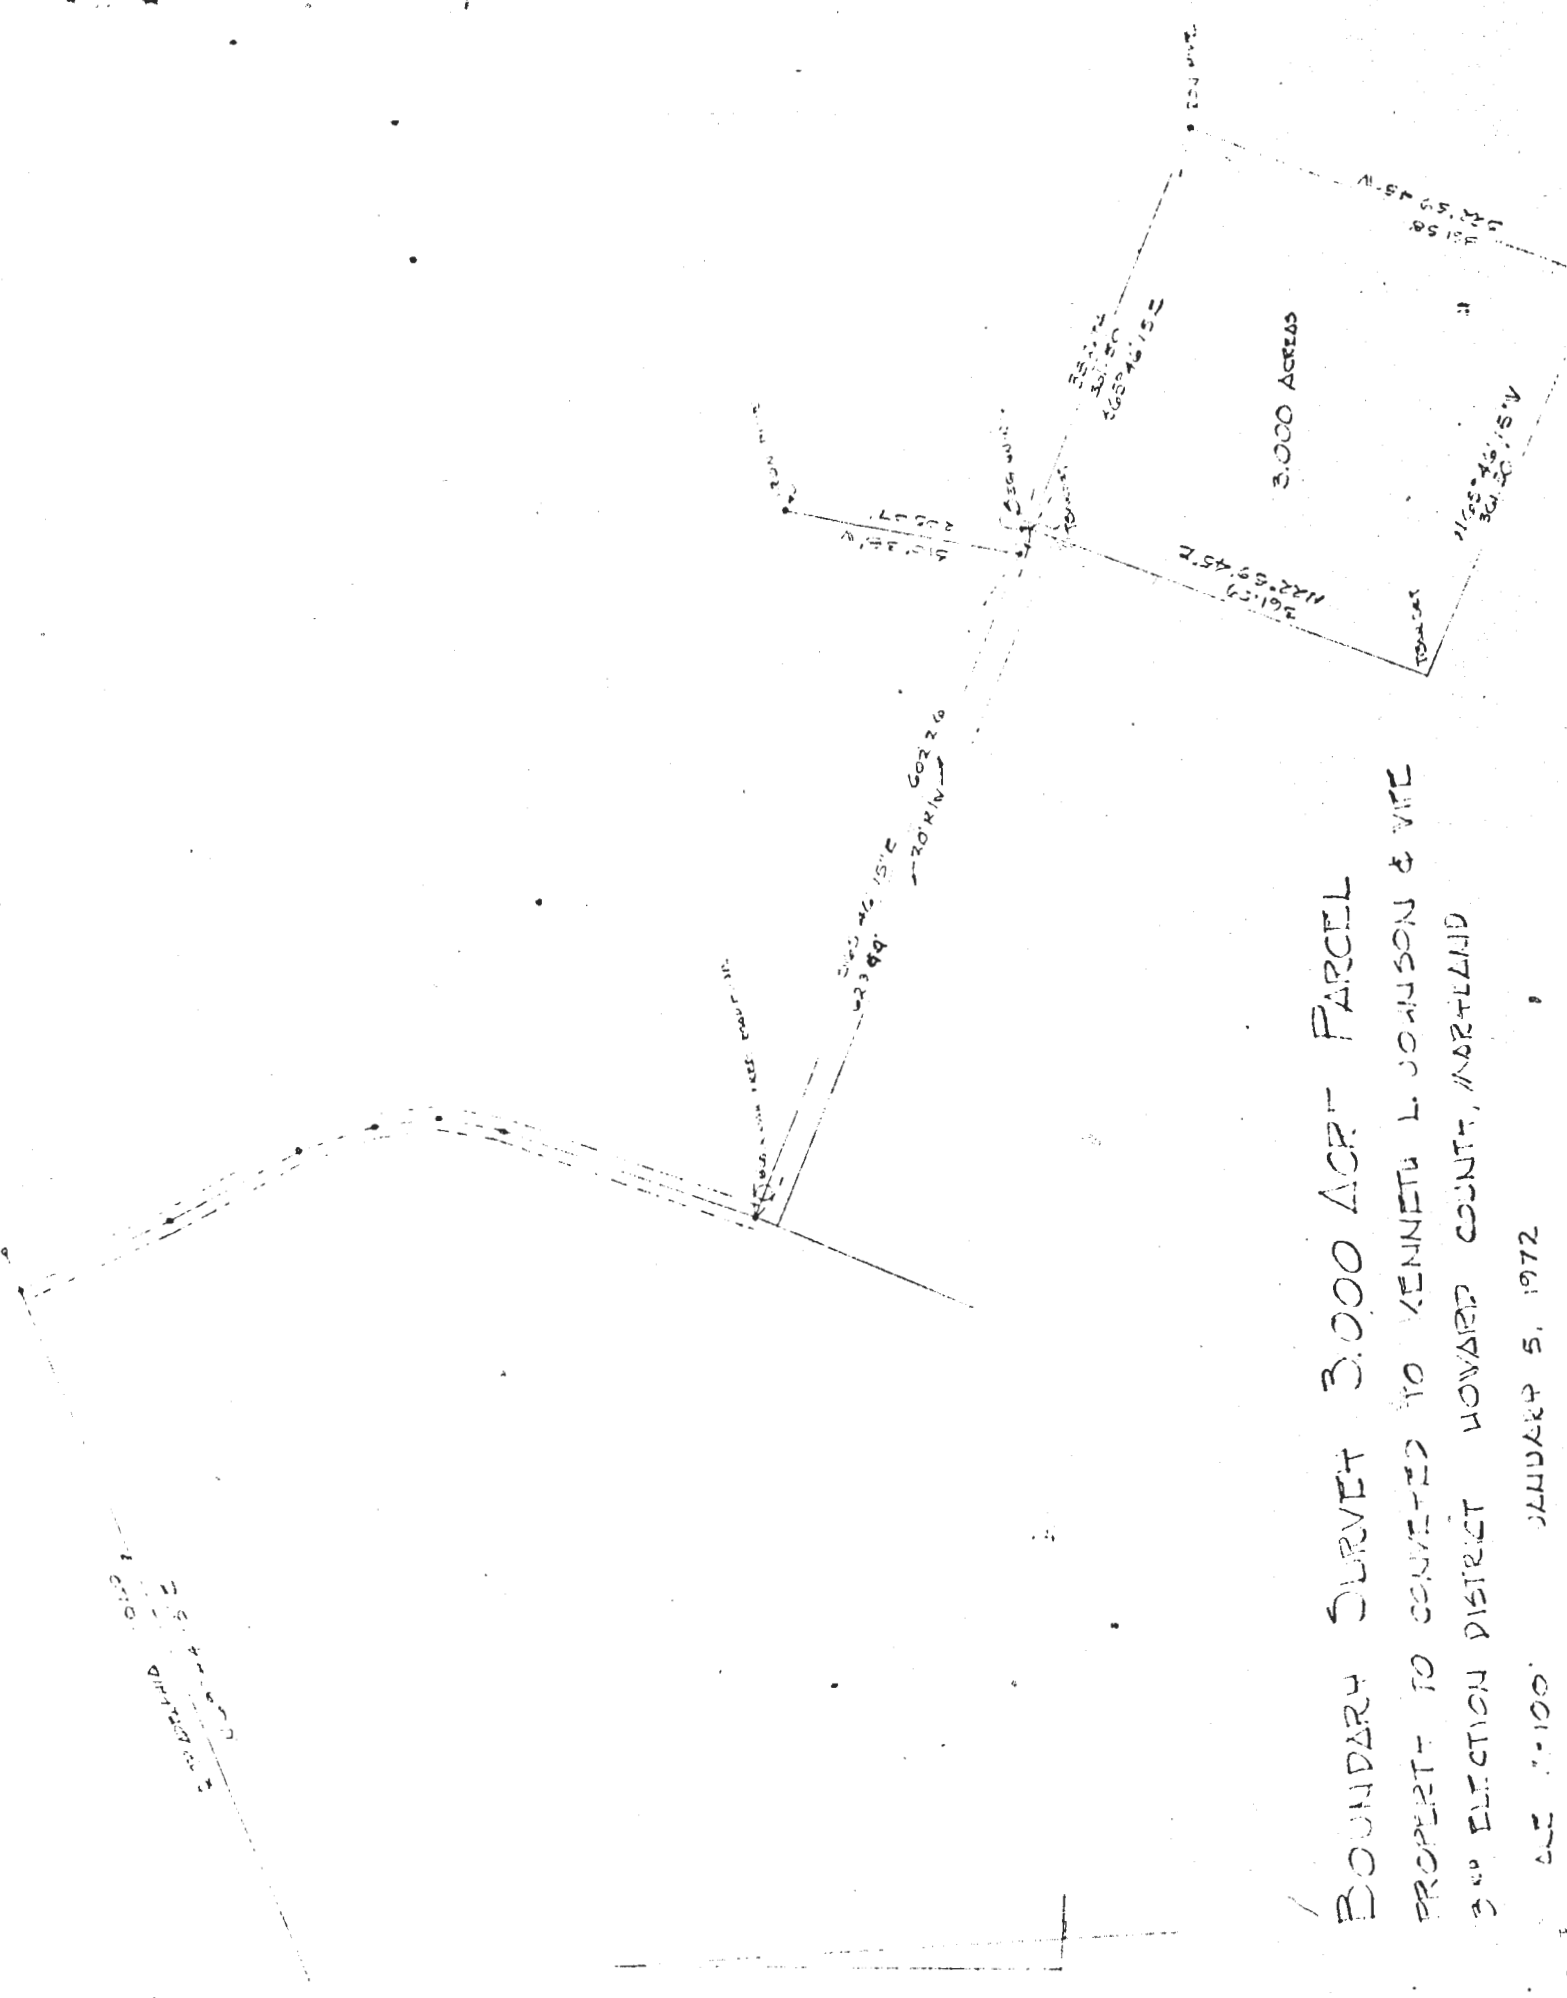

APPLICATION

A 19088

SEWAGE DISPOSAL TESTING

P _____

STATE OF MARYLAND - DEPARTMENT OF HEALTH AND MENTAL HYGIENE

HOWARD COUNTY HEALTH DEPARTMENT
ENVIRONMENTAL HEALTH SERVICES

125 23rd St

DISTRICT 3rd

P. O. BOX 476, ELLICOTT CITY, MARYLAND 21043
TELEPHONE: 465-8000, EXT. 356

DATE 10/23/73

17. my well - 300 sq ft sidewall area below the top
5 1/2 FT Clay Inlet to Dry Well to be no deeper
than 5 1/2 FT and bottom of Dry Well to be
no deeper than 12 FT

Place the dry well 9' from the front lot line
and 120 FT from the left side of the
lot as seen when facing the
lot from the front lot line

TO: THE COUNTY HEALTH OFFICER
ELLICOTT CITY, MARYLAND

I, HEREBY, APPLY FOR THE NECESSARY TEST IN ORDER TO CONSTRUCT (OR RECONSTRUCT) A SEWAGE
DISPOSAL SYSTEM.

PROPERTY OWNER Kenneth L. Johnson & wife

ADDRESS 2903 Woodland Avenue, Balto., Md. 21215

PHONE 542-1503

office - 426-0920

727

PROPERTY LOCATION:

SUBDIVISION _____ LOT NO. _____

ROAD AND DESCRIPTION 11799 Triadelphia Road - adjacent to the Hacienda Riding Stable

SIZE OF LOT 3 acres

TYPE BLDG. 4 bedrooms

NUMBER OF BEDROOMS

IF NOT SINGLE RESIDENCE DESCRIBE _____

THE SYSTEM INSTALLED UNDER THIS APPLICATION IS ACCEPTABLE ONLY UNTIL PUBLIC
FACILITIES BECOME AVAILABLE.

SIGNATURE OF APPLICANT Kenneth L. Johnson

APPROVED BY Raymond Dodge

FOR Dry Well

DATE 11/14/73

(KIND OF SYSTEM)

REJECTED BY _____

FOR _____

DATE _____

(KIND OF SYSTEM)

HOLD PENDING FURTHER TESTS _____

DATE _____

REASONS FOR REJECTION OR HOLDING _____

THIS IS NOT A PERMIT

RECORDED

APPLICATION

A 19088

P _____

SEWAGE DISPOSAL TESTING

STATE OF MARYLAND - DEPARTMENT OF HEALTH AND MENTAL HYGIENE

HOWARD COUNTY HEALTH DEPARTMENT
ENVIRONMENTAL HEALTH SERVICES

P. O. BOX 476, ELLICOTT CITY, MARYLAND 21043
TELEPHONE: 465-8000, EXT. 356

DISTRICT 3rd

DATE 10/23/73

TO: THE COUNTY HEALTH OFFICER
ELLICOTT CITY, MARYLAND

I, HEREBY, APPLY FOR THE NECESSARY TEST IN ORDER TO CONSTRUCT (OR RECONSTRUCT) A SEWAGE DISPOSAL SYSTEM.

PROPERTY OWNER Kenneth L. Johnson & wife

ADDRESS 2903 Woodland Avenue, Balto., Md. 21215 PHONE 542-1503

office - 542-0920
727

PROPERTY LOCATION:

SUBDIVISION _____ LOT NO. _____

ROAD AND DESCRIPTION 11799 Triadelphia Road - adjacent to the Hacienda Riding Stable

SIZE OF LOT 3 acres TYPE BLDG. 4 bedrooms

NUMBER OF BEDROOMS

IF NOT SINGLE RESIDENCE DESCRIBE _____

THE SYSTEM INSTALLED UNDER THIS APPLICATION IS ACCEPTABLE ONLY UNTIL PUBLIC FACILITIES BECOME AVAILABLE.

SIGNATURE OF APPLICANT Kenneth L. Johnson


APPROVED BY _____ FOR _____ DATE _____
(KIND OF SYSTEM)

REJECTED BY _____ FOR _____ DATE _____
(KIND OF SYSTEM)

HOLD PENDING FURTHER TESTS _____ DATE _____

REASONS FOR REJECTION OR HOLDING _____

THIS IS NOT A PERMIT

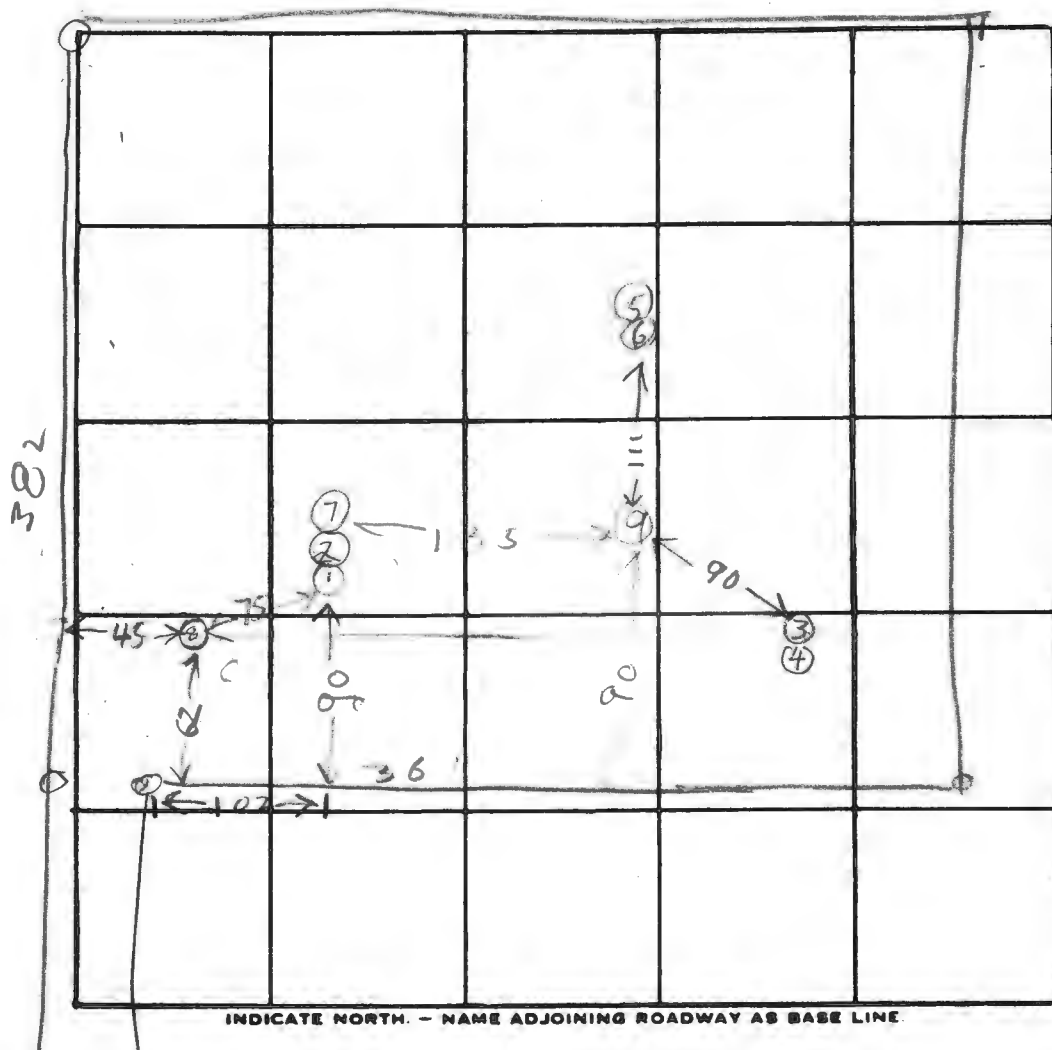

DATE	TEST NO.	DEPTH	PRE-WET		TEST - 1" DROP		TIME
			START	STOP	START	STOP	
11/14/65	1	4 1/2	1029	1048	1048	1115	39
	2	12	1030	1034	1034	1035	4
	3	10 1/2	UNDER 100 LBS. P. TEST 11				
		10 1/2	F 7 FROM GROUND				
	4	5	1115	1117	1117	1122	5
	5	11 1/2	1134	1140	1140	1050	10
	6	4 1/2	1137	1150	1250	1204	14
	7	6	1148	1155	1155	1204	9
	8	11 1/2	TOP 4 FT CLAY BOT 7 1/2 FT SANDY DRY				
11/14/70	9	11	TOP 5 FT CLAY BOT 6 FT SANDY DRY				

REMARKS

TYPE OF SOIL

Retco Engineering Company, Inc.

507 KEYSER BUILDING

BALTIMORE, MARYLAND 21202

TELEPHONE 539-6790

Description

3.000 Acre Parcel to be conveyed to Kenneth L. Johnson and wife, 3rd Election District, Howard County, Maryland.

Beginning for the same at a point 623.44 feet from the beginning of the 1st or South 66 degrees 20 minutes East 985 foot line of a deed from Evergreen Valley Corporation to Joseph F. Stetka and recorded among the Land Records of Howard County in Liber 452 folio 577 running thence binding on said 1st line to the end thereof and part of the 2nd line or South 22 degrees 24 minutes East 500.00 foot line as now surveyed 1) South 65 degrees 46 minutes 15 seconds East 361.50 feet to a "T" bar now set 2) South 22 degrees 59 minutes 45 seconds West 361.58 feet to a "T" bar now set thence leaving said 2nd line for new lines of division the two following courses and distances 3) North 65 degrees 46 minutes 15 seconds West 361.50 feet to a "T" bar now set and 4) North 22 degrees 59 minutes 45 seconds East 361.58 feet to the place of beginning.

Containing 3.000 Acres of land $\pm$.

Together with the use thereof a right-of-way 20 feet wide southwesterly of the 1st or South 66 degrees 20 minutes East 985 foot line in the aforementioned deed to Stetka, Jr. extending 623.50 feet from the beginning thereof.

TO HOWARD COUNTY MARYLAND
AND STATE OF MARYLAND DR.

REAL ESTATE TAX LEVY
JULY 1, 1972 TO JUNE 30, 1973

INDEX NUMBER
31 J0070000

COUNTY TAX	FIRE TAX	STATE TAX	AD VALOREM	FRONT FT. WATER	FRONT FT. SEWER	TOTAL TAX DUE
396.28	5.76	30.26				432.30
LAND	BUILDING	TOTAL ASSESSMENT	CODES	ELDERLY OR ALLOWED	SCHOOL TAX	DISCOUNT-INTEREST
10270	4140	14410	A B E G		200.11	
DISCOUNT ON COUNTY TAX ONLY						COST OF SALE
22531						TOTAL

SEE ENCLOSED STATEMENT FOR RATES
SCHEDULE OF INTEREST AND DISCOUNT ON
REVERSE SIDE OF THIS COPY

MAKE ALL CHECKS PAYABLE TO
DIRECTOR OF FINANCE OF HOWARD COUNTY

FAILURE TO RECEIVE A BILL IS NO EXCUSE FOR
NOT PAYING TAXES, INTEREST AND PENALTY



DIRECTOR OF FINANCE
COPY

THIS COPY MUST AC-
COMPANY PAYMENT IN-
CLUDE TAXPAYER'S
COPY IF RECEIPT IS DE-
SIRED. IF PAID BY LEND-
ING AGENCY MAIL BOTH
COPIES TO THEM.

JOHNSON KENNETH L & WF

2903 WOODLAND AVE
BALTIMORE MD 21215

11411 A & IMP
11799 TRIADDELPHIA RD
ELICOTT CITY

Retco Engineering Company, Inc.

507 KEYSER BUILDING

BALTIMORE, MARYLAND 21202

TELEPHONE 539-6790

Being a part of the property conveyed for Evergreen Valley Corporation to Joseph F. Stetka, Jr. and recorded in the Land Records of Howard County in Liber 452 folio 577.

-2-

Job No. 711238
January 5, 1972

dah/RMHSr.

