

RECORDED
Liber 680
Folio 12

APPLICATION

A 27519

P _____

SEWAGE DISPOSAL TESTING

STATE OF MARYLAND - DEPARTMENT OF HEALTH AND MENTAL HYGIENE

HOWARD COUNTY HEALTH DEPARTMENT
ENVIRONMENTAL HEALTH SERVICES

P. O. BOX 476, ELLICOTT CITY, MARYLAND 21043
TELEPHONE: 465-5000, EXT. 356

DISTRICT 4th

DATE 2/3/78

*specs on other
page*

TO: THE COUNTY HEALTH OFFICER
ELLICOTT CITY, MARYLAND

I, HEREBY, APPLY FOR THE NECESSARY TEST IN ORDER TO CONSTRUCT (OR RECONSTRUCT) A SEWAGE
DISPOSAL SYSTEM. *NAME CHANGE*

PROPERTY OWNER Claudia Miller DORSET 489-4634
Allen Mitchell
442-2920

ADDRESS 1633 FRED RD PHONE _____

PROPERTY LOCATION: WOODBINE 21797

SUBDIVISION Stanley Miller property LOT NO. LOT 19

ROAD AND DESCRIPTION Route 144

SIZE OF LOT 1 acre 1.50 ac TYPE BLDG. 3 or 4 bedrooms
NUMBER OF BEDROOMS _____

IF NOT SINGLE RESIDENCE DESCRIBE _____

THE SYSTEM INSTALLED UNDER THIS APPLICATION IS ACCEPTABLE ONLY UNTIL PUBLIC
FACILITIES BECOME AVAILABLE.

SIGNATURE OF APPLICANT _____

APPROVED BY Raymond Hodges FOR DRY WELL DATE 3/7/78
(KIND OF SYSTEM)

REJECTED BY _____ FOR _____ DATE _____
(KIND OF SYSTEM)

HOLD PENDING FURTHER TESTS _____ DATE _____

REASONS FOR REJECTION OR HOLDING 2/9/78 Dig more RH 2/10/78 Per OK
Hold for Certificate Holder RH 3/1/78 - OK For Mr Boyer
to sign Per

THIS IS NOT A PERMIT

STANLEY MILLER PROP

SEPTIC TANK: 3 BEDROOM, 1000 GALLON

LOT 19

4 BEDROOM, 1250 GALLON

ROUTE 144

DRY WELL TO HAVE 120 SQUARE FEET OF SIDEWALL AREA PER BEDROOM.

DRY WELL INLET TO BE max. 6 FEET BELOW ORIGINAL GRADE.

DRY WELL BOTTOM (MAXIMUM DEPTH) TO BE 12 FEET BELOW ORIGINAL GRADE.

PLACE THE DRY WELL 178 FEET FROM THE BACK LOT LINE AND 103 FEET FROM THE LEFT LOT LINE AS SEEN WHEN FACING THE LOT FROM THE ~~ROAD~~


FRONT LOT LINE

NOTE THE BACK LOT LINE

IS 201.78' LONG AND RUNS
N 32° 46' 12" E THE LEFT

LOT LINE IS 302.68 FT LONG
& RUNS N 64° 51' 12" W

Note: The lot shown hereon complies with minimum ownership width and lot area as required by the Maryland State Department of Health and Mental Hygiene.

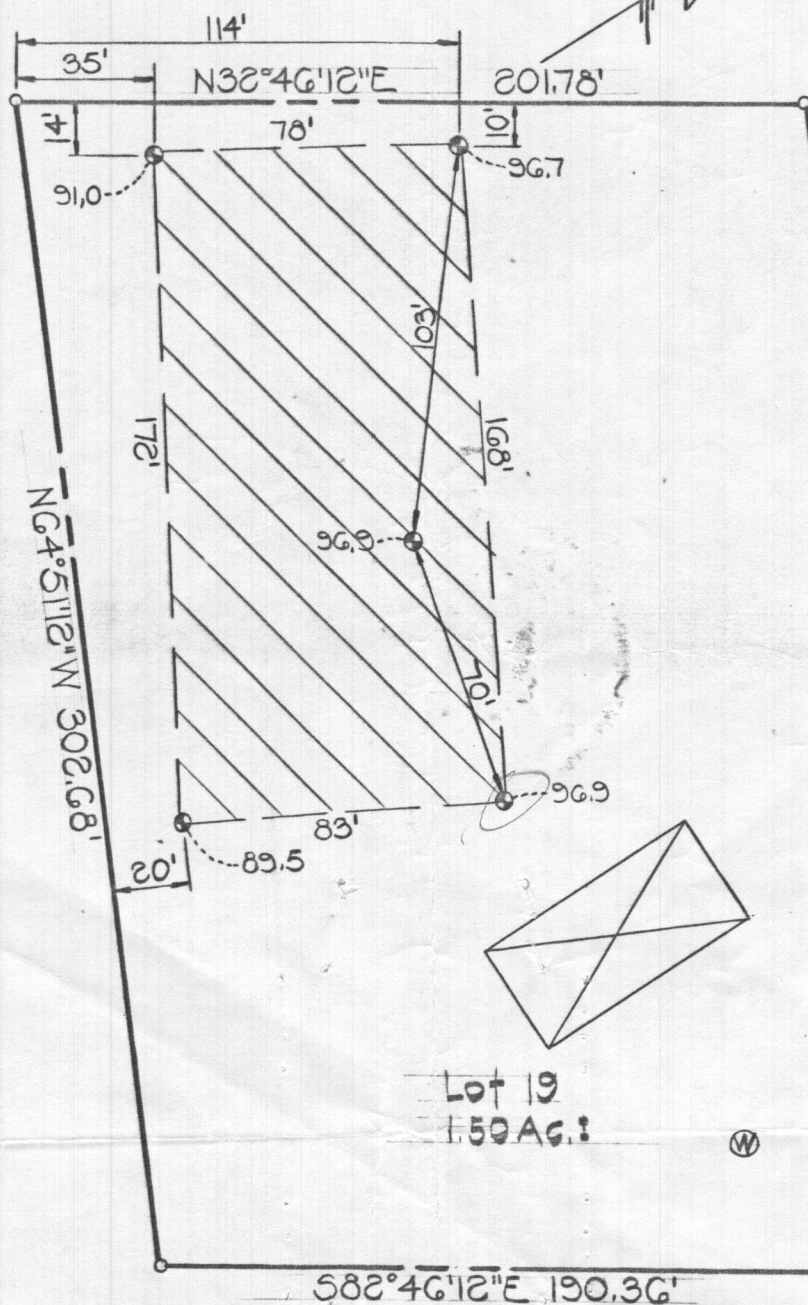

⊕ Denotes field located perc holes
96.9 - Denotes field elevations

I certify the measurements for the sewage disposal area and the sewage disposal area for this property is as designated.

Walter Park 2/27/1978
Walter Park Md. Reg. #5539 Date



Approved: For private water and private sewerage systems. Howard County Health Department

Joyce M. Bodden 3-6-78
County Health Officer Date

MD. ROUTE 144

CROVO & ASSOCIATES, INC.
CIVIL ENGINEERING &
LAND SURVEYING
8669 OAK ROAD
BALTIMORE MARYLAND 21234

PROPERTY OF
STANLEY MILLER
4TH ELECTION DISTRICT HOWARD CO., MD.
FEBRUARY 27, 1978 SCALE: 1"=50'