



# Howard County Health Department

Maura J. Rossman, M.D., Health Officer

## Bureau of Environmental Health

8930 Stanford Boulevard, Columbia, MD 21045

Main: 410-313-2640 | Fax: 410-313-2648

TDD 410-313-2323 | Toll Free 1-866-313-6300

[www.hchealth.org](http://www.hchealth.org)

Facebook: [www.facebook.com/hocohealth](https://www.facebook.com/hocohealth)

RECEIPT DATE: \_\_\_\_\_

### ONSITE SEWAGE DISPOSAL SYSTEM

P \_\_\_\_\_

APPROVAL DATE: 11/23/23 (SP)

### PERMIT: CONSTRUCTION

A \_\_\_\_\_

PROPERTY ADDRESS: 11225 WHITHORN WAY, ELLICOTT CITY, MD 21042

SUBDIVISION: RIVERWOOD, PHASE 2

LOT: 74

TAX ID: \_\_\_\_\_

03-351637

CONTRACTOR: Valley Road Enterprises LLC

EMAIL: \_\_\_\_\_

Chris Eby

CONTRACTOR ADDRESS: 5443 Valley Rd, Catonsville, MD 21228

PHONE: 410-927-6003

PROPERTY OWNER: WASIM and SHEHILA KHAN

EMAIL: \_\_\_\_\_

OWNER ADDRESS: 10223 RUTLAND ROUND ROAD, COLUMBIA, MD 21044

PHONE: \_\_\_\_\_

SEPTIC TANK SIZE (GALLONS): 2000

TANK MANUFACTURER: MAYER BROS, INC.

PUMP MODEL: Zoeller M57 or M59

PUMP SIZE: 0.3

PUMP TANK CAPACITY: 2000

DISTRIBUTION SYSTEM: ☒ GRAVITY ☐ PRESSURE DOSED

BEDROOMS: 6

APPLICATION RATE: 1.2

TRENCHES:	LINEAR FEET REQUIRED: <u>104</u>	INLET DEPTH: <u>3.0</u>
	TRENCH WIDTH: <u>3</u>	MAXIMUM BOTTOM DEPTH: <u>7.0</u>
	MINIMUM SPACE BETWEEN TRENCHES: <u>11</u>	EFFECTIVE AREA BEGINNING DEPTH: <u>3.0</u>
LOCATION:	PER APPROVED SITE PLAN. SEWAGE DISPOSAL AREA AND TANK LOCATIONS MUST BE STAKED BY LICENSED SURVEYOR PRIOR TO PRE-CONSTRUCTION INSPECTION.	
NOTES:	INSTALL AT LEAST TWO CLEANOUTS IN SHC. SYSTEM MUST PASS PUMP AND ALARM TEST PRIOR TO HEALTH DEPARTMENT FINAL APPROVAL OF THIS PERMIT AND RELEASE FOR 'USE AND OCCUPANCY'.	

ISSUED BY: R BRICKER

ISSUE DATE: \_\_\_\_\_

EXPIRATION DATE: \_\_\_\_\_

NOTE: CONTRACTOR MUST SCHEDULE A PRE-CONSTRUCTION INSPECTION PRIOR TO BEGINNING ANY INSTALLATION

NOTE: CONTRACTOR MUST SCHEDULE AN INSPECTION AND GAIN APPROVAL OF ALL COMPONENTS PRIOR TO COVERING

NOTE: STONE MUST BE APPROVED BY HEALTH DEPARTMENT AND GRAVEL TICKET MUST BE AVAILABLE FOR REVIEW.

NOTE: WATERTIGHT TANKS REQUIRED

NOTE: ALL PARTS OF SEPTIC SYSTEM SHALL BE AT LEAST 100 FEET DOWNGRADIENT FROM ANY WATER WELL

NOTE: MANHOLE RISERS REQUIRED ON ALL SEPTIC TANKS AND PUMP CHAMBERS

NOTE: AN ELECTRICAL PERMIT IS REQUIRED FOR INSTALLATION OF ANY ELECTRICAL COMPONENTS OF THE SYSTEM

☐ ELECTRICAL PERMIT ISSUED E 22002703

NOTE: MDE RECOMMENDS SEPTIC TANKS, BAT, AND OTHER PRETREATMENT UNITS BE PUMPED AT A FREQUENCY ADEQUATE TO ENSURE THAT SOLIDS ARE NOT DISCHARGED TO THE DISPOSAL AREA


NEITHER THE HOWARD COUNTY COUNCIL NOR THE HEALTH DEPARTMENT IS RESPONSIBLE FOR THE SUCCESSFUL OPERATION OF ANY SYSTEM.

PERMITTEE RESPONSIBLE FOR OBTAINING FINAL APPROVAL ON THIS PERMIT.

CALL 410-313-1771 TO SCHEDULE INSPECTIONS.






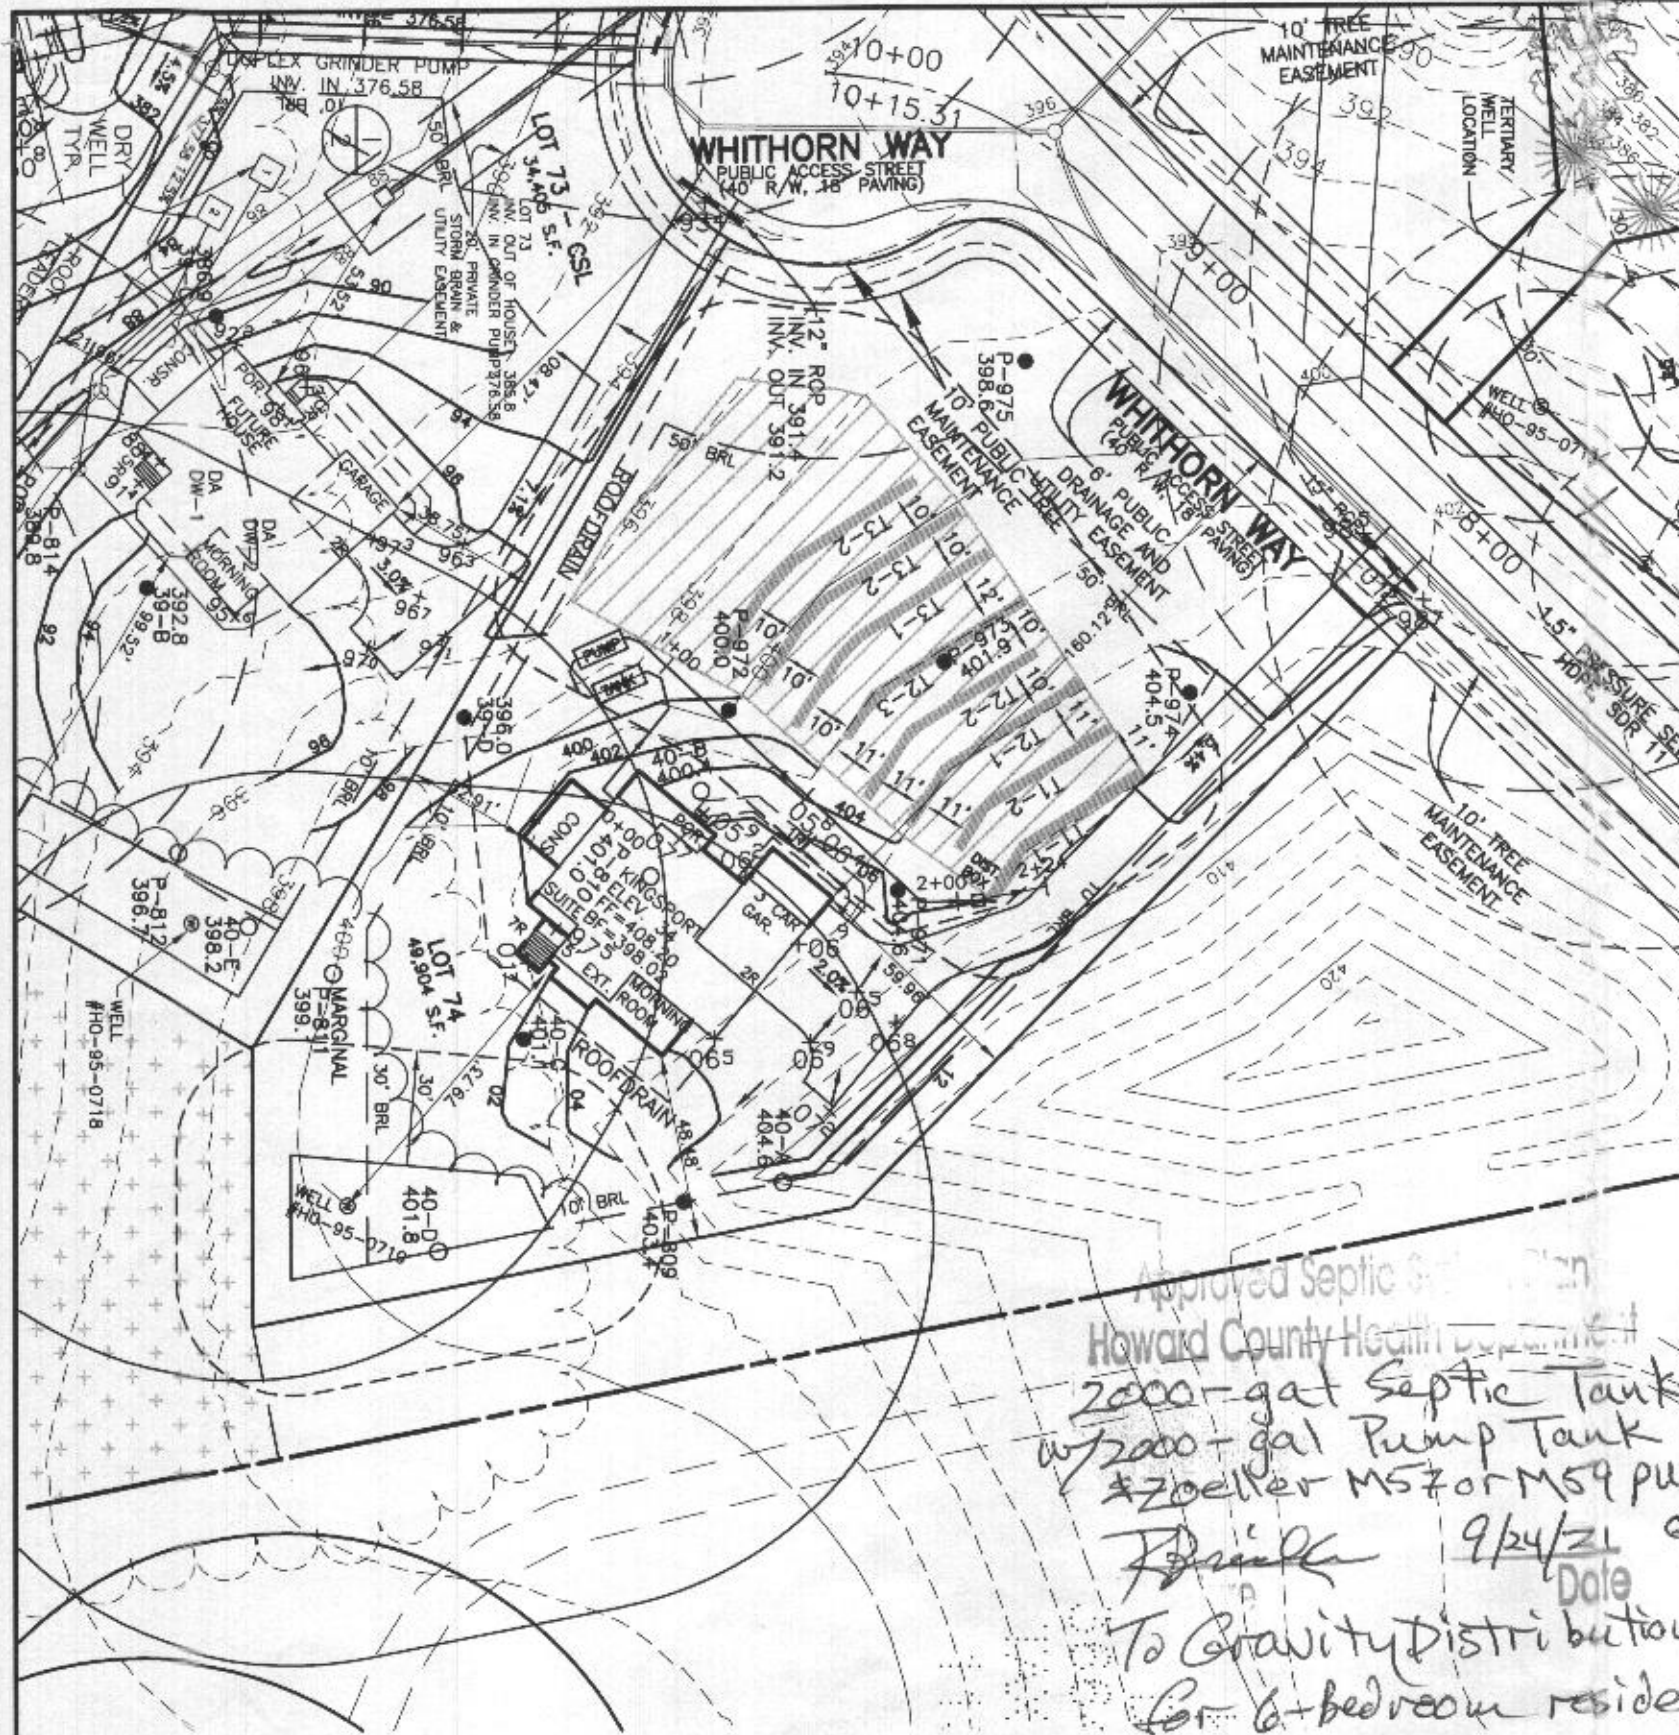

# LEGEND

- EXISTING CONTOURS ESTABLISHED UNDER F-04-082
- FIELD SURVEYED WELL LOCATION
- PASSED PERCOLATION TEST
- FAILED PERCOLATION TEST
- EXISTING APPROVED SEWAGE DISPOSAL AREA

GRID NORTH

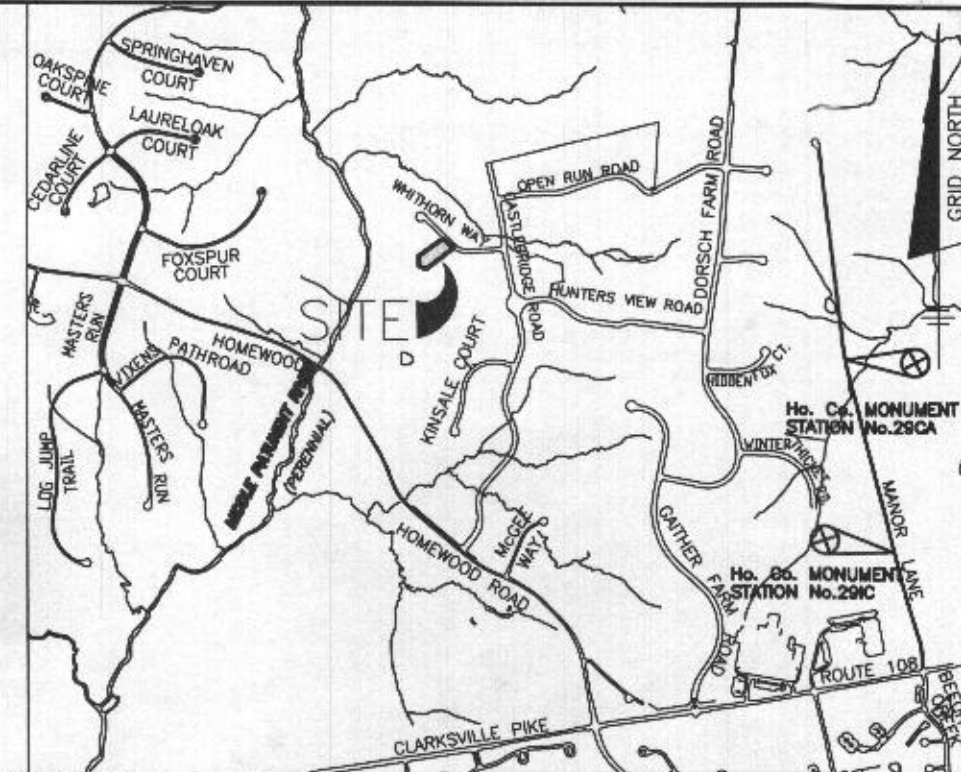

## ONSITE SEWAGE DISPOSAL PLAN NOTES:

- THE LOT SHOWN HEREON WAS RECORDED ON THE PLAT FOR RIVERWOOD, PHASE 2, PLAT Nos. 19720-19726. REFER TO THE PLATS FOR LOT DIMENSIONS, LOT AREAS, ALL EASEMENTS AND CONDITIONS.
- SEDIMENT AND EROSION CONTROLS, THE STANDARD PLAN USAGE, WERE APPROVED BY HOWARD SOIL CONSERVATION.
- TOPOGRAPHY SHOWN HEREON IS TAKEN FROM THE APPROVED ROAD CONSTRUCTION PLANS AND INCLUDES HOWARD COUNTY GIS, FIELD RUN TOPOGRAPHY BY J.A. RICE, INC., AND DESIGN GRADING FROM THE ROAD CONSTRUCTION PLANS.
- ALL SEDIMENT AND EROSION CONTROL FEATURES USED ON THIS SITE SHALL COMPLY WITH THE 2011 MARYLAND STANDARDS AND SPECIFICATIONS FOR SOIL EROSION AND SEDIMENT CONTROL.
- ALL DRAINAGE AND STORMWATER MANAGEMENT FEATURES USED ON THIS SITE MUST COMPLY WITH THE APPROVED ROAD CONSTRUCTION PLANS EXCEPT AS WAIVED.
- THE EXISTING WELL SHOWN ON THIS PLAN, HO-95-0719, HAS BEEN FIELD LOCATED BY BENCHMARK ENGINEERING, INC., AND IS ACCURATELY SHOWN.
- THERE ARE NO EXISTING WELLS OR SEPTIC SYSTEMS WITHIN 100' OF THIS PROJECT'S BOUNDARY EXCEPT AS NOTED.
- ANY CHANGES TO A PRIVATE SEWAGE DISPOSAL AREA OR WELL BOX SHALL REQUIRE A REVISED PERCOLATION CERTIFICATION PLAN.
- STORMWATER MANAGEMENT FOR THIS LOT WAS DESIGNED AND PROVIDED BY ONE DRY WELL FACILITY AND THE EXISTING MICROPOOL ED FACILITY.
- THE NEW SEPTIC TANK WILL HAVE A 2,000 GALLON TWO COMPARTMENT TANK, THE PUMP TANK WILL BE A 2,000 GALLON ONE COMPARTMENT TANK.
- ANY CHANGES TO THE LOCATIONS OR DEPTHS TO ANY COMPONENTS MUST BE APPROVED BY THE ENGINEER AND THE HOWARD COUNTY HEALTH DEPARTMENT PRIOR TO INSTALLATION. A REVISED SITE PLAN MAY BE REQUIRED.
- ANY ELECTRICAL WORK FOR THE INSTALLATION MUST BE PERFORMED BY A LICENSED ELECTRICIAN.

ADC MAP 4934 GRID E1


VICINITY MAP

SCALE: 1" = 2000'

Professional Certification. I hereby certify that these documents were prepared or approved by me, and that I am a duly licensed professional engineer under the laws of the State of Maryland, License No. 45577, Expiration Date: 06-08-2022.



## PLAN VIEW

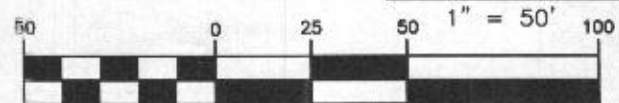

(IN FEET)  
1 inch = 50 ft.

OWNER:

WASIM AND SHEHLLA KHAN  
10223 RUTLAND ROUND ROAD  
COLUMBIA, MD 21044

BUILDER:

CARUSO HOMES  
2120 BALDWIN AVE  
SUITE 200  
CROFTON MD, 21114  
301-832-2018

BENCHMARK

ENGINEERS LAND SURVEYORS PLANNERS  
ENGINEERING, INC.  
8480 BALTIMORE NATIONAL PIKE SUITE 315  
ELLICOTT CITY, MARYLAND 21043  
(P) 410-465-6105 (F) 410-465-6644  
WWW.BEJ-CIVILENGINEERING.COM

PROJECT:

RIVERWOOD, PHASE 2

LOT 74

LOCATION:

TAX MAP: 29, GRID: 4, PARCEL: 20, ZONED: RC-DEO  
11225 WHITHORN WAY  
ELLICOTT CITY MD 21042

THIRD ELECTION DISTRICT, HOWARD COUNTY, MD, TAX ID #03-351637

TITLE:

ONSITE SEWAGE DISPOSAL SYSTEM  
(OSDS) DESIGN PLAN

HOUSE TYPE:

KINGSPORT MODEL

DATE:

SEPT., 2021

PROJECT NO.

3073

SCALE:

AS SHOWN

DRAWING

1 OF 4







# Pumping Station

Diameter of Force Main and Manifold = 2" PVC SCH. 40  
Length of Force Main = 113 feet SCH. 40 gallons/100 feet = 17.4 Table 4.2

Volume of Main = 19.7 gallons

Total Volume = 19.7 gallons

Minimum Dose must be greater than 1/6 of the design flow 150 gallons

Minimum Dose must be greater than the volume of the main 20 gallons

Use minimum dose of 160 gallons okay Doses per Day = 5.625

## Size Pump Chamber

Pump chamber must be able to hold one dose and one days design flow

One day Capacity = 900 gallons  
Dose = 160 gallons  
Totals = 1060 gallons

Use 2,000 gallon pump tank

Tank Dimensions:	Exterior	Interior	Length:	Width:	Height:	Area:	Volume:
Length:	13.75 feet	13.08 feet	13.08 feet	5.58 feet	4.67 feet	73.05 sf	340.89 cf
Width:	6.25 feet	5.58 feet	5.58 feet	5.58 feet	4.67 feet	73.05 sf	340.89 cf
Height:	5.42 feet	4.67 feet	4.67 feet	4.67 feet	4.67 feet	73.05 sf	340.89 cf
Walls:	0.33 feet	0.33 feet	0.33 feet	0.33 feet	0.33 feet	0.33 feet	0.33 feet
Bottom:	0.33 feet	0.33 feet	0.33 feet	0.33 feet	0.33 feet	0.33 feet	0.33 feet
Top:	0.42 feet	0.42 feet	0.42 feet	0.42 feet	0.42 feet	0.42 feet	0.42 feet
Bottom to Inlet:	4.58 feet	4.58 feet	4.58 feet	4.58 feet	4.58 feet	4.58 feet	4.58 feet

## Sizing the Pump

Flow: runtime = 7.000 minutes  
rate = 22.86 gallons/minute

## Design Head:

Design Head = Static Head + Friction Head  
Static Head = highest elevation of main - pump off elevation  
Highest component of system = 403.33 Main HP  
Pump off elevation = 392.00  
Static Head = 11.33 feet  
Friction Head = Head loss due to pipe friction  
2.0" pipe = 113 feet  
45' bends 3 loss for bend 12 feet per table 4.3  
90' bends 3 loss for bend 15 feet per table 4.3  
Gate Valve 0 loss for tee 0 feet per table 4.3  
Friction loss per table 4.4 = 0.95 (ft/100 ft)  
Equivalent Length = 140 Friction loss 1.32 feet  
Total Friction Head = 1.32  
Design Head = 12.65 feet

## Pump Requirements:

Performance = 22.86 gpm  
Head of Water = 12.65 feet of head

Pump Selection: Zoeller Pump Company, Model 59  
0.3 horse power

Pump Flow Rate = 26.00 gallons/minute  
per rating curve. Run time: 6.15 Minutes  
TDH analysis 12.99 ft  
Between design and curve? Yes

## Design Pump Chamber

Ground over Tank = 397.30 Cover 1.90 ft  
Top of Tank = 395.40  
Invert of Tank = 390.31  
6" Riser = 0.50 feet  
Pump Height = 0.86 feet

Min. Pump off = 391.67  
Selected Pump off = 392.00

Dose = 21.4 cf  
Area of Pit = 73.05 sf

Pump on dist. = 0.29  
Pump on Elev. = 392.29

Distance between Pump on and Highwater Alarm = 0.5 feet  
Highwater Alarm Elevation = 392.79

Dist. for day stored above alarm 1.65  
Minimum Inlet Elev. = 394.44  
Tank Inlet = 394.56 Okay  
Dist. Alarm to Inlet = 1.77 Okay

Trusted. Tested. Tough.

Product information presented here reflects conditions at time of publication. Consult factory regarding discrepancies or recommendations.



## TECHNICAL DATA SHEET MIGHTY-MATE SERIES Cast Iron Models 53, 57 and Bronze Models 55, 59 Submersible Effluent / Dewatering Pumps

### PRODUCT SPECIFICATIONS

MOTOR	Motor Power	3/10
	Voltage	115 or 230
PUMP	Phase	1 Ph
	Freq.	60 Hz
MATERIALS	RPM	1600
	Type	Shaded pole
PUMP	Insulation	Class B
	Amperes	4.8 - 9.7
PUMP	Operation	Automatic or nonautomatic
	Auto On/Off Points	2.14" (18.4 cm) ± 2" (18 cm)
PUMP	Discharge Size	1-1/2" NPT
	Solids Handling	1/2" (12 mm) spherical solids
PUMP	Cord Length	9' (3 m) automatic, 15' (5 m) non-automatic
	Cord Type	UL listed, 3-wire, grounded plug
PUMP	Max. Head	15.37' (5.8 m)
	Max. Flow Rate	43 GPM (160 LPM)
PUMP	Max. Operating Temp.	130° F (54° C)
	Casting	Of field
PUMP	Motor Protection	Auto reset thermal overload
	Cap	Cast iron or bronze
PUMP	Motor Housing	Cast iron or bronze
	Pump Housing	Cast iron or bronze
PUMP	Base	Cast iron, bronze or engineered thermoplastic
	Upper Bearing	Sleeve bearing
PUMP	Lower Bearing	Sleeve bearing
	Mechanical Seals	Carbon and ceramic
PUMP	Impeller Type	Non-clogging vortex
	Impeller	Plastic, cast iron or bronze
PUMP	Hardware	Stainless steel
	Motor Shaft	AST 1218 cold rolled steel
PUMP	Gasket	Neprene

NOTE: See model comparison chart for specific details.




© Copyright 2020 Zoeller® Co. All rights reserved.

502-778-2731 | 800-828-7867 | 3645 Cane Run Road | Louisville, KY 40211-1961 | zoellerpumps.com

SECTION: 2.13.000  
PW270  
1120  
Supersedes  
0215

## TOTAL DYNAMIC HEAD FLOW PER MINUTE

MODEL		53/55/57/59	
Feet	Meters	Gal.	Liters
5	1.5	43	163
10	3.0	34	129
15	4.6	19	72
Shut-off Head:		19.25 ft.(5.9m)	

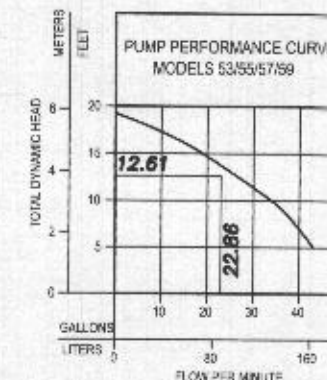

## RECOMMENDED PUMP: M59

Model	Seal	Mode	Voltage	Ph	Amps	HP	H <sub>0</sub>	Flow	Weight	Simplex	Duplex
M53/M55	Single	Auto	115	1	9.7	3/10	25	20	10	1	1
M53/M55	Single	Non	115	1	9.7	3/10	25	20	10	2	3 & 4
* M53	Single	Auto	115	1	9.7	3/10	25	20	10	1	1
* M53/M57	Single	Auto	230	1	4.8	3/10	25	24/30	11/13	1	1
M55	Single	Auto	230	1	4.8	3/10	25	20	10	1	1
M55/M59	Single	Non	230	1	4.8	3/10	25	20	10	2	3 & 4
M57/M59	Single	Auto	115	1	9.7	3/10	25	24/30	11/13	1	1
M57/M59	Single	Non	115	1	9.7	3/10	25	24/30	11/13	2	3 & 4
* M57	Single	Auto	115	1	9.7	3/10	25	20	10	1	1
M57/M59	Single	Auto	230	1	4.8	3/10	25	24/30	11/13	1	1
M57/M59	Single	Non	230	1	4.8	3/10	25	24/30	11/13	2	3 & 4
M59	Single	Non	230	1	4.8	3/10	25	20	10	2	3 & 4

\* Single piggyback switch included.

### SPECIAL MODEL FEATURES

Additional cord lengths are available in 15' (5 m), 25' (8 m) and 35' (11 m). 30' (10 m) cord lengths available for 230 V units only.

SE and BE models include a piggyback variable level float switch.

Model 53: cast iron switch case, motor and pump housing, a plastic impeller and base. Model 57: all cast iron construction with a cast iron impeller.

Model 55: bronze switch case, motor and pump housing, a plastic impeller and base. Model 59: bronze construction with a bronze impeller.

Optional pump stand (P/N 10-2421).

### SELECTION GUIDE

- Integral float-operated mechanical switch, no external control required.
- Single piggyback variable level float switch or double piggyback variable level float switch. Refer to FMD77.
- See FMD72 for correct model of Electrical Attenuator.
- Variable level control switch 10-0743 used as a control activator with electrical attenuator (3) or (4) float system.

### OPTIONAL PUMP STAND P/N 10-2421

- Reduces potential clogging by debris
- Replaces rocks or debris under the pump
- Made of durable, noncorrosive ABS
- Raises pump 2" (5 cm) off bottom of basin
- Provides the ability to raise impeller by adding sections of 1/2" or 2" (12mm or 50mm) PVC piping
- Attaches securely to pump
- Accommodates pump, dewatering and effluent applications

NOTE: Make sure float is free from obstruction.



**CAUTION** All installation of controls, protection devices and wiring should be done by a qualified licensed electrician. All electrical and safety codes should be followed including the most recent National Electrical Code (NEC) and the Occupational Safety and Health Act (OSHA).

© Copyright 2020 Zoeller® Co. All rights reserved.

502-778-2731 | 800-828-7867 | 3645 Cane Run Road | Louisville, KY 40211-1961 | zoellerpumps.com

Professional Certification I hereby certify that these documents were prepared or approved by me, and that I am a duly licensed professional engineer under the laws of the State of Maryland. License No. 45577, Expiration Date: 06-08-2022.



## BENCHMARK

ENGINEERS • LAND SURVEYORS • PLANNERS  
ENGINEERING, INC.  
8480 BALTIMORE NATIONAL PIKE SUITE 315  
ELLICOTT CITY, MARYLAND 21043  
(P) 410-465-6105 • (F) 410-465-6644  
WWW.BEI-CMLENGINEERING.COM

BUILDER:  
CARUSO HOMES  
2120 BALDWIN AVE  
SUITE 200  
CROFTON MD, 21114  
301-832-2018

OWNER:  
WASIM AND SHEHLLA KHAN  
10223 RUTLAND ROUND ROAD  
COLUMBIA, MD 21044

## PROJECT:

RIVERWOOD  
LOT 74

## LOCATION:

TAX MAP: 29, GRID: 4, PARCEL: 20, ZONED: RC-DEO  
11225 WHITHORN WAY  
ELLICOTT CITY MD 21042  
THIRD ELECTION DISTRICT, HOWARD COUNTY, MD, TAX ID #03-351637

## TITLE:

ONSITE SEWAGE DISPOSAL SYSTEM  
(OSDS) DESIGN PLAN

## HOUSE TYPE:

KINGSPORT MODEL

## DATE:

SEPT., 2021

## PROJECT NO.

3073


## SCALE:

AS SHOWN

## DRAWING

3 OF 4



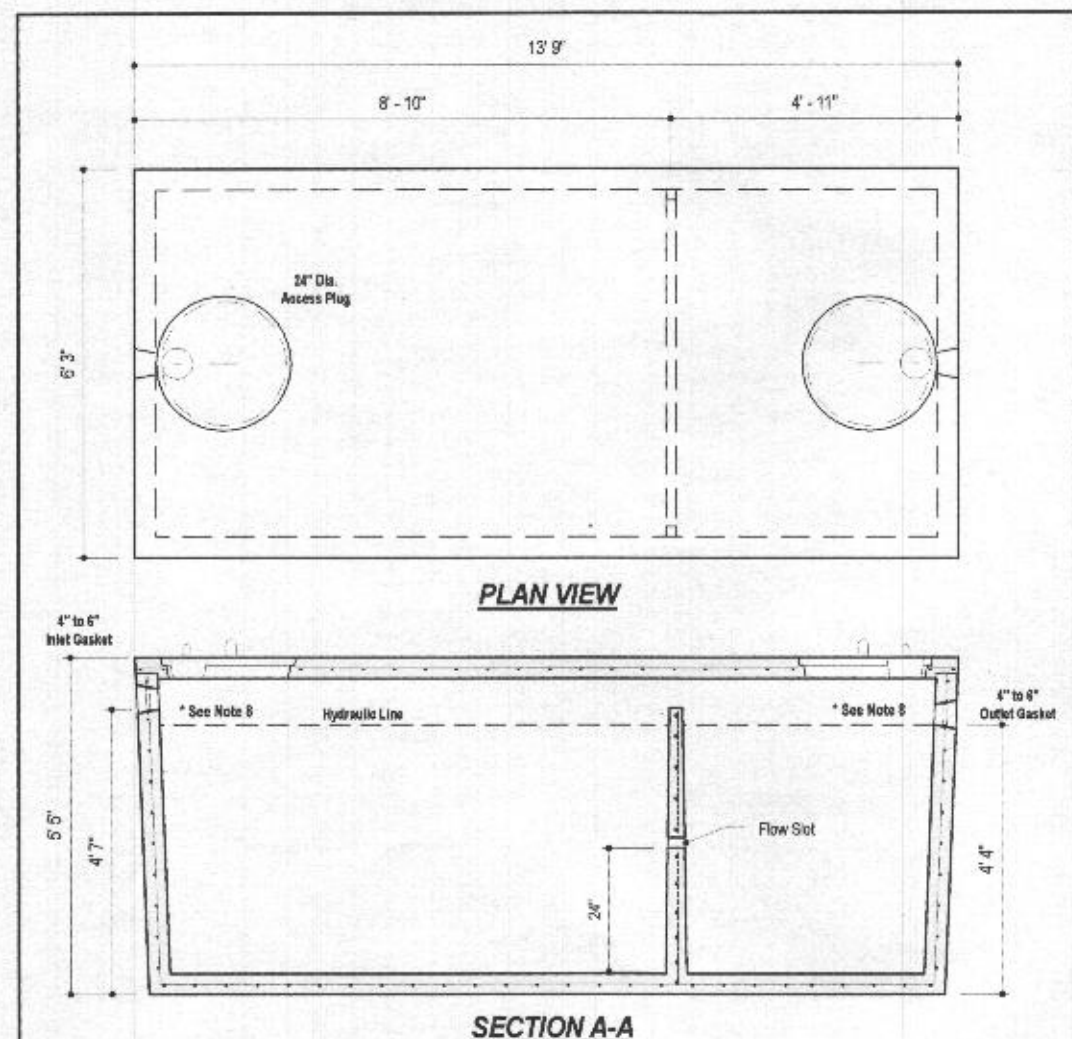

#### DESIGN DATA & GENERAL NOTES

- [1] Concrete strength f'c=4,000 p.s.i. @ 28 days. Density = 150 pcf.
- [2] Cement - Portland Type III per ASTM C 150-92.
- [3] Admixtures & plasticizers per ASTM C 260-98 & C 494-92.
- [4] Reinforcing per ASTM A196. Min. 1-1/2" cover.
- [5] Top slab sealed with butyl rope mastic.
- [6] 4" wall, 4" base, & 4" top thickness.
- [7] Max 3" of cover.
- [8] Depending on use of tank, inlet & outlet baffles may be required by code.

**MBI**  
Mayer Bros., Inc.

6264 Race Road  
Elkridge, Maryland 21075  
Tel. 410.796.1434  
Fax. 410.796.1438

www.mayerbrosprecast.com


#### 2,000 GALLON SEPTIC TANK 2-Compartment

Stock Item [Approx. 19,900 lbs]

Dwg. No. 2000-2C

No Scale

Aug 11, 2008

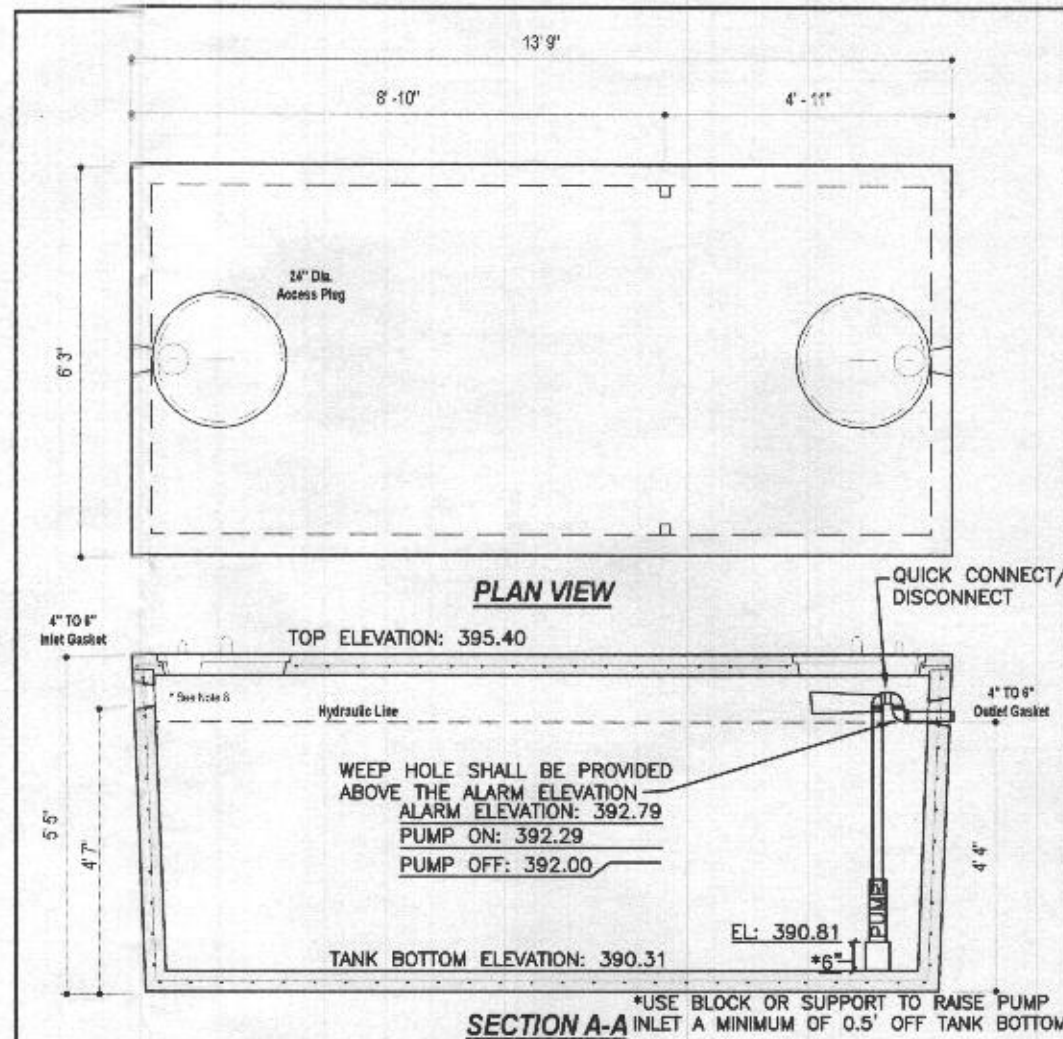

#### DESIGN DATA & GENERAL NOTES

- [1] Concrete strength f'c=4,000 p.s.i. @ 28 days. Density = 150 pcf.
- [2] Cement - Portland Type III per ASTM C 150-92.
- [3] Admixtures & plasticizers per ASTM C 260-98 & C 494-92.
- [4] Reinforcing per ASTM A196. Min. 1-1/2" cover.
- [5] Top slab sealed with butyl rope mastic.
- [6] 4" wall, 4" base, & 4" top thickness.
- [7] Max 3" of cover.
- [8] Depending on use of tank, inlet & outlet baffles may be required by code.

**MBI**  
Mayer Bros., Inc.

6264 Race Road  
Elkridge, Maryland 21075  
Tel. 410.796.1434  
Fax. 410.796.1438

www.mayerbrosprecast.com

#### 2,000 GALLON SEPTIC TANK 1-Compartment

Stock Item [Approx. 19,900 lbs]

Dwg. No. 2000-1C

No Scale

Aug. 11, 2008

Float Tree	Elev.	Relative to Bottom
Bottom of Tank	390.31	
Top of Pump	391.67	1' 4 3/8"
Pump Off	392.00	1' 8 1/4"
Pump On	392.29	1' 11 13/16"
High Alarm	392.79	2' 5 13/16"

WEIGHT = 19,000 lbs.

Approved Septic System Plan  
Howard County Health Department

Approved

Signature

9/24/2021  
Date

PROJECT:

RIVERWOOD  
LOT 74

LOCATION: TAX MAP: 29, GRID: 4, PARCEL: 20, ZONED: RC-DEO  
11225 WHITHORN WAY  
ELLCOTT CITY MD 21042

THIRD ELECTION DISTRICT, HOWARD COUNTY, MD, TAX ID #03-351637

TITLE: ONSITE SEWAGE DISPOSAL SYSTEM  
(OSDS) DESIGN PLAN

HOUSE TYPE: KINGSFORT MODEL

DATE: SEPT., 2021

PROJECT NO. 3073

SCALE: AS SHOWN

DRAWING 4 OF 4

Professional Certification. I hereby certify that these documents were prepared or approved by me, and that I am a duly licensed professional engineer under the laws of the State of Maryland. License No. 45577, Expiration Date: 06-08-2022.



BENCHMARK

ENGINEERS LAND SURVEYORS PLANNERS

ENGINEERING, INC.

8480 BALTIMORE NATIONAL PIKE & SUITE 315  
ELLCOTT CITY, MARYLAND 21043  
(P) 410-465-6105 & (F) 410-465-6644

WWW.BEJ-CIVILENGINEERING.COM



J:\1950 RIVERWOOD HSES\dwg\8011 Lot 73 v2.dwg, Lot 74 OSDS, 9/21/2021 9:49:35 AM



415

# Approved Septic System Plan Howard County Health Department

410

405

400


395

390

390

FF: 408.20

BF: 398.02

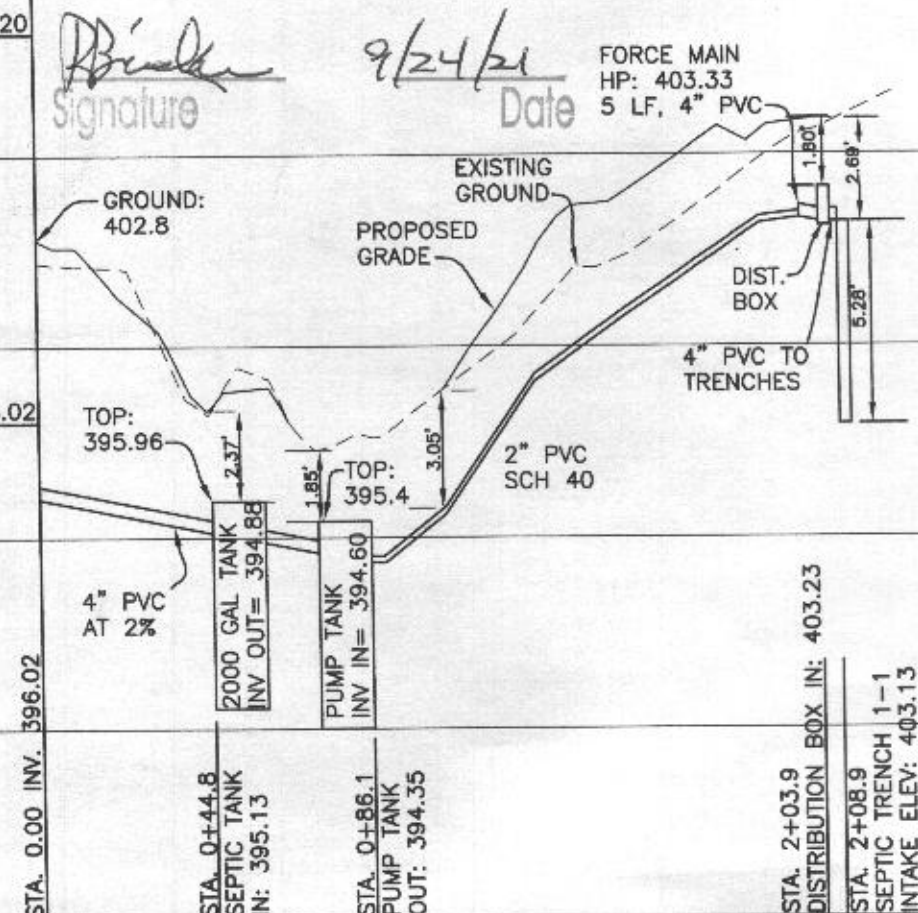

LOT 74 SEPTIC PROFILE  
SCALE: 1"=50' HORIZ., 1"=5' VERT

415

410

405

400

395

390

385

## INITIAL SYSTEM

Number of Bedrooms	6	
Application Rate	1.2	gpd/sf
Effective Area Beginning Depth	3.0	ft
Bottom Max Depth	7.0	ft
Design Flow	900	gpd
Drainage Field square footage	750	sf
Sidewall Reduction Credit	0.42	
Trench width	3	ft
Effective Area Depth	4	ft
Trench Spacing	11	ft
Linear Length of trench Required	104	lf

## 1st REPLACEMENT SYSTEM

Number of Bedrooms	6	
Application Rate	1.2	gpd/sf
Effective Area Beginning Depth	4.0	ft
Bottom Max Depth	5.5	ft
Design Flow	900	gpd
Drainage Field square footage	750	sf
Sidewall Reduction Credit	0.71	
Trench width	3	ft
Effective Area Depth	1.5	ft
Trench Spacing	10	ft
Linear Length of trench Required	179	lf

## 2nd REPLACEMENT SYSTEM

Number of Bedrooms	6	
Application Rate	1.2	gpd/sf
Effective Area Beginning Depth	4.5	ft
Bottom Max Depth	5.5	ft
Design Flow	900	gpd
Drainage Field square footage	750	sf
Sidewall Reduction Credit	0.83	
Trench width	3	ft
Effective Area Depth	1	ft
Trench Spacing	10	ft
Linear Length of trench Required	208	lf

## HEALTH DEPARTMENT SPEC INFORMATION - LOT 74

System	Application Rate	Effective Depth	Bottom Depth
Initial	1.2	3.0	7.0
1st Replacement	1.2	4.0	5.5
2nd Replacement	1.2	4.5	5.5

SEE MANUFACTURES SPECIFICATIONS FOR DETAILS.  
WWW.MAYERPRECAST.COM  
EQUIVALENT FROM OTHER MANUFACTURERS CAN BE SUBSTITUTED.

SIGNATURE AND SEAL ARE FOR SEPTIC PROFILE AND CALCULATIONS ONLY, TANK AND DETAILS WERE NOT DESIGNED OR REVIEWED BY THE ENGINEER:

BUILDER:  
CARUSO HOMES  
2120 BALDWIN AVE  
SUITE 200  
CROFTON MD, 21114  
301-832-2018

OWNER:  
WASIM AND SHEHLLA KHAN  
10223 RUTLAND ROUND ROAD  
COLUMBIA, MD 21044

## SEPTIC INVERT CHART - LOT 74

INV @ HOUSE	396.2
GROUND @ HOUSE	402.8
INV IN TANK	395.1
INV OUT TANK	394.9
TOP OF TANK	396.0
GROUND OVER TANK	398.3
INV IN PUMP TANK	394.6
INV OUT PUMP TANK	394.4
TOP OF PUMP TANK	395.4
GROUND OVER P. TANK	397.3
INV IN DIST BOX	403.23
INV OUT DIST BOX	403.18
GROUND AT DIST BOX	405.9

PROJECT:

RIVERWOOD  
LOT 74

LOCATION: TAX MAP: 29, GRID: 4, PARCEL: 20, ZONED: RC-DEO  
11225 WHITHORN WAY  
ELLICOTT CITY MD 21042

THIRD ELECTION DISTRICT, HOWARD COUNTY, MD, TAX ID #03-351637

TITLE: ONSITE SEWAGE DISPOSAL SYSTEM  
(OSDS) DESIGN PLAN

HOUSE TYPE:

KINGSPORT MODEL

DATE:

SEPT., 2021

PROJECT NO.

3073


SCALE:

AS SHOWN

DRAWING

2

OF 4

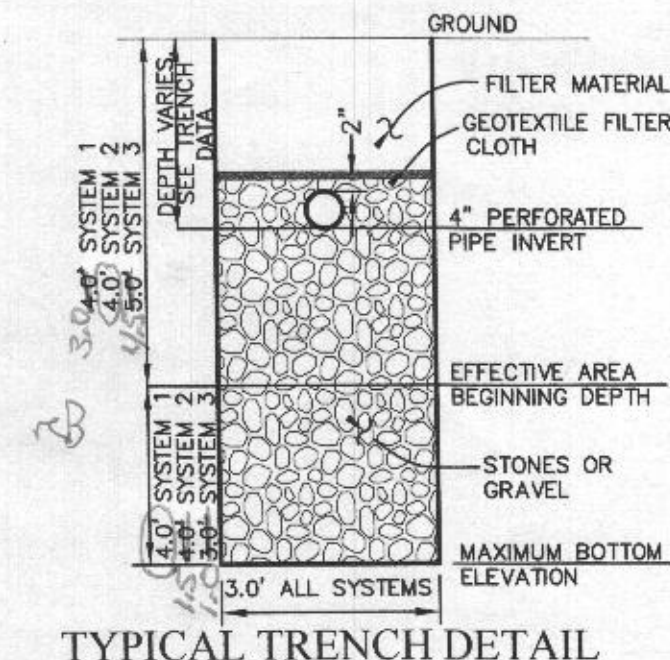

Professional Certification. I hereby certify that these documents were prepared or approved by me, and that I am a duly licensed professional engineer under the laws of the State of Maryland, License No. 45577, Expiration Date: 06-08-2022.



## BENCHMARK

ENGINEERS LAND SURVEYORS PLANNERS  
ENGINEERING, INC.  
8480 BALTIMORE NATIONAL PIKE & SUITE 315  
ELLICOTT CITY, MARYLAND 21043  
(P) 410-485-8105 & (F) 410-485-8644  
WWW.BEI-CIVILENGINEERING.COM



## Pumping Station

Diameter of Force Main and Manifold = 2" PVC SCH. 40  
Length of Force Main = 113 feet SCH. 40 gallons/100 feet = 17.4 Table 4.2

Volume of Main = 19.7 gallons

Total Volume = 19.7 gallons

Minimum Dose must be greater than 1/8 of the design flow 150 gallons

Minimum Dose must be greater than the volume of the main 20 gallons

Use minimum dose of 160 gallons okay Doses per Day = 5.625

## Size Pump Chamber

Pump chamber must be able to hold one dose and one days design flow

One day Capacity = 900 gallons  
Dose = 160 gallons  
Totals = 1060 gallons

Use 2,000 gallon pump tank

Tank Dimensions:

	Exterior	Interior	Walls:	Bottom:	Top:	Bottom to Inlet:
Length:	13.75 feet	13.08 feet	0.33 feet	0.33 feet	0.42 feet	4.58 feet
Width:	6.25 feet	5.58 feet				
Height:	5.42 feet	4.67 feet				
Area:		73.05 sf				
Volume:		340.89 cf				

## Sizing the Pump

Flow: runtime = 7.000 minutes  
rate = 22.86 gallons/minute

## Design Head:

Design Head = Static Head + Friction Head  
Static Head = highest elevation of main - pump off elevation  
Highest component of system = 403.33 Main HP  
Pump off elevation = 392.00  
Static Head = 11.33 feet

Friction Head = Head loss due to pipe friction  
2.0" pipe = 113 feet  
45° bends 3 loss for bend 12 feet per table 4.3  
90° bends 3 loss for bend 15 feet per table 4.3  
Gate Valve 0 loss for tee 0 feet per table 4.3

Friction loss per table 4.4 = 0.95 (ft/100 ft)

Equivalent Length = 140 Friction loss 1.32 feet

Total Friction Head = 1.32

Design Head = 12.65 feet

## Pump Requirements:

Performance = 22.86 gpm  
Head of Water = 12.65 feet of head

Pump Selection: Zoeller Pump Company, Model 59  
0.3 horse power

Pump Flow Rate = 26.00 gallons/minute  
per rating curve. Run time: 6.15 Minutes  
TDM analysis 12.99  
Between design and curve? Yes

## Design Pump Chamber

Ground over Tank = 387.30 Cover = 1.90 ft  
Top of Tank = 395.40  
Invert of Tank = 390.31  
6" Riser = 0.50 feet  
Pump Height = 0.86 feet

Min. Pump off = 391.67  
Selected Pump off = 392.00

Dose = 21.4 cf  
Area of Pit = 73.05 sf

Pump on Elev. = 0.29  
Pump on Elev. = 392.29

Distance between Pump on and Highwater Alarm = 0.5 feet  
Highwater Alarm Elevation = 392.79

Dist. for day stored above alarm 1.65  
Minimum Inlet Elev. = 394.44  
Tank Inlet = 394.56 Okay  
Dist. Alarm to Inlet = 1.77 Okay

J:\1950 RIVERWOOD HSES\dwg\8011 Lot 74 OSDS, 9/21/2021 9:50:10 AM

Trusted. Tested. Tough.

Product information presented here replaces specifications at time of publication. Consult factory regarding discrepancies or inconsistencies.

**ZOELLER**  
PUMP COMPANY


SECTION: 2.15.000  
FM2773  
1122  
Supersedes  
0515

## TECHNICAL DATA SHEET MIGHTY-MATE SERIES Cast Iron Models 53, 57 and Bronze Models 55, 59 Submersible Effluent / Dewatering Pumps

## PRODUCT SPECIFICATIONS


MOTOR	Horse Power	3/10
	Voltage	115 or 230
PUMP	Phase	1 Ph
	Freq	60 Hz
MATERIALS	RPM	1800
	Type	Shaded pole
MATERIALS	Insulation	Class B
	Amps	4.2 - 5.7
MATERIALS	Operation	Automatic or non-automatic
	Auto On/Off Points	7 1/4" (18.4 cm) / 3" (7.6 cm)
MATERIALS	Discharge Size	1-1/2" NPT
	Solids Handling	1/2" (12 mm) spherical solids
MATERIALS	Cord Length	9' (3 m) automatic, 15' (5 m) non-automatic
	Cord Type	UL listed, 3-wire, grounded plug
MATERIALS	Max. Head	19.25 (5.9 m)
	Max. Flow Rate	45 GPM (168 LPM)
MATERIALS	Max. Operating Temp.	120° F (50° C)
	Coating	DN Rite
MATERIALS	Motor Protection	Auto reset thermal overload
	Cap	Cast iron or bronze
MATERIALS	Motor Housing	Cast iron or bronze
	Pump Housing	Cast iron or bronze
MATERIALS	Base	Cast iron, bronze or engineered thermoplastic
	Upper Bearing	Sleeve bearing
MATERIALS	Lower Bearing	Sleeve bearing
	Mechanical Seals	Carbon and ceramic
MATERIALS	Impeller Type	Non-clogging vortex
	Impeller	Plastic, cast iron or bronze
MATERIALS	Hardware	Stainless steel
	Motor Shaft	AST 315 cold rolled steel
MATERIALS	Gasket	Neprene

NOTE: See model comparison chart for specific details.

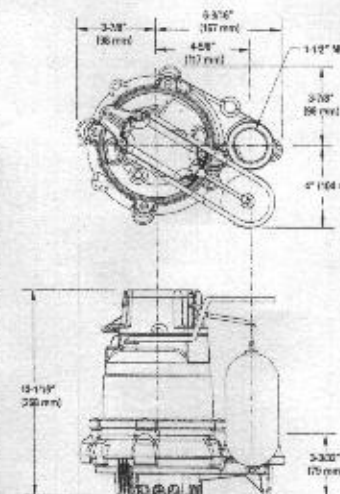

## TOTAL DYNAMIC HEAD FLOW PER MINUTE

MODEL		53/55/57/59	
Feet	Meters	Gal.	Liter
5	1.5	43	163
10	3.0	34	129
15	4.6	19	72
Shut-off Head:		19.25 ft.(5.9m)	

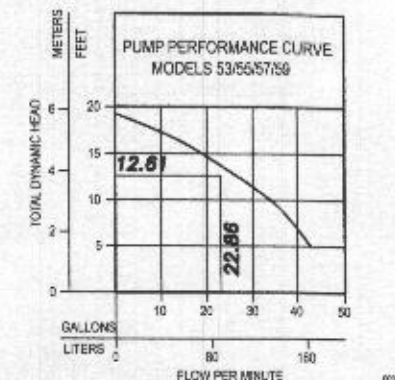

## RECOMMENDED PUMP: M59

Model	MODEL COMPARISON									
	Steel	Model	Volts	Ph.	Amps	HP	Hz	Lbs	Kg	Simplex
M53/M55	Single	Auto	115	1	8.7	3/10	60	23	10	1
M53/M55	Single	Non	115	1	8.7	3/10	60	23	10	3
* M53	Single	Auto	115	1	8.7	3/10	60	23	11	*
* M53/M57	Single	Auto	230	1	4.8	3/10	60	24/30	11/13	*
M53	Single	Auto	230	1	4.8	3/10	60	23	10	1
M53/M55	Single	Non	230	1	4.8	3/10	60	23	10	2
M57/M59	Single	Auto	115	1	9.7	3/10	60	28/33	13/15	1
M57/M59	Single	Non	115	1	9.7	3/10	60	28/33	13/15	2
* M57	Single	Auto	115	1	9.7	3/10	60	30	13	*
M57/M59	Single	Auto	230	1	4.8	3/10	60	30/33	13/15	1
M57/M59	Single	Non	230	1	4.8	3/10	60	28/33	13/15	2
M59	Single	Non	230	1	4.8	3/10	60	22	10	2

\* Single piggyback switch included.

## SPECIAL MODEL FEATURES

Additional cord lengths are available in 15' (5 m), 25' (8 m) and 35' (11 m). 60' (18 m) cord lengths available for 230 V units only.  
BE and BN models include a piggyback variable level pump switch.  
Model 53: cast iron switch case, motor and pump housing, a plastic impeller and base. Model 57: all cast iron construction with a cast iron impeller.  
Model 59: bronze switch case, motor and pump housing, a plastic impeller and base. Model 55: bronze construction with a bronze impeller.  
Optional pump stand (P/N 10-2421).


## SELECTION GUIDE

- Integral float-operated mechanical switch, no external control required.
- Single piggyback variable level float switch or double piggyback variable level float switch. Refer to FM0477.
- See FM0712 for correct model of Electrical Alternator.
- Variable level control switch 10-743 used as a control activator with electrical alternator (3) or (4) float system.

## OPTIONAL PUMP STAND P/N 10-2421

- Reduces potential clogging by debris
- Replaces rocks or bricks under the pump
- Made of durable, non-corrosive ABS
- Raises pump 2" (5 cm) off bottom of basin
- Provides the ability to raise/lower by adding sections of 1 1/2" or 2" (38.4 or 50.8 mm) PVC piping
- Attaches securely to pump
- Accommodates pump, dewatering and effluent applications

NOTE: Make sure float is free from obstruction.

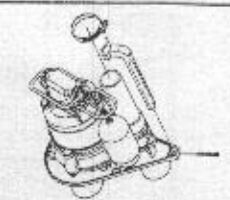

**CAUTION** All installation of controls, protection devices and wiring should be done by a qualified licensed electrician. All electrical and safety codes should be followed including the most recent National Electrical Code (NEC) and the Occupational Safety and Health Act (OSHA).

© Copyright 2020 Zoeller® Co. All rights reserved.  
502-778-2731 | 800-928-7867 | 3549 Cane Run Road | Louisville, KY 40211-1961 | zoellerpumps.com

Professional Certification. I hereby certify that these documents were prepared or approved by me, and that I am a duly licensed professional engineer under the laws of the State of Maryland. License No. 45577, Expiration Date: 06-08-2022.



## BENCHMARK

ENGINEERS • LAND SURVEYORS • PLANNERS

ENGINEERING, INC.  
8480 BALTIMORE NATIONAL PIKE SUITE 315  
ELLICOTT CITY, MARYLAND 21043  
(P) 410-465-6105 • (F) 410-465-6644

WWW.BE-CIVILENGINEERING.COM


BUILDER:  
CARUSO HOMES  
2120 BALDWIN AVE  
SUITE 200  
CROFTON MD, 21114  
301-832-2018

OWNER:  
WASIM AND SHEHLLA KHAN  
10223 RUTLAND ROUND ROAD  
COLUMBIA, MD 21044


PROJECT:	RIVERWOOD LOT 74	
LOCATION:	TAX MAP: 29, GRID: 4, PARCEL: 20, ZONED: RC-DED 11225 WHITHORN WAY ELLICOTT CITY MD 21042 THIRD ELECTION DISTRICT, HOWARD COUNTY, MD, TAX ID #03-351637	
TITLE:	ONSITE SEWAGE DISPOSAL SYSTEM (OSDS) DESIGN PLAN	
HOUSE TYPE:	KINGSPORT MODEL	
DATE:	SEPT., 2021	PROJECT NO. 3073
SCALE:	AS SHOWN	DRAWING 3 OF 4

J:\1950 RIVERWOOD HSES\dwg\8011 Lot 74 OSDS, 9/21/2021 9:50:10 AM



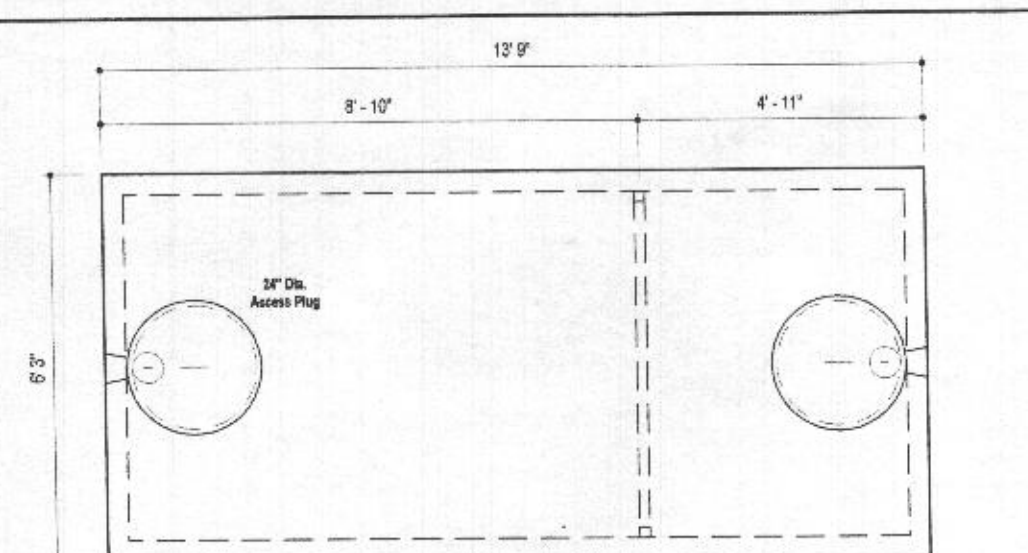

PLAN VIEW

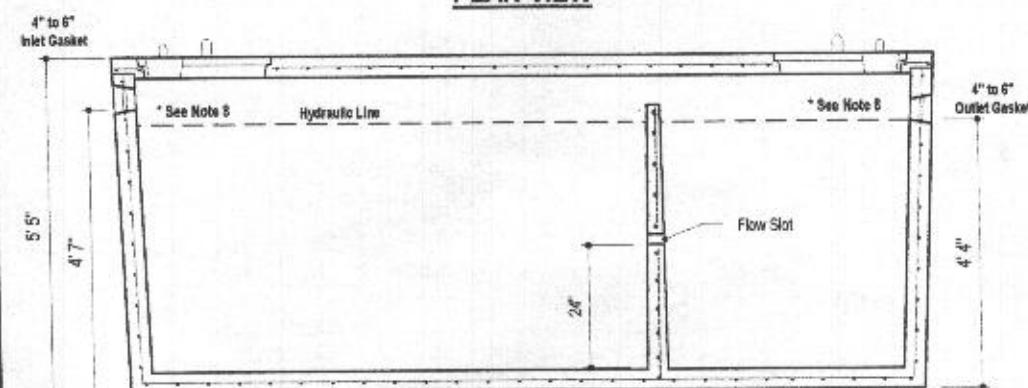

SECTION A-A

DESIGN DATA & GENERAL NOTES

- [1] Concrete strength f' = 4,000 p.s.i. @ 28 days. Density = 150 pcf.
- [2] Cement - Portland Type III per ASTM C 150-92.
- [3] Admixtures & plasticizers per ASTM C 260-98 & C 494-92.
- [4] Reinforcing per ASTM A193. Min. 1-1/2" cover.
- [5] Top slab sealed with butyl rope mastic.
- [6] 4" wall, 4" base, & 6" top thickness.
- [7] Max 3' of cover.
- [8] Depending on use of tank, Inlet & Outlet baffles may be required by code.

**MBI**  
Mayer Bros., Inc.

6264 Race Road  
Elkridge, Maryland 21075  
Tel. 410.796.1434  
Fax. 410.796.1438

www.mayerbrosprecast.com


**2,000 GALLON SEPTIC TANK  
2-Compartment**

Stock Item [Approx. 19,900 lbs]


Dwg. No. 2000-2C

No Scale

Aug 11, 2008

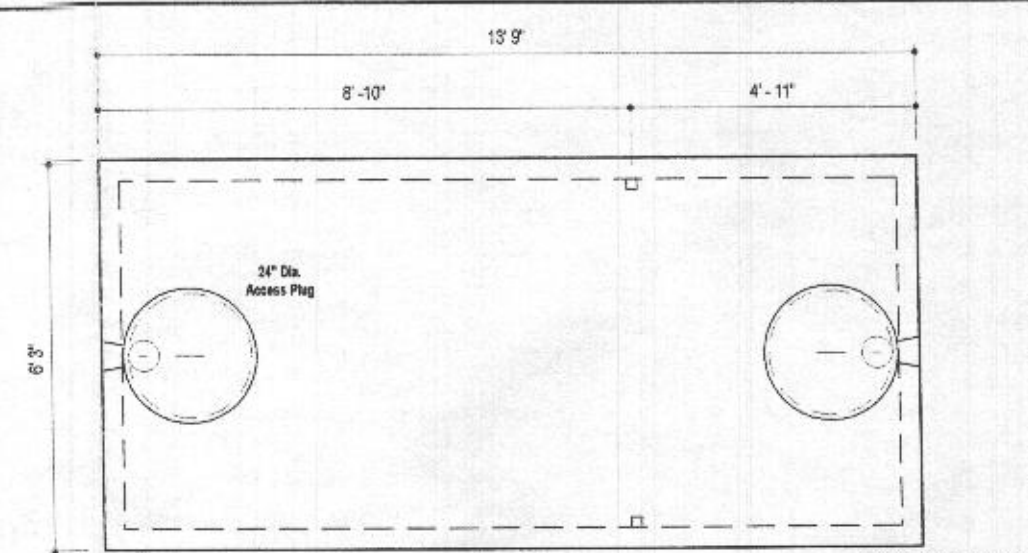

PLAN VIEW

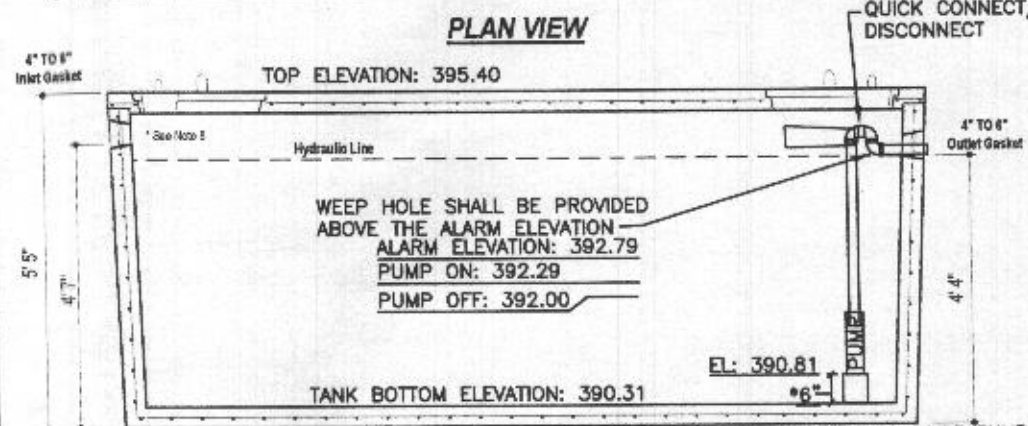

SECTION A-A

DESIGN DATA & GENERAL NOTES

- [1] Concrete strength f' = 4,000 p.s.i. @ 28 days. Density = 150 pcf.
- [2] Cement - Portland Type III per ASTM C 150-92.
- [3] Admixtures & plasticizers per ASTM C 260-98 & C 494-92.
- [4] Reinforcing per ASTM A193. Min. 1-1/2" cover.
- [5] Top slab sealed with butyl rope mastic.
- [6] 4" wall, 4" base, & 6" top thickness.
- [7] Max 3' of cover.
- [8] Depending on use of tank, Inlet & Outlet baffles may be required by code.

Float Tree:	Elev.	Relative to Bottom
Bottom of Tank	390.31	
Top of Pump	391.67	1' 4 3/8"
Pump Off	392.00	1' 8 1/4"
Pump On	392.29	1' 11 13/16"
High Alarm	392.79	2' 5 13/16"

WEIGHT = 19,000 lbs.

**MBI**  
Mayer Bros., Inc.

6264 Race Road  
Elkridge, Maryland 21075  
Tel. 410.796.1434  
Fax. 410.796.1438

www.mayerbrosprecast.com

**2,000 GALLON SEPTIC TANK  
1-Compartment**

Stock Item [Approx. 19,000 lbs]

Dwg. No. 2000-1C

No Scale

Aug 11, 2008

Professional Certification. I hereby certify that these documents were prepared or approved by me, and that I am a duly licensed professional engineer under the laws of the State of Maryland. License No. 45577, Expiration Date: 06-08-2022.



**BENCHMARK**

ENGINEERS LAND SURVEYORS PLANNERS

**ENGINEERING, INC.**

8480 BALTIMORE NATIONAL PIKE SUITE 315  
ELLCOTT CITY, MARYLAND 21043  
(P) 410-465-6105 (F) 410-465-6644

WWW.BEI-CVLENGINEERING.COM

Approved Septic System Plan  
Howard County Health Department

Approved

Signature

9/24/21  
Date

PROJECT:

**RIVERWOOD  
LOT 74**

LOCATION: TAX MAP: 29, GRID: 4, PARCEL: 20, ZONED: RC-DEO  
11225 WHITHORN WAY  
ELLCOTT CITY MD 21042

THIRD ELECTION DISTRICT, HOWARD COUNTY, MD, TAX ID #03-351637

TITLE: **ONSITE SEWAGE DISPOSAL SYSTEM  
(OSDS) DESIGN PLAN**

HOUSE TYPE:

**KINGSPORT MODEL**

DATE:

SEPT., 2021

PROJECT NO.

3073

SCALE:

AS SHOWN


DRAWING

4

OF

4



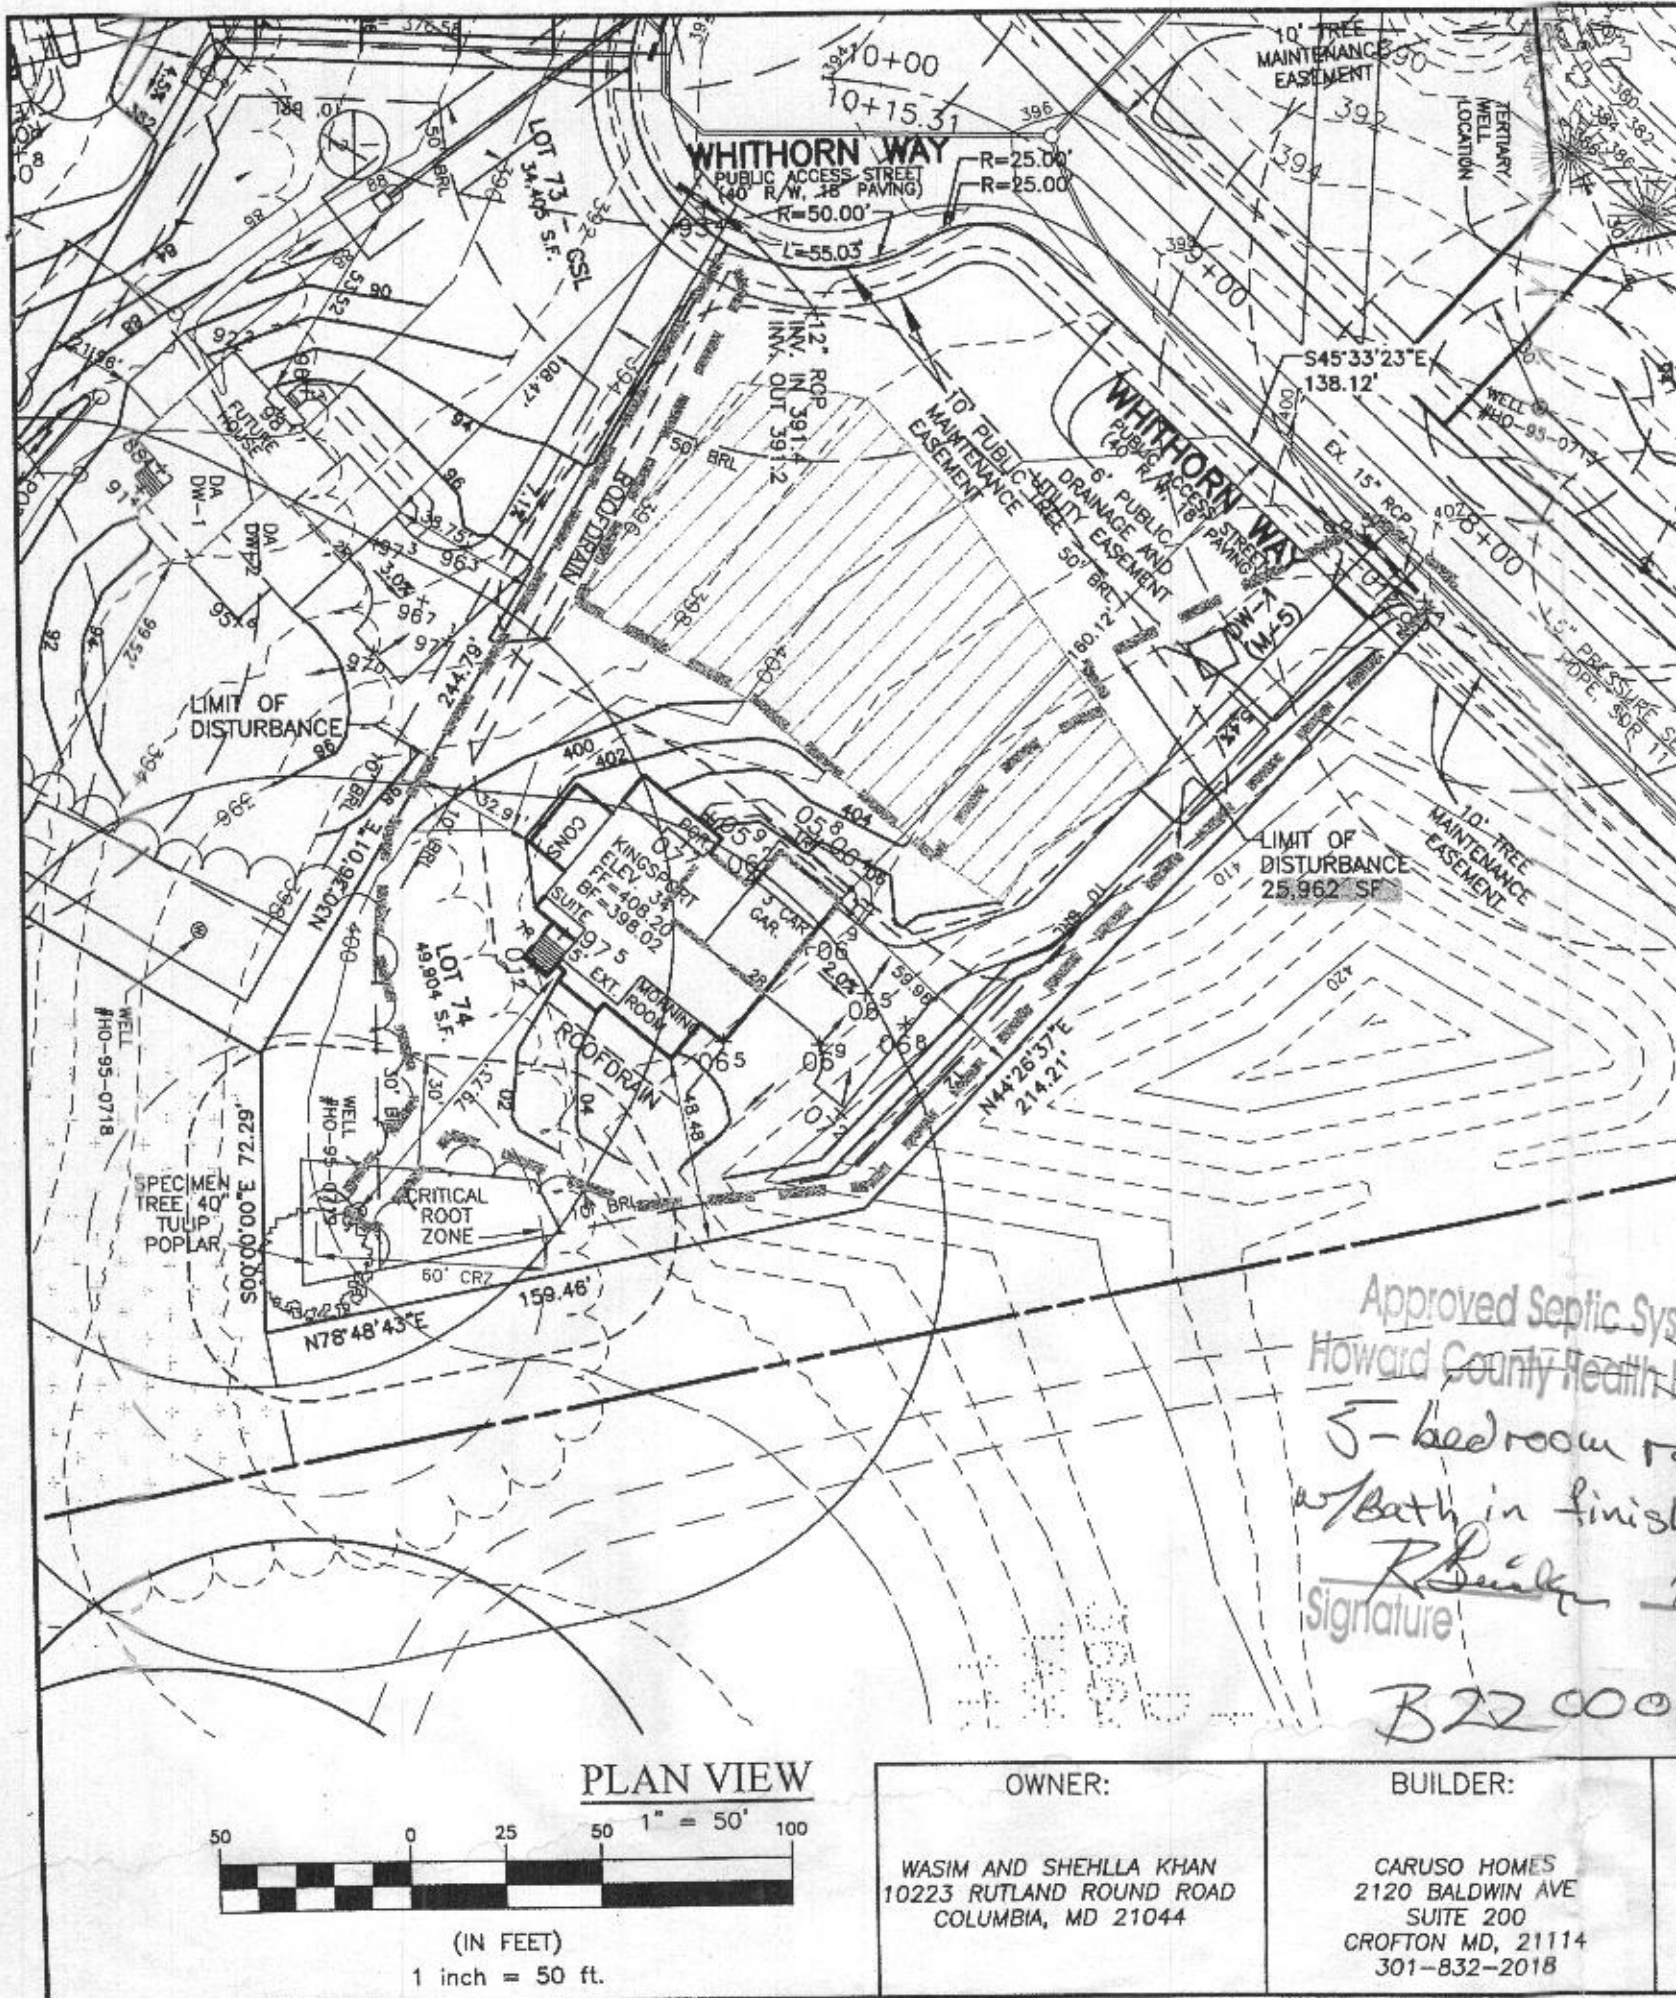


### LEGEND

- EXISTING CONTOURS ESTABLISHED UNDER F-04-082
- FIELD SURVEYED WELL LOCATION
- EXISTING APPROVED SEWAGE DISPOSAL AREA
- LIMIT OF DISTURBANCE

GRID NORTH

### BUILDING PERMIT PLAN NOTES:

1. THE LOT SHOWN HEREON WAS RECORDED ON THE PLAT FOR RIVERWOOD, PHASE 2, PLAT Nos. 19720-19726. REFER TO THE PLATS FOR LOT DIMENSIONS, LOT AREAS, ALL EASEMENTS AND CONDITIONS.
2. SEDIMENT AND EROSION CONTROLS, THE STANDARD PLAN USAGE, WERE APPROVED BY HOWARD SOIL CONSERVATION.
3. TOPOGRAPHY SHOWN HEREON IS TAKEN FROM THE APPROVED ROAD CONSTRUCTION PLANS AND INCLUDES HOWARD COUNTY GIS, FIELD RUN TOPOGRAPHY BY J.A. RICE, INC., AND DESIGN GRADING FROM THE ROAD CONSTRUCTION PLANS.
4. ALL SEDIMENT AND EROSION CONTROL FEATURES USED ON THIS SITE SHALL COMPLY WITH THE 2011 MARYLAND STANDARDS AND SPECIFICATIONS FOR SOIL EROSION AND SEDIMENT CONTROL.
5. ALL DRAINAGE AND STORMWATER MANAGEMENT FEATURES USED ON THIS SITE MUST COMPLY WITH THE APPROVED ROAD CONSTRUCTION PLANS EXCEPT AS WAIVED.
6. THE EXISTING WELL SHOWN ON THIS PLAN, HO-95-0719, HAS BEEN FIELD LOCATED BY BENCHMARK ENGINEERING, INC., AND IS ACCURATELY SHOWN.
7. THERE ARE NO EXISTING WELLS OR SEPTIC SYSTEMS WITHIN 100' OF THIS PROJECT'S BOUNDARY EXCEPT AS NOTED.
8. ANY CHANGES TO A PRIVATE SEWAGE DISPOSAL AREA OR WELL BOX SHALL REQUIRE A REVISED PERCOLATION CERTIFICATION PLAN.
9. STORMWATER MANAGEMENT FOR THIS LOT WAS DESIGNED AND PROVIDED BY ONE DRY WELL FACILITY AND THE EXISTING MICROPOOL ED FACILITY.
10. THE DRIVEWAY CULVERT FOR THIS LOT WAS INSTALLED UNDER THE ROAD CONSTRUCTION PLANS.

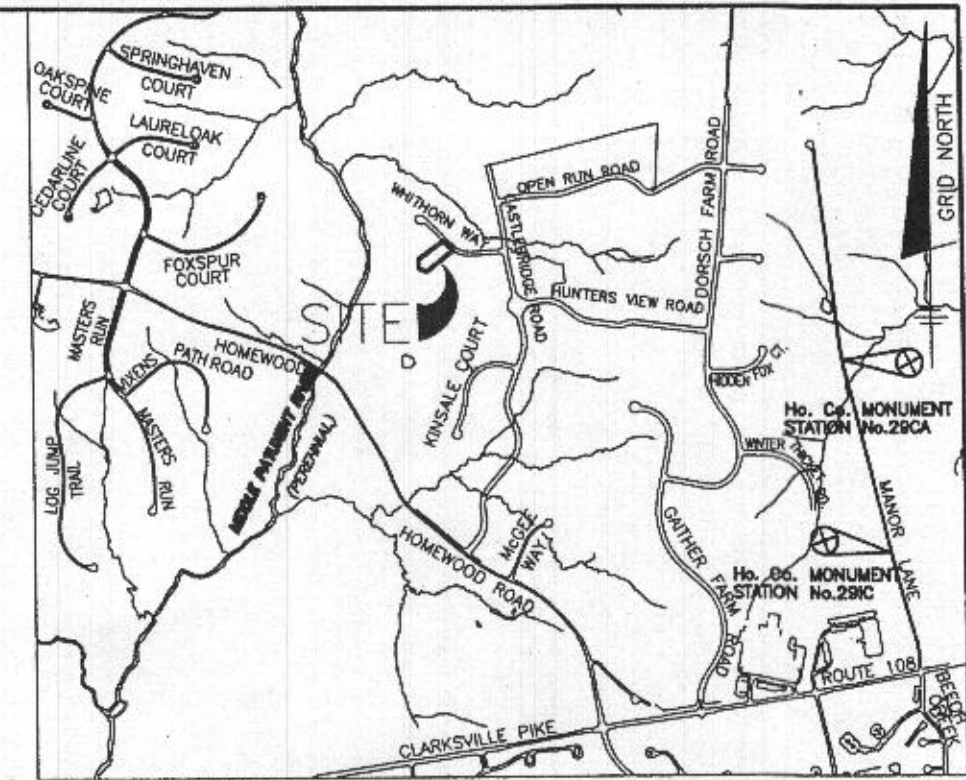

Approved Septic System Plan  
Howard County Health Department  
5-bedroom residence  
w/ Bath in finished basement area  
Signature: *R. B. B.* Date: 1/24/2022  
B22000071

OWNER:	BUILDER:	BENCHMARK
WASIM AND SHEHLLA KHAN 10223 RUTLAND ROUND ROAD COLUMBIA, MD 21044	CARUSO HOMES 2120 BALDWIN AVE SUITE 200 CROFTON MD, 21114 301-832-2018	ENGINEERS LAND SURVEYORS PLANNERS <b>ENGINEERING, INC.</b> 8480 BALTIMORE NATIONAL PIKE SUITE 315 ELLICOTT CITY, MARYLAND 21043 (P) 410-465-6105 (F) 410-465-6644 WWW.BE-CIVILENGINEERING.COM

PROJECT:	RIVERWOOD, PHASE 2 LOT 74		
LOCATION:	TAX MAP: 29, GRID: 4, PARCEL: 20, ZONED: RC-DEO 11225 WHITHORN WAY ELLICOTT CITY MD 21042 THIRD ELECTION DISTRICT, HOWARD COUNTY, MD, TAX ID #03-351637		
TITLE:	BUILDING PERMIT PLAN		
HOUSE TYPE:	KINGSPORT MODEL		
DATE:	NOV., 2021	PROJECT NO.	3073
SCALE:	AS SHOWN	DRAWING	1 OF 2