

7/20/78
1:30 p.m.

APPLICATION

A 28425

SEWAGE DISPOSAL TESTING

P _____

STATE OF MARYLAND - DEPARTMENT OF HEALTH AND MENTAL HYGIENE 1000 gallons
DISTRICT 4th

HOWARD COUNTY HEALTH DEPARTMENT
ENVIRONMENTAL HEALTH SERVICES
P. O. BOX 476, ELLICOTT CITY, MARYLAND 21043
TELEPHONE: 465-5000, EXT. 356

Septic Tank { 1-3 Bedrooms
4 Bedrooms
DATE 7/6/78 1250 gallons

Dry well to have 125 sq ft effective absorbent sidewall area per bedroom below inlet. Inlet to be 3' below original grade and maximum depth 8'. Location per engineer's plat 500' down right property line section being 1245' in length from point of turn of line 313' and line 1245' and 145' in from right property line when of dry well & trench used

TO: THE COUNTY HEALTH OFFICER
ELLICOTT CITY, MARYLAND

Spacing lot from Watersville Road. need: (1) 5' earth buffer between trench & dry well.

I, HEREBY, APPLY FOR THE NECESSARY TEST IN ORDER TO CONSTRUCT (OR RECONSTRUCT) A SEWAGE DISPOSAL SYSTEM.

PROPERTY OWNER Wyse S. Taylor

ADDRESS Rt. 5 Box 316, Mt. Airy, Md PHONE 489-4148

PROPERTY LOCATION: (2) 2 inspections of trench - before & after stone in trench.
SUBDIVISION _____ LOT NO. _____

ROAD AND DESCRIPTION Watersville Rd - Howard Co. - just before Blooms Lane.

SIZE OF LOT existing farm house - 19 acres TYPE BLDG. 2
NUMBER OF BEDROOMS _____

IF NOT SINGLE RESIDENCE DESCRIBE " _____

THE SYSTEM INSTALLED UNDER THIS APPLICATION IS ACCEPTABLE ONLY UNTIL PUBLIC FACILITIES BECOME AVAILABLE.

SIGNATURE OF APPLICANT Elizabeth Taylor


APPROVED BY C. B. Streaker FOR Dry well & trench DATE 10/5/78
(KIND OF SYSTEM)

REJECTED BY _____ FOR _____ DATE _____
(KIND OF SYSTEM)

HOLD PENDING FURTHER TESTS _____ DATE _____

7/20/78 REASONS FOR REJECTION OR HOLDING for certified holes by engineer
9/5/78 Certified holes reviewed by C.B.S. C.B.S.

THIS IS NOT A PERMIT

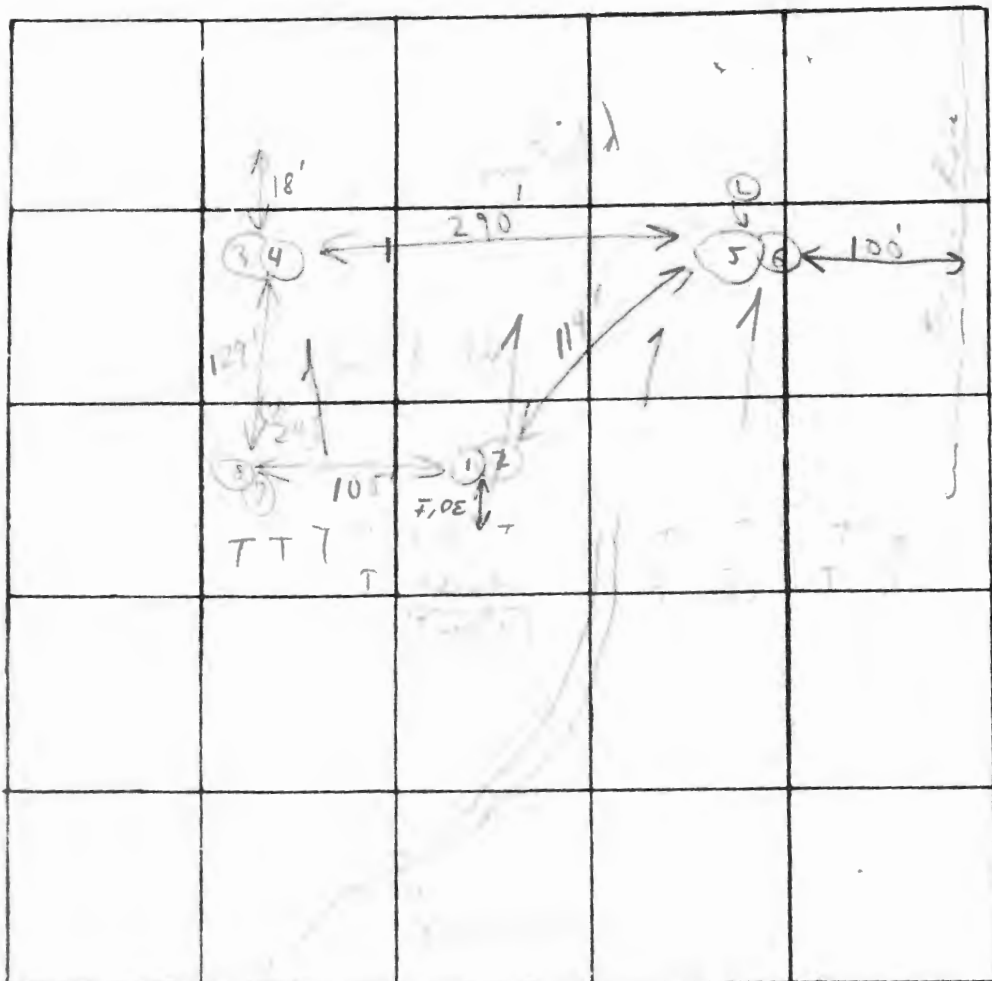

Field sheet

INDICATE NORTH - NAME ADJOINING ROADWAY AS BASE LINE

DATE	TEST NO.	DEPTH	PRE-WET		TEST - 1" DROP		TIME
			START	STOP	START	STOP	
1/12/78	(4)	3'	1:16	1:21	1:21	1:30	9
	2 (H)	10 1/2'	1:17	1:19	1:19	1:24	5
	3	3'	1:32	1:33	1:33	1:34	2
	4	10 1/2'	1:33	1:35	1:35	1:37	2
	5	4'	1:40	1:42	1:42	1:45	3
	6	12'	1:40	1:42	1:42	1:44	2
	7	9'			3:00		
	8	3'	1:22	1:23	1:23	1:25	2
	(H) 9	9 1/2'	1:23	1:25	1:25	1:28	3
							8
							28

Hole dry
2:00 1/2" +
water still
in bottom
More
po
3 minutes on
Inlet 3'

REMARKS

TYPE OF SOIL

TESTED BY C. B. E.

ALSO PRESENT

2 1/2" Ricker

7/20/78

To: Office W.S. Taylor property
From: C. B. Streaker
Re: & Memo below concerning perc test - hole - certification

HOWARD COUNTY HEALTH DEPARTMENT

P. O. BOX 476
ELLCOTT CITY, MARYLAND 21043
TELEPHONE 465-5000

January 19, 1978

MEMORANDUM


TO: All Sanitarians
FROM: Donald W. Monaghan
RE: Perc Test and Field Location of test pits

If you require test pits to be field located you shall inform the owner and the engineer in the field at time of testing and by mail (3 copies - one for owner, one for engineer and one for our records) that:

1. Approval for lot or lots will not be granted until all perc pits are field located;
2. Field location of pits must be received by this office within two (2) months after perc tests are completed; and
3. If necessary information is not received within the prescribed time frame this department may require re-perc of the property.

DWM:hs

7/20/78 Note - gave owner & engineer's copy to Mr. Picketts
boys to give to owner.
C.B.S.

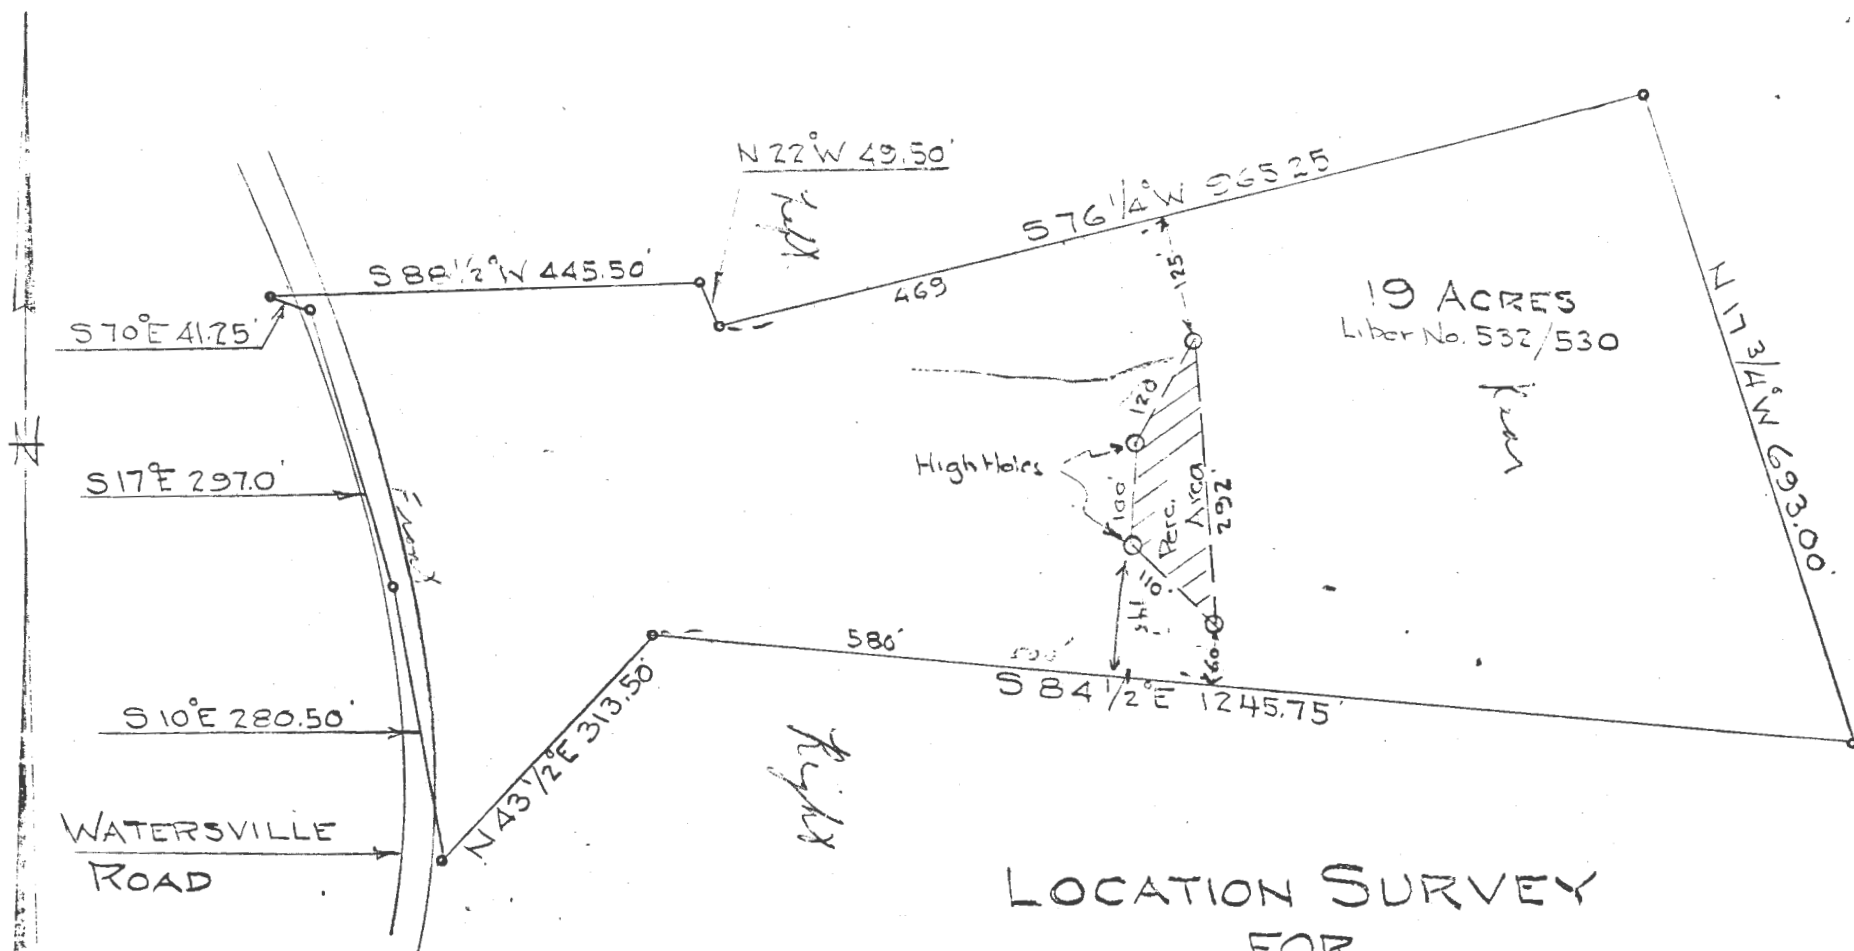

LOCATION SURVEY
FOR
WYSE TAYLOR
FOURTH ELECTION DIST., HOWARD CO.
MT. AIRY, MARYLAND
SCALE: 1 IN. = 200 FT. AUGUST 2, 1978

* Denotes percolation test area as field located.
Note: The lot shown hereon complies with the
minimum ownership and lot area as required by the
Maryland State Dept. of Health & Mental Hygiene

Approved: Private Water & Private Sewer

Wm. Boykin 9-6-78

Filed for Record
AUG 10 1978
HOWARD CO. CLERK