

# APPLICATION

SEWAGE DISPOSAL TESTING

A 16379

P \_\_\_\_\_

## MARYLAND STATE DEPARTMENT OF HEALTH

HOWARD COUNTY *Septic Tank 1000 gallon 3 bedroom* ELLICOTT CITY

DISTRICT 6

DATE 10/13/71

*10/13/71 9:30*  
*Dry Well to have { 300 ft effective absorption sidewall area 3 bedroom*  
*400 ft effective absorption sidewall area 4 bedroom*  
*below inlet. Inlet to be 4' below original grade and*  
*maximum depth 11' for dry well below original grade. Located*  
*at 25' from back property line and 37' from right side*  
*property line as seen when facing lot from Rt 195*

TO: THE COUNTY HEALTH OFFICER  
ELLICOTT CITY, MARYLAND

I, HEREBY, APPLY FOR THE NECESSARY TESTS IN ORDER TO CONSTRUCT (OR RECONSTRUCT) A SEWAGE DISPOSAL SYSTEM.

PROPERTY OWNER Andrew Handy & wife

ADDRESS 5470 Waterloo Road, Ellicott City, Md. PHONE 465-7729

PROPERTY LOCATION:

SUBDIVISION \_\_\_\_\_ LOT NO. 1  
beside 5470

ROAD AND DESCRIPTION Waterloo Road - 2 lots beyond Mrs. Hilera Cooper (where  
Old Annapolis Road & Waterloo Road meet)

OCCUPANT \_\_\_\_\_ PHONE \_\_\_\_\_

PERSON TO CONSTRUCT SYSTEM \_\_\_\_\_

ADDRESS \_\_\_\_\_ PHONE \_\_\_\_\_

SIZE OF LOT 1/2 ~~1.000~~ acres TYPE BLDG. 3 or 4  
NUMBER OF BEDROOMS  
(Single Fmly. Dwllg.)

IF NOT SINGLE RESIDENCE DESCRIBE \_\_\_\_\_

SIGNATURE OF APPLICANT /s/ Ernest Robinson

(X) APPROVED BY C. Stucker FOR Dry Well DATE Nov. 1, 1971  
(KIND OF SYSTEM)

REJECTED BY \_\_\_\_\_ FOR \_\_\_\_\_ DATE \_\_\_\_\_  
(KIND OF SYSTEM)

HOLD PENDING FURTHER TESTS \_\_\_\_\_ DATE \_\_\_\_\_

REASONS FOR REJECTION OR HOLDING ⊗ Approved if hole 142 are  
used for primary. C.B.D.

# THIS IS NOT A PERMIT

# APPLICATION

SEWAGE DISPOSAL TESTING

A 16379

P

## MARYLAND STATE DEPARTMENT OF HEALTH

HOWARD COUNTY

ELLICOTT CITY

DISTRICT 6

DATE 10/13/71

Dry Well to have 300" x 300" x 300" (3' x 3' x 3')

below inlet maximum depth 1' for dry well located at 20' from back property line and 30' from right side property line as seen when facing lot from Rt 175

TO: THE COUNTY HEALTH OFFICER  
ELLICOTT CITY, MARYLAND

I, HEREBY, APPLY FOR THE NECESSARY TESTS IN ORDER TO CONSTRUCT (OR RECONSTRUCT) A SEWAGE DISPOSAL SYSTEM.

PROPERTY OWNER Andrew Handy & wife

ADDRESS 5470 Waterloo Road, Ellicott City, Md. PHONE 465-7729

PROPERTY LOCATION:

SUBDIVISION beside 5470 LOT NO. 1  
ROAD AND DESCRIPTION Waterloo Road - 2 lots beyond Mrs. Hilaria Cooper (where Old Annapolis Road & Waterloo Road meet)

OCCUPANT PHONE

PERSON TO CONSTRUCT SYSTEM ADDRESS 20.01 00.01 00.01 87.9 5.11 PHONE 1 11/1/01

SIZE OF LOT 28.01 23.01 26.01 06.01 TYPE BLDE 3 or 4 (NUMBER OF BEDROOMS (Single Fmly. Dwllg.))

IF NOT SINGLE RESIDENCE DESCRIBE 10.32 10.32 14 4

SIGNATURE OF APPLICANT Ernest Robinson


APPROVED BY C. O. Stecker FOR Dry Well DATE Nov 1, 1971

REJECTED BY FOR (KIND OF SYSTEM) DATE

HOLD PENDING FURTHER TESTS DATE

REASONS FOR REJECTION OR HOLDING Approved if hole 142 are used for primary system C.B.S.

THIS IS NOT A PERMIT

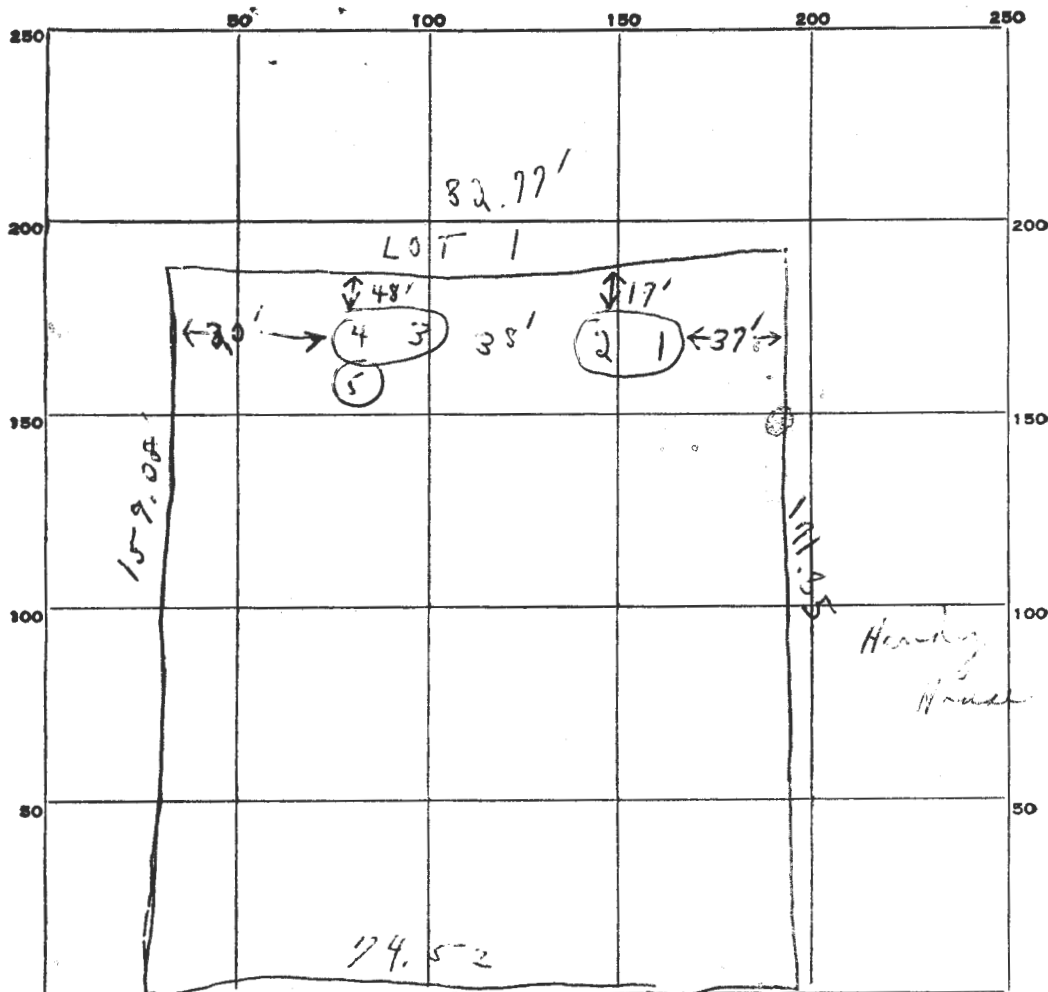

INDICATE NORTH. - NAME ADJOINING ROADWAY AS BASE LINE.

114. Kte. 175

| DATE     | TEST NO. | DEPTH                             | PRE-WET |       | TEST - 1" DROP                      |       | TIME  |
|----------|----------|-----------------------------------|---------|-------|-------------------------------------|-------|-------|
|          |          |                                   | START   | STOP  | START                               | STOP  |       |
| 10/13/77 | 1        | 7 1/2'                            | 9:44    | 9:45  | 9:45                                | 9:47  | 2 min |
|          | 2        | 4 1/2'                            | 9:58    | 10:00 | 10:00                               | 10:03 | 3 min |
|          | 3        | 10'                               | 10:20   | 10:23 | 10:23                               | 10:26 | 3 min |
|          | 4        | 4'                                | 10:35   | 10:40 | Too little perc                     |       |       |
|          | 5        | 4 1/2'                            | 10:57   | 11:12 | Too little perc (Wood, leaves more) |       |       |
|          |          | (Note 5 1/2 ft. good soil starts) |         |       |                                     |       |       |
|          |          |                                   |         |       |                                     |       |       |
|          |          |                                   |         |       |                                     |       |       |
#### SOIL AUGER FINDING

TESTED BY B. S. Outlet in at 4' Not Level

REMARKS (Hole 1 & 2) Good soil. 11 in holes 1 & 2)

^ Use

FRANKLIN P. OWENS  
RHM 312/386

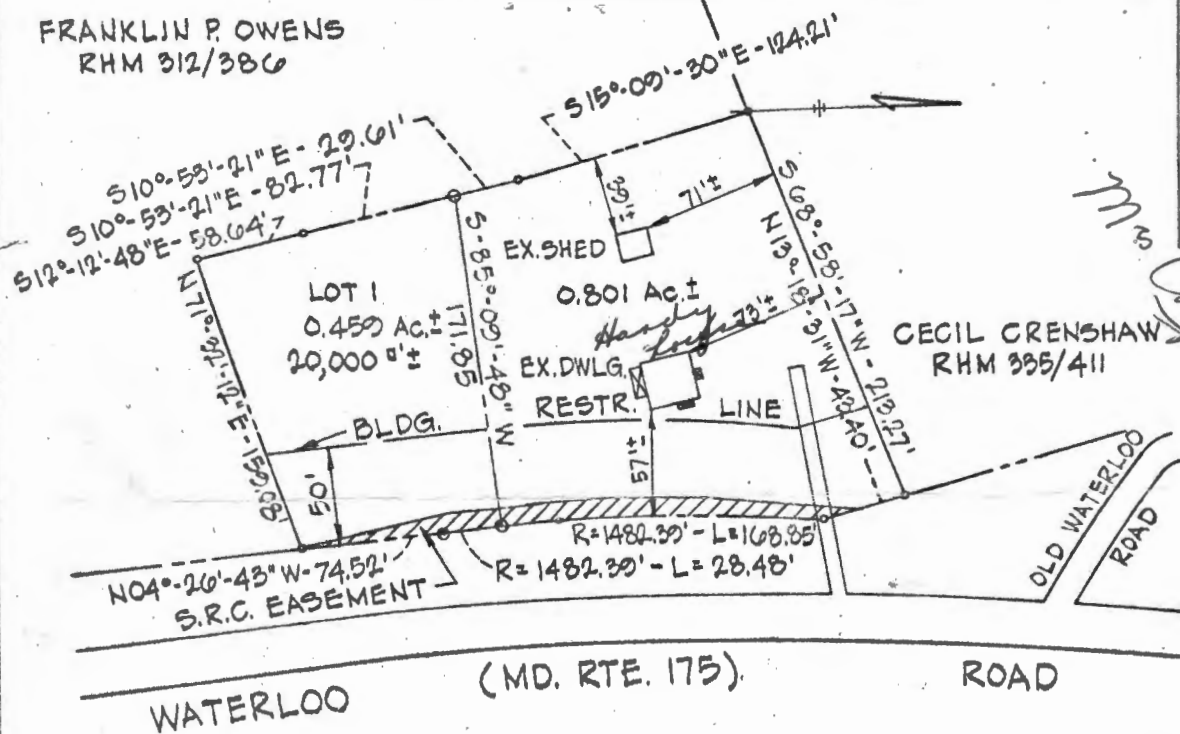

PROPERTY OF  
ANDREW HANDY

VICINITY MAP

SCALE: 1"=1200'

PROPERTY OF:  
ANDREW HANDY AND WIFE  
6TH ELECTION DISTRICT  
HOWARD COUNTY, MARYLAND  
5470 WATERLOO ROAD  
ELLCOTT CITY, MD.-21043

SCALE: 1"=100'

#### NOTES:

1. PROPERTY LOCATED ON TAX MAP NO. 31 PARCEL 248
2. ZONED R-20
3. TITLE REFERENCE: M.W.B. 223/412
4. TOTAL AREA PROPERTY: 1.260 AC.±
5. TOTAL AREA LOT: 0.459 AC.±
6. RESIDUE: 0.801 AC.±

APPROVED: PUBLIC WATER AND PRIVATE SEWER

COUNTY HEALTH OFFICER

DATE

APPROVED: DIVISION OF LAND DEVELOPMENT AND  
TRANSPORTATION PLANNING

PLANNING DIRECTOR

DATE

#### OWNER'S CERTIFICATE:

WILLIAM G. RASCH II - REG. NO. 4575

PURDUM AND JESCHKE  
ENGINEERS AND LAND SURVEYORS  
3697 PARK AVENUE  
ELLCOTT CITY, MARYLAND - 21043

I, THE UNDERSIGNED, OWNER OF THE PROPERTY SHOWN HEREON, MY HEIRS OR ASSIGNS, ADOPT THIS PLAN OF SUBDIVISION AND DO HEREBY ESTABLISH THE BUILDING SETBACK RESTRICTION LINE SHOWN HEREON IN ORDER TO COMPLY WITH THE GENERAL PLAN OF HIGHWAYS OF HOWARD COUNTY.