

APPLICATION

SEWAGE DISPOSAL TESTING

MARYLAND STATE DEPARTMENT OF HEALTH

HOWARD COUNTY

ELLICOTT CITY

DISTRICT

2

DATE

8-29-62

NEW JOB

Tile Field - 300 sqft bottom area to be

located in area that passed perc test. First trench should run between connect test hole to trench. Trench should run parallel with fence line on right side of lot.

It is O.K. to use existing septic tank only if the outlet is not exceed no more than 2 1/2 ft below ground. If it is any more than 2 1/2 ft in the ground a new Septic Tank with a capacity of 500 gal must be installed

TO: THE COUNTY HEALTH OFFICER
ELLICOTT CITY, MARYLAND

I, HEREBY, APPLY FOR THE NECESSARY TESTS IN ORDER TO CONSTRUCT (OR RECONSTRUCT) A SEWAGE DISPOSAL SYSTEM.

PROPERTY OWNER W. R. Hall

ADDRESS Waterloo Rd. PHONE _____

PROPERTY LOCATION:

SUBDIVISION _____ LOT NO. _____

ROAD AND DESCRIPTION Waterloo Road 10 or 12 house below Montgomery Road
shutters

House with blue shutters on the right hand side of the road

OCCUPANT _____ PHONE _____

PERSON TO CONSTRUCT SYSTEM _____

ADDRESS _____ PHONE _____

SIZE OF LOT _____ TYPE BLDG. bathroom
NUMBER OF BEDROOMS

IF NOT SINGLE RESIDENCE DESCRIBE _____

SIGNATURE OF APPLICANT _____


APPROVED BY Donald W. Monaghan FOR Tile Field DATE 8-29-62
(KIND OF SYSTEM)

REJECTED BY _____ FOR _____ DATE _____
(KIND OF SYSTEM)

HOLD PENDING FURTHER TESTS _____ DATE _____

REASONS FOR REJECTION OR HOLDING _____

THIS IS NOT A PERMIT

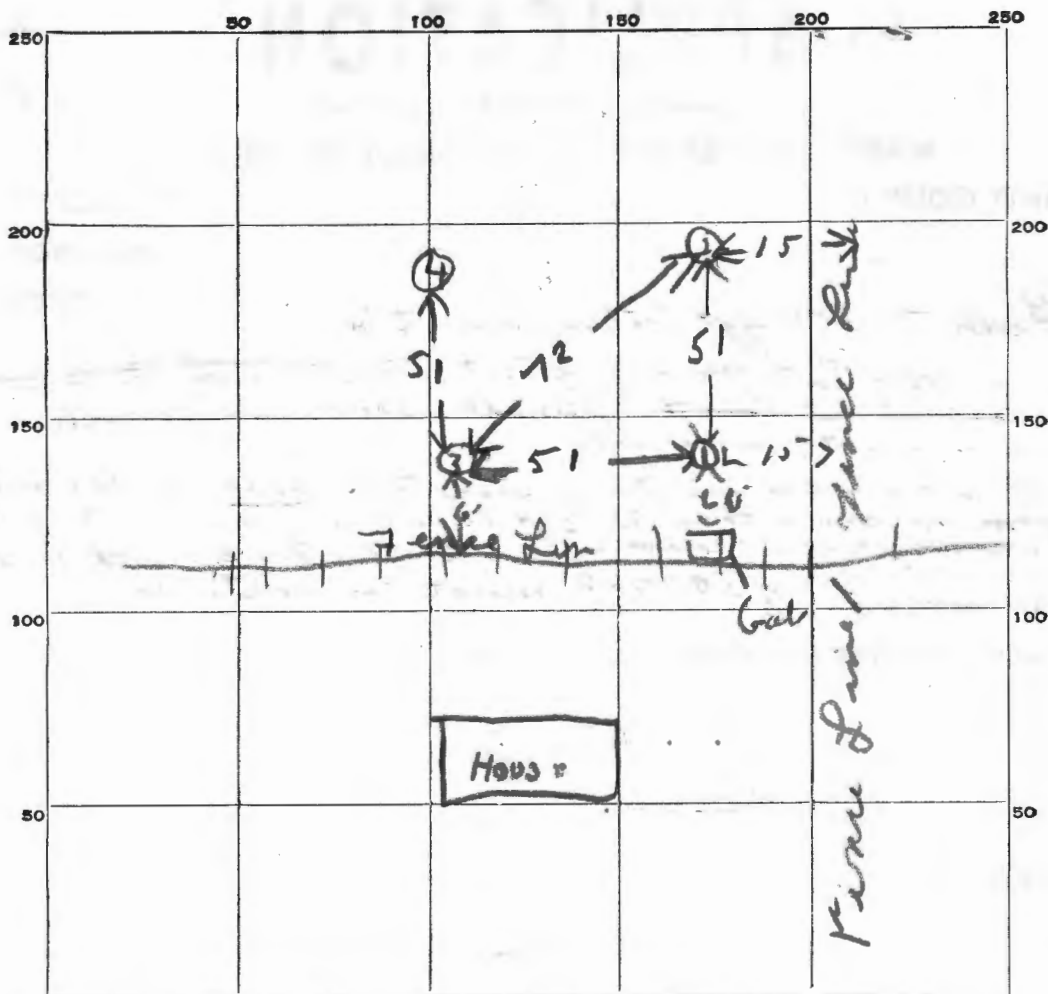

WATERLOO RIVER

[illegible]

SOIL AUGER FINDING.

TESTED BY.

REMARKS.

ALSO PRESENT

LOT NO.