

APPLICATION

SEWAGE DISPOSAL TESTING

A 14489

P _____

MARYLAND STATE DEPARTMENT OF HEALTH

HOWARD COUNTY *Leptis Tank-750 gal*

ELLICOTT CITY

DISTRICT 3

DATE 5/7/69

*Dry Well - 300 sq ft absorbent sidewalk
area to begin below the inlet.*

*Locate dry well either 37 ft or 81 ft
off. Lept property line and 85 ft in*

*back of existing house as seen from Woodstock Rd.
New system can be tied to existing
dry well if desired.*

TO: THE COUNTY HEALTH OFFICER
ELLICOTT CITY, MARYLAND

I, HEREBY, APPLY FOR THE NECESSARY TESTS IN ORDER TO CONSTRUCT (OR RECONSTRUCT) A SEWAGE DISPOSAL SYSTEM.

PROPERTY OWNER Albert Lee Taylor & Olive Taylor

ADDRESS Old Court Road, Woodstock, Md. PHONE DA 8-2606

PROPERTY LOCATION:

SUBDIVISION _____ LOT NO. _____

ROAD AND DESCRIPTION Woodstock Road - across from Woodstock P. O. - 1 house and
then Mr. Taylor's property -

OCCUPANT _____ PHONE _____

PERSON TO CONSTRUCT SYSTEM _____

ADDRESS _____ PHONE _____

SIZE OF LOT 2 1/2 acres TYPE BLDG. 3

NUMBER OF BEDROOMS

IF NOT SINGLE RESIDENCE DESCRIBE Duplex house to be attached
to existing home - for the
purpose of renting other house

SIGNATURE OF APPLICANT Albert Lee Taylor

✓ APPROVED BY Robert V. Toner FOR Dry Well DATE 5/15/69

(KIND OF SYSTEM)


REJECTED BY _____ FOR _____ DATE _____

(KIND OF SYSTEM)

HOLD PENDING FURTHER TESTS _____ DATE _____

REASONS FOR REJECTION OR HOLDING _____

THIS IS NOT A PERMIT

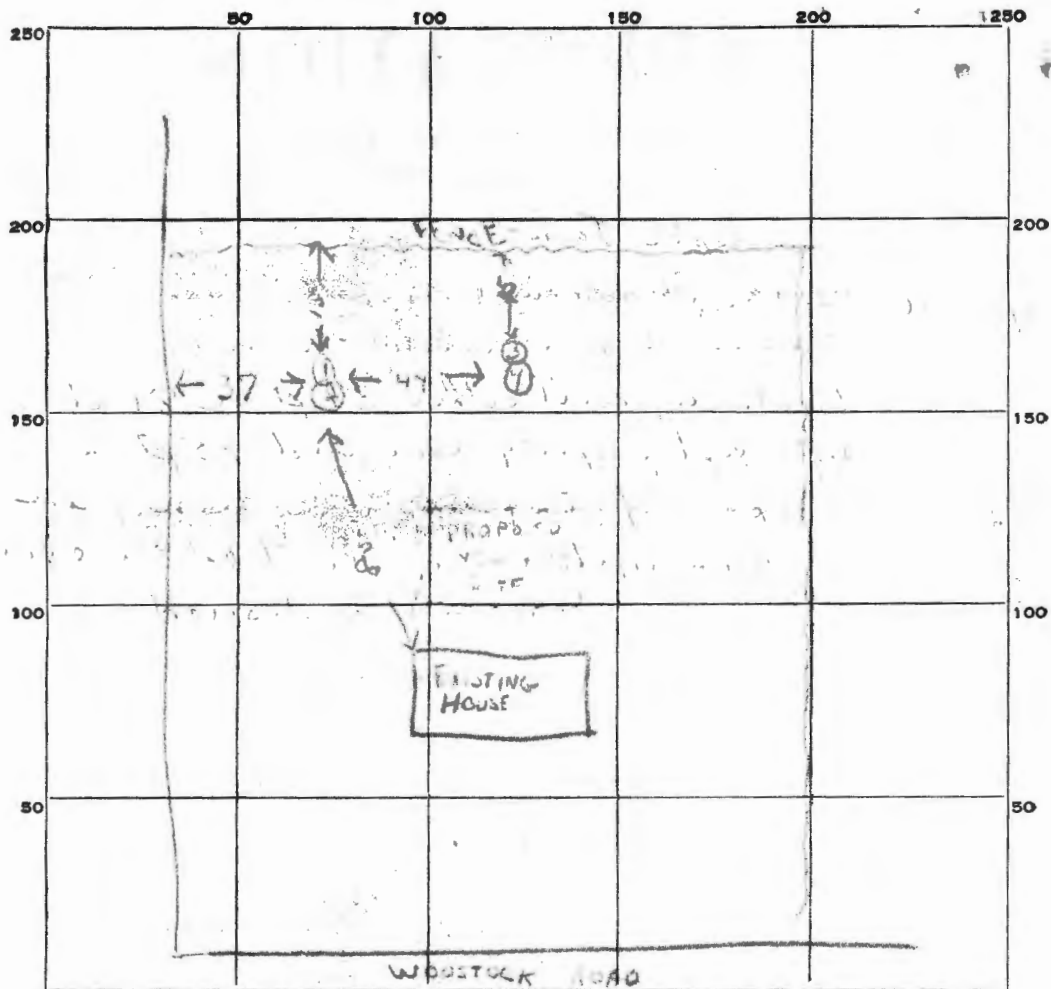

DATE	TEST NO.	DEPTH	PRE-WET		TEST - 1" DROP		TIME
			START	STOP	START	STOP	
5/15/69	91	9 ft	9 33	9 35	9 35	9 37	2 min
	2	4 1/2 ft	9 37	9 38	9 38	9 40	2 min
	3	9 ft	9 44	9 46	9 46	9 48	2 min
	4	4 1/2 ft	9 51	9 52	9 52	9 54	1 min
	Hole No. 1 dug to 13 ft bad soil.						

SOIL AUGER FINDING

TESTED BY A. Toms

REMARK

APPLICATION

A 14489

P _____

SEWAGE DISPOSAL TESTING

MARYLAND STATE DEPARTMENT OF HEALTH

HOWARD COUNTY

Septic Tank 750 gal.

ELLICOTT CITY

DISTRICT 3DATE 5/7/69*Dry Well - 300 sq ft. absorbent sidewalk
area to begin below the inlet.**Locate dry well either 37 ft or 81 ft.
off. left property line and 85 ft in**back of existing house as seen from Woodstock Rd.**New system can be tied to existing
dry well if desired.*TO: THE COUNTY HEALTH OFFICER
ELLICOTT CITY, MARYLANDI, HEREBY, APPLY FOR THE NECESSARY TESTS IN ORDER TO CONSTRUCT (OR RECONSTRUCT) A SEWAGE
DISPOSAL SYSTEM.PROPERTY OWNER Albert Lee Taylor & Olive TaylorVOID 12/13/85 SEE
NEW SPECADDRESS Old Court Road, Woodstock, Md.PHONE DA 8-2606SHEET

PROPERTY LOCATION:

SUBDIVISION _____

LOT NO. _____

ROAD AND DESCRIPTION Woodstock Road - across from Woodstock P. O. - 1 house and
then Mr. Taylor's property -

OCCUPANT _____

PHONE _____

PERSON TO CONSTRUCT SYSTEM _____

ADDRESS _____

PHONE _____

SIZE OF LOT 2 1/2 acres

TYPE BLDG. _____

NUMBER OF BEDROOMS

IF NOT SINGLE RESIDENCE DESCRIBE _____

Duplex house to be attached
to existing home - for the
purpose of renting other houseSIGNATURE OF APPLICANT Albert Lee TaylorAPPROVED BY Robert V. Tane

FOR

Dry Well

(KIND OF SYSTEM)

DATE

5/15/69

REJECTED BY _____

FOR _____

(KIND OF SYSTEM)


DATE _____

HOLD PENDING FURTHER TESTS _____

DATE _____

REASONS FOR REJECTION OR HOLDING _____

THIS IS NOT A PERMIT

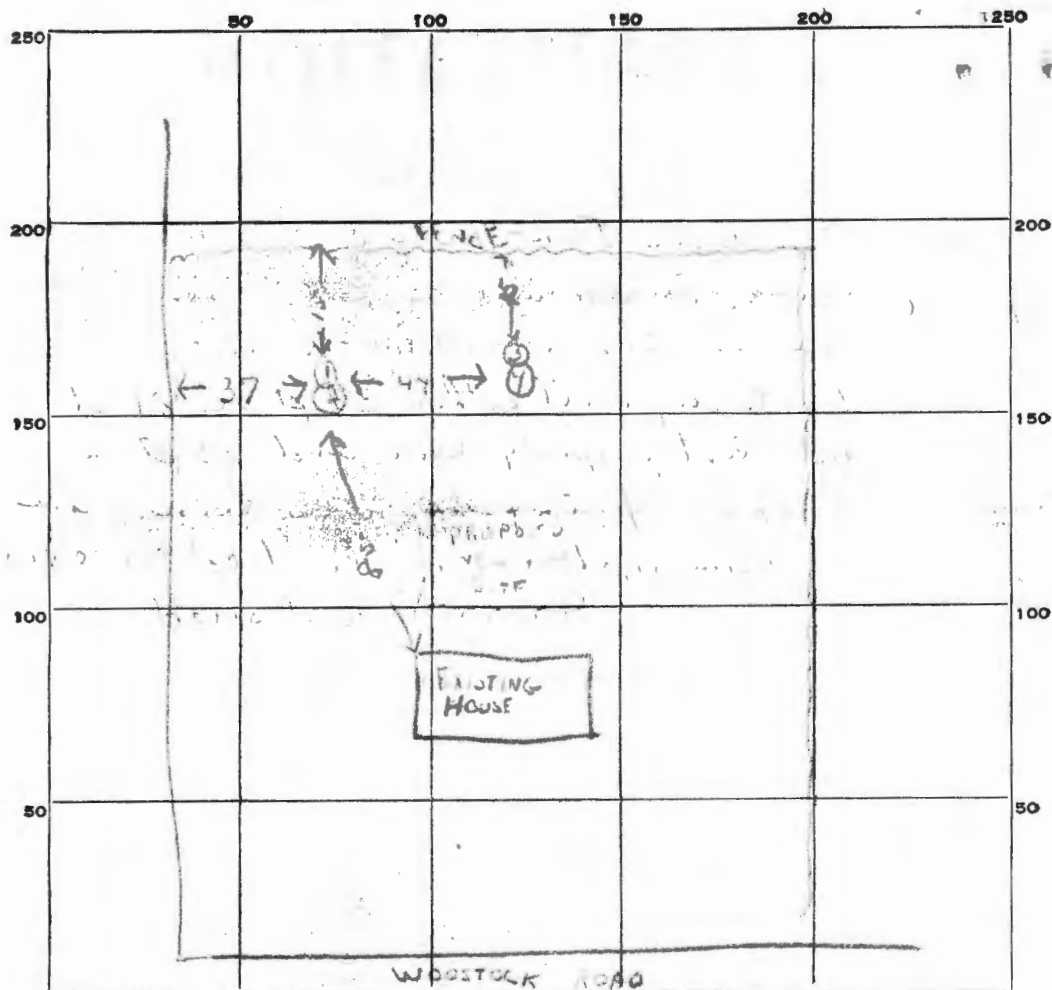

INDICATE NORTH. - NAME ADJOINING ROADWAY AS BASE LINE.

DATE	TEST NO.	DEPTH	PRE-WET		TEST - 1" DROP		TIME
			START	STOP	START	STOP	
5/15/69	91	9 ft	9 33	9 35	9 35	9 37	2 min
	2	4 1/2 ft	9 37	9 38	9 38	9 40	2 min
	3	9 ft	9 44	9 46	9 46	9 48	2 min
	4	4 1/2 ft	9 51	9 52	9 52	9 54	1 min
	Hole No. 1 dug to 13 ft hard soil.						

SOIL AUGER FINDING

5/15/69 TESTED BY R. Tonne

REMARK

A 14489

SUBDIVISION: ALBERT & OLIVE TAILOR LOT NUMBER:
WOOD STOCK RD DRY WELL OR DRY WELL AND TRENCH

		_____ sq. ft./bedroom
	<u>Septic Tank</u>	<u>Minimum Total square Feet</u>
3 bedroom	1000 gallon	_____
4 bedroom	1250 gallon	_____
5 bedroom	1500 gallon	_____

Inlet _____ feet below original grade.

Bottom maximum depth _____ feet below original grade.

Effective area begins at _____ feet below original grade.

NOTE: If trench is used to make up absorbent area, run the trench on level ground and leave a 5 foot earth buffer between dry well and trench. No trench is to exceed 100 feet in length. Trench inlet to be same as dry well, with _____ feet of stone below distribution pipe.

TRENCHES

158 sq. ft./bedroom

Trench to be 2 wide.

Inlet 3 feet below original grade.


Bottom maximum depth 10 feet below original grade.

Effective area begins at 3 feet below original grade.

7 feet of stone below distribution pipe.

- NOTE:
- (1) No trench to exceed 100 feet in length.
 - (2) If more than one trench used, a distribution box is required.
 - (3) Trenches to be installed on level ground.
 - (4) Call for inspection of trench before gravel is installed.
 - (5) Provide 6"-8" diameter cleanout and cap to grade or above on septic tank and drywell.
 - (6) If a Garbage disposal is used, increase septic tank capacity by 50% and increase absorbant sidewall area by 22%.

LOCATION: 12/13/85 EXTRA INSPECTION OF
EXISTING SYSTEM WILL BE NEEDED BEFORE
NEW SPECS CAN BE WRITTEN. OLD TEST
RUN IN 1969. WE MUST KNOW SOMETHING
ABOUT CONDITION OF OLD SYSTEM THIS YEAR
12/13/85 RJ

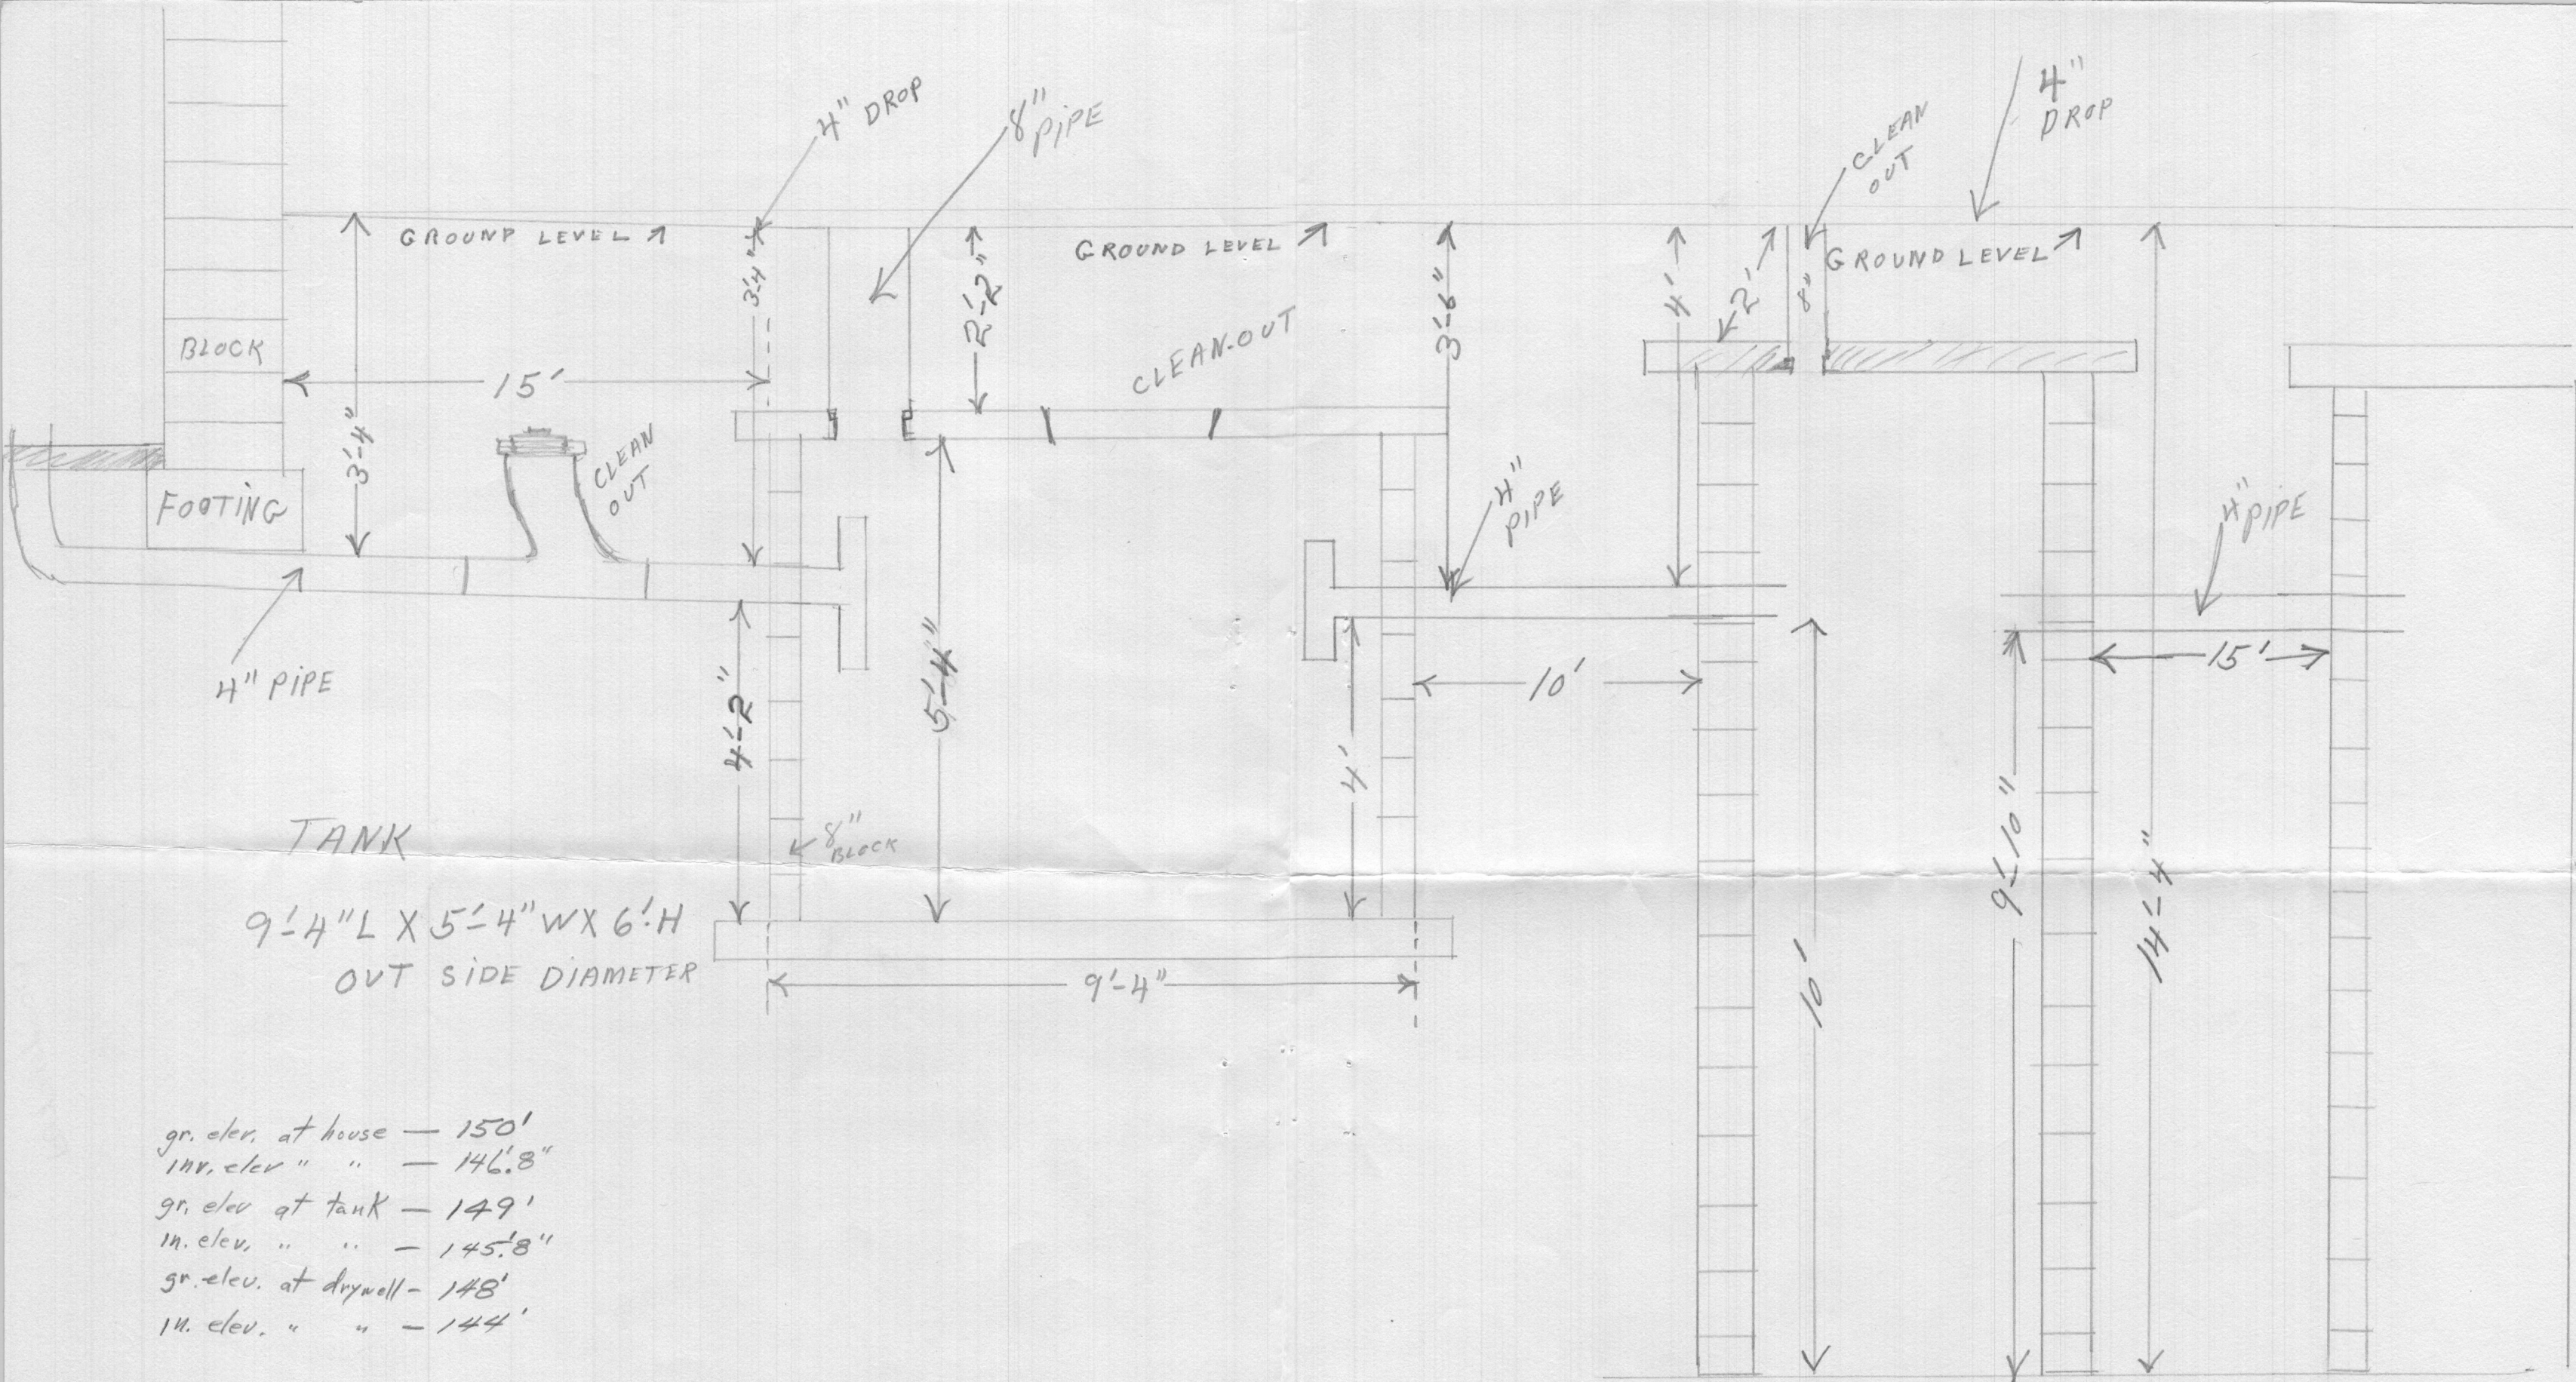

A. L. TAYLOR Woodstock RD.
 DAB-2606

Mrs. Olive A. Taylor

