

APPLICATION

A 08730

P _____

SEWAGE DISPOSAL TESTING

MARYLAND STATE DEPARTMENT OF HEALTH

HOWARD COUNTY

ELLICOTT CITY

DISTRICT 6DATE 7/8/64*Septic tank 1,000 gal.**Leaching bed - 15 ft. wide x 27 ft. long.**Bottom of gravel to be 4 to 5 ft. below original grade.**Locate leaching bed in the area between 19 ft. to 67 ft. from the back of the house on the adjoining property at number 95 Whiskey Bottom Rd. and 36 in the area between 36 ft. to 76 ft. from the left side line as lot is seen when traveling from Whiskey Bottom Rd.*TO: THE COUNTY HEALTH OFFICER
ELLICOTT CITY, MARYLAND

I, HEREBY, APPLY FOR THE NECESSARY TESTS IN ORDER TO CONSTRUCT (OR RECONSTRUCT) A SEWAGE DISPOSAL SYSTEM.

PROPERTY OWNER Joseph E. Loveless, Sr. & WifeADDRESS Box 203, Laurel, Maryland PHONE 725-0754

PROPERTY LOCATION:

SUBDIVISION _____ LOT NO. _____

ROAD AND DESCRIPTION Whiskey Bottom Road - look for Loveless Brothers Equipment Co.
67 Whiskey Bottom Rd.
knock on door

OCCUPANT _____ PHONE _____

PERSON TO CONSTRUCT SYSTEM _____

ADDRESS _____ PHONE _____

SIZE OF LOT 100 x 220 TYPE BLDG. 4
NUMBER OF BEDROOMS


IF NOT SINGLE RESIDENCE DESCRIBE _____

SIGNATURE OF APPLICANT J E LovelessAPPROVED BY Ronald F. White FOR Leaching Bed DATE 7/9/64
(KIND OF SYSTEM)REJECTED BY _____ FOR _____ DATE _____
(KIND OF SYSTEM)

HOLD PENDING FURTHER TESTS _____ DATE _____

REASONS FOR REJECTION OR HOLDING _____

THIS IS NOT A PERMIT

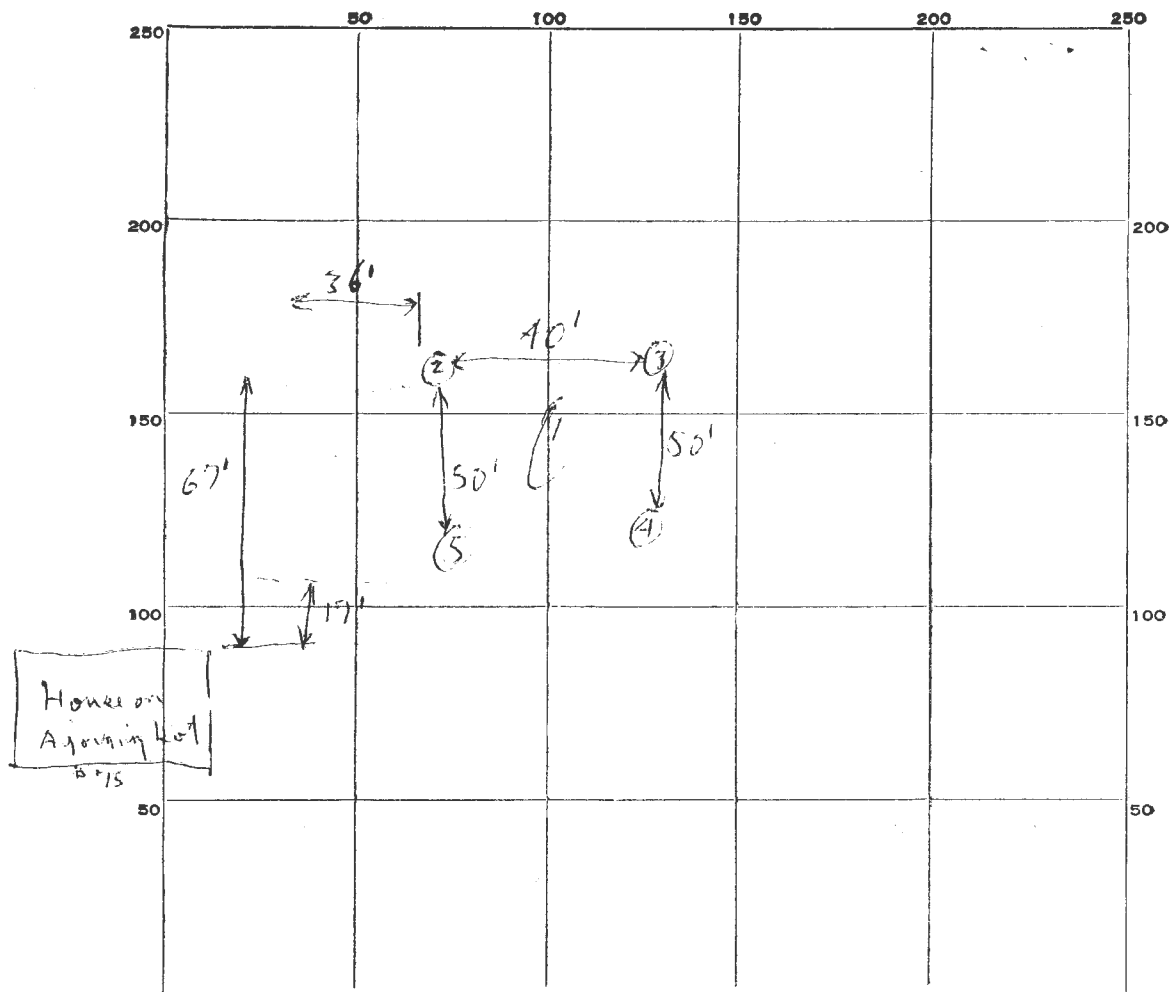

INDICATE NORTH. NAME ADJOINING ROADWAY AS BASE LINE.

Willows Bottom Rd.

→ N 71°

DATE	TEST NO.	DEPTH	PRE-WET		TEST - 1" DROP		TIME
			START	STOP	START	STOP	
7/9/64	1	9 1/2 ft.	105	106	106	107	1 min.
	2	7 ft.	107	108	108	110	2 min.
	3	4 ft.	104	110	110	112	2 min.
	4	7 ft.	111	113	113	118	5 min.
	5	4 ft.	113	116	116	123	7 min.

SOIL AUGER FINDING

Sand all way down

TESTED BY

JRDF 7/9/64

REMARKS

ALSO PRESENT

J. W. Zedler

LOT NO.