

APPLICATION

SEWAGE DISPOSAL TESTING

MARYLAND STATE DEPARTMENT OF HEALTH

HOWARD COUNTY

ELLICOTT CITY

DISTRICT 5

DATE 6/20/69

TO: THE COUNTY HEALTH OFFICER
ELLICOTT CITY, MARYLAND

I, HEREBY, APPLY FOR THE NECESSARY TESTS IN ORDER TO CONSTRUCT (OR RECONSTRUCT) A SEWAGE DISPOSAL SYSTEM.

PROPERTY OWNER

Sydney Fishman
Fishman LANDLORD

ADDRESS

2113 Scaggsville Rd.

PHONE

762 5566

PROPERTY LOCATION:

Tenant is Odell 498 1982

SUBDIVISION

LOT NO.

ROAD AND DESCRIPTION

2113 Scaggsville Rd.

2nd house from Feryl Antiques

OCCUPANT

PHONE

PERSON TO CONSTRUCT SYSTEM

ADDRESS

PHONE

SIZE OF LOT

20 acres

TYPE BLDG.

Existing House
NUMBER OF BEDROOMS

IF NOT SINGLE RESIDENCE DESCRIBE

SIGNATURE OF APPLICANT

1/ Calvin Miles

APPROVED BY

FOR

(KIND OF SYSTEM)

DATE

REJECTED BY

FOR

(KIND OF SYSTEM)


DATE

HOLD PENDING FURTHER TESTS

DATE

REASONS FOR REJECTION OR HOLDING

2
THIS IS NOT A PERMIT

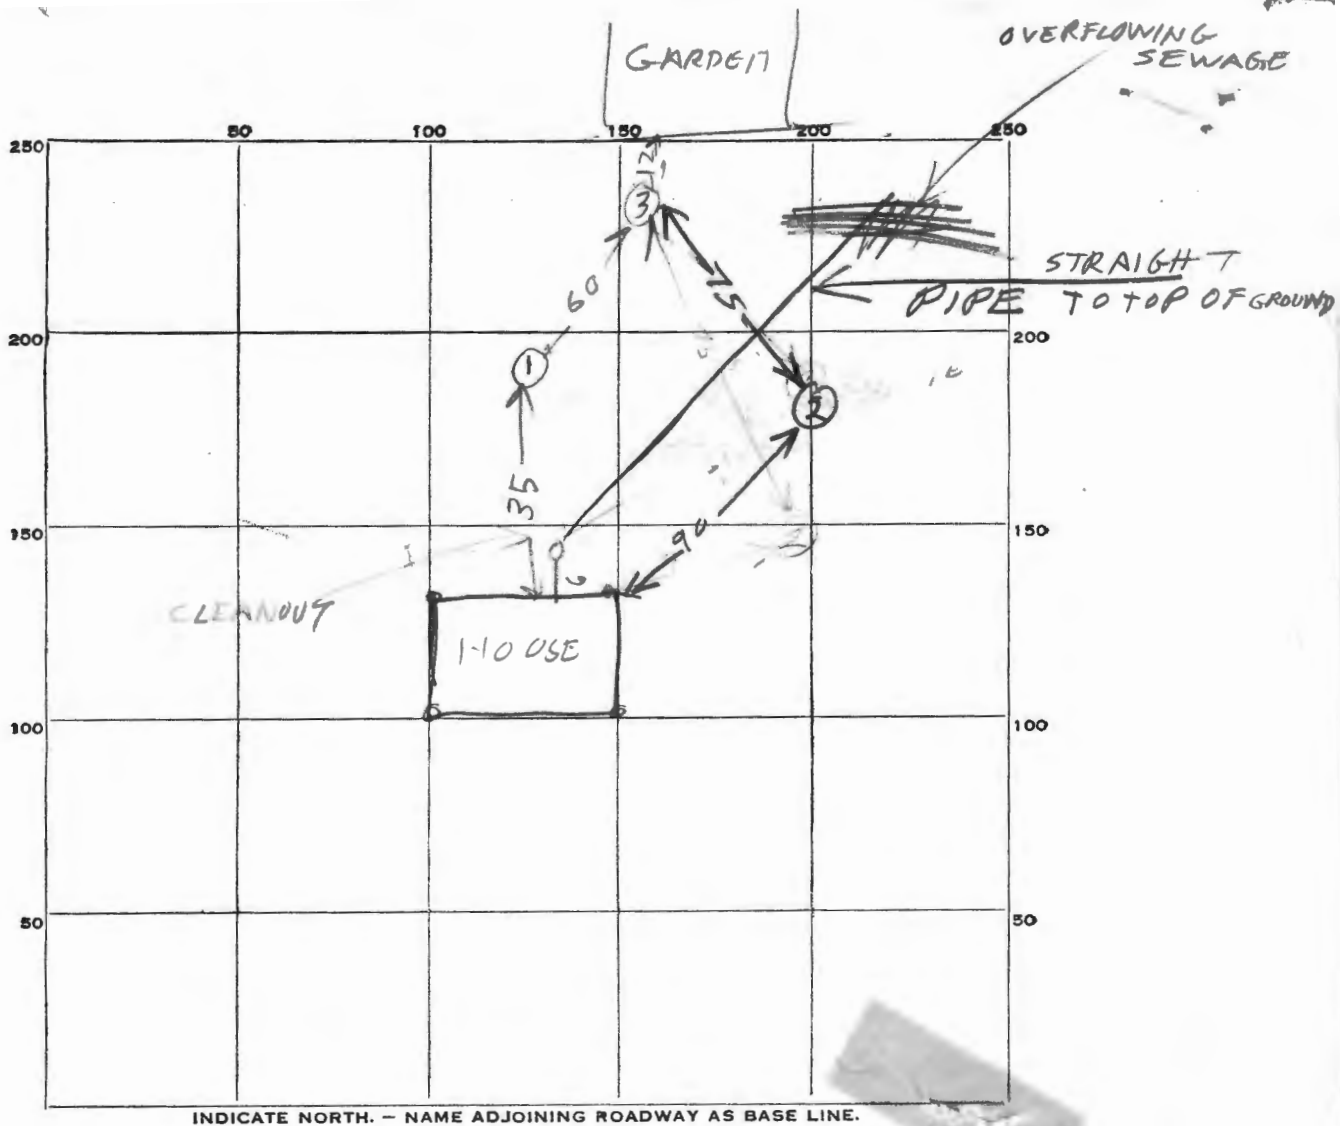

DATE	TEST NO.	DEPTH	PRE-WET		TEST - 1" DROP		TIME
			START	STOP	START	STOP	
6/10/69	1	12 1/2	TOP 3' CLAY	MID 4' CLAY & GRAVEL			
	2	9	BOT 5 1/2' CLAY				
	3	6	ALL CLAY	UNDERGROUND WATER 8 FT			
			CLAY	SAND GRAVEL			

SOIL AUGER FINDING _____

TESTED BY _____

REMARKS

City Water. Ground unsatisfactory for all system

August 8, 1969

Hammond Park Enterprises
346 Hungerford Drive
Rockville, Maryland

Attention: Mr. Sydney Fishman

Dear Mr. Fishman:

On June 20, 1969, Calvin Miles and I ran percolation tests on your property at 2113 Scaggsville Road, Laurel, Maryland. The tests were exceptionally bad. It is impossible to install a workable sewage disposal system on this lot. However, you may install a sewage system for the existing house, that will not make the sewage situation any worse. You may install a tile field with 600 sq. ft. bottom area 2 ft. to 4 ft. deep in the back yard. It will not work, but no harm will be done, because the existing sewage system is already overflowing.

In your letter you mentioned something about development of the land. This land is, in general, very poor for private sewage disposal systems. Most of the percolation tests in this area will fail.

Very truly yours,

Raymond Hodges,
Sanitarian

RH:jr

HAMMOND PARK ENTERPRISES

LAND INVESTMENTS-DEVELOPERS

~~5410E~~ 346 Hungerford Drive

~~230 NORTH WASHINGTON STREET~~

ROCKVILLE, MARYLAND

SYDNEY FISHMAN
STANLEY D. FISHMAN

~~762-5566~~
762-5566

July 29, 1969

Howard County Health Department
199 Court House Drive
Ellicott City, Maryland 21043

Attention: Mr. Hodges

Re: Septic System - 2113 Scaggsville Road, Laurel, Maryland

Gentlemen:

We would like to inquire about the required type of septic system for the above captioned property. During the month of June, 1969, several percolation tests were made by Calvin Miles of Fulton, Maryland, under the direction and supervision of Mr. Hodges of the Howard County Health Department. We would like to install a minimum type system as we plan to develop this land in the very near future.

Please inform us as to the minimum type of system that would be acceptable for this existing one bathroom house.

Very truly yours,

HAMMOND PARK ENTERPRISES



Sydney Fishman

SF:dbf

7/31/69 - Called Mr Fishman. Not there. Left message for him to call back

8/1/69 - Called Mr Fishman. Not there. He will call me
4 AUG 69 MONDAY