1130 PW 1000 1615

# APPLICATION

PERCOLATION TESTING

A 36723

HOWARD COUNTY HEALTH DEPARTMENT

BUREAU OF ENVIRONMENTAL HEALTH

P.O. BOX 476 ELLICOTT CITY, MARYLAND 21043

DATE 3/27/86


TO:	THE COUNTY HEALTH OFFICER
	ELLICOTT CITY MARYLAND

TELEPHONE: 461-9933

I. HEREBY, APPLY FOR THE NECESSARY TEST IN ORDER TO CONSTRUCT (OR RECONSTRUCT) A SEWAGE DISPOSAL SYSTEM.

ROPERTY OWNER MICHAEL A	\$ And Adele G. R	Robbins
		PHONE (301) 725-2151
PROSPECTIVE BUYER		
ADDRESS		PHONE
PROPERTY LOCATION:	Disger - SounERBuil	Idens, - 792-0834
SUBDIVISION		LOT NO.
ROAD AND DESCRIPTION ON VOILE	nerhausen Road; App	prox 700ft, West of SAVAge -
Gailford Rd in SAI	1Age, Md.	
Gailford Rd in SAY  TAX MAP 47 PARCEL # 8	35	
SIZE OF LOT 1/2 Acre		TYPE BLDG. SINGLE FAMILY DWELLING OR COMMERCIAL)
THE SYSTEM INSTALLED UNDER THIS AP	PLICATION IS ACCEPTABLE ONLY UNTIL PUI	JBLIC FACILITIES BECOME AVAILABLE. I FULLY UNDERSTAND THE
	HIS PERC TEST APPLICATION IS NON-REFUN	NDABLE UNDER ANY CIRCUMSTANCES. I ALSO AGREE TO COMPLY
	TESTING TRIS LOT.	(SIGNATURE OF APPLICANT)
APPROVED BY	FOR	DATE
REJECTED BY	FOR	DATE
HOLD PENDING FURTHER TESTS		DATE
REASONS FOR REJECTION OR HOLDING	9-80 UNSANSFACTORY PERC. 1	HONLY CLAY CAYOR + HAL WATER MELO. S.

#### THIS IS NOT A PERMIT

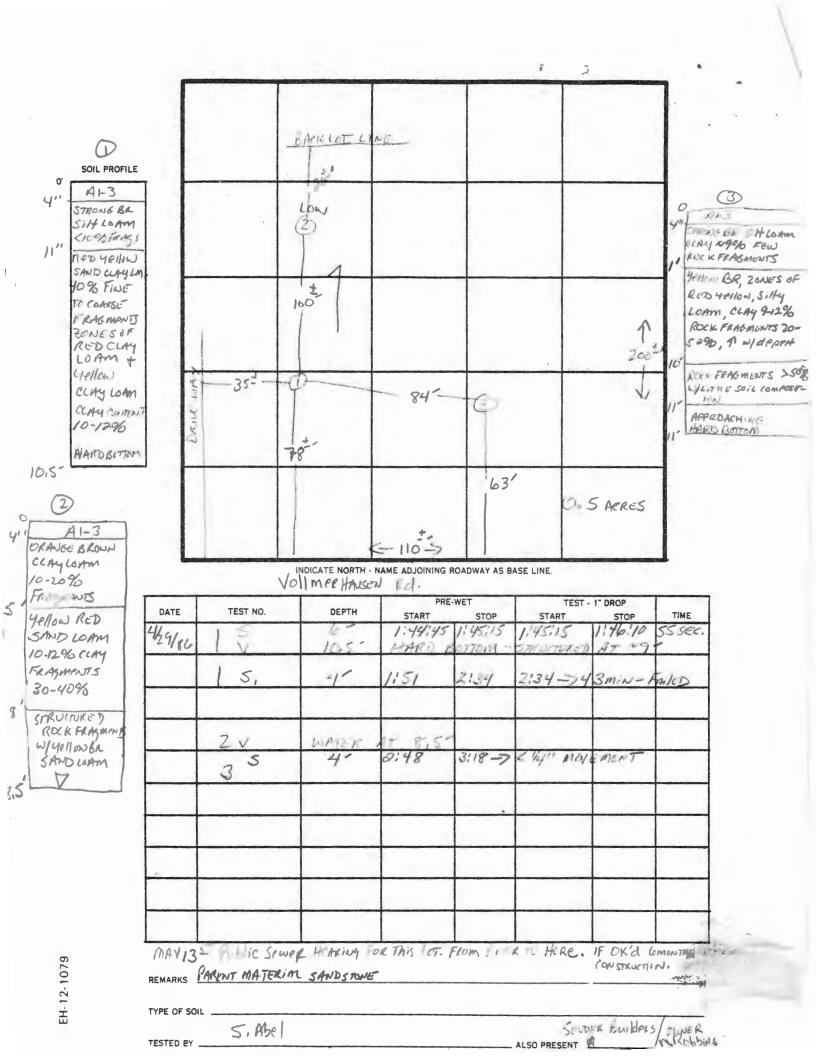

# APPLICATION

PERCOLATION TESTING

A 36723


HOWARD COUNTY HEALTH DEPARTMENT BUREAU OF ENVIRONMENTAL HEALTH

P.O. BOX 476 ELLICOTT CITY, MARYLAND 21043 TELEPHONE: 461-9933

DISTRICT 6 PelecTion

TO: THE COUNTY HEALTH OFFICER ELLICOTT CITY, MARYLAND		
I, HEREBY, APPLY FOR THE NECESSARY TEST IN ORDER TO	CONSTRUCT (OR RECONSTRUC	CT) A SEWAGE DISPOSAL SYSTEM.
PROPERTY OWNER MICHAEL A AND A	dele G. Ro	bbins.
ADDRESS 8070 SAVAGE - Guil	Ford Rd.	PHONE (301) 725-2151
PROSPECTIVE BUYER		
~ADDRESS		
PROPERTY LOCATION:		
SUBDIVISION		LOT NO.
/ROAD AND DESCRIPTION BN Vollmerhausen	· Road ; Appro	west of savage- Guilforg
Rd in Savage, Md.		
TAX MAP ————PARCEL #		
SIZE OF LOT		TYPE BLOG Single FAMILY dwelling (SINGLE FAMILY DWELLING OR COMMERCIAL)
THE SYSTEM INSTALLED UNDER THIS APPLICATION IS ACC	CEPTABLE ONLY UNTIL PUI	BLIC FACILITIES BECOME AVAILABLE. I FULLY UNDERSTAND THE
	_	IDABLE UNDER ANY CIRCUMSTANCES. I ALSO AGREE TO COMPLY
✓WITH ALL M.O.S.H.A. REQUIREMENTS IN TESTING THIS I	OT Michael	A. Robbins (SIGNATURE OF APPLICANT)
APPROVED BY	FOR	DATE
REJECTED BY	FOR	DATE
HOLD PENDING FURTHER TESTS		DATE
REASONS FOR REJECTION OR HOLDING		

# THIS IS NOT A PERMIT

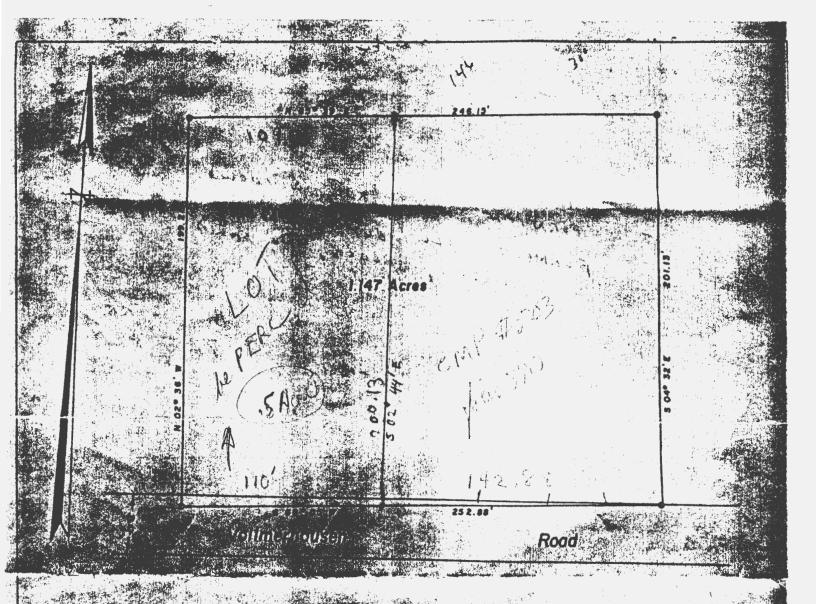

PLAT OF SURVEY
FOR
FRANK VOLLMERHAUSEN
SIXTH ELECTION DISTRICT OF HOWARD COUNTY
SAVAGE, MARYLAND
SCALE: I IN: 50 FT. OCTOBER 31,1968

Claude M. Skinner Jr. Reg. Engineer B Land Gurveyor No. 223

#### HOWARD COUNTY HEALTH DEPARTMENT

JOYCE M. BOYD, M.D., M.P.H. COUNTY HEALTH OFFICER



Bureau of Environmental Health 3525 Ellicott Mills Drive Ellicott City, Maryland 21043

Director - 461-9956 Water & Sewerage, Permits - 461-9933 Community Environmental Health - 461-9944 Technical Services - 461-9955

May 15, 1986

Michael A. Robbins 8070 Savage Guilford Road Savage, Maryland 20863

RE: Percolation Testing
Robbins Property
Tax Map 47 Parcel 835

Dear Mr. Robbins:

Percolation testing performed on April 29, 1986 on the above referenced property revealed unsatisfactory soil conditions. The presence of a deep clay layer and high water table does not permit the use of on-site sewerage disposal.

If you should have any questions concerning this test, please feel free to contact me at the above address or by calling 461-9933.

Very truly yours,

Craig Williams, Director Water and Sewerage Program

CW/SA:JR