

APPLICATION

A 29275

SEWAGE DISPOSAL TESTING

P _____

STATE OF MARYLAND - DEPARTMENT OF HEALTH AND MENTAL HYGIENE

HOWARD COUNTY HEALTH DEPARTMENT
ENVIRONMENTAL HEALTH SERVICES
P. O. BOX 476, ELLICOTT CITY, MARYLAND 21043
TELEPHONE: 465-5000, EXT. 356

DISTRICT 3rd

DATE 11/24/78

TO THE COUNTY HEALTH OFFICER
ELLICOTT CITY, MARYLAND

I, HEREBY, APPLY FOR THE NECESSARY TEST IN ORDER TO CONSTRUCT (OR RECONSTRUCT) A SEWAGE DISPOSAL SYSTEM.

PROPERTY OWNER Howard Crist Property

ADDRESS _____ PHONE _____

PROPERTY LOCATION _____

SUBDIVISION _____ LOT NO. _____

ROAD AND DESCRIPTION Triadelphia & Ivory Roads

SIZE OF LOT 5.0 acres TYPE BLDG. 3 or 4 bedrooms
NUMBER OF BEDROOMS _____

IF NOT SINGLE RESIDENCE DESCRIBE _____

THE SYSTEM INSTALLED UNDER THIS APPLICATION IS ACCEPTABLE ONLY UNTIL PUBLIC FACILITIES BECOME AVAILABLE.

SIGNATURE OF APPLICANT /s/ Crist Family Properties

APPROVED BY _____ FOR _____ DATE _____
(KIND OF SYSTEM)

REJECTED BY _____ FOR _____ DATE _____
(KIND OF SYSTEM)

HOLD PENDING FURTHER TESTS See M DATE 12-18-78

REASONS FOR REJECTION OR HOLDING inadequate plan

THIS IS NOT A PERMIT

boender associates

engineers
surveyors
planners

BALTIMORE DIVISION INC.
SUITE 102-107 TOWN & COUNTRY PROFESSIONAL BUILDING
ELLCOTT CITY, MARYLAND 21043
BALTIMORE 301-465-7777

LETTER OF TRANSMITTAL

12/18/78
1:30

TO: Howard County Health Department
3450 Courthouse Drive
Ellicott City, Maryland 21043

DATE: November 24, 1978

ATTENTION: Don Monaghan

RE: Howard Crist Property

-GENTLEMEN:

☒ WE ARE SENDING YOU ☒ ATTACHED ☐ UNDER SEPARATE COVER VIA _____ THE FOLLOWING ITEMS:
☐ SHOP DRAWINGS ☐ PRINTS ☐ PLANS ☐ SAMPLES ☐ SPECIFICATIONS
☐ COPY OF LETTER ☐ _____

copies	date or no.	description
1		Property Plat
1		Check in the amount of \$ 100.00

THESE ARE TRANSMITTED AS CHECKED BELOW:

☒ FOR APPROVAL ☐ APPROVED AS SUBMITTED ☐ RESUBMIT _____ COPIES FOR APPROVAL
☐ FOR YOUR USE ☐ APPROVED AS NOTED ☐ SUBMIT _____ COPIES FOR DISTRIBUTION
☐ AS REQUESTED ☐ RETURNED FOR CORRECTIONS ☐ RETURN _____ CORRECTED PRINTS
☒ FOR REVIEW AND COMMENT ☐ _____
☐ FOR BIDS DUE _____ 19____ ☐ PRINTS RETURNED AFTER LOAN TO US

REMARKS:


If you have any questions relevant to the attached, please do not hesitate to contact the office at your earliest convenience.

COPIES:

IF ENCLOSURES ARE NOT AS NOTED, KINDLY NOTIFIED US AT ONCE.

SIGNED: Boender Associates, Inc. 

hole in 1" mostly clay

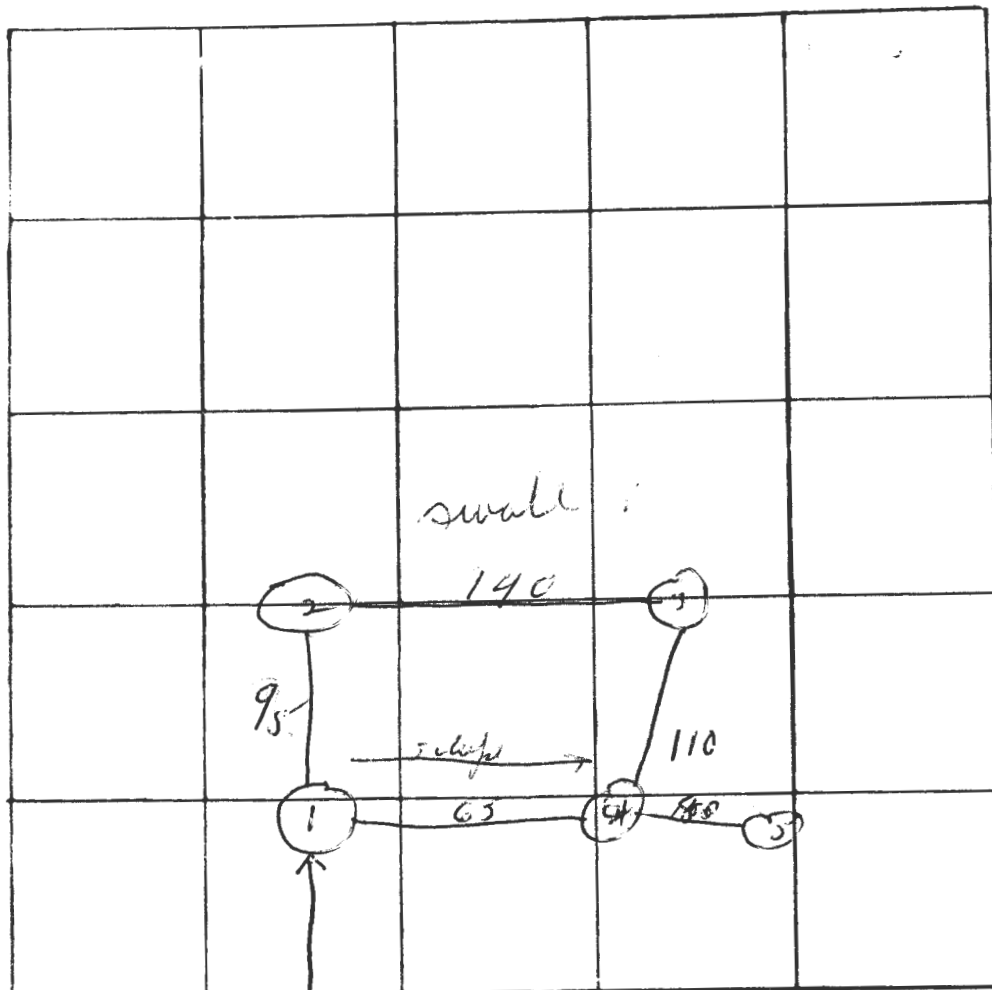

INDICATE NORTH - NAME ADJOINING ROADWAY AS BASE LINE
 ← G. Cray Rd → Channel Rd

DATE	TEST NO.	DEPTH	PRE-WET		TEST - 1" DROP		TIME
			START	STOP	START	STOP	
12/6/78	15	5	1 39	1 45	1 45	4 slow perc	
	10	13	1 34	1 42	1 42	5 slow perc	Stop
	25	5	1 42	1 46	1 46	1 52	9 min
	40	13	1 42	1 45	1 45	1 56	11 min
	35	5 1/2	1 57	2 03	2 03	2 15	12 min
	30	14	1 57	2 02	2 02	2 16	14 min
	4	10 1/2	runnel	same as #1			
	45	5	2 13	also perc			
	40	13	2 19	no perc			
	5	rock					

REMARKS _____

TYPE OF SOIL _____

TESTED BY DM ALSO PRESENT: _____

R-40

S 66° W 132.00'

S 73° W 201.50'

S 66° 30' E 523.32'

858.00'

S 112° 42' W

S 44° 15'

5.00 Acres Under Contract
to
Howard Crist Sr.

Howard Crist
N 30° 30' W 500.00'

Howard Crist
136/99
131/518

R-40

James Reagon
182/396

9.50 Acres Remaining

SEE SURVEY PLAT
26 Nov. 69

1.315 Ac
Lot

Present Zoning R-40
Proposed Zoning -
Special Permit
to operate Antique
Shop

A.J. Sharp
189/283

R-40

Proposed Lot
1.000 Acre

S 06° 30' E 330.00'
N 06° 30' W 330.00'

R-40

T.J. Sullivan
211/408

S 82° E 533.00'

N 53° 15' E 203.50'

135.00'

S 06° 30' E 330.00'

N 85° E 178.00'

ROAD

State 187.00'

N 35° E 105.00'

IVORY ROAD

TRIADENPHIA

Howard Clark
352/591

R-40