

Fill out in triplicate.
\$15.00 check payable to:
Howard County Health Dept. - Sanitation

APPLICATION

BUI-127A 14563

SEWAGE DISPOSAL TESTING

P _____

MARYLAND STATE DEPARTMENT OF HEALTH

HOWARD COUNTY

ELLICOTT CITY

DISTRICT

DATE 3/8/66

150 Gallon Tank
Dry Wells 300 sq ft sidewalk
area below the top 6 FT of Clay

Place the dry well 230 ft to 310 ft
from the front lot line and 40 ft to 60 ft
from the LEFT side of the lot

TO: THE COUNTY HEALTH OFFICER
ELLICOTT CITY, MARYLAND

I, HEREBY, APPLY FOR THE NECESSARY TESTS IN ORDER TO CONSTRUCT (OR RECONSTRUCT) A SEWAGE
DISPOSAL SYSTEM.

✓ PROPERTY OWNER BERNARD A. and RUBY I. SCHOCH

✓ ADDRESS 12241 DALEWOOD DR WHEATON, MD. 20902 PHONE WH 2-8738

PROPERTY LOCATION:

✓ SUBDIVISION _____ LOT NO. _____

✓ ROAD AND DESCRIPTION Wooded lot on Schaffersville Rd as per
plat enclosed

OCCUPANT _____ PHONE _____

PERSON TO CONSTRUCT SYSTEM HERMAN SIRK

ADDRESS Annapolis Rock Road, Woodbine, Md. PHONE HV 9-4724

✓ SIZE OF LOT 4.864 Acres TYPE BLDG. 3 BR. RAMBLER
NUMBER OF BEDROOMS

IF NOT SINGLE RESIDENCE DESCRIBE _____

✓ SIGNATURE OF APPLICANT Bernard A. Schoch

✓ APPROVED BY Raymond Hedges FOR Dry Well DATE 1 APR 66


REJECTED BY _____ FOR _____ DATE _____

HOLD PENDING FURTHER TESTS 15 MAR 66 DATE

REASONS FOR REJECTION OR HOLDING 15 MAR 66

Some percolation in
bottom of deep holes but not above. Need thicker
Layers of porous soil.

THIS IS NOT A PERMIT

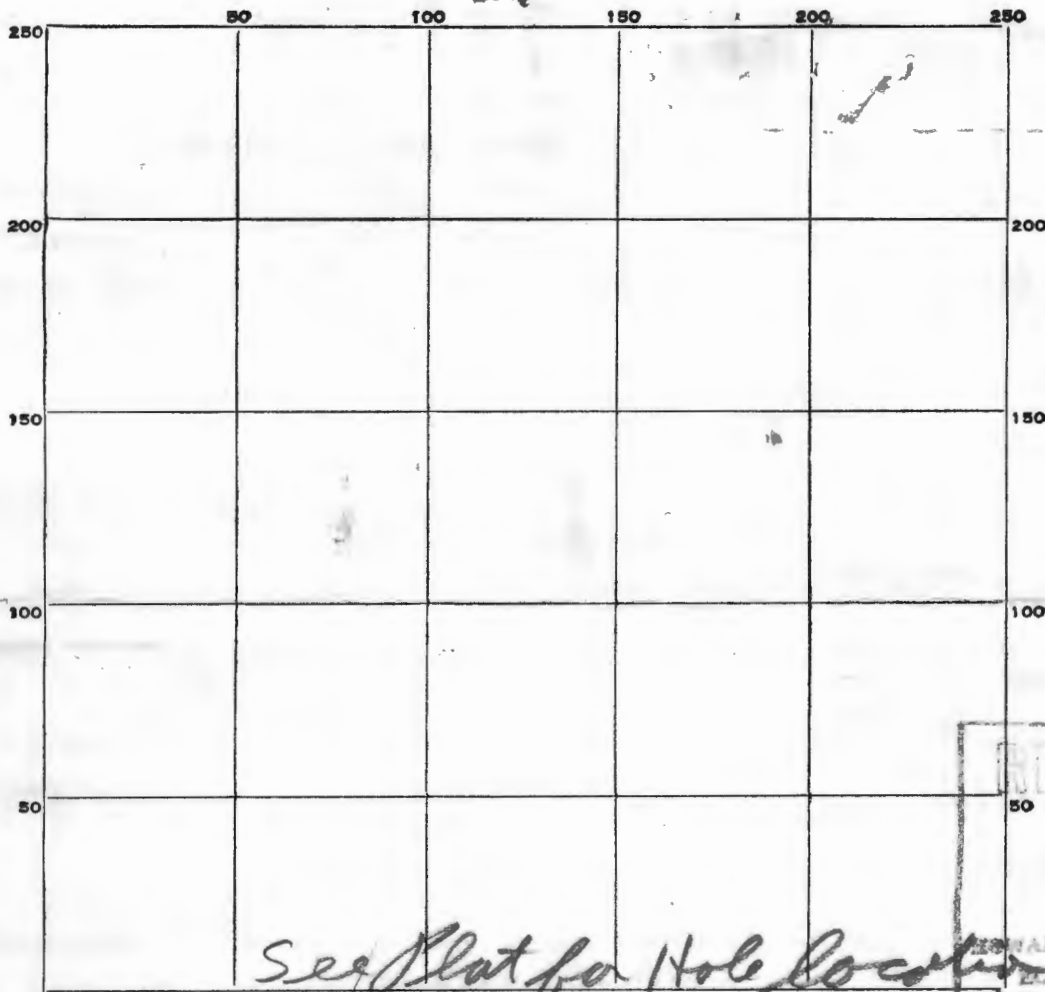


INDICATE NORTH. - NAME ADJOINING ROADWAY AS BASE LINE.

SCHAEFFERSVILLE RD.

DATE	TEST NO.	DEPTH	PRE-WET		TEST - 1" DROP		TIME
			START	STOP	START	STOP	
3/15/66	1	3 1/2	118	138	little perc in 20 min		
"	2	9	119	124	124	136	12
"	3	9 1/2	123	122	127	135	8
"	4	3 1/2	125	136	136	210	little perc
"	5	5 1/2	147	220	220	252	little perc
"	6	7	222	252	little perc		
"	(28)(9)	5	NOT TESTED		HIT ROCK		
"	10	6 1/2	AT ABOUT 5 FT		NOT TESTED		
"			AT ABOUT 6 FT		HIT ROCK		
4/1/66	11	9 1/2	957	958	958	1000	2
4/1/66	12	5	958	1030	little perc		
	13	4 1/2	1001	1045	1st inch		
	14	10	1003	1005	1005	1008	3
	15	7	1017	1021	1021	1029	8
	16	7	1039	1041	1041	1044	3

REMARKS

same 950
SAME PIT
ME PIT

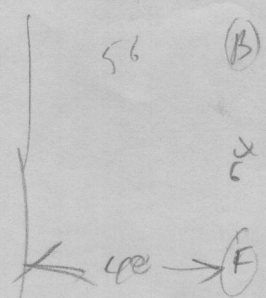

231
69
00
99
231

