

APPLICATION

FOR PERCOLATION TESTING AND SITE EVALUATION

TEST DATE(S) _____ TEST TIME _____

AP 558086C

AGENCY REVIEW: _____

DATE 4-19-16

DO NOT WRITE ABOVE THIS LINE

I HEREBY APPLY FOR THE NECESSARY TESTING/EVALUATION PRIOR TO ISSUANCE OF SEWAGE DISPOSAL SYSTEM PERMIT(S) TO:

CHECK AS NEEDED:

- ☒ CONSTRUCT NEW SEPTIC SYSTEM(S)
☐ REPAIR/ADD TO AN EXISTING SEPTIC SYSTEM
☐ REPLACE AN EXISTING SEPTIC SYSTEM

CHECK AS NEEDED:

- ☒ NEW STRUCTURE(S)
☐ ADDITION TO AN EXISTING STRUCTURE
☐ REPLACE AN EXISTING STRUCTURE

CHECK ONE:

- ☒ CREATE NEW LOT(S)
☐ BUILD ON AN EXISTING LOT IN A SUBDIVISION
☐ BUILD ON AN EXISTING PARCEL OF RECORD

IS THE PROPERTY WITHIN 2500' OF ANY RESERVOIR?

- ☐ YES
☒ NO

THE TYPE OF STRUCTURE IS:

- ☒ RESIDENTIAL WITH unknown PROPOSED BEDROOMS IN THE COMPLETED STRUCTURE (NOTE UNKNOWN IF APPROPRIATE)
☐ COMMERCIAL (PROVIDE DETAIL OF NUMBERS AND TYPES OF EMPLOYEES/ CUSTOMERS ON ACCOMPANYING PLAN)
☐ INSTITUTIONAL/GOVERNMENT (PROVIDE DETAIL OF NUMBERS AND TYPES OF EMPLOYEES/USERS ON ACCOMPANYING PLAN)

PROPERTY OWNER(S) Evergreen Stables Farm LLC

DAYTIME PHONE 301 725 0442 CELL _____ FAX _____

MAILING ADDRESS 8250 OLD COLUMBIA RD FULTON MD 20759
STREET CITY/TOWN STATE ZIP

APPLICANT Owner

DAYTIME PHONE _____ CELL _____ FAX _____

MAILING ADDRESS _____
STREET CITY/TOWN STATE ZIP

APPLICANT'S ROLE: DEVELOPER BUILDER BUYER RELATIVE/FRIEND REALTOR CONSULTANT

PROPERTY LOCATION
SUBDIVISION/PROPERTY NAME St Francis of Assisi LOT NO. 4

PROPERTY ADDRESS 8250 Old Columbia Road Fulton, MD
STREET TOWN/POST OFFICE

TAX MAP PAGE(S) 46 GRID 03 PARCEL(S) 337 PROPOSED LOT SIZE ± 1 ac.

AS APPLICANT, I UNDERSTAND THE FOLLOWING: THE SYSTEM INSTALLED SUBSEQUENT TO THIS APPLICATION IS ACCEPTABLE ONLY UNTIL PUBLIC SEWERAGE IS AVAILABLE. THIS APPLICATION IS COMPLETE WHEN ALL APPLICABLE FEES AND A SUITABLE SITE PLAN HAVE BEEN RECEIVED. I ACCEPT THE RESPONSIBILITY FOR COMPLIANCE WITH ALL M.O.S.H.A. AND "MISS UTILITY" REQUIREMENTS. APPROVAL IS BASED UPON SATISFACTORY REVIEW OF A PERC CERTIFICATION PLAN.

TEST RESULTS WILL BE MAILED TO APPLICANT.

SIGNATURE OF APPLICANT

HOWARD COUNTY HEALTH DEPARTMENT, BUREAU OF ENVIRONMENTAL HEALTH, WELL AND SEPTIC PROGRAM
7178 COLUMBIA GATEWAY DRIVE COLUMBIA, MARYLAND 21046 (410) 313-2640 FAX (410) 313-2648
TDD (410) 313-2323 TOLL FREE 1-877-4MD-DHMH

P-13
0.5' brl
or
cl
3' mica
pale
red
SL
many
mica
14'


P-14

similar
to
P-13

13.5'

P-15

17' brl
or cl
3.3' fsL
mica
dry
13'

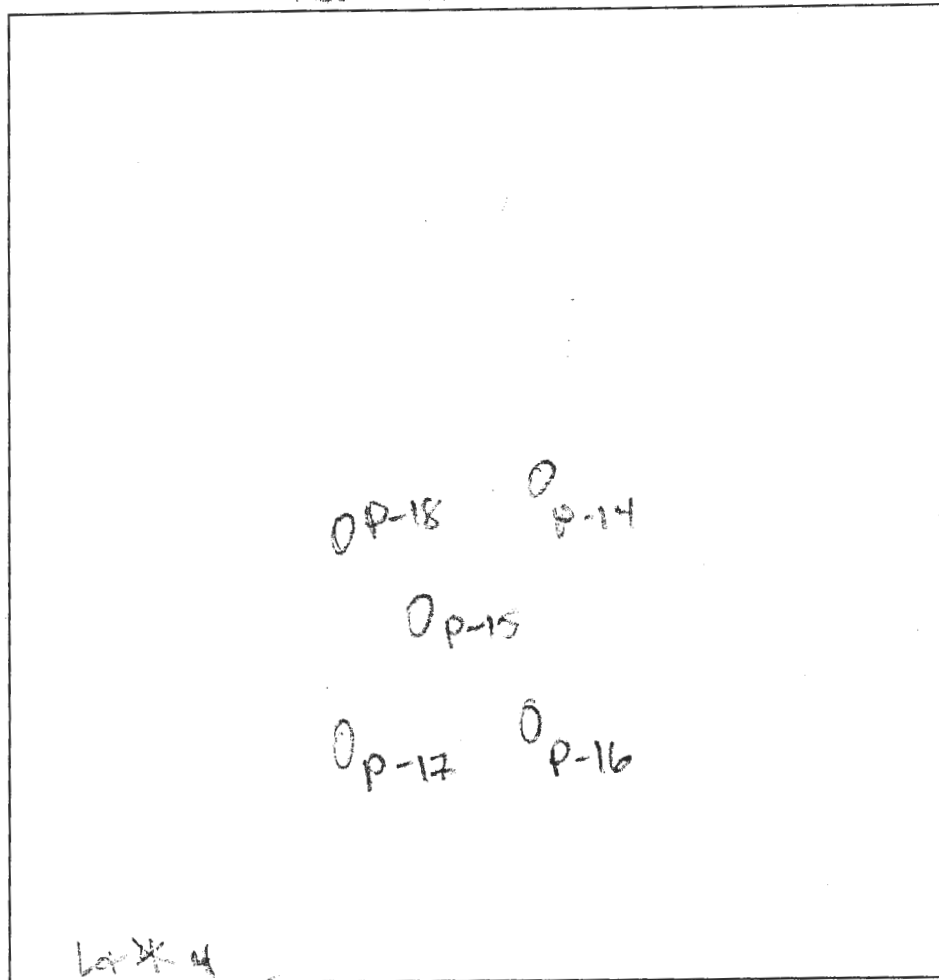

brl
ord
gravelly
3'
red
fsL
many
mica
13.5'

P-17

4.5' or
cl
pale
red
fsL
micaceous
14'

P-18

4' tan
SL
many
mica
dry
13'

drive

→ Old col Rd

DATE	TEST #	DEPTH	START	BREAK 1" DROP	STOP 2" DROP	TIME OF 2ND INCH	P/F/H
6/1	P-13	14 4 1/2	10:31	10:40	10:45	5	P
	P-14	13 1/2 4 1/2	10:47	10:49	10:51	2	P
	P-15	13 3 1/2	10:54	10:56	10:57	Fast	F
2nd	P-15	RP	10:58	11:00	11:02	2	P
	P-16	13 1/2 5	11:09	11:13	11:17	4	P
	P-17	14 4 1/2	11:26	~~~~~	~~~~~	5	F
2nd	P-17	RP 7	11:32	11:36	11:44	8	P
	P-18	13 5	11:39	11:40	11:41	Fast	F
	P-18	RP	11:42	11:44	11:46	2	P

REMARKS

SANITARIAN H. Oswald BACKHOE Hattfelds OTHERS Owner's Engineer
TEST HOLES USED IN SDA S. Freeman AVG. PERC TIME _____ SQ. FT/BR _____

TRENCH WIDTH _____ INLET DEPTH _____ MAX. BOT DEPTH _____ EFFECTIVE S/W _____

BAT



ZONE: RR-DEO
30.7600

LOT 1
PLAT 16725, 17401
ZONE: RR-DEO
3.0068

EXISTING OF
HO-95-0009

Perc Cert Signed
9.28.21

EX. PARKING
N 538.6001

EXISTING MAINTENANCE
ACCESS TO BE
CONNECTED TO
PROPOSED ROAD

EXISTING DRIVEWAY
TO BE CONNECTED
TO PROPOSED ROAD

EX. CHURCH

EX. PARKING

ST. FRANCIS OF ASSISI
LOT 1
PLAT 10125, 21865,
23246
ZONE: RR-DEO
12.4748 AC

NON-BUILDABLE
BULK PARCEL 'B'
0.23 AC

SUPER LOT 10
WEISMAN, GEORGE D.,
TRUSTEE
PLAT 5861
ZONE: RR-DEO
15.37 AC

EXISTING PUBLIC
FLOOD PLAIN
EASEMENT - PLAT
16724-16729

BUILDABLE
PRESERVATION
PARCEL 'A'
10.00 AC

ST. FRANCIS OF ASSISI
LOT 10
PLAT 10125
ZONE: RR-DEO
10.717 AC

APPROXIMATE
EXISTING
100-YEAR
FLOOD PLAIN

EX. HOUSE
CIRCA 1987
TO REMAIN
EX. POOL
TO REMAIN

APPROXIMATE
LOCATION OF
EXISTING
SEPTIC TANK
TO REMAIN

EXISTING WELL
HO-81-2161
TO BE ABANDONED

EX. SHED
CIRCA 1987
TO BE
REMOVED

WHITE RINE COURT
LOCAL 50' R.W.

LOT 8
45,457 SF
WELL LOT 8

LOT 7
40,587 SF

LOT 6
42,768 SF

LOT 3
42,791 SF

LOT 4
42,791 SF

LOT 5
40,320 SF

LOT 2
42,775 SF

LOT 1
46,662 SF

APPROXIMATE LOCATION
OF EXISTING SEED
TANKS TO BE
ABANDONED

PRIVATE SEWAGE
DISPOSAL AREA
10011 SF

PRIVATE SEWAGE
DISPOSAL AREA
10030 SF

100' STREAM
SETBACK

100' STREAM
SETBACK
ENVIRONMENTAL
BUFFER

