

APPLICATION

SEWAGE DISPOSAL TESTING

A 17462

P _____

MARYLAND STATE DEPARTMENT OF HEALTH

HOWARD COUNTY

ELLICOTT CITY

DISTRICT 5th

DATE 9-15-72

TO: THE COUNTY HEALTH OFFICER
ELLICOTT CITY, MARYLAND

I, HEREBY, APPLY FOR THE NECESSARY TESTS IN ORDER TO CONSTRUCT (OR RECONSTRUCT) A SEWAGE DISPOSAL SYSTEM.

PROPERTY OWNER Russell Coleman 40 Mrs. Best

ADDRESS 10412 Montrose Avenue PHONE 493-5790
Bethesda, Maryland 20014

PROPERTY LOCATION:

SUBDIVISION (Coleman-Lerch property) LOT NO. _____

ROAD AND DESCRIPTION Triadelphia Mill Road, Dayton, Md. 21036

OCCUPANT Undeveloped land PHONE _____

PERSON TO CONSTRUCT SYSTEM To be determined

ADDRESS _____ PHONE _____

SIZE OF LOT 5 Acres per survey A-3370-23 TYPE BLDG. Four (4)
NUMBER OF BEDROOMS

IF NOT SINGLE RESIDENCE DESCRIBE _____

SIGNATURE OF APPLICANT Russell Coleman

APPROVED BY _____ FOR _____ DATE _____
(KIND OF SYSTEM)


REJECTED BY _____ FOR _____ DATE _____
(KIND OF SYSTEM)

HOLD PENDING FURTHER TESTS _____ DATE _____

REASONS FOR REJECTION OR HOLDING _____

THIS IS NOT A PERMIT

COLEMAN LERCH
Lot 23

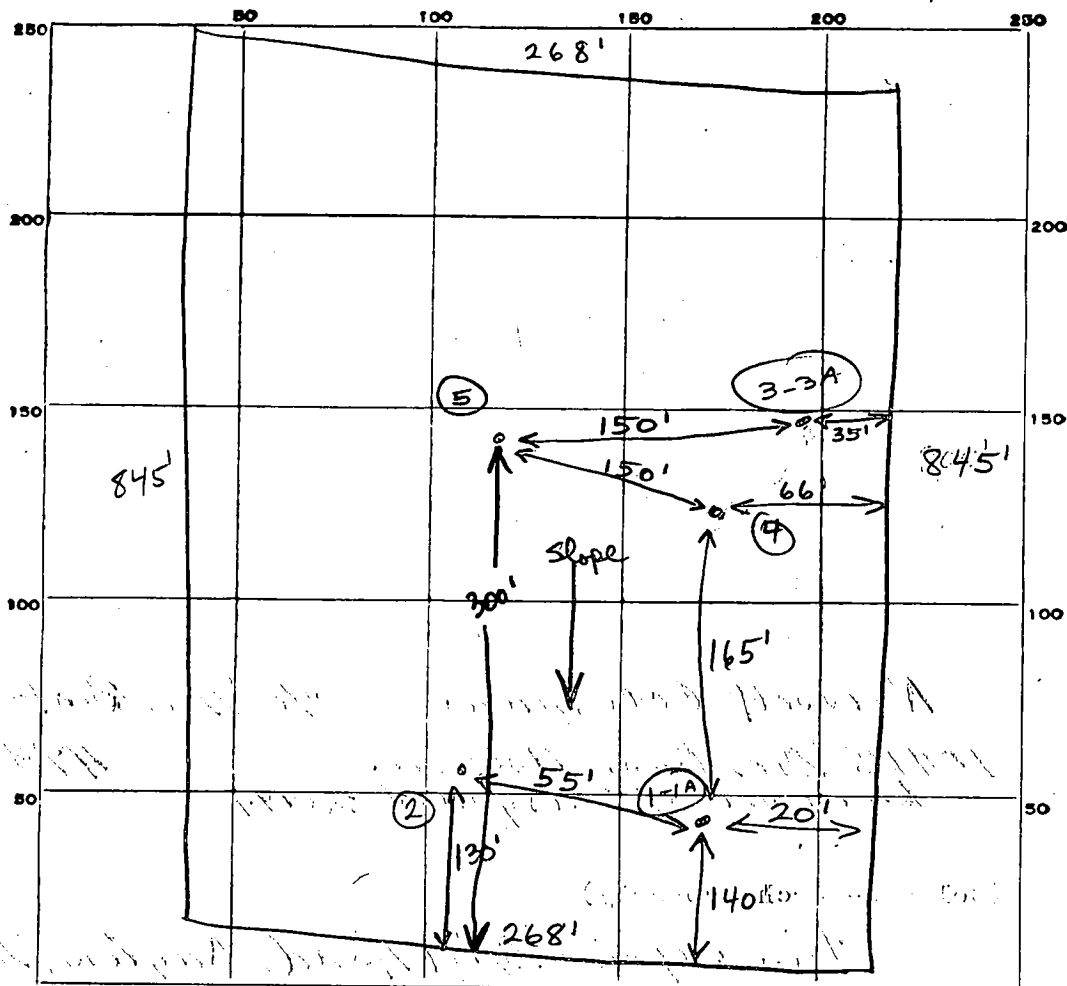

INDICATE NORTH - NAME ADJOINING ROADWAY AS BASE LINE.

Tridelpia Mill Rd

DATE	TEST NO.	DEPTH	PRE-WET		TEST - 1" DROP		TIME
			START	STOP	START	STOP	
10/13	1	4	10 ⁰⁰	10 ⁰⁵	10 ⁰⁵	10 ⁰⁸	3
	1A	11	10 ⁰⁰	10 ¹⁰	10 ¹⁰	10 ²²	12
	2	water at 9 1/2'	TOP 4'	clay			
	3	4	10 ²⁷	10 ³⁰	10 ³⁰	10 ³³	3
	3A	11	10 ²⁷	10 ³³	10 ³³	10 ⁴⁰	7
	4	TOP 3' clay Bottom 8' - Good					
	5	TOP 3' clay Bottom 8' - Good					

Average
Time
6 min

SOIL AUGER FINDING

TESTED BY

REMARKS


H. J. Syder

Dry Well at

Inlet 4'

Max Depth 11'

5

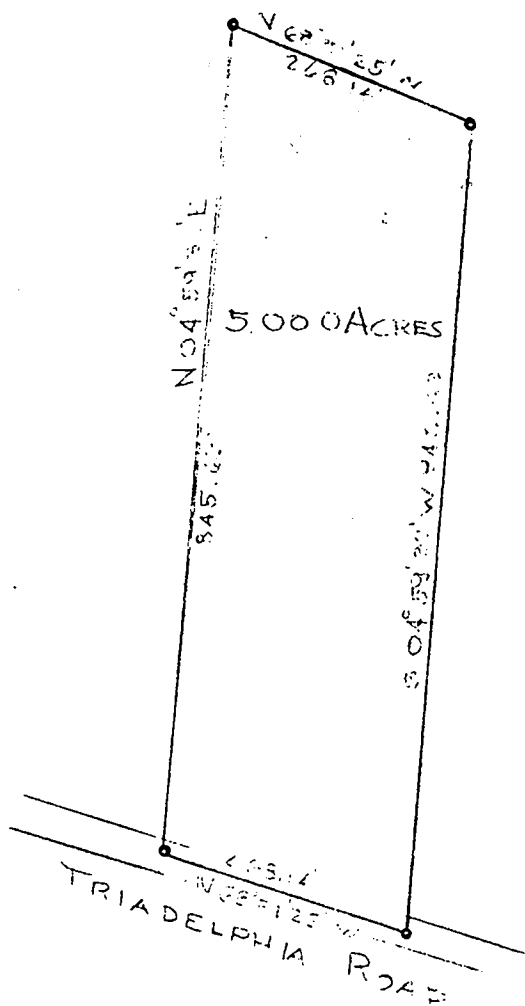

PLAT OF SURVEY
FOR
RUSSELL COLEMAN
FIFTH ELECTION DISTRICT
OF

HOWARD COUNTY
DAYTON, MARYLAND

SCALE: 1 IN = 200 FT

MAY 3, 1972

Claude M. Skinner, Jr.

Claude M. Skinner, Jr.
Reg. Professional Engineer &
Land Surveyor No. 2227

