

APPLICATION

CONTRACTOR-K&K
EXCAVATING

LOT OF RECORD

PERCOLATION TESTING

A 510114

P _____

HOWARD COUNTY HEALTH DEPARTMENT

BUREAU OF ENVIRONMENTAL HEALTH

3525-H ELLICOTT MILLS DRIVE/ELLICOTT CITY, MARYLAND 21043
TELEPHONE: 313-2640

DISTRICT _____

DATE 4-28-98

TENTATIVE SCHEDULE
4-5-98
T. J. JONES
K. J. JONES

TO: THE COUNTY HEALTH OFFICER
ELLICOTT CITY, MARYLAND

I HEREBY APPLY FOR THE NECESSARY TEST PRIOR TO APPLICATION FOR PERMIT TO CONSTRUCT (OR RECONSTRUCT) A SEWAGE DISPOSAL SYSTEM.

PROPERTY OWNER John Rote + Elizabeth Krieger-Kerry Doyle + Scott Posey

ADDRESS 14620 TRIADDELPHIA Mill Road DAYTON PHONE _____

AGENT OR PROSPECTIVE BUYER D. Scott Posey + Kerry Doyle

ADDRESS 14608 Shiloh Court Laurel Md PHONE 301 776 2072

PROPERTY LOCATION: Apt. X-4 20708 Work 301-262-8554

SUBDIVISION _____ LOT NO. 23

ROAD AND DESCRIPTION 14630 Triadelphia Mill Rd

S acres

TAX MAP 27 PARCEL # 96

SIZE OF LOT 5 AC TYPE BLDG. SEO - 2 Bwn
(SINGLE FAMILY DWELLING OR COMMERCIAL)

BLDG. PERMIT SIGNED

AND RETURNED 7-17-98

Final # B10112975

THE SYSTEM INSTALLED UNDER THIS APPLICATION IS ACCEPTABLE ONLY UNTIL PUBLIC FACILITIES BECOME AVAILABLE. I FULLY UNDERSTAND THE FEE CONNECTED WITH THE FILING OF THIS PERC TEST APPLICATION IS NON-REFUNDABLE UNDER ANY CIRCUMSTANCES. I ALSO AGREE TO COMPLY WITH ALL M.O.S.H.A. REQUIREMENTS IN TESTING THIS LOT.

(SIGNATURE OF APPLICANT)

APPROVED BY [Signature] FOR SEO DATE 5/11/98

DISAPPROVED BY _____ FOR _____ DATE _____

HOLD PENDING FURTHER TESTS _____

REASONS FOR REJECTION OR HOLDING _____

PERCOLATION TEST PLAT/PRELIMINARY PLAT - TITLE OR I.D. # _____ DATE _____

SITE DEVELOPMENT PLAN/FINAL PLAT - TITLE OR I.D. # _____ DATE _____

THIS IS NOT A PERMIT

5101
COUNTY #

SOIL PROFILE

Brown
Loam

Pink
SC/
SIL

Brown
CL


Pink
SL

SOIL PROFILE

TOPSOIL
Brown
CL

TAN SL

208
SPEC
PARENT
MATERIAL
MIXED
COLORATION
BLACK/
PINK/ORANGE

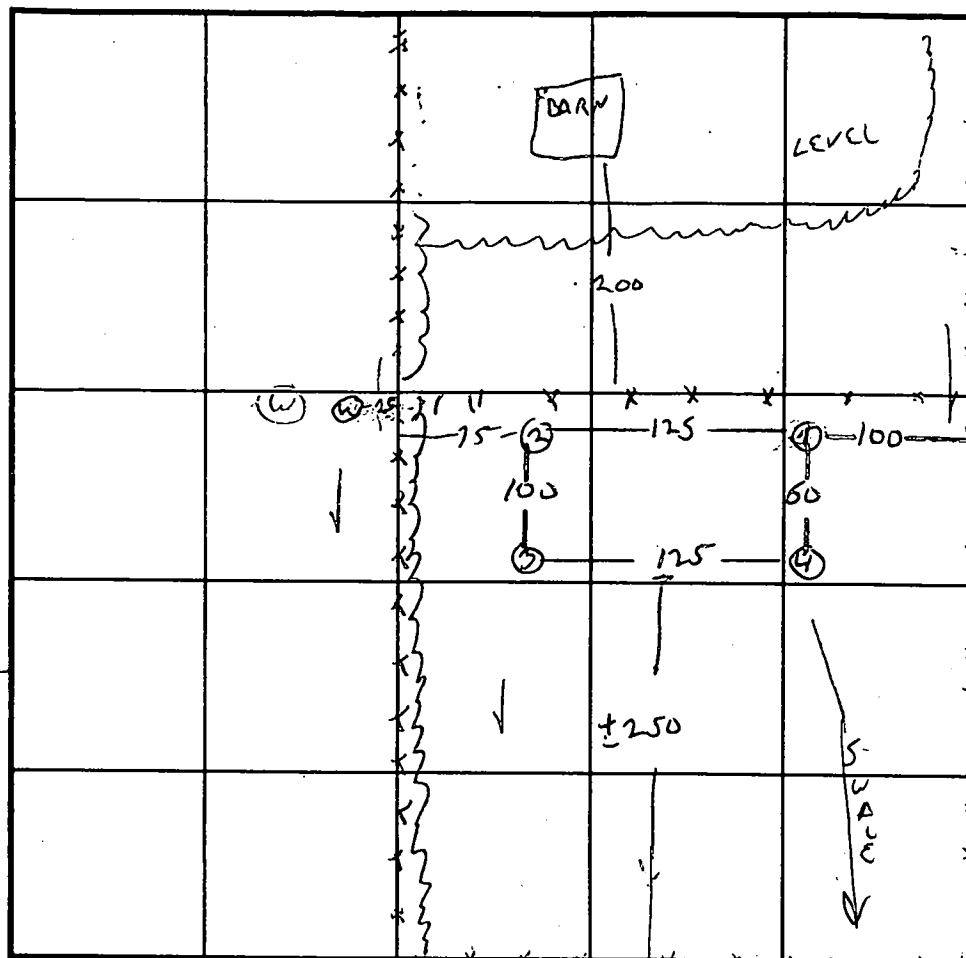

INDICATE NORTH - NAME ADJOINING ROADWAY AS BASE LINE TRIAD MILL ROAD

DATE	TEST NO.	DEPTH	PRE-WET START	PRE-WET STOP	TEST - 1" DROP START	TEST - 1" DROP STOP	TIME
5/11/98	4	4.5/12.5	10:39	10:40	→	10:43	3 MIN
	3	4/9.5	10:46	10:48	→	10:52	4 MIN
	1	3/12.5	VISUAL				0/L
	2	3/12	10:56	10:58	→	11:00	2 MIN
		7/12	10:57	10:58	→	11:00	2 MIN

REMARKS DEEP SYSTEM INITIALLY, SHALLOW REPAIRS, ALL HOLES DRY

TYPE OF SOIL

TESTED BY G SAUSAGE

ALSO PRESENT K+K

TRENCH DESIGN DATA: AVERAGE PERCOLATION TIME 3 MIN

TRENCH WIDTH 32

INLET DEPTH 3

MAXIMUM BOTTOM DEPTH 7

SQ. FT./BEDROOM 180