


4 ATTIC SECTION w/ OPT. 539 : THIRD FLOOR WALK UP SPACE
 A-408 SCALE: 1/4"=1'-0"
 TOLUNA ARCH DWS


3 ATTIC SECTION w/ OPT. 539 : THIRD FLOOR WALK UP SPACE
 A-408 SCALE: 1/4"=1'-0"
 TOLUNA ARCH DWS

- GENERAL PLAN NOTES**
- A. ALL WOOD STUD PARTITIONS NOT DIMENSIONED ARE TO BE 3 1/2" FOR INTERIOR AND 5 1/2" FOR EXTERIOR WALLS UNLESS OTHERWISE NOTED.
 - B. ALL INTERIOR DIMENSIONS ARE TO FACE OF STUDS.
 - C. ALL EXTERIOR DIMENSIONS ARE TO FACE OF STUDS.
 - D. ALL DIMENSIONS GOVERN OVER SCALE.
 - E. ALL SMOKE DETECTORS ARE TO BE WIRED IN SUCH A MANNER THAT ACTIVATION OF ONE WILL ACTIVATE THEM ALL.
 - F. ENCLOSED ACCESSIBLE SPACE UNDER STAIRS SHALL HAVE WALLS AND SOFFITS PROTECTED ON ENCLOSED SIDE WITH 1/2" GYPSUM BOARD.
 - G. ALL WINDOWS SIZE ARE NOTED IN FEET + INCHES AS MEASURED FROM SASH TO SASH.
 - H. REFER TO ELEVATIONS FOR WINDOW HEAD HEIGHTS.
 - I. ALL DOORS ARE TO BE 6'-8" HIGH UNLESS OTHERWISE NOTED.
 - J. WASHER ALWAYS TO BE ON LEFT SIDE OF DRYER.
 - K. DISHWASHER ALWAYS TO BE ON RIGHT SIDE OF SINK.

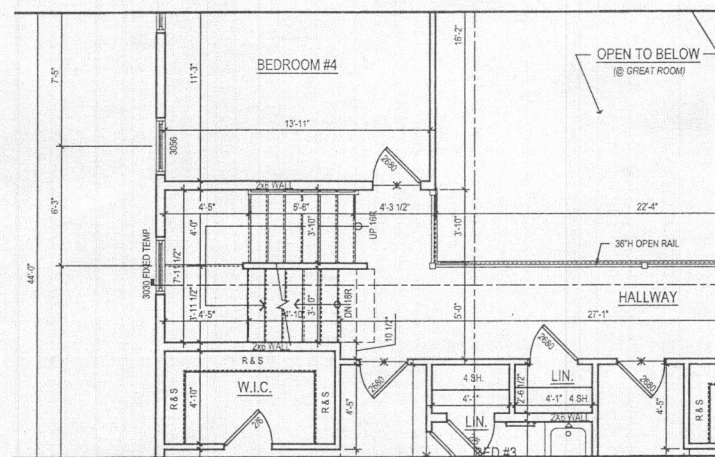

2 PART. SECOND FLOOR PLAN w/ OPT. 539 : THIRD FLOOR WALK UP SPACE
 A-408 SCALE: 1/4"=1'-0"
 TOLUNA ARCH DWS

USABLE SPACE	SQ. FT.
ATTIC LOFT AREA	545.70 SQ. FT.
50% AREA	272.85 SQ. FT.
AREA WITH 7' CEILING	342.30 SQ. FT.

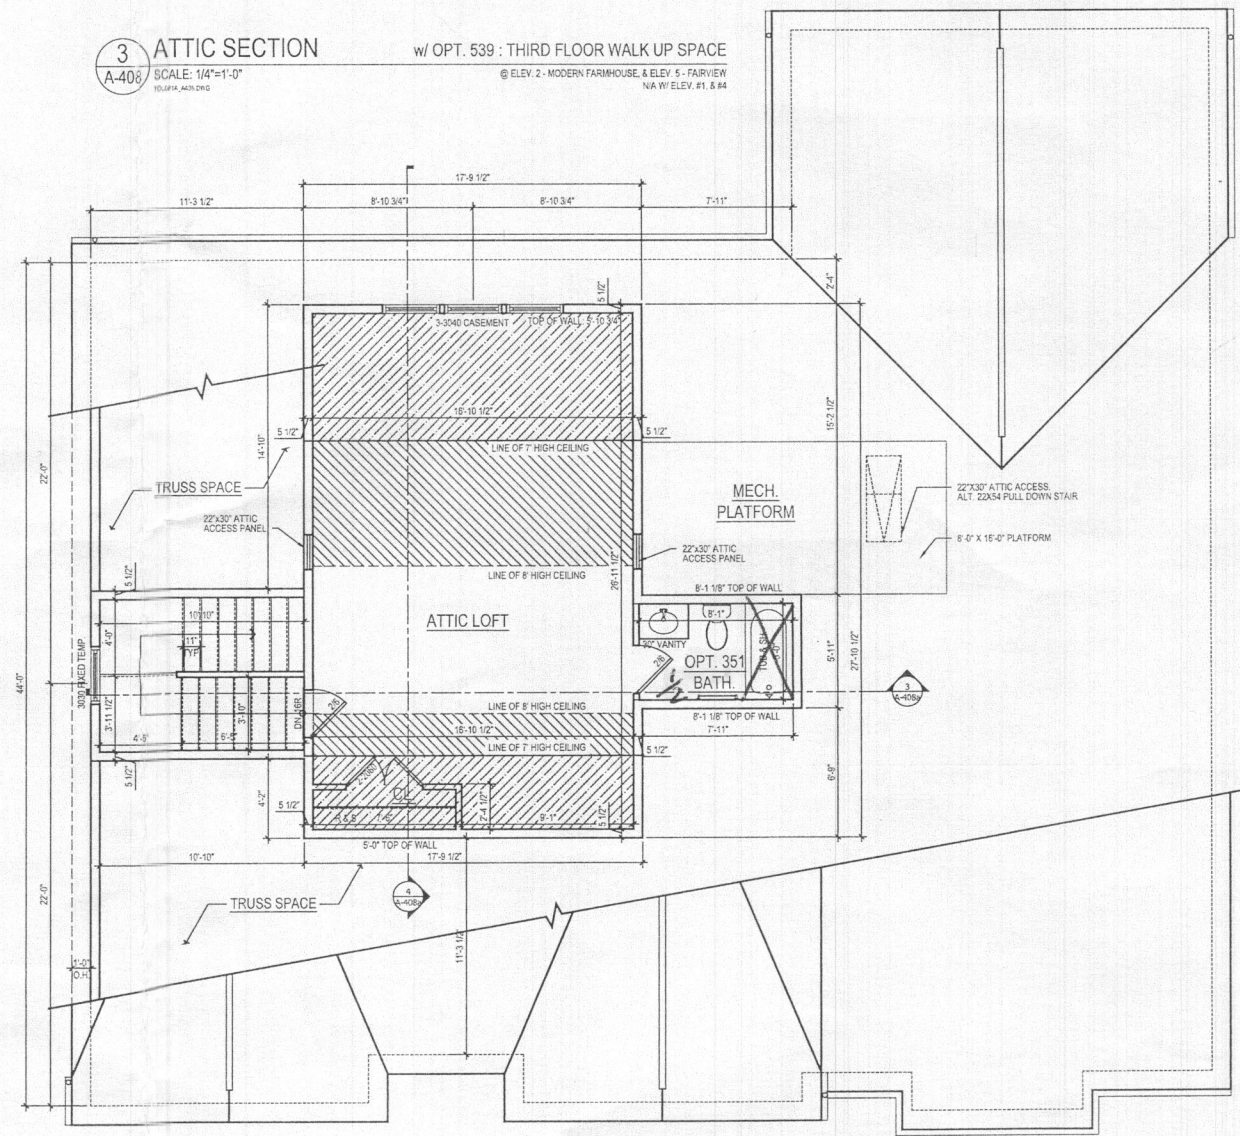

1 ATTIC FLOOR PLAN w/ OPT. 539 : THIRD FLOOR WALK UP SPACE
 A-408 SCALE: 1/4"=1'-0"
 TOLUNA ARCH DWS

ARCHITECT:
lessard
 DESIGN
 8521 Leesburg Pike
 Suite 700 | Vienna, VA 22182
 P: 571.830.1800 | F: 571.830.1801
 www.lessarddesign.com

SEAL & SIGNATURE:

OWNER:

TOLL BROTHERS
 19775 BELMONT EXECUTIVE PLAZA
 ASHBURN, VA 20147
 P: 571.291.8068
 CONTACT: CHRISTINA LEMLEY
 clemley@tollbrothers.com

PROJECT NAME:
MARYLAND

SHEET TITLE:

ISSUE / REVISION		
NO.	DESCRIPTION	DATE
1	BID SET	05.29.19
2	PERMIT SET	06.19.19
3	MD NEW STANDARDS	09.16.19
4	MR #220241	12.11.20

PROJECT No: TOL0819
 DRAWN BY: ACH
 CHECKED BY: AP
 PLOT DATE: Jan. 20, 2021
 FILE NAME: TOL0819_A408.dwg

A-408

- Health Dept

10517 Pudding Lane

LOT 32

Kings forest

5BR
only for
OSD



USABLE SPACE	SQ. FT.
OPT. 013 RECREATION ROOM	1,172
OPT. 383 BATH	47
OPT. 263216 GUEST BEDROOM	210
OPT. 582 MEDIA ROOM	240
TOTAL	1,669

ARCHITECT:



lessard
DESIGN

8521 Leesburg Pike
Suite 700 | Vienna, VA 22182
P: 571.830.1800 | F: 571.830.1801
www.lessarddesign.com

SEAL & SIGNATURE:

OWNER:

TOLL BROTHERS
19775 BELMONT EXECUTIVE PLAZA
ASHBURN, VA 20147
P: 571.291.8068
CONTACT: CHRISTINA LEMLEY
clemley@tollbrothers.com

EXECUTIVE SERIES

MARYLAND

PARKHURST FLOOR PLANS

PROJECT NAME.

SHEET TIT 6.

ISSUE / REVISION		
NO.	DESCRIPTION	DATE
	BID SET	05.29.11
	PERMIT SET	06.19.11
1	MD NEW STANDARDS	09.16.11
2	MR #220241	12.11.2011

PROJECT No:	TOL 081a
DRAWN BY:	AC/RJ
CHECKED BY:	AI
PLOT DATE:	Jan. 20, 2021
FILE NAME:	TOL081a_A100.dwg


A-100a

©2001 LESSARD DESIGN INC. ALL RIGHTS RESERVED. THIS PLAN IS NOT TO BE REPRODUCED, CHANGED OR COPIED IN ANY FORM OR MANNER WITHOUT THE WRITTEN PERMISSION OF LESSARD DESIGN INC.


B22006742

GENERAL PLAN NOTES

- ALL WOOD STUD PARTITIONS NOT DIMENSIONED ARE TO BE 3 1/2" FOR INTERIOR AND 5 1/2" FOR EXTERIOR WALLS UNLESS OTHERWISE NOTED.
- ALL INTERIOR DIMENSIONS ARE TO FACE OF STUDS.
- ALL EXTERIOR DIMENSIONS ARE TO FACE OF STUDS.
- ALL DIMENSIONS GOVERN OVER SCALE.
- ALL SMOKE DETECTORS ARE TO BE WIRED IN SUCH A MANNER THAT ACTIVATION OF ONE WILL ACTIVATE THEM ALL.
- ENCLOSED ACCESSIBLE SPACE UNDER STAIRS SHALL HAVE WALLS AND SOFFITS PROTECTED ON ENCLOSED SIDE WITH 1/2" GYPSUM BOARD.
- ALL WINDOWS SIZE ARE NOTED IN FEET + INCHES AS MEASURED FROM SASH TO SASH.
- REFER TO ELEVATIONS FOR WINDOW HEAD HEIGHTS.
- ALL DOORS ARE TO BE 6'-8" HIGH UNLESS OTHERWISE NOTED.
- WASHER ALWAYS TO BE ON LEFT SIDE OF DRYER.
- DISHWASHER ALWAYS TO BE ON RIGHT SIDE OF SINK.

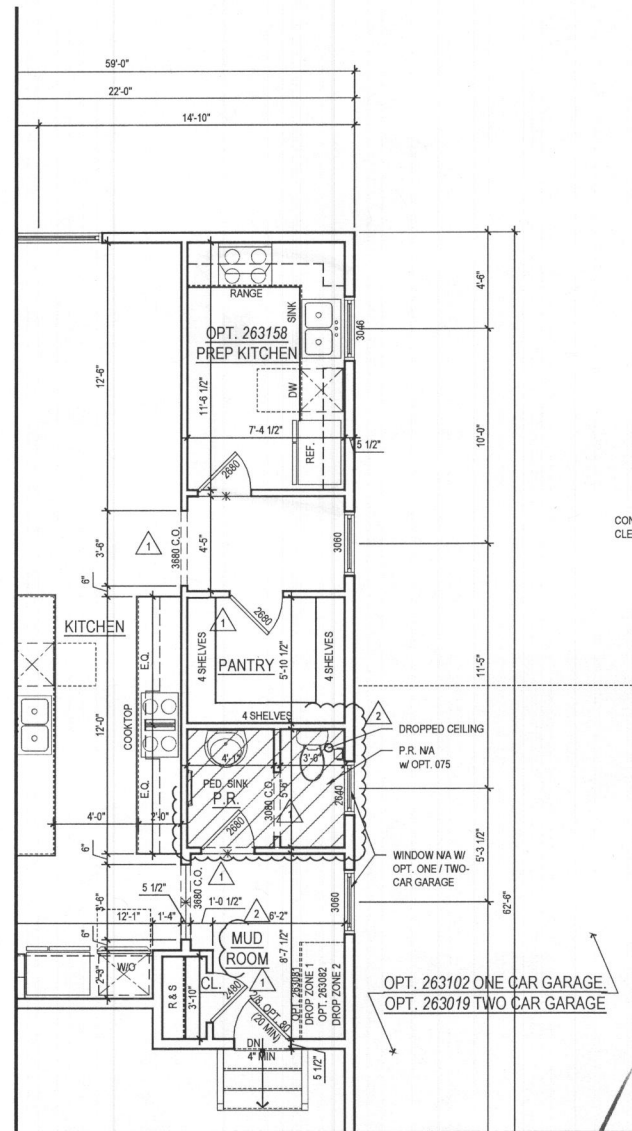

2 PART. FIRST FLOOR PLAN w/ OPT. 263158 - OPT. PREP KITCHEN
A-110 SCALE: 1/4"=1'-0"
TOL081a_A110.dwg

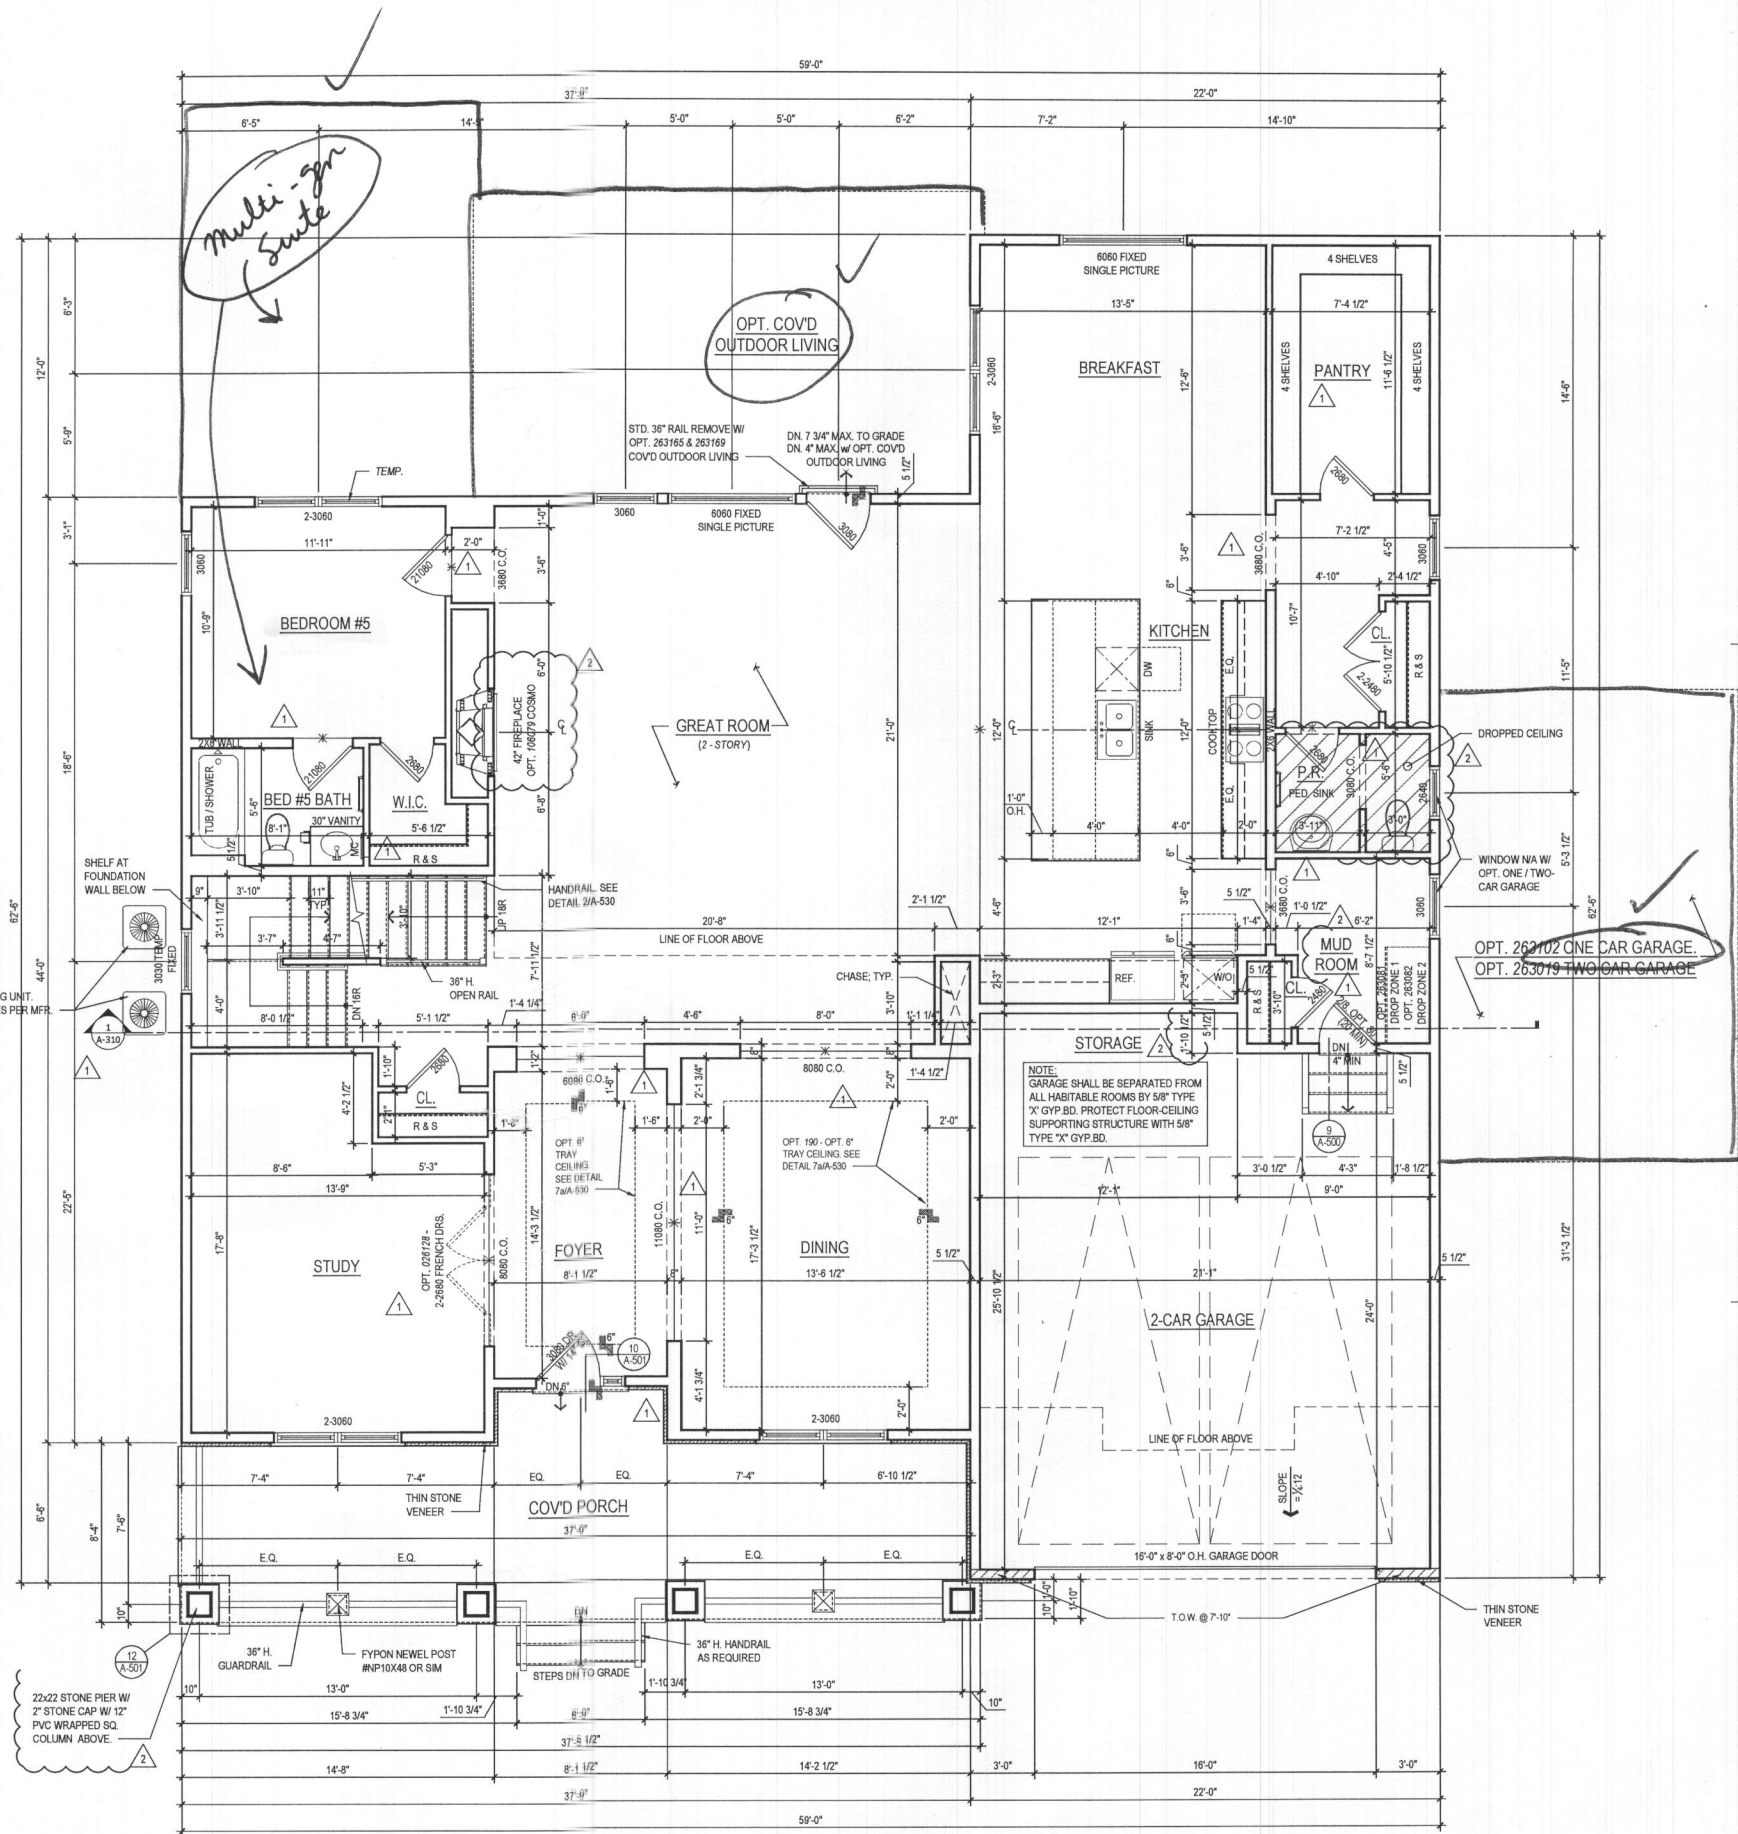

1 FIRST FLOOR PLAN
A-110 SCALE: 1/4"=1'-0"
TOL081a_A110.dwg

@ ELEV. 1 - CRAFTSMAN

ARCHITECT:



lessard
DESIGN

8521 Leesburg Pike
Suite 700 | Vienna, VA 22182
P: 571.830.1800 | F: 571.830.1801
www.lessarddesign.com

SEAL & SIGNATURE:

OWNER:

TOLL BROTHERS
19775 BELMONT EXECUTIVE PLAZA
ASHBURN, VA 20147
P: 571.291.8068
CONTACT: CHRISTINA LEMLEY
clemley@tollbrothers.com



MARYLAND

PARKHURST FLOOR PLANS


PROJECT NAME:

SHEET TITLE:

ISSUE / REVISION		
NO.	DESCRIPTION	DATE
1	BID SET	05.29.19
2	PERMIT SET	06.19.19
3	MD NEW STANDARDS	09.16.19
4	MR #220241	12.11.20

PROJECT No: TOL081a
DRAWN BY: ACN
CHECKED BY: AP
PLOT DATE: Jan. 20, 2021
FILE NAME: TOL081a_A110.dwg


A-110

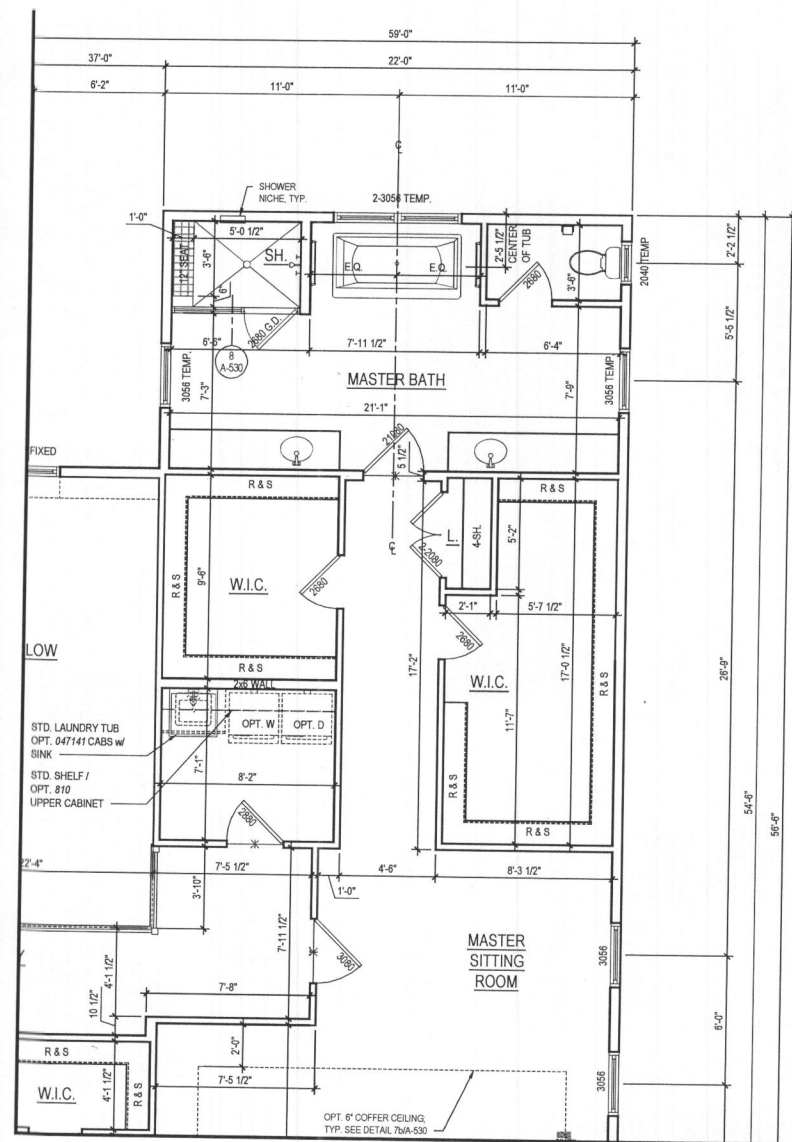

2 PART. SECOND FLOOR PLAN W/ OPT. 030 - ADDITIONAL WALK IN CLOSET
A-120 SCALE: 1/4"=1'-0"
TOL081A_A120.DWG

GENERAL PLAN NOTES

- ALL WOOD STUD PARTITIONS NOT DIMENSIONED ARE TO BE 3 1/2" FOR INTERIOR AND 5 1/2" FOR EXTERIOR WALLS UNLESS OTHERWISE NOTED.
- ALL INTERIOR DIMENSIONS ARE TO FACE OF STUDS.
- ALL EXTERIOR DIMENSIONS ARE TO FACE OF STUDS.
- ALL DIMENSIONS GOVERN OVER SCALE.
- ALL SMOKE DETECTORS ARE TO BE WIRED IN SUCH A MANNER THAT ACTIVATION OF ONE WILL ACTIVATE THEM ALL.
- ENCLOSED ACCESSIBLE SPACE UNDER STAIRS SHALL HAVE WALLS AND SOFFITS PROTECTED ON ENCLOSED SIDE WITH 1/2" GYPSUM BOARD.
- ALL WINDOWS SIZE ARE NOTED IN FEET + INCHES AS MEASURED FROM SASH TO SASH.
- REFER TO ELEVATIONS FOR WINDOW HEAD HEIGHTS.
- ALL DOORS ARE TO BE 6'-8" HIGH UNLESS OTHERWISE NOTED.
- WASHER ALWAYS TO BE ON LEFT SIDE OF DRYER.
- DISHWASHER ALWAYS TO BE ON RIGHT SIDE OF SINK.

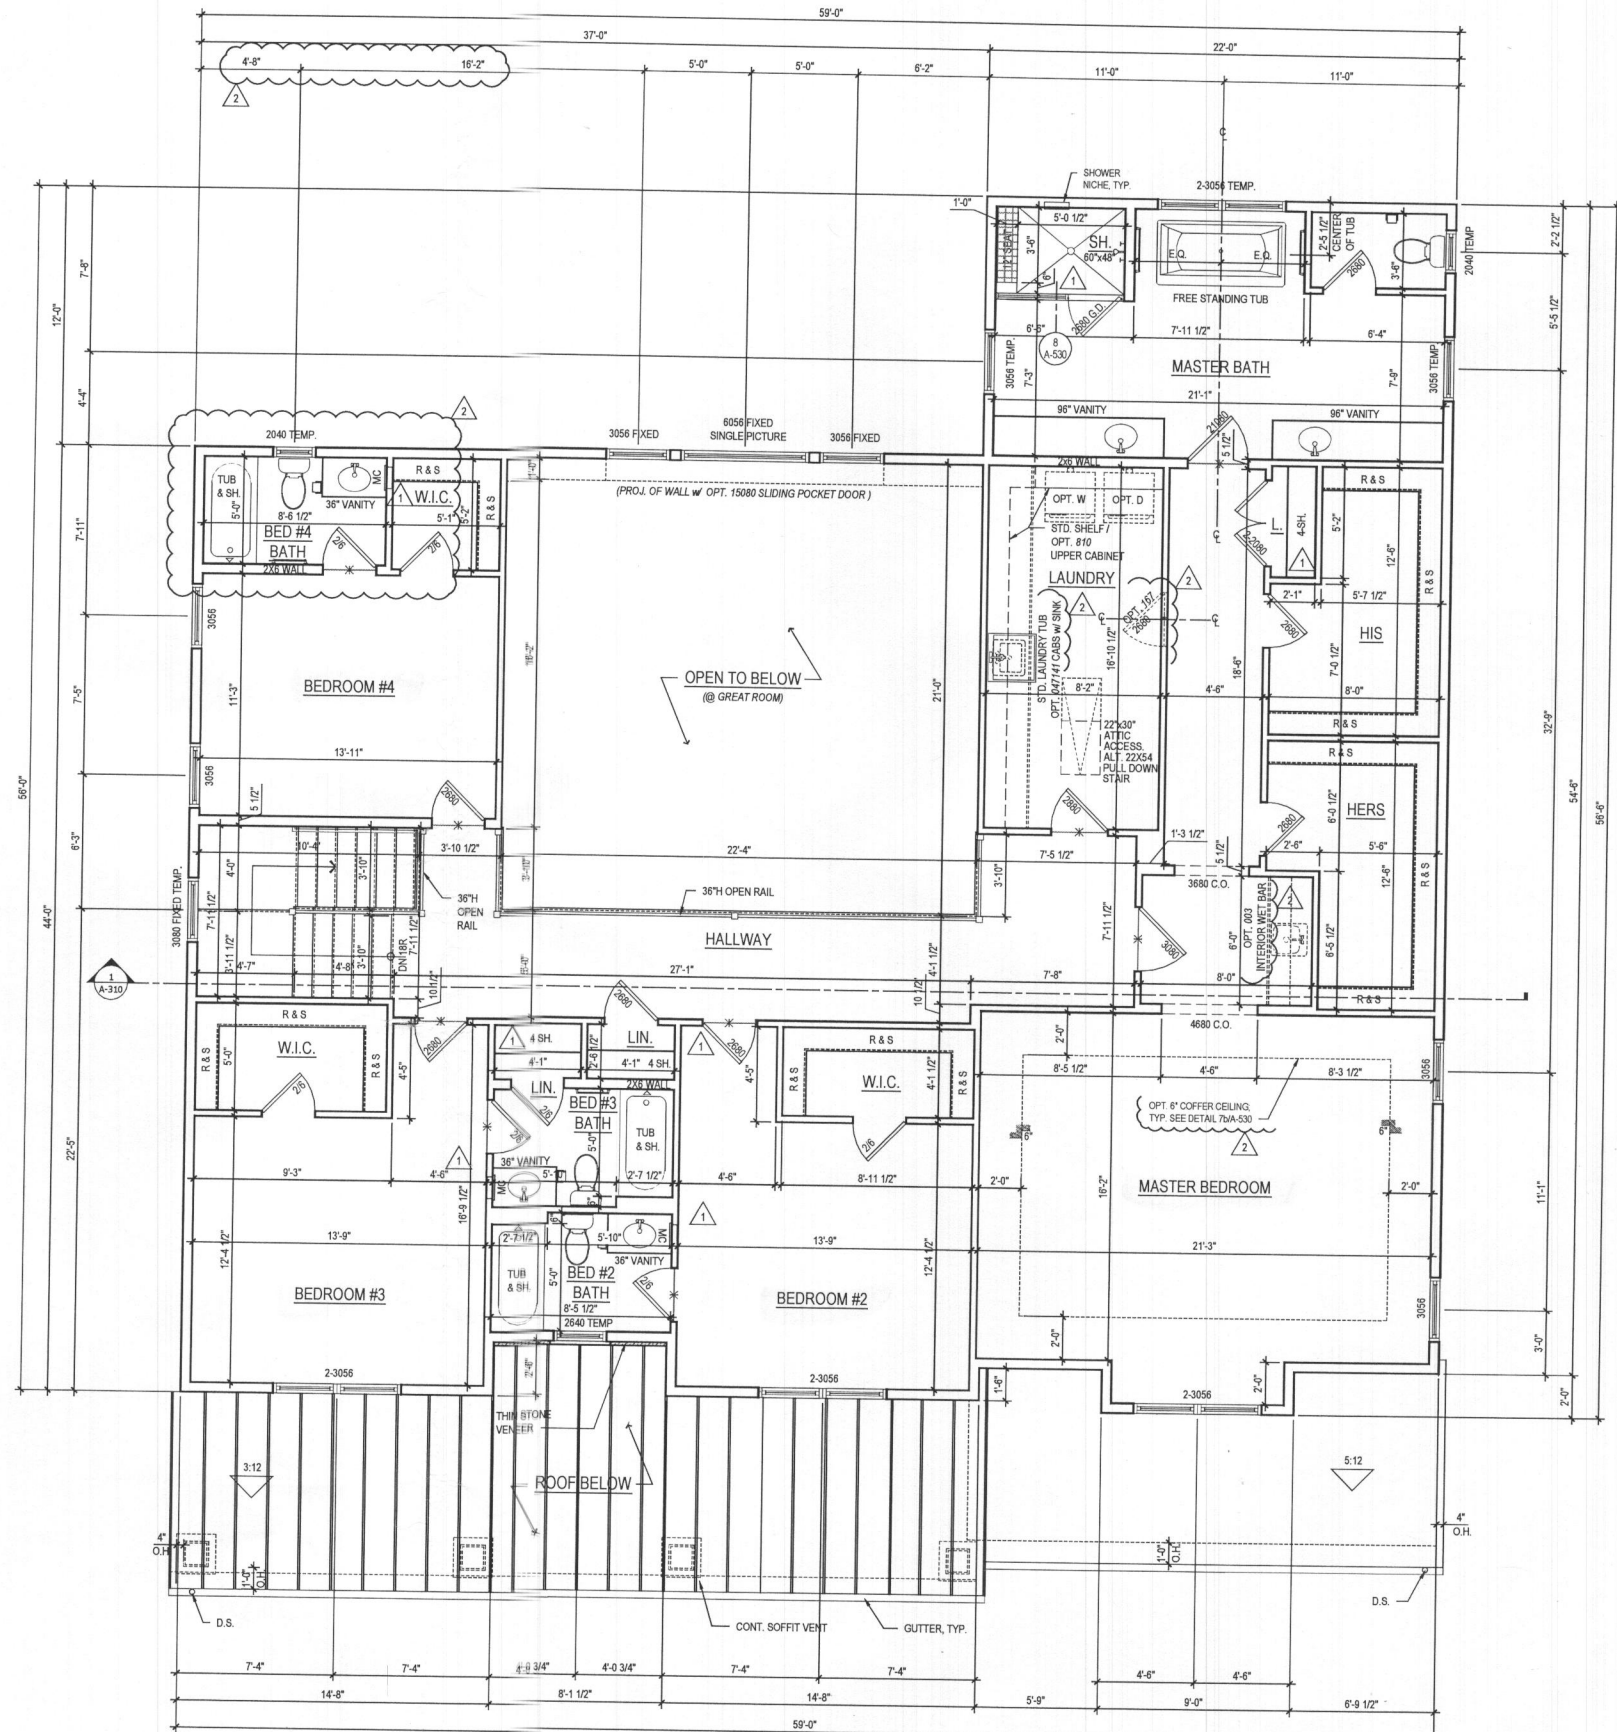

1 SECOND FLOOR PLAN
A-120 SCALE: 1/4"=1'-0"
TOL081A_A120.DWG

@ ELEV. 1 - CRAFTSMAN

ARCHITECT:
lessard DESIGN
8521 Leesburg Pike
Suite 700 | Vienna, VA 22182
P: 571.830.1800 | F: 571.830.1801
www.lessarddesign.com

SEAL & SIGNATURE:

OWNER:

TOLL BROTHERS
19775 BELMONT EXECUTIVE PLAZA
ASHBURN, VA 20147
P: 571.291.8068
CONTACT: CHRISTINA LEMLEY
clemley@tollbrothers.com

MARYLAND
EXECUTIVE DESIGN

**PARKHURST
FLOOR PLANS**


PROJECT NAME:

SHEET TITLE:

ISSUE / REVISION		
NO.	DESCRIPTION	DATE
1	BID SET	05.29.19
2	PERMIT SET	06.19.19
3	MD NEW STANDARDS	09.16.19
4	MR #220241	12.11.20


PROJECT No: TOL081a
DRAWN BY: AC/RN
CHECKED BY: AP
PLOT DATE: Jan. 20, 2021
FILE NAME: TOL081a_A120.dwg

A-120

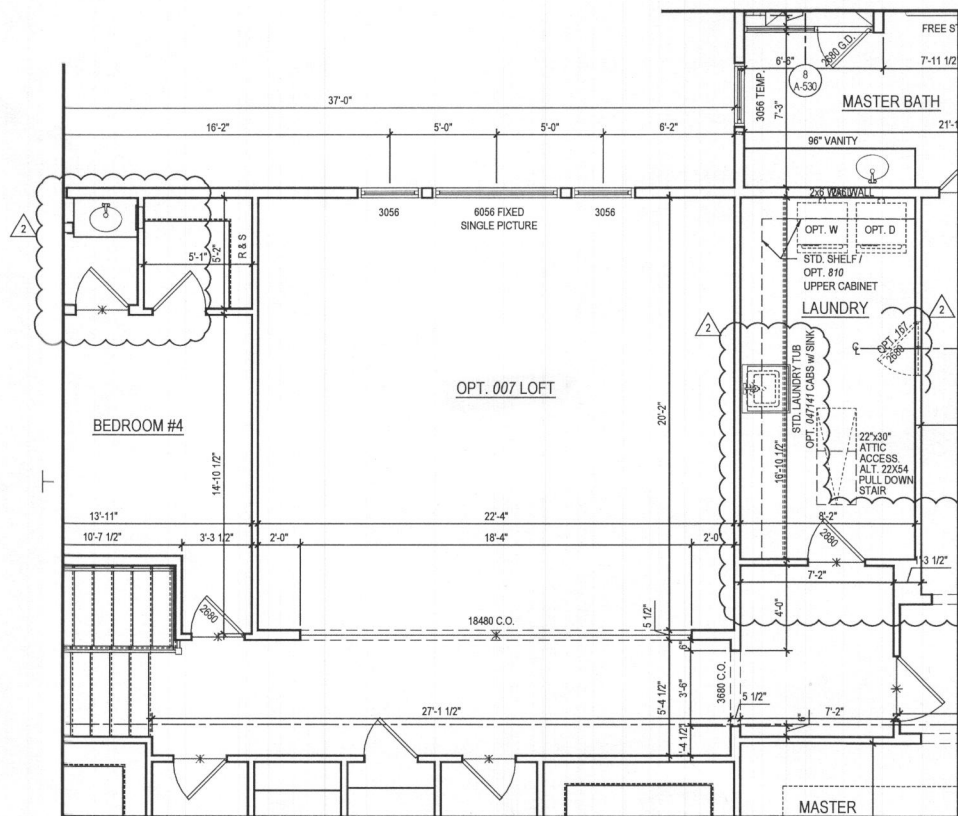


3 PART. SECOND FLOOR PLAN
A-121 SCALE: 1/4"=1'-0"
TOL081A_A121.DWG

W/ OPT. 007 LOFT

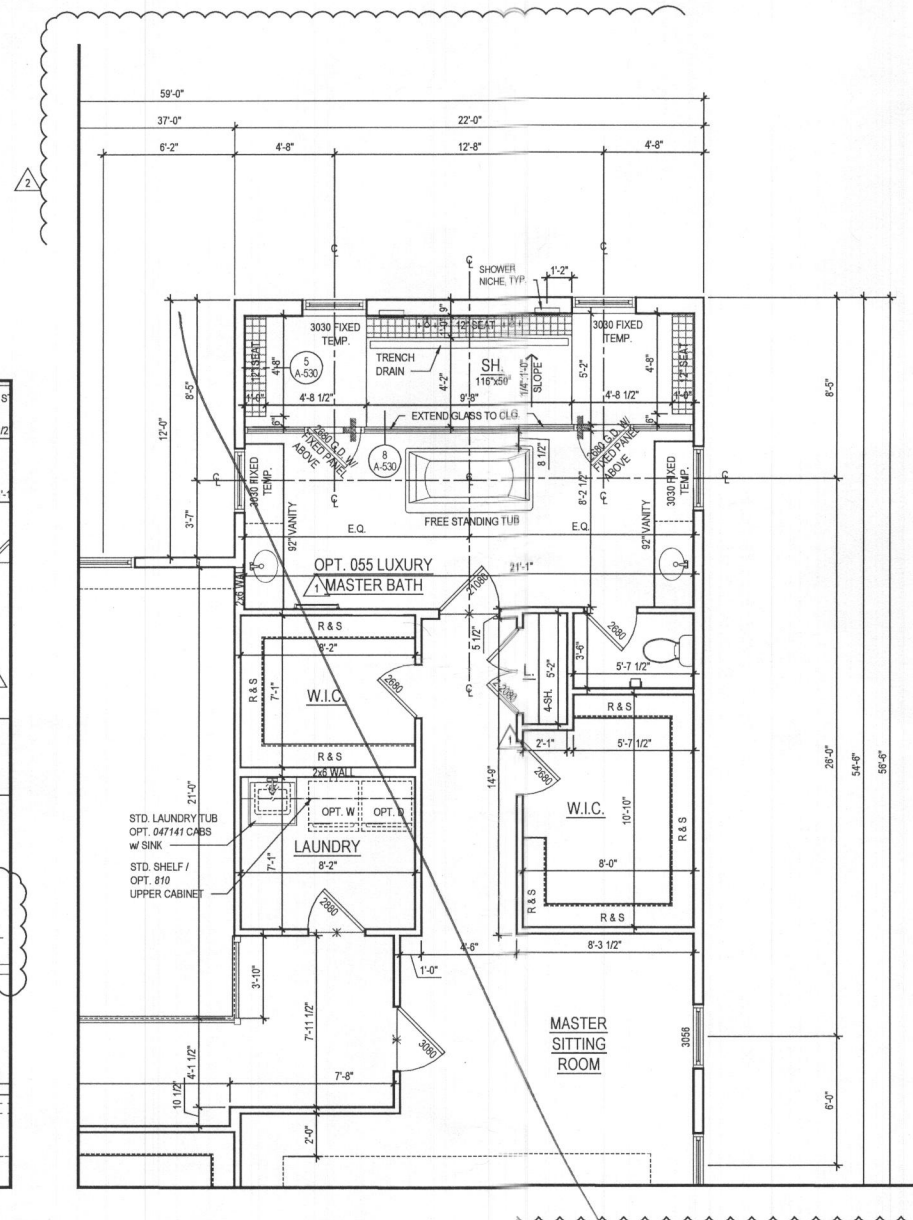

2 PART. SECOND FLOOR PLAN
A-121 SCALE: 1/4"=1'-0"
TOL081A_A121.DWG

W/ OPT. 055 - LUXURY MASTER BATH
W/ OPT. 030 - ADDITIONAL WALK IN CLOSET

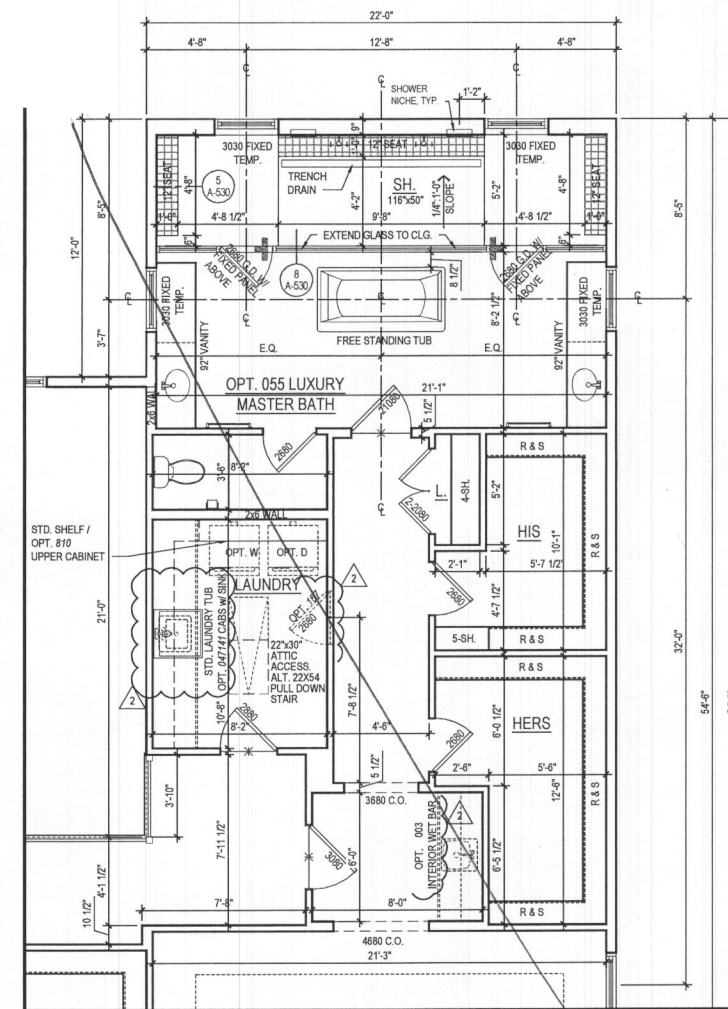

1 PART. SECOND FLOOR PLAN
A-121 SCALE: 1/4"=1'-0"
TOL081A_A121.DWG

- GENERAL PLAN NOTES
- A. ALL WOOD STUD PARTITIONS NOT DIMENSIONED ARE TO BE 3 1/2" FOR INTERIOR AND 5 1/2" FOR EXTERIOR WALLS UNLESS OTHERWISE NOTED.
 - B. ALL INTERIOR DIMENSIONS ARE TO FACE OF STUDS.
 - C. ALL EXTERIOR DIMENSIONS ARE TO FACE OF STUDS.
 - D. ALL DIMENSIONS GOVERN OVER SCALE.
 - E. ALL SMOKE DETECTORS ARE TO BE WIRED IN SUCH A MANNER THAT ACTIVATION OF ONE WILL ACTIVATE THEM ALL.
 - F. ENCLOSED ACCESSIBLE SPACE UNDER STAIRS SHALL HAVE WALLS AND SOFFITS PROTECTED ON ENCLOSED SIDE WITH 1/2" GYPSUM BOARD.
 - G. ALL WINDOWS SIZE ARE NOTED IN FEET + INCHES AS MEASURED FROM SASH TO SASH.
 - H. REFER TO ELEVATIONS FOR WINDOW HEAD HEIGHTS.
 - I. ALL DOORS ARE TO BE 6'-8" HIGH UNLESS OTHERWISE NOTED.
 - J. WASHER ALWAYS TO BE ON LEFT SIDE OF DRYER.
 - K. DISHWASHER ALWAYS TO BE ON RIGHT SIDE OF SINK.

ARCHITECT:
lessard
DESIGN
8521 Leesburg Pike
Suite 700 | Vienna, VA 22182
P: 571.830.1800 | F: 571.830.1801
www.lessarddesign.com

SEAL & SIGNATURE:

OWNER:

TOLL BROTHERS
19775 BELMONT EXECUTIVE PLAZA
ASHBURN, VA 20147
P: 571.291.8068
CONTACT: CHRISTINA LEMLEY
clemley@tollbrothers.com


PARKHURST
FLOOR PLANS
MARYLAND

PROJECT NAME:
SHEET TITLE:


ISSUE / REVISION		
NO.	DESCRIPTION	DATE
1	BID SET	05.29.19
2	PERMIT SET	06.19.19
3	MD NEW STANDARDS	09.16.19
4	MR #220241	12.11.20

PROJECT NO: TOL081A
DRAWN BY: ACB
CHECKED BY: AD
PLOT DATE: Jan. 20, 2021
FILE NAME: TOL081a_A121.dwg


A-121

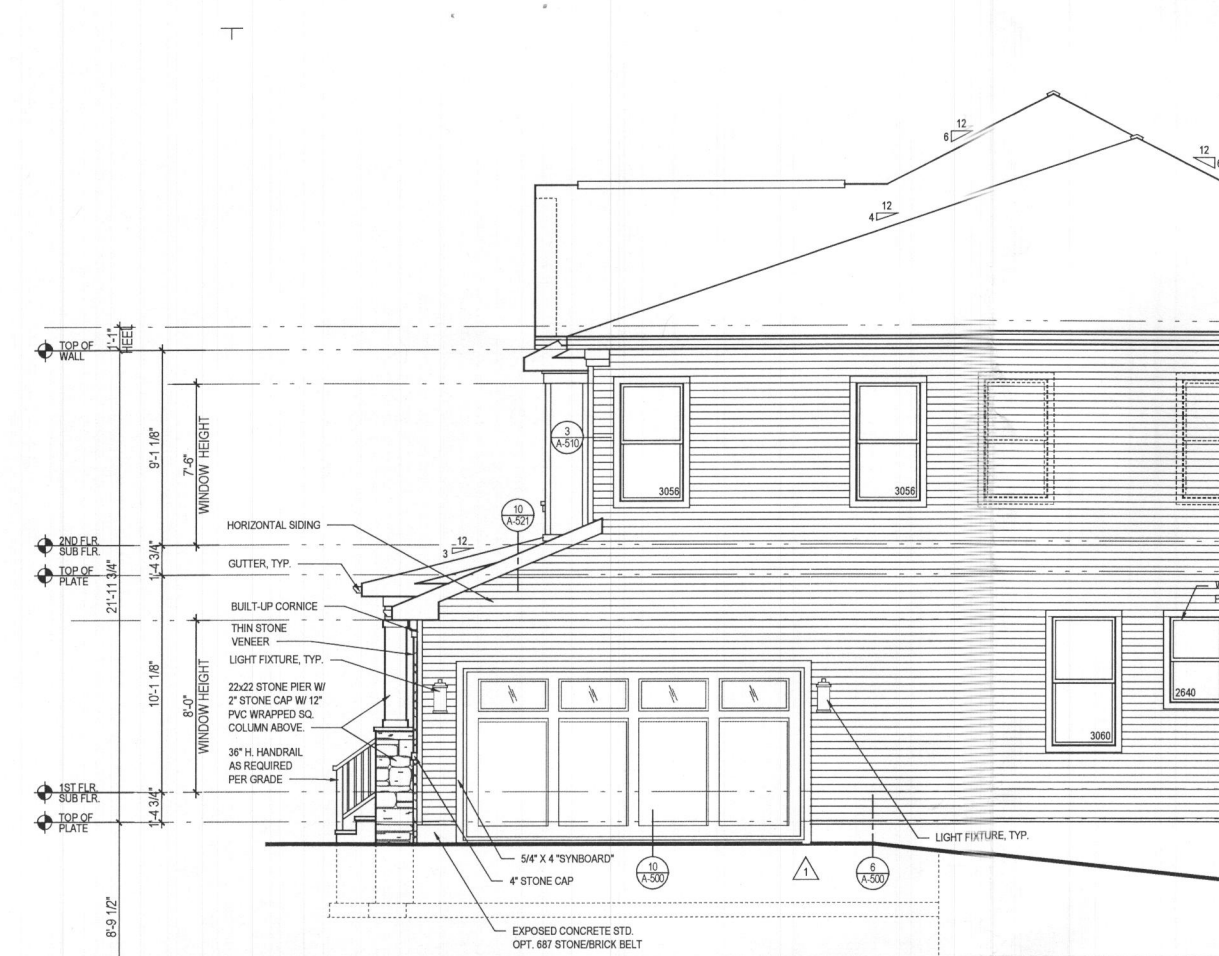


4 PART. RIGHT SIDE ELEVATION w/ OPT. 012 - SIDE LOAD GARAGE
 A-400 SCALE: 1/4"=1'-0"
 TOL081A_A400.DWG ELEV. 1 - SHOWN

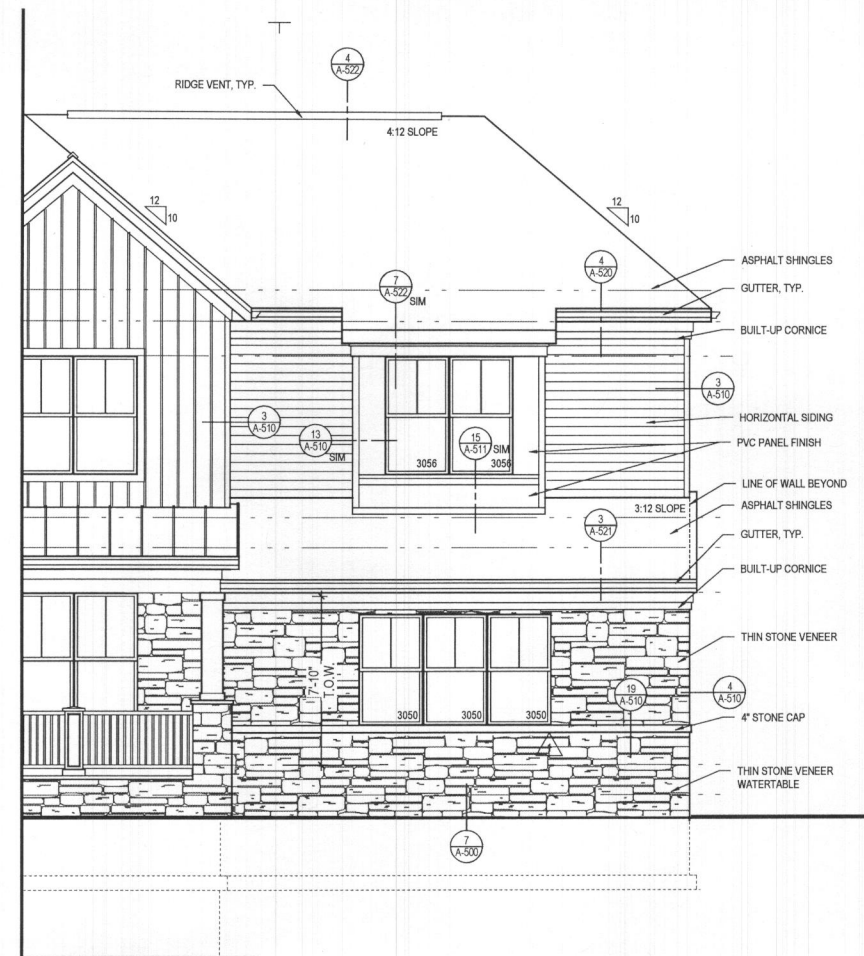

3 PART. FRONT ELEVATION w/ OPT. 012 - SIDE LOAD GARAGE
 A-400 SCALE: 1/4"=1'-0"
 TOL081A_A400.DWG ELEV. 1 - SHOWN

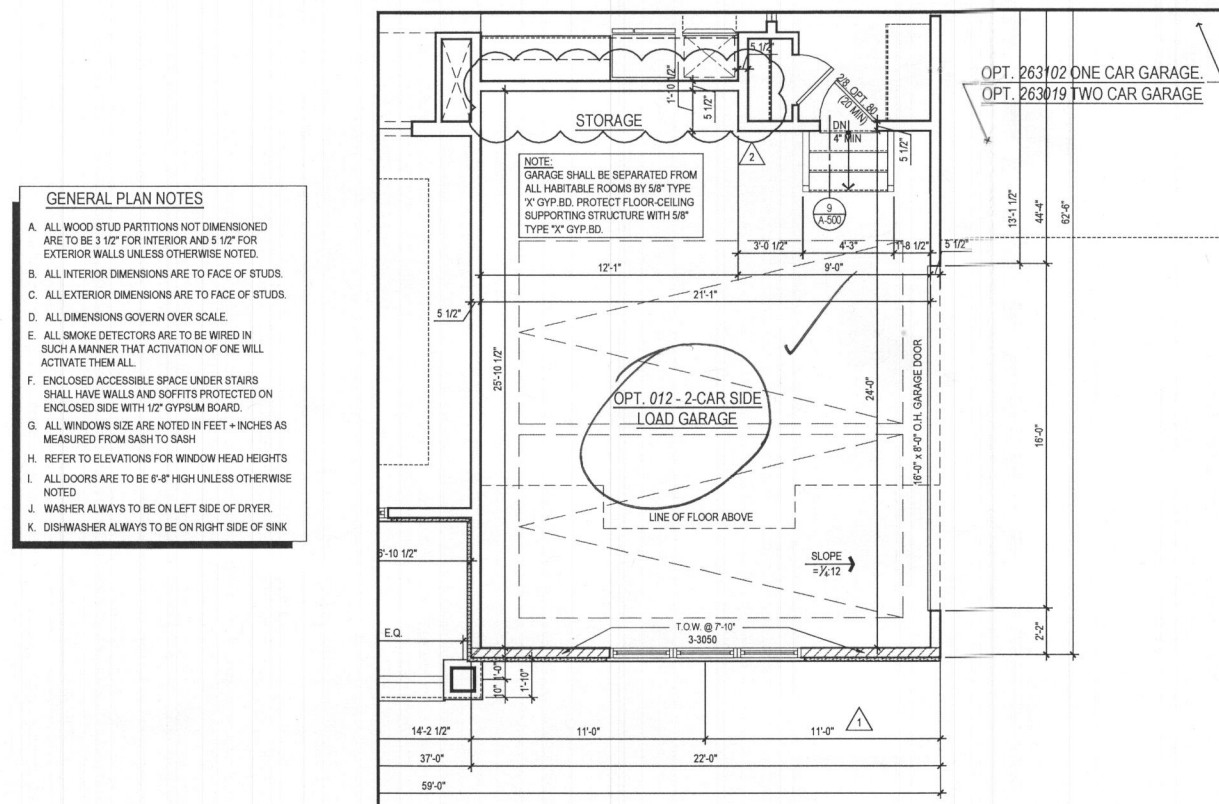

2 PART. FIRST FLOOR PLAN w/ OPT. 012 - SIDE LOAD GARAGE
 A-400 SCALE: 1/4"=1'-0"
 TOL081A_A400.DWG

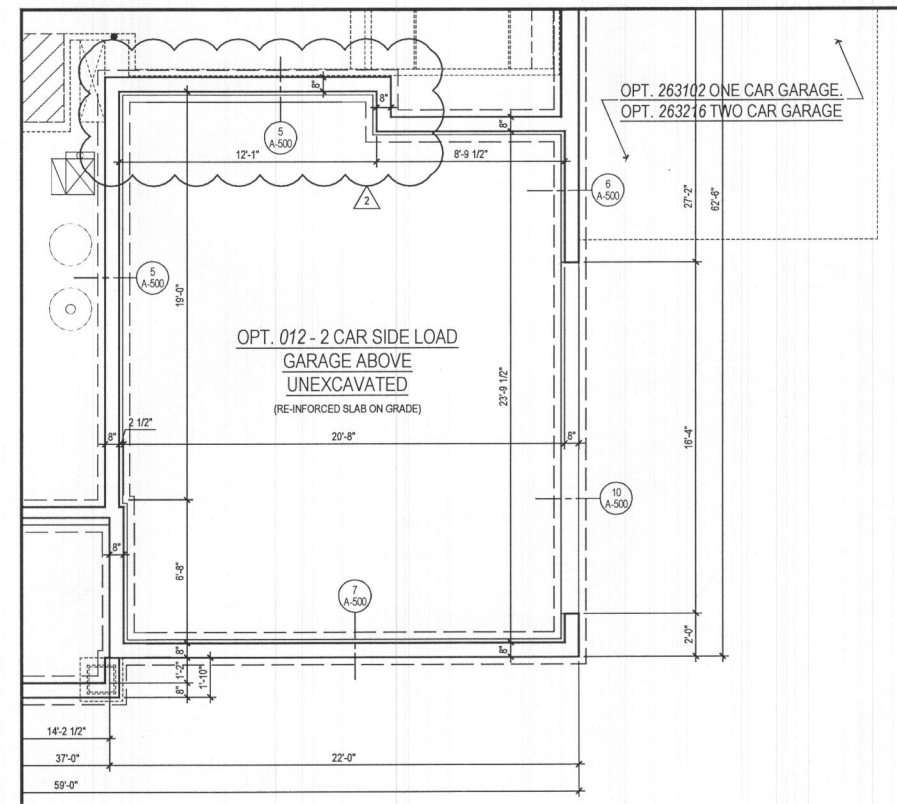


1 PART. BASEMENT FLOOR PLAN w/ OPT. 012 - SIDE LOAD GARAGE
 A-400 SCALE: 1/4"=1'-0"
 TOL081A_A400.DWG

GENERAL PLAN NOTES

- ALL WOOD STUD PARTITIONS NOT DIMENSIONED ARE TO BE 3 1/2" FOR INTERIOR AND 5 1/2" FOR EXTERIOR WALLS UNLESS OTHERWISE NOTED.
- ALL INTERIOR DIMENSIONS ARE TO FACE OF STUDS.
- ALL EXTERIOR DIMENSIONS ARE TO FACE OF STUDS.
- ALL DIMENSIONS GOVERN OVER SCALE.
- ALL SMOKE DETECTORS ARE TO BE WIRED IN SUCH A MANNER THAT ACTIVATION OF ONE WILL ACTIVATE THEM ALL.
- ENCLOSED ACCESSIBLE SPACE UNDER STAIRS SHALL HAVE WALLS AND SOFFITS PROTECTED ON ENCLOSED SIDE WITH 1/2" GYP/5/8" BOARD.
- ALL WINDOWS SIZE ARE NOTED IN FEET + INCHES AS MEASURED FROM SASH TO SASH.
- REFER TO ELEVATIONS FOR WINDOW HEAD HEIGHTS.
- ALL DOORS ARE TO BE 6'-8" HIGH UNLESS OTHERWISE NOTED.
- WASHER ALWAYS TO BE ON LEFT SIDE OF DRYER.
- DISHWASHER ALWAYS TO BE ON RIGHT SIDE OF SINK.

ARCHITECT:

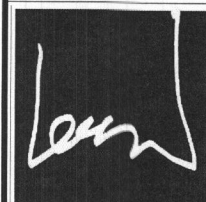

lessard
DESIGN

8521 Leesburg Pike
 Suite 700 | Vienna, VA 22182
 P: 571.830.1800 | F: 571.830.1801
 www.lessarddesign.com

SEAL & SIGNATURE:

OWNER:

TOLL BROTHERS
 19775 BELMONT EXECUTIVE PLAZA
 ASHBURN, VA 20147
 P: 571.291.8068
 CONTACT: CHRISTINA LEMLEY
 clemley@tollbrothers.com



PARKHURST
OPTIONS


PROJECT NAME:

SHEET TITLE:


ISSUE / REVISION		
NO.	DESCRIPTION	DATE
BID SET		05.29.19
PERMIT SET		06.19.19
1	MD NEW STANDARDS	09.16.19
2	MR #220241	12.11.20

PROJECT No: TOL081a
 DRAWN BY: AC/RN
 CHECKED BY: 40
 PLOT DATE: Jan. 20, 2021
 FILE NAME: TOL081a_A400.dwg


A-400

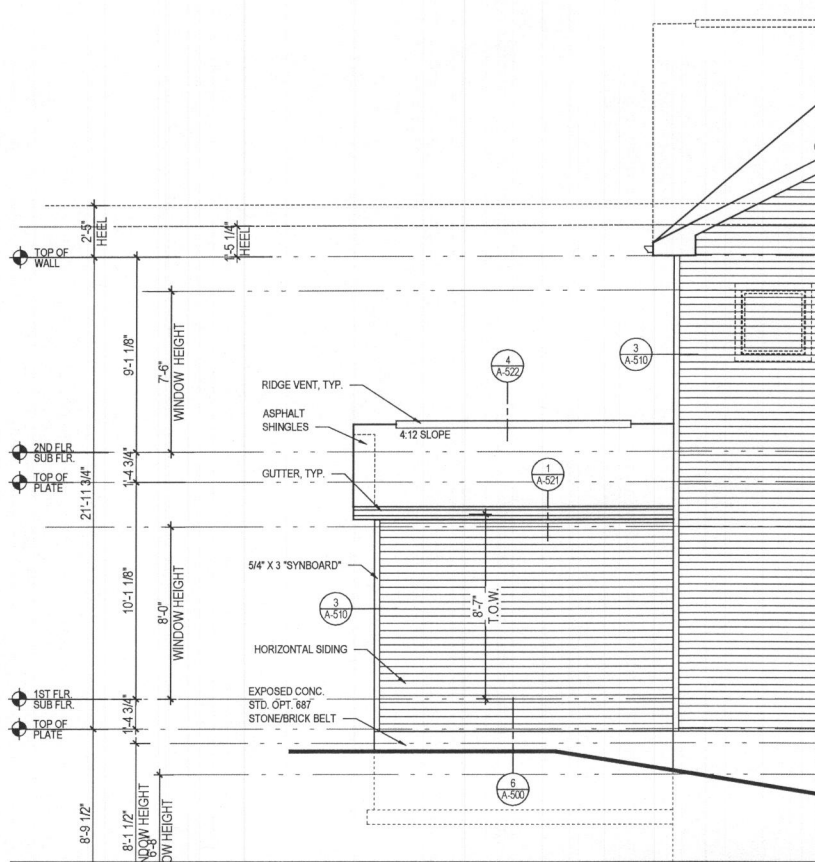


6 PART. REAR ELEVATION w/ OPT. 263102 - ONE CAR GARAGE
A-401 SCALE: 1/4"=1'-0" ELEV. 1 - SHOWN
TOL081A_A401.DWG

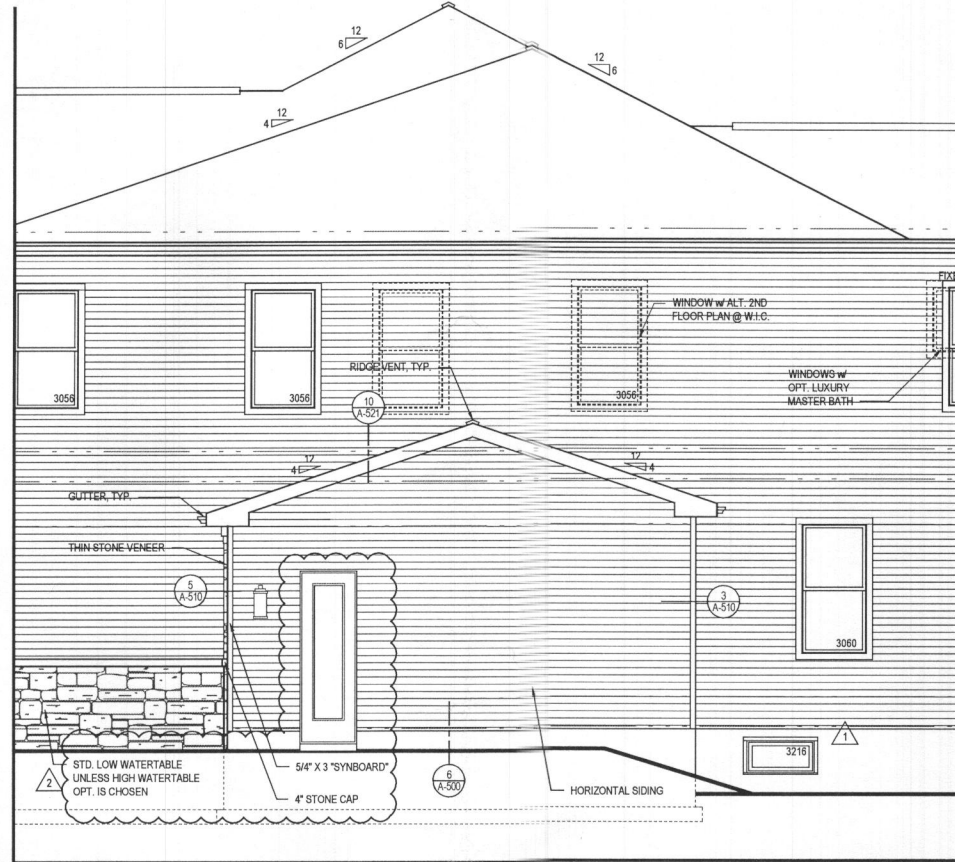


5 PART. RIGHT SIDE ELEVATION w/ OPT. 263102 - ONE CAR GARAGE
A-401 SCALE: 1/4"=1'-0" ELEV. 1 - SHOWN
TOL081A_A401.DWG

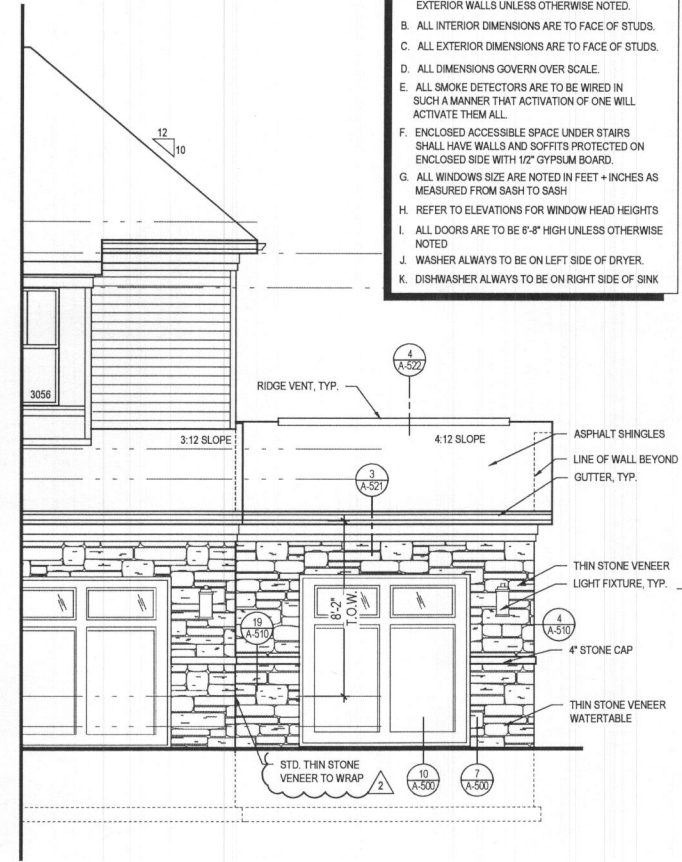


4 PART. FRONT ELEVATION w/ OPT. 263102 - ONE CAR GARAGE
A-401 SCALE: 1/4"=1'-0" ELEV. 1 - SHOWN
TOL081A_A401.DWG

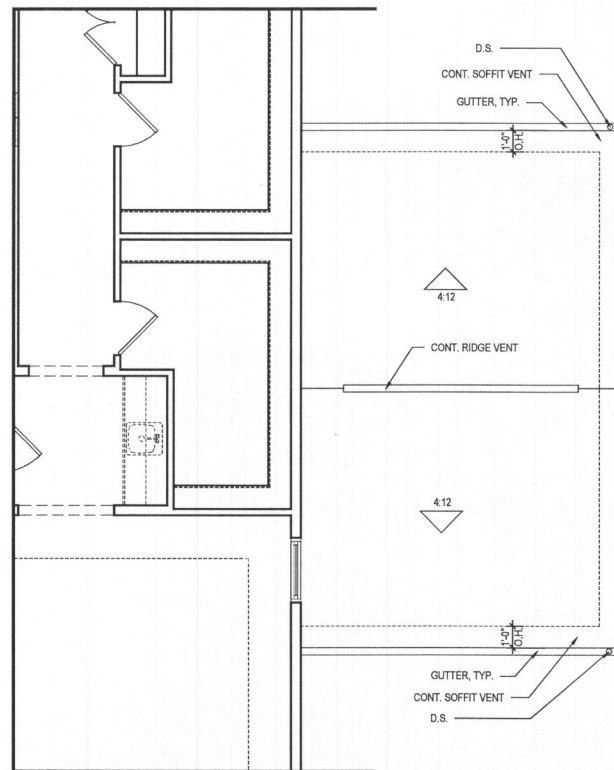

3 PART. SECOND FLOOR PLAN w/ OPT. 263102 - ONE CAR GARAGE
A-401 SCALE: 1/4"=1'-0" ELEV. 1 - SHOWN
TOL081A_A401.DWG

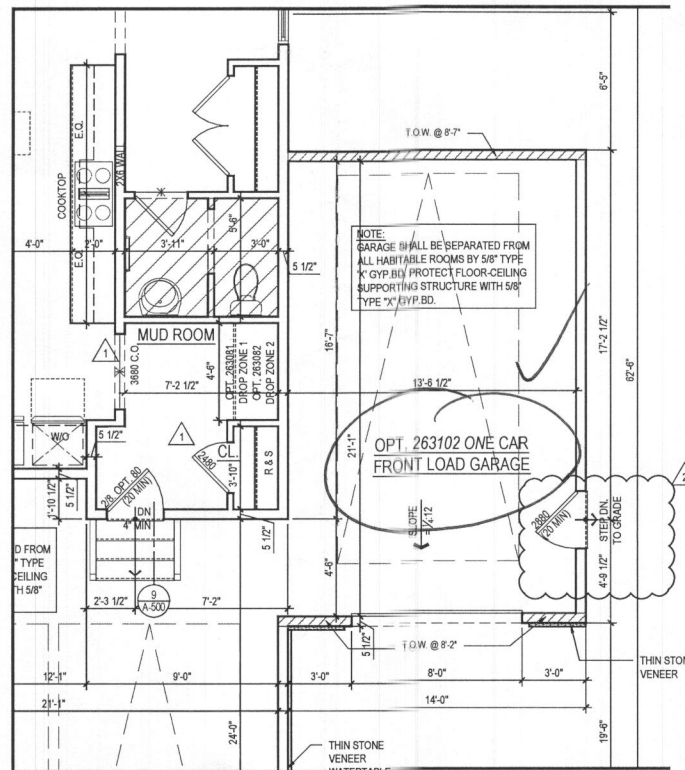

2 PART. FIRST FLOOR PLAN w/ OPT. 263102 - ONE CAR GARAGE
A-401 SCALE: 1/4"=1'-0" ELEV. 1 - SHOWN
TOL081A_A401.DWG

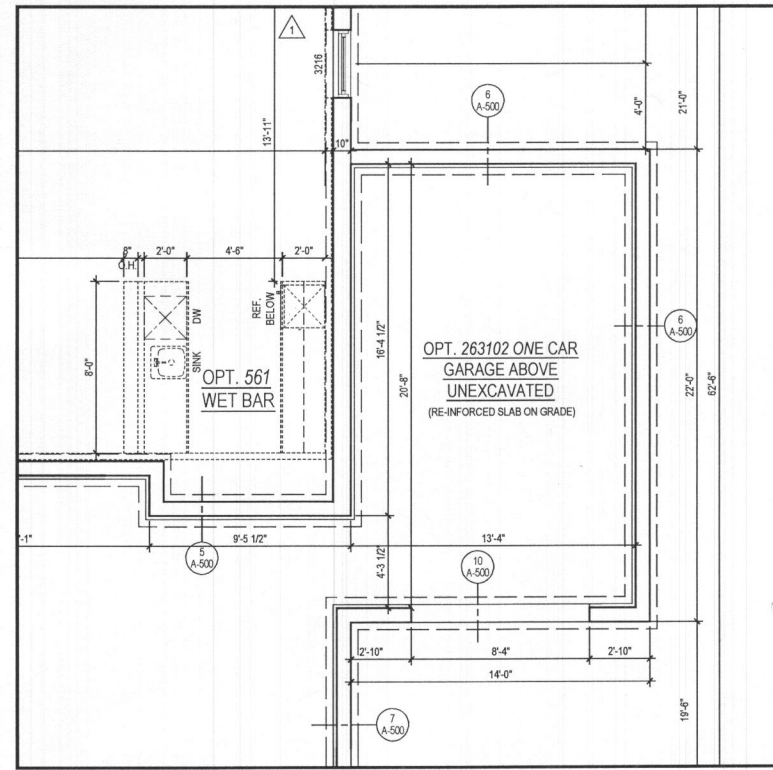


1 PART. BASEMENT FLOOR PLAN w/ OPT. 263102 - ONE CAR GARAGE
A-401 SCALE: 1/4"=1'-0" ELEV. 1 - SHOWN
TOL081A_A401.DWG

GENERAL PLAN NOTES

- ALL WOOD STUD PARTITIONS NOT DIMENSIONED ARE TO BE 3 1/2" FOR INTERIOR AND 5 1/2" FOR EXTERIOR WALLS UNLESS OTHERWISE NOTED.
- ALL INTERIOR DIMENSIONS ARE TO FACE OF STUDS.
- ALL EXTERIOR DIMENSIONS ARE TO FACE OF STUDS.
- ALL DIMENSIONS GOVERN OVER SCALE.
- ALL SMOKE DETECTORS ARE TO BE WIRED IN SUCH A MANNER THAT ACTIVATION OF ONE WILL ACTIVATE THEM ALL.
- ENCLOSED ACCESSIBLE SPACE UNDER STAIRS SHALL HAVE WALLS AND SOFFITS PROTECTED ON ENCLOSED SIDE WITH 1/2" GYPSUM BOARD.
- ALL WINDOWS SIZE ARE NOTED IN FEET + INCHES AS MEASURED FROM SASH TO SASH.
- REFER TO ELEVATIONS FOR WINDOW HEAD HEIGHTS.
- ALL DOORS ARE TO BE 6'-8" HIGH UNLESS OTHERWISE NOTED.
- WASHER ALWAYS TO BE ON LEFT SIDE OF DRYER.
- DISHWASHER ALWAYS TO BE ON RIGHT SIDE OF SINK.

ARCHITECT:

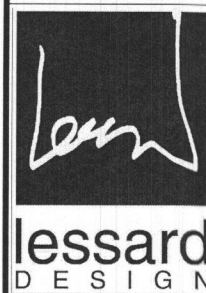

8521 Leesburg Pike
Suite 700 | Vienna, VA 22182
P: 571.830.1800 | F: 571.830.1801
www.lessarddesign.com

SEAL & SIGNATURE:

OWNER:

TOLL BROTHERS

19775 BELMONT EXECUTIVE PLAZA
ASHBURN, VA 20147
P: 571.291.8068
CONTACT: CHRISTINA LEMLEY
clemley@tollbrothers.com



PARKHURST OPTIONS

PROJECT NAME:

SHEET TITLE:


ISSUE / REVISION		
NO.	DESCRIPTION	DATE
BID SET		05.29.19
PERMIT SET		06.19.19
1	MD NEW STANDARDS	09.16.19
2	MR #220241	12.11.20

PROJECT NO:	TOL-081A
DRAWN BY:	AC/ML
CHECKED BY:	40
PLOT DATE:	Jan. 20, 2021
FILE NAME:	TOL081A_A401.dwg

A-401


GENERAL PLAN NOTES

- ALL WOOD STUD PARTITIONS NOT DIMENSIONED ARE TO BE 3 1/2" FOR INTERIOR AND 5 1/2" FOR EXTERIOR WALLS UNLESS OTHERWISE NOTED.
- ALL INTERIOR DIMENSIONS ARE TO FACE OF STUDS.
- ALL EXTERIOR DIMENSIONS ARE TO FACE OF STUDS.
- ALL DIMENSIONS GOVERN OVER SCALE.
- ALL SMOKE DETECTORS ARE TO BE WIRED IN SUCH A MANNER THAT ACTIVATION OF ONE WILL ACTIVATE THEM ALL.
- ENCLOSED ACCESSIBLE SPACE UNDER STAIRS SHALL HAVE WALLS AND SOFFITS PROTECTED ON ENCLOSED SIDE WITH 1/2" GYPSUM BOARD.
- ALL WINDOWS SIZE ARE NOTED IN FEET + INCHES AS MEASURED FROM SASH TO SASH.
- REFER TO ELEVATIONS FOR WINDOW HEAD HEIGHTS.
- ALL DOORS ARE TO BE 6'-8" HIGH UNLESS OTHERWISE NOTED.
- WASHER ALWAYS TO BE ON LEFT SIDE OF DRYER.
- DISHWASHER ALWAYS TO BE ON RIGHT SIDE OF SINK.

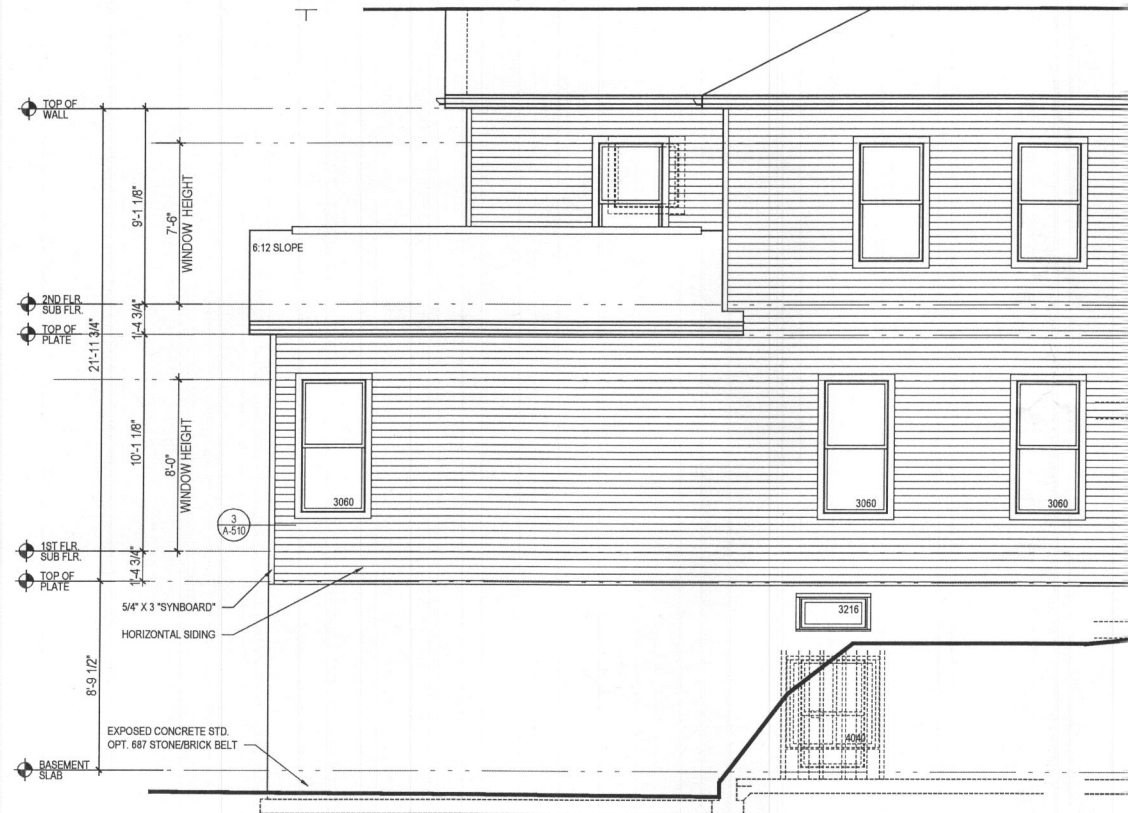


5 PART. LEFT ELEV.
A-407 SCALE: 1/4"=1'-0"

w/ OPT. 263073 MULTI-GEN. SUITE
w/ COVD OUTDOOR LIVING @ WALKOUT CONDITION

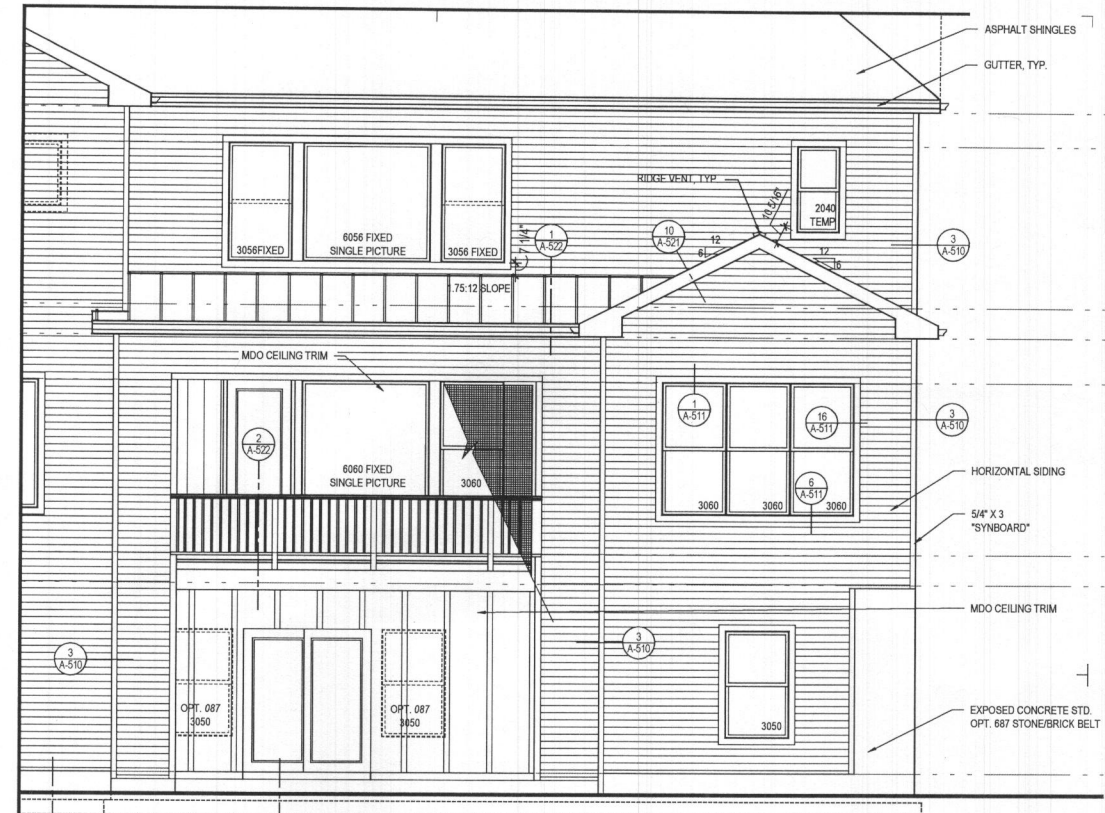


4 REAR ELEVATION
A-407 SCALE: 1/4"=1'-0"

w/ OPT. 263073 MULTI-GEN. SUITE
w/ COVD OUTDOOR LIVING @ WALKOUT CONDITION

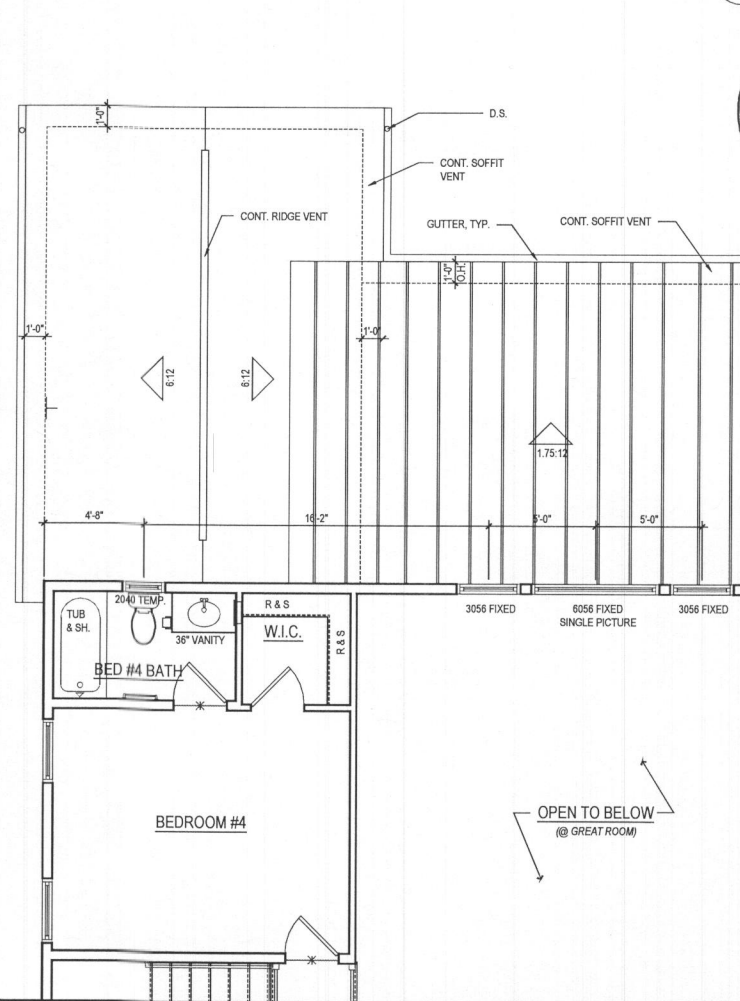


3 PART. SECOND FLOOR PLAN
A-407 SCALE: 1/4"=1'-0"

w/ OPT. 263073 MULTI-GEN. SUITE
w/ COVD OUTDOOR LIVING @ WALKOUT CONDITION

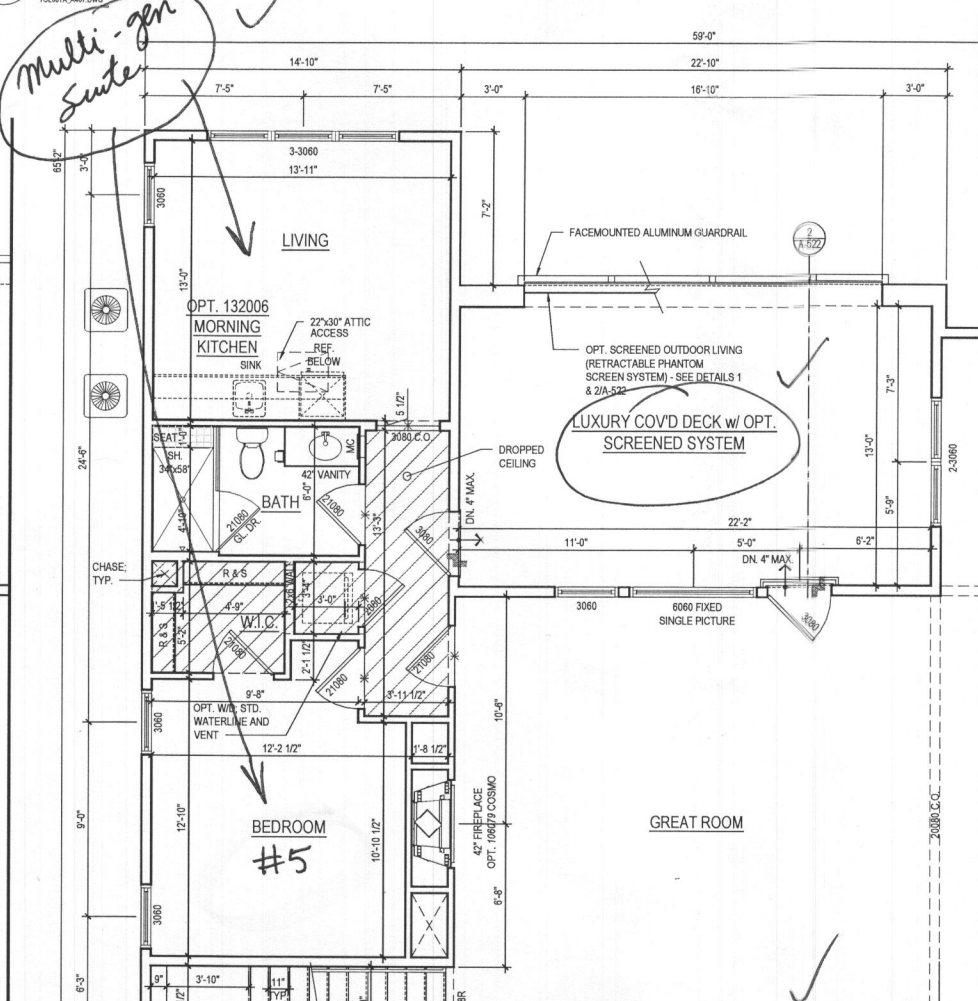

2 PART. FIRST FLOOR PLAN
A-407 SCALE: 1/4"=1'-0"

w/ OPT. 263073 MULTI-GEN. SUITE
w/ COVD OUTDOOR LIVING @ WALKOUT CONDITION

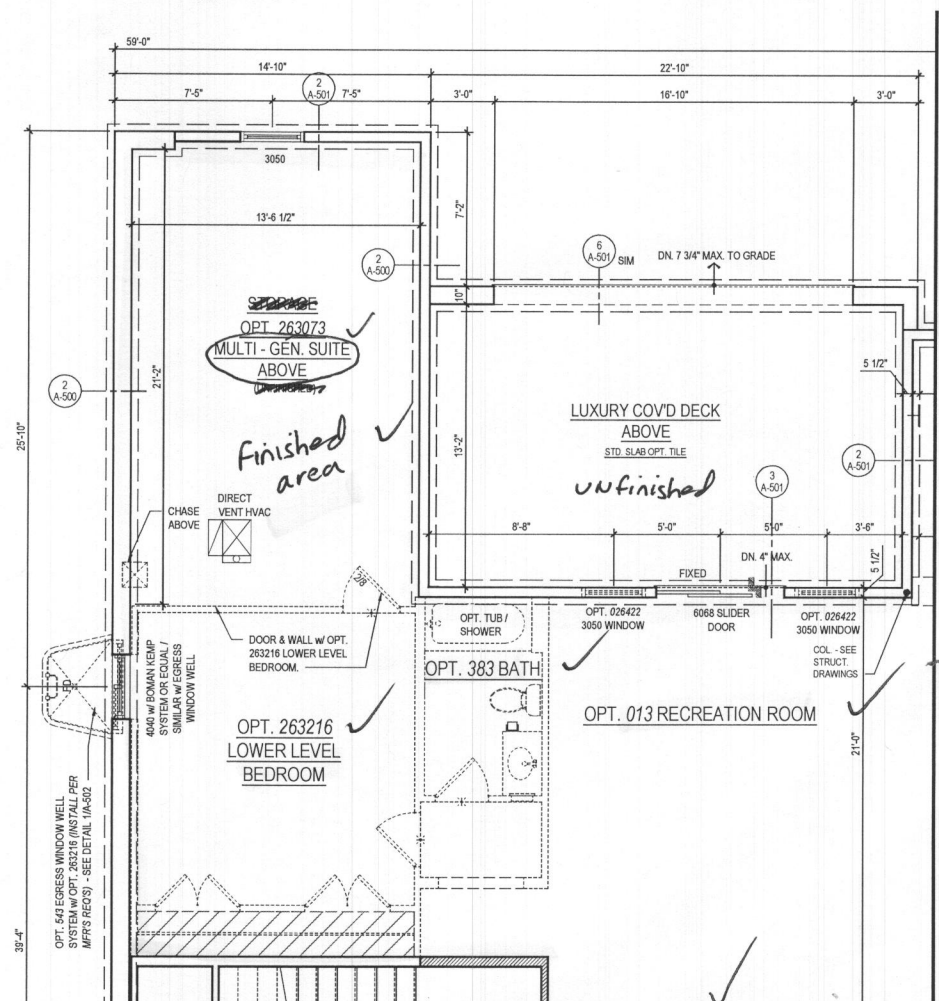

1 PART. BASEMENT PLAN
A-407 SCALE: 1/4"=1'-0"

w/ OPT. 263073 MULTI-GEN. SUITE
w/ COVD OUTDOOR LIVING @ WALKOUT CONDITION

ARCHITECT:

lessard
DESIGN

8521 Leesburg Pike
Suite 700 | Vienna, VA 22182
P: 571.830.1800 | F: 571.830.1801
www.lessarddesign.com

SEAL & SIGNATURE:

OWNER:

TOLL BROTHERS
19775 BELMONT EXECUTIVE PLAZA
ASHBURN, VA 20147
P: 571.291.8068
CONTACT: CHRISTINA LEMLEY
clemley@tollbrothers.com



PARKHURST
OPTIONS



PROJECT NAME:

SHEET TITLE:

ISSUE / REVISION		
NO.	DESCRIPTION	DATE
1	BID SET	05.29.19
2	PERMIT SET	06.19.19
3	MD NEW STANDARDS	09.16.19
4	MR #220241	12.11.20

PROJECT No: TOL081a
DRAWN BY: AC/RR
CHECKED BY: AP
PLOT DATE: Jan. 20, 2021
FILE NAME: TOL081a_A407.dwg


A-407

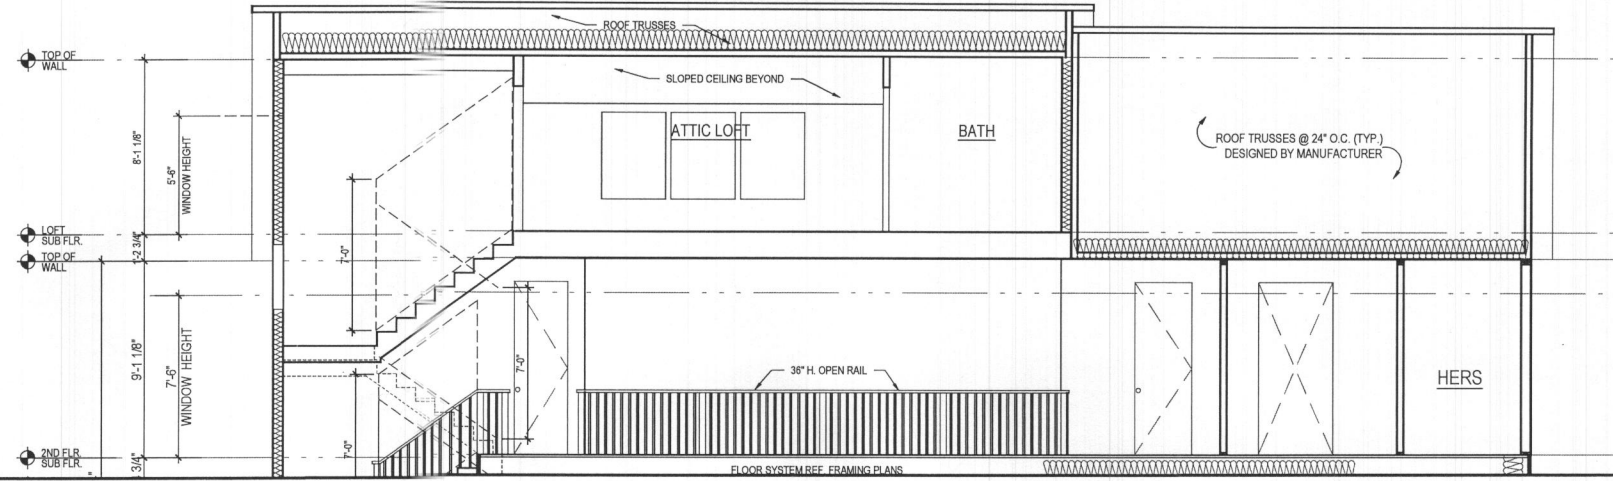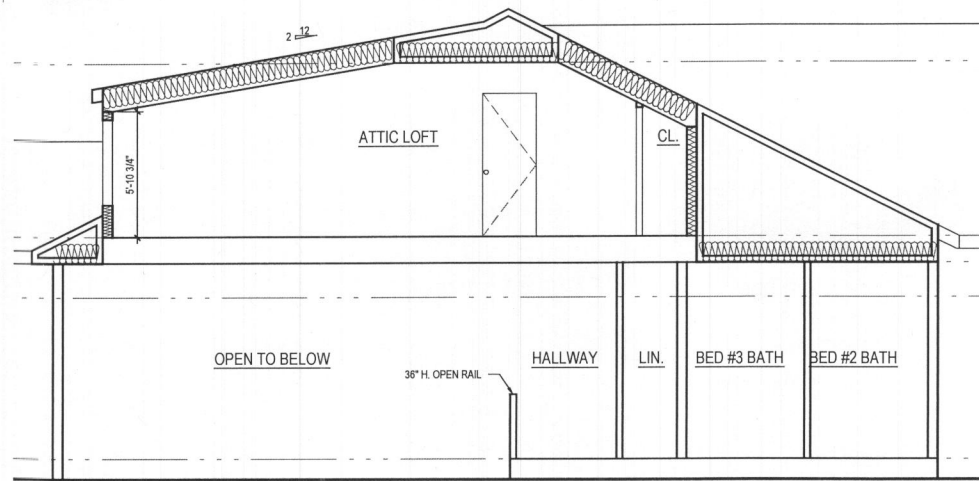

4 ATTIC SECTION w/ OPT. 539 : THIRD FLOOR WALK UP SPACE
 A-408 SCALE: 1/4"=1'-0"
 TOL081A.A408.dwg @ ELEV. 2 - MODERN FARMHOUSE, & ELEV. 5 - FAIRVIEW
 N/A W/ ELEV. #1, & #4


3 ATTIC SECTION w/ OPT. 539 : THIRD FLOOR WALK UP SPACE
 A-408 SCALE: 1/4"=1'-0"
 TOL081A.A408.dwg @ ELEV. 2 - MODERN FARMHOUSE, & ELEV. 5 - FAIRVIEW
 N/A W/ ELEV. #1, & #4

- GENERAL PLAN NOTES**
- A. ALL WOOD STUD PARTITIONS NOT DIMENSIONED ARE TO BE 3 1/2" FOR INTERIOR AND 5 1/2" FOR EXTERIOR WALLS UNLESS OTHERWISE NOTED.
 - B. ALL INTERIOR DIMENSIONS ARE TO FACE OF STUDS.
 - C. ALL EXTERIOR DIMENSIONS ARE TO FACE OF STUDS.
 - D. ALL DIMENSIONS GOVERN OVER SCALE.
 - E. ALL SMOKE DETECTORS ARE TO BE WIRED IN SUCH A MANNER THAT ACTIVATION OF ONE WILL ACTIVATE THEM ALL.
 - F. ENCLOSED ACCESSIBLE SPACE UNDER STAIRS SHALL HAVE WALLS AND SOFFITS PROTECTED ON ENCLOSED SIDE WITH 1/2" GYPSUM BOARD.
 - G. ALL WINDOWS SIZE ARE NOTED IN FEET + INCHES AS MEASURED FROM SASH TO SASH.
 - H. REFER TO ELEVATIONS FOR WINDOW HEAD HEIGHTS.
 - I. ALL DOORS ARE TO BE 6'-8" HIGH UNLESS OTHERWISE NOTED.
 - J. WASHER ALWAYS TO BE ON LEFT SIDE OF DRYER.
 - K. DISHWASHER ALWAYS TO BE ON RIGHT SIDE OF SINK.

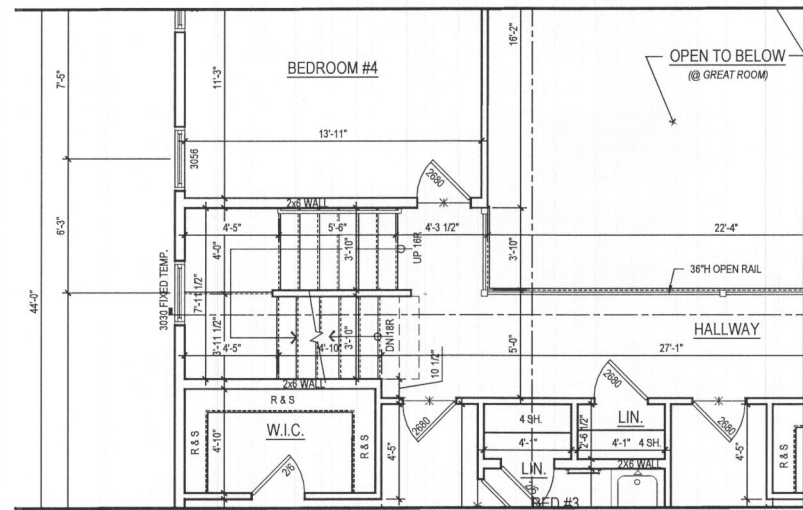

2 PART. SECOND FLOOR PLAN w/ OPT. 539 : THIRD FLOOR WALK UP SPACE
 A-408 SCALE: 1/4"=1'-0"
 TOL081A.A408.dwg @ ELEV. 2 - MODERN FARMHOUSE, & ELEV. 5 - FAIRVIEW
 N/A W/ ELEV. #1, & #4

USABLE SPACE	SQ. FT.
ATTIC LOFT AREA	545.70 SQ. FT.
50% AREA	272.85 SQ. FT.
AREA WITH 7' CEILING	342.30 SQ. FT.

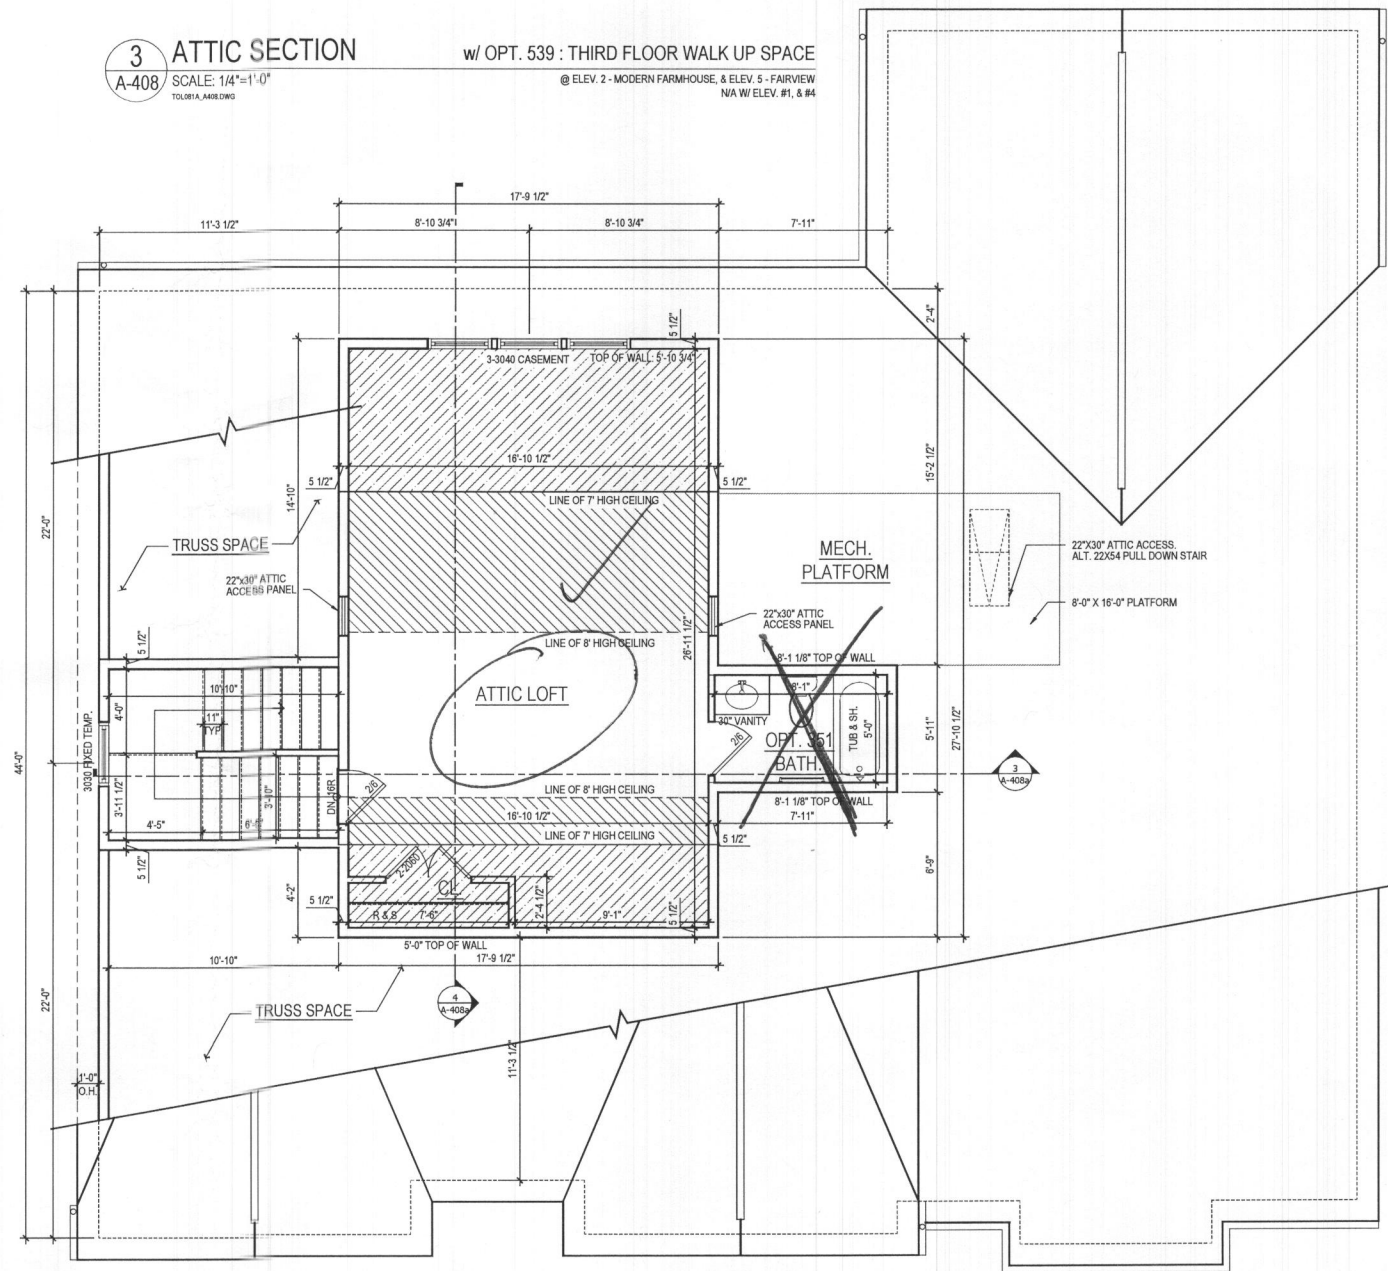

1 ATTIC FLOOR PLAN w/ OPT. 539 : THIRD FLOOR WALK UP SPACE
 A-408 SCALE: 1/4"=1'-0"
 TOL081A.A408.dwg @ ELEV. 2 - MODERN FARMHOUSE, & ELEV. 5 - FAIRVIEW
 N/A W/ ELEV. #1, & #4

ARCHITECT:

lessard
DESIGN

8521 Leesburg Pike
 Suite 700 | Vienna, VA 22182
 P: 571.830.1800 | F: 571.830.1801
 www.lessarddesign.com

SEAL & SIGNATURE:

OWNER:

TOLL BROTHERS
 19775 BELMONT EXECUTIVE PLAZA
 ASHBURN, VA 20147
 P: 571.291.8068
 CONTACT: CHRISTINA LEMLEY
 clemley@tollbrothers.com

PROJECT NAME:

MARYLAND

PARKHURST

OPT. 539 : 3RD FLOOR WALK UP SPACE

SHEET TITLE:

ISSUE / REVISION		
NO.	DESCRIPTION	DATE
BID SET		05.29.19
PERMIT SET		06.19.19
1	MD NEW STANDARDS	09.16.19
2	MR #220241	12.11.20


PROJECT No: TOL081A
 DRAWN BY: ACRA
 CHECKED BY: AP
 PLOT DATE: Jan. 20, 2021
 FILE NAME: TOL081A.A408.dwg

A-408

GENERAL PLAN NOTES

- ALL WOOD STUD PARTITIONS NOT DIMENSIONED ARE TO BE 3 1/2" FOR INTERIOR AND 5 1/2" FOR EXTERIOR WALLS UNLESS OTHERWISE NOTED.
- ALL INTERIOR DIMENSIONS ARE TO FACE OF STUDS.
- ALL EXTERIOR DIMENSIONS ARE TO FACE OF STUDS.
- ALL DIMENSIONS GOVERN OVER SCALE.
- ALL SMOKE DETECTORS ARE TO BE WIRED IN SUCH A MANNER THAT ACTIVATION OF ONE WILL ACTIVATE THEM ALL.
- ENCLOSED ACCESSIBLE SPACE UNDER STAIRS SHALL HAVE WALLS AND SOFFITS PROTECTED ON ENCLOSED SIDE WITH 1/2" GYPSUM BOARD.
- ALL WINDOWS SIZE ARE NOTED IN FEET + INCHES AS MEASURED FROM SASH TO SASH.
- REFER TO ELEVATIONS FOR WINDOW HEAD HEIGHTS.
- ALL DOORS ARE TO BE 6'-8" HIGH UNLESS OTHERWISE NOTED.
- WASHER ALWAYS TO BE ON LEFT SIDE OF DRYER.
- DISHWASHER ALWAYS TO BE ON RIGHT SIDE OF SINK.

Health Dept
10517 Pidding Lane
lot 32
Kings Forest

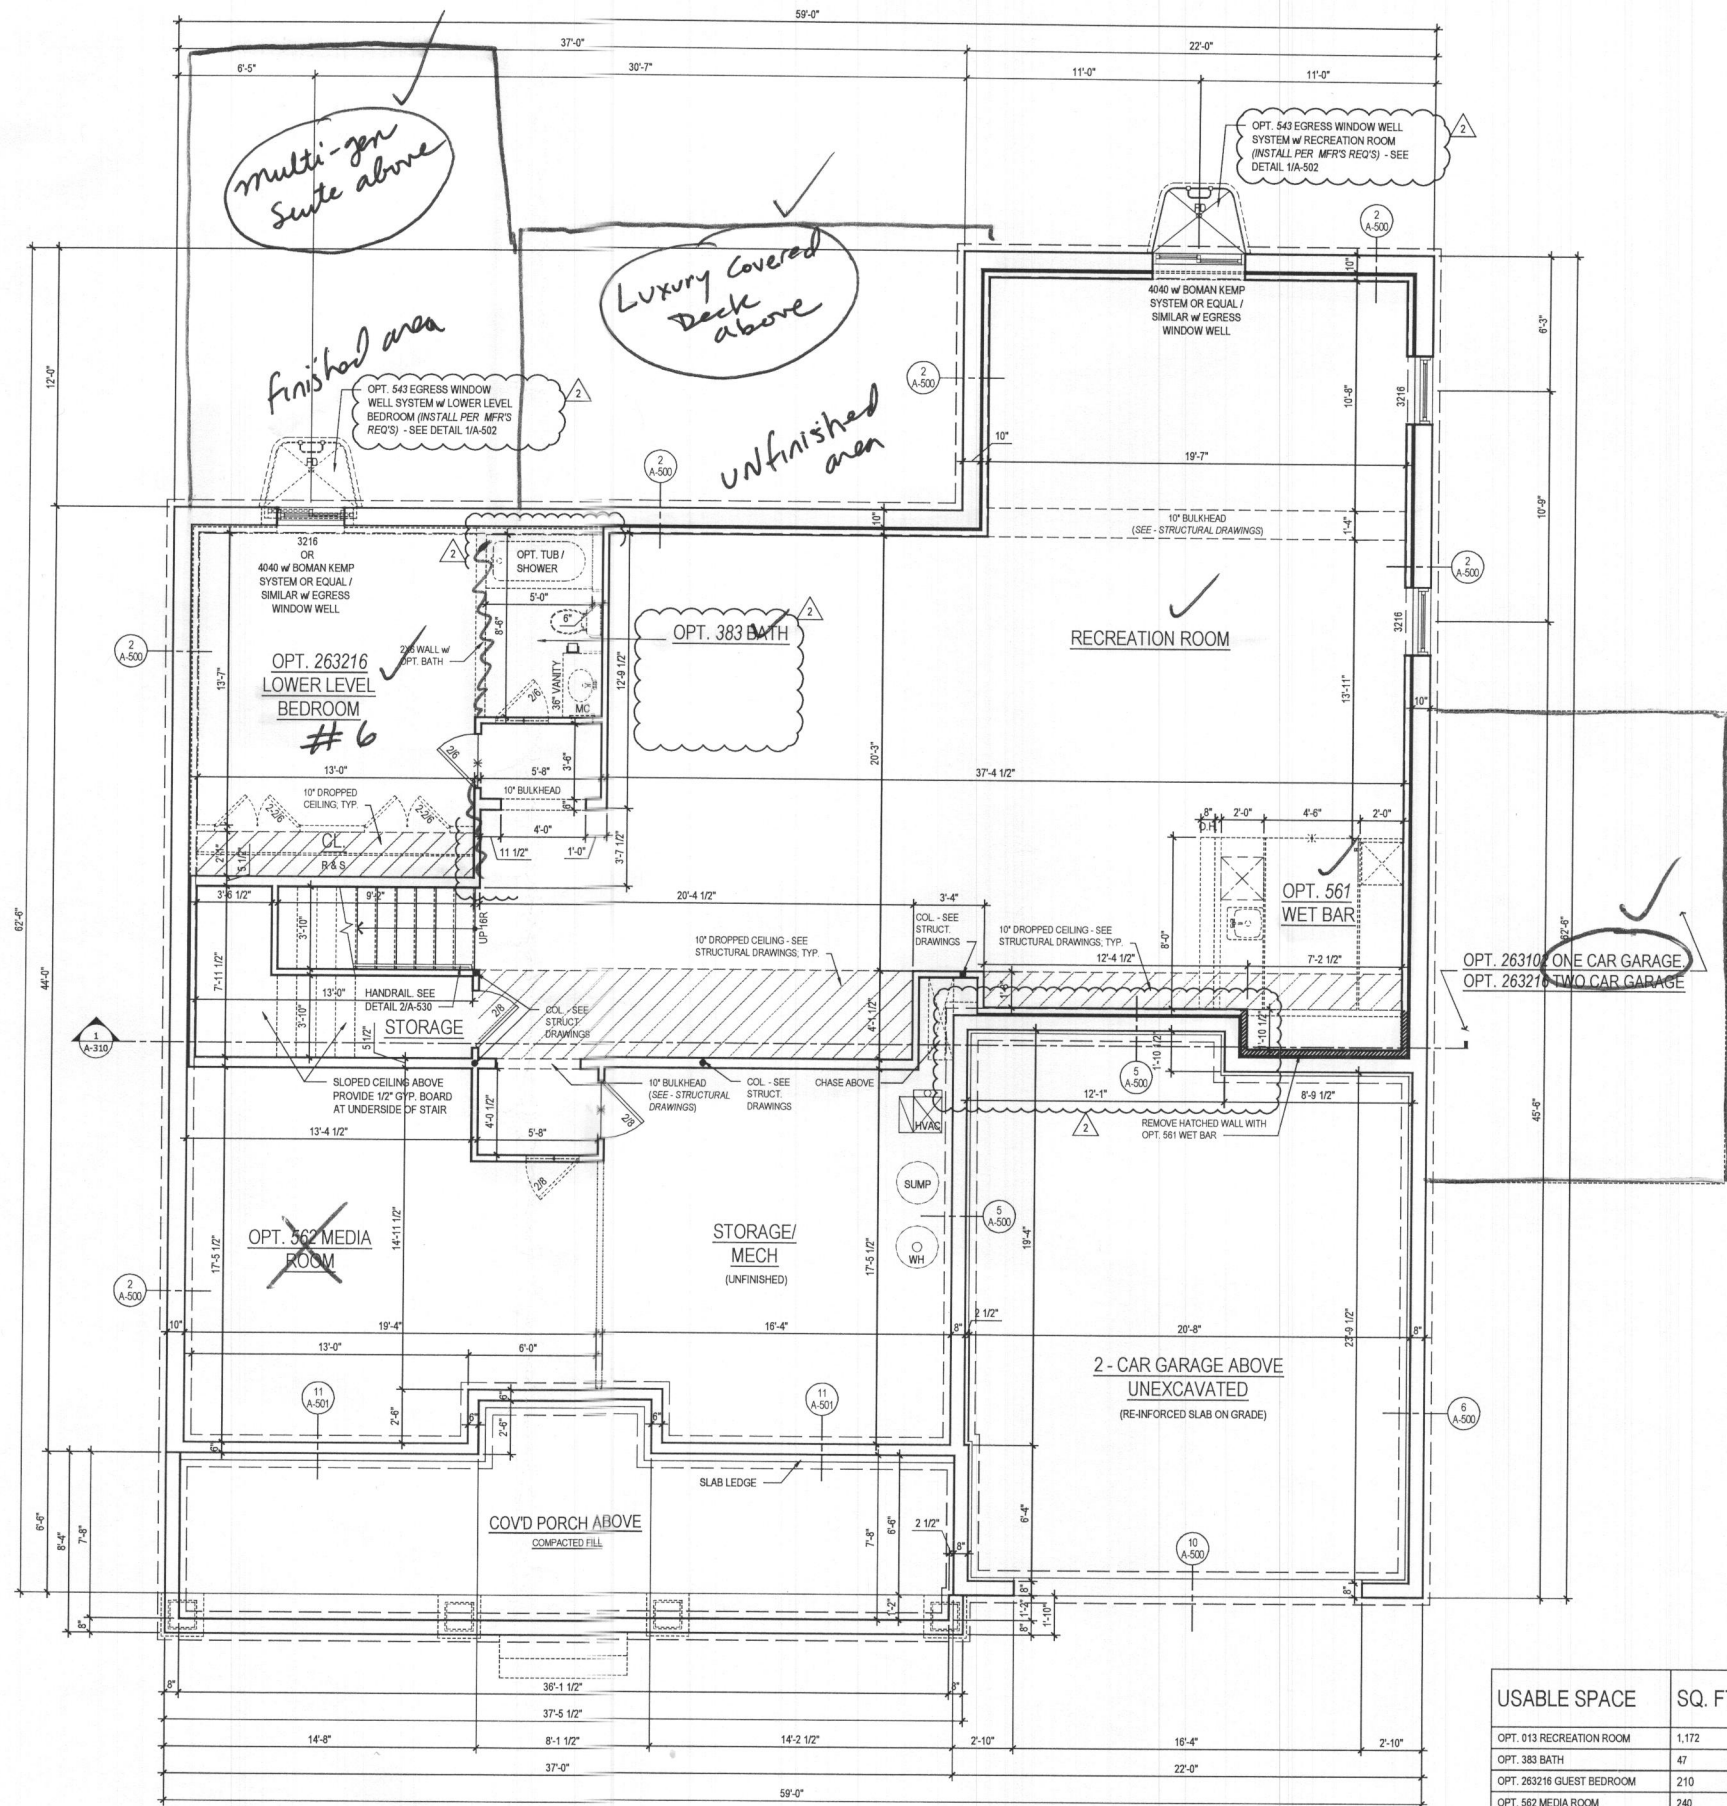

1 BASEMENT FLOOR PLAN
A-100a SCALE: 1/4"=1'-0"
TOL081a_A100.dwg

W/ OPT 013 RECREATION ROOM @ ELEV. 1 - CRAFTSMAN
@ FINISHED CONDITION

USABLE SPACE	SQ. FT.
OPT. 013 RECREATION ROOM	1,172
OPT. 383 BATH	47
OPT. 263216 GUEST BEDROOM	210
OPT. 562 MEDIA ROOM	240
TOTAL	1,669

ARCHITECT:
lessard DESIGN
8521 Leesburg Pike
Suite 700 | Vienna, VA 22182
P: 571.830.1800 | F: 571.830.1801
www.lessarddesign.com

SEAL & SIGNATURE:

OWNER:

TOLL BROTHERS
19775 BELMONT EXECUTIVE PLAZA
ASHBURN, VA 20147
P: 571.291.8068
CONTACT: CHRISTINA LEMLEY
clemley@tollbrothers.com

PROJECT NAME:
PARKHURST FLOOR PLANS

MARYLAND

PARKHURST FLOOR PLANS

PROJECT NAME:

SHEET TITLE:

NO.	DESCRIPTION	DATE
1	BID SET	05.29.19
2	PERMIT SET	06.18.19
3	MD NEW STANDARDS	09.16.19
4	MR #220241	12.11.20

PROJECT No: TOL081a
DRAWN BY: AC/RN
CHECKED BY: AP
PLOT DATE: Jan. 20, 2021
FILE NAME: TOL081a_A100.dwg

A-100a

B22000742

HEALTH