

MARYLAND DEPARTMENT OF THE ENVIRONMENT, WATER MANAGEMENT ADMINISTRATION
1800 Washington Blvd., Baltimore, Maryland 21230 (410) 537-3784

WATER WELL ABANDONMENT-SEALING REPORT FORM

SUBMIT COPIES OF COMPLETED FORM TO:

- * COUNTY ENVIRONMENTAL AGENCY (contact MDE, WMA if address needed)
- * WELL OWNER
- * MDE, WATER MANAGEMENT ADMINISTRATION, WELL PROGRAM

OK
3/21/19 SC

DATE WELL ABANDONED: 3-8-19 (month/day/year)

* PERMIT NUMBER OF ABANDONED WELL (if any) _____


* PERMIT NUMBER OF REPLACEMENT WELL: _____

* PERSON ABANDONING WELL: Maurice Dixon WELL DRILLER'S LICENSE NUMBER: 0666

CIRCLE: MWD / MSD / MGB

* OWNER'S NAME: Dennis Liu

SITE LOCATION MAP

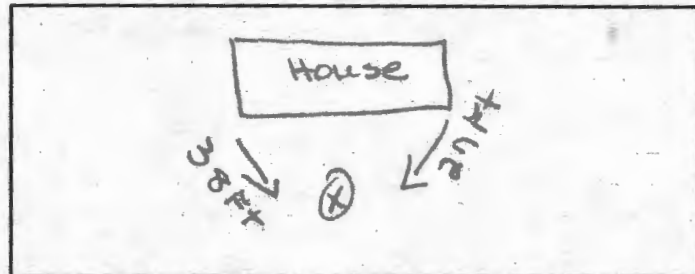

* WELL LOCATION:
COUNTY: Howard
NEAREST TOWN: Laurel
TAX MAP _____ BLOCK _____ PARCEL _____
SUBDIVISION: _____
SECTION: _____ LOT: _____
STREET ADDRESS: 10674 Scaggsville Rd

LATITUDE 39.13807 N

LONGITUDE 76.88235 W

LOG OF SEALING MATERIAL

MATERIAL	FEET	
	FROM	TO
Stone	40	5
Concrete	5	0

VOLUME OF MATERIAL USED

1/2 ton stone 38 Bags Concrete

* TYPE OF WELL BEING ABANDONED:

_____DRILLED _____JETTED
_____BORED _____X HAND DUG
_____OTHER (specify) _____

USE CODE:

X DOMESTIC _____MUNICIPAL/PUBLIC
_____IRRIGATION _____INDUSTRIAL
_____TEST/OBSERVATION _____GEO THERMAL

* TYPE OF CASING:

_____STEEL _____PLASTIC
X CONCRETE _____OTHER (specify) _____

SIZE OF CASING: 3 ft INCHES IN DIAMETER

DEPTH OF WELL: 40 FEET DEEP

WAS ANY CASING REMOVED? X YES _____ NO

If yes, length removed, in feet: 1

WAS CASING RIPPED OR PERFORATED? _____ YES X NO

SIGNATURE-MASTER WELL DRILLER OR SUPERVISING SANITARIAN, LICENSE# 0666

MWD / MSD / MGS

CIRCLE ONE

DATE 3-8-19

SURVEY

38 yds per Brian Smith at Carroll Water Pursuant to § 10-624 of the State Govt. Article of the Maryland Code, personal info requested on this form is used in processing this form pursuant to COMAR 26.04.04. Failure to provide the info may result in this form not being processed. You have the right to inspect, amend, or correct this form. The Maryland Department of the Environment is subject to the Maryland Public Information Act. This form may be made available on the Internet via MDE's website and is subject to inspection or copying, in whole or in part, by the public and other governmental agencies, if not protected by federal or State Law.

SITE INSPECTION SHEET

OWNER: _____ PHONE #: _____


ADDRESS: 10674 Scaggsville Rd CONTRACTOR: _____

WELL TAG #: _____

SUBDIVISION: _____ LOT: _____ COUNTY #: _____

PROPOSAL: carport converted to living space w/permit (N.O.V.)
confirm well & location

LOCATION DIAGRAM

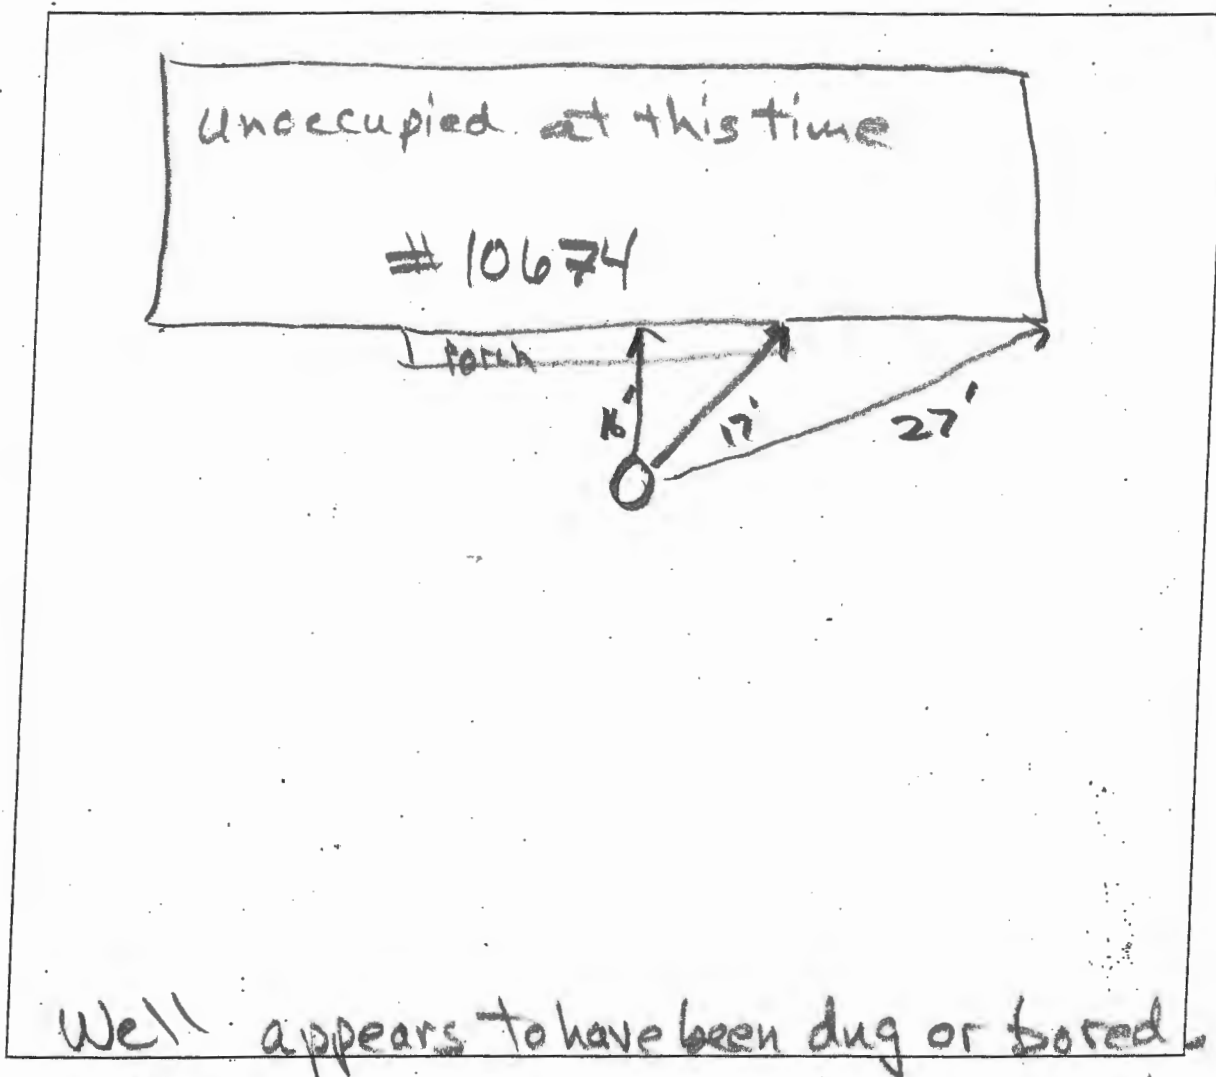

COMMENTS: Well has concrete riser extending 2.5' above grade
concrete/kongkrete cover (~3.5' dia); Well is ~3ft dia,
25' to water level, total depth undetermined.

A 4" sewer cleanout is observed to back-left of house

DATE: 6/18/2015

INSPECTOR: R. Bricker