

B21003351


10536 Pudding Lane
LOT 23

Health Dept
Revision to remove
Basement Bedroom and closet
add flex space

TOTAL Bedrooms = 5

GENERAL PLAN NOTES

- ALL WOOD STUD PARTITIONS NOT DIMENSIONED ARE TO BE 3 1/2" FOR INTERIOR AND 5 1/2" FOR EXTERIOR WALLS UNLESS OTHERWISE NOTED.
- ALL INTERIOR DIMENSIONS ARE TO FACE OF STUDS.
- ALL EXTERIOR DIMENSIONS ARE TO FACE OF STUDS.
- ALL DIMENSIONS GOVERN OVER SCALE.
- ALL SMOKE DETECTORS ARE TO BE WIRED IN SUCH A MANNER THAT ACTIVATION OF ONE WILL ACTIVATE THEM ALL.
- ENCLOSED ACCESSIBLE SPACE UNDER STAIRS SHALL HAVE WALLS AND SOFFITS PROTECTED ON ENCLOSED SIDE WITH 1/2" GYPSUM BOARD.
- ALL WINDOWS SIZE ARE NOTED IN FEET + INCHES AS MEASURED FROM SASH TO SASH.
- REFER TO ELEVATIONS FOR WINDOW HEAD HEIGHTS.
- ALL DOORS ARE TO BE 6'-8" HIGH UNLESS OTHERWISE NOTED.
- WASHER ALWAYS TO BE ON LEFT SIDE OF DRYER.
- DISHWASHER ALWAYS TO BE ON RIGHT SIDE OF SINK.

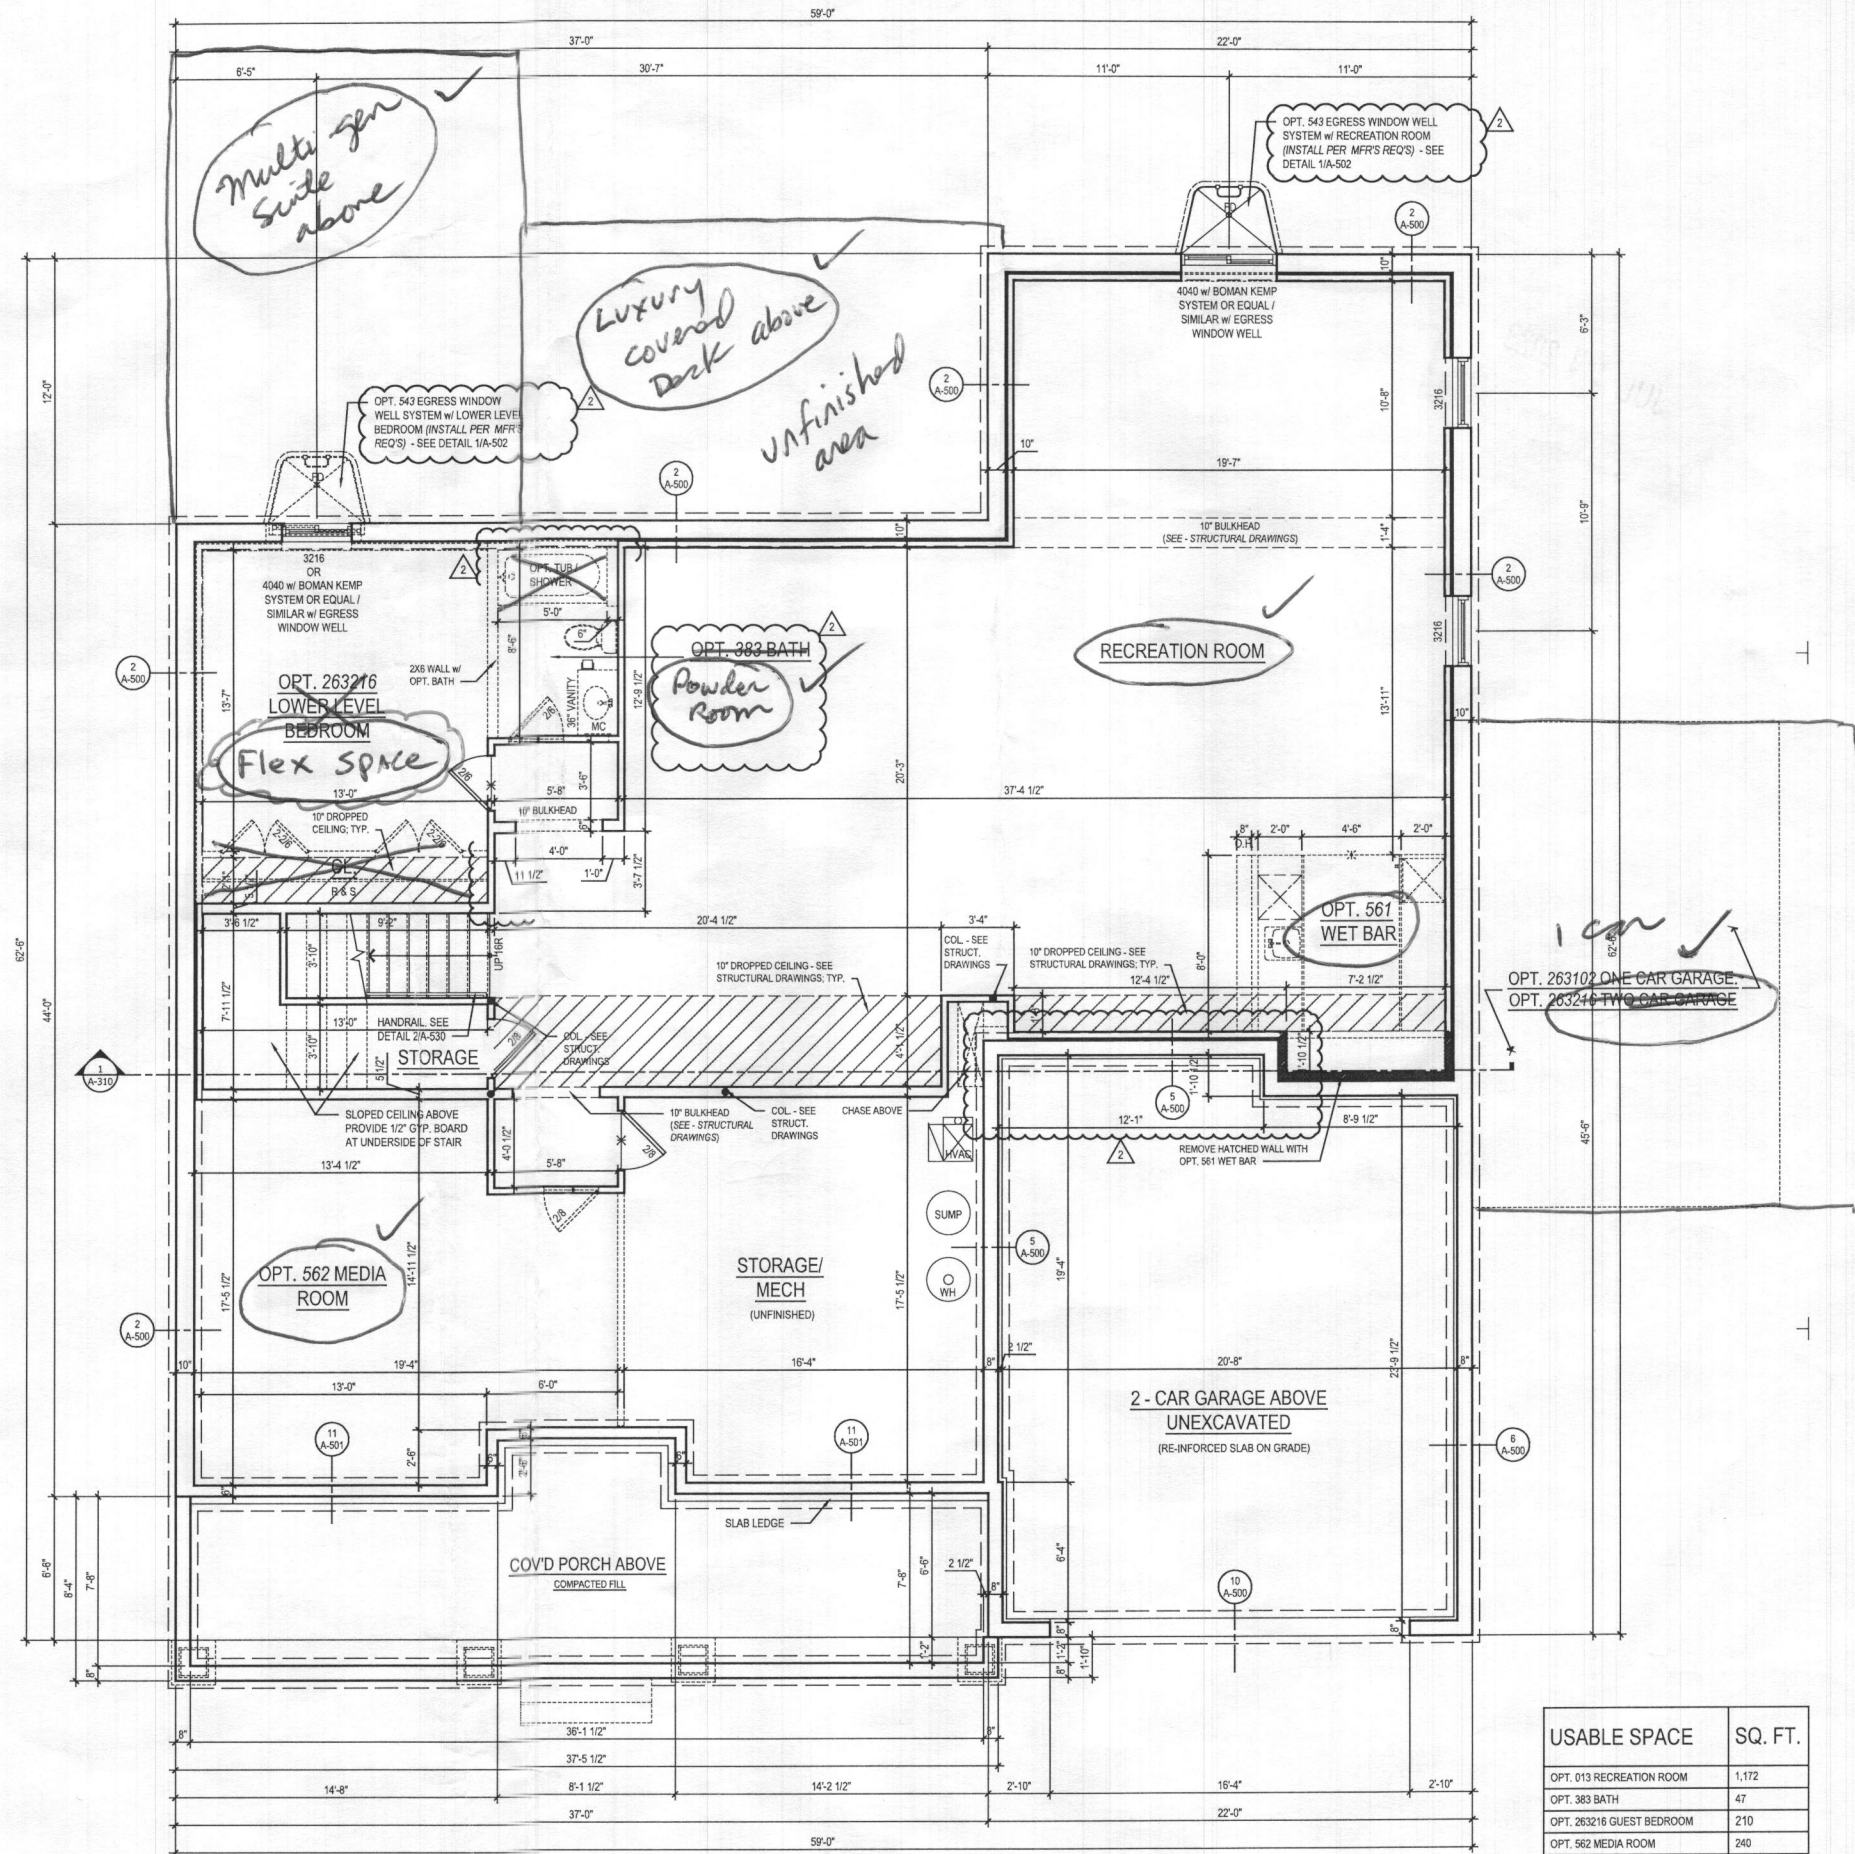

1 BASEMENT FLOOR PLAN
A-100a SCALE: 1/4"=1'-0"
TOL081a_A100.dwg

W/ OPT 013 RECREATION ROOM @ ELEV. 1 - ~~CRACKED~~
See "modern farmhouse" elev. @ FINISHED CONDITION

USABLE SPACE	SQ. FT.
OPT. 013 RECREATION ROOM	1,172
OPT. 383 BATH	47
OPT. 263216 GUEST BEDROOM	210
OPT. 562 MEDIA ROOM	240
TOTAL	1,669

ARCHITECT:
lessard
DESIGN

8521 Leesburg Pike
Suite 700 | Vienna, VA 22182
P: 571.830.1800 | F: 571.830.1801
www.lessarddesign.com

SEAL & SIGNATURE:

OWNER:

TOLL BROTHERS
19775 BELMONT EXECUTIVE PLAZA
ASHBURN, VA 20147
P: 571.291.8068
CONTACT: CHRISTINA LEMLEY
clemley@tollbrothers.com

EXCLUSIVE SERIES
MARYLAND

PARKHURST
FLOOR PLANS

PROJECT NAME:

SHEET TITLE:

ISSUE / REVISION


NO.	DESCRIPTION	DATE
BID SET		05.29.19
PERMIT SET		06.19.19
1	MD NEW STANDARDS	09.16.19
2	MR #220241	12.11.20

PROJECT No: TOL081a
DRAWN BY: AC/RN
CHECKED BY: AP
PLOT DATE: Jan. 20, 2021
FILE NAME: TOL081a_A100.dwg

A-100a


GENERAL PLAN NOTES

- ALL WOOD STUD PARTITIONS NOT DIMENSIONED ARE TO BE 3 1/2" FOR INTERIOR AND 5 1/2" FOR EXTERIOR WALLS UNLESS OTHERWISE NOTED.
- ALL INTERIOR DIMENSIONS ARE TO FACE OF STUDS.
- ALL EXTERIOR DIMENSIONS ARE TO FACE OF STUDS.
- ALL DIMENSIONS GOVERN OVER SCALE.
- ALL SMOKE DETECTORS ARE TO BE WIRED IN SUCH A MANNER THAT ACTIVATION OF ONE WILL ACTIVATE THEM ALL.
- ENCLOSED ACCESSIBLE SPACE UNDER STAIRS SHALL HAVE WALLS AND SOFFITS PROTECTED ON ENCLOSED SIDE WITH 1/2" GYPSUM BOARD.
- ALL WINDOWS SIZE ARE NOTED IN FEET + INCHES AS MEASURED FROM SASH TO SASH.
- REFER TO ELEVATIONS FOR WINDOW HEAD HEIGHTS.
- ALL DOORS ARE TO BE 6'-8" HIGH UNLESS OTHERWISE NOTED.
- WASHER ALWAYS TO BE ON LEFT SIDE OF DRYER.
- DISHWASHER ALWAYS TO BE ON RIGHT SIDE OF SINK.

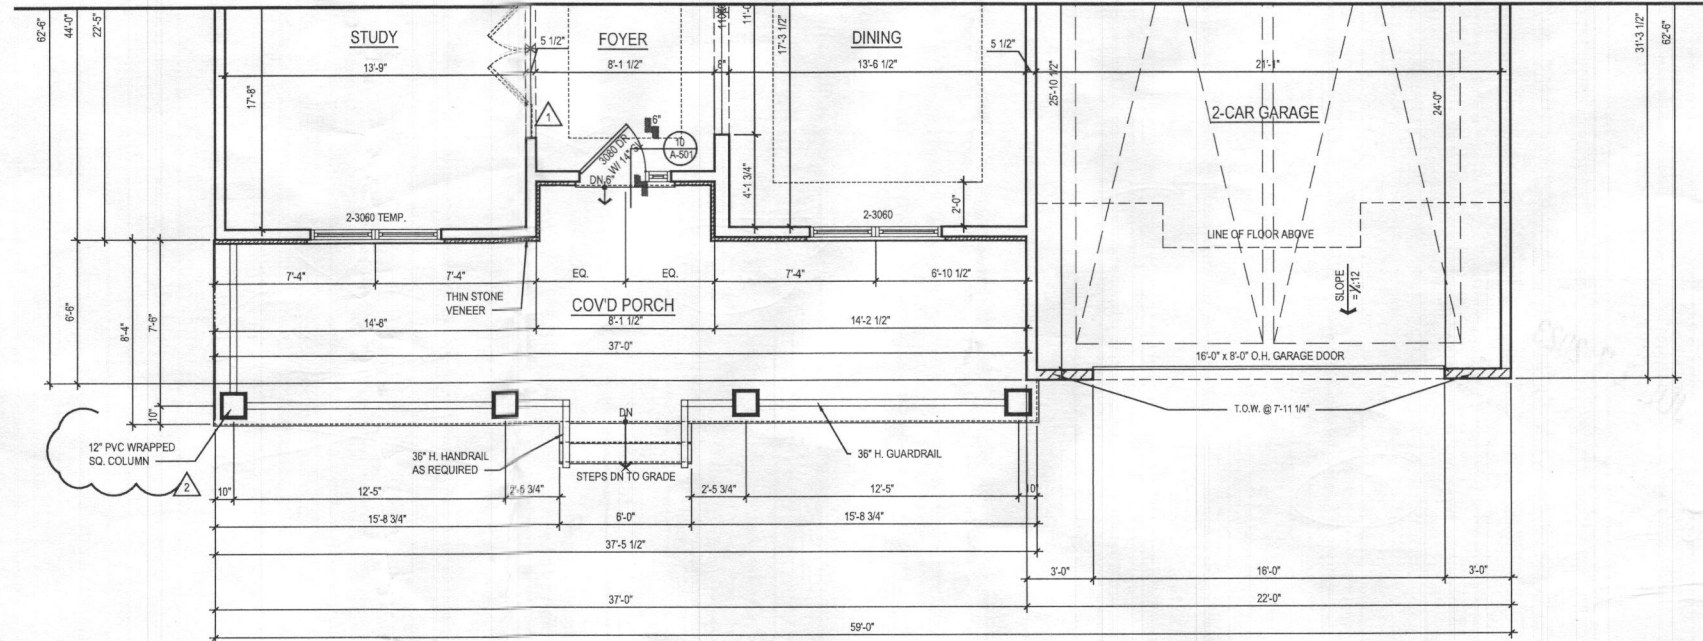


2 FIRST FLOOR PLAN
A-140 SCALE: 1/4"=1'-0"
TOL081a_A140.DWG

@ ELEV. 2 - MODERN FARMHOUSE

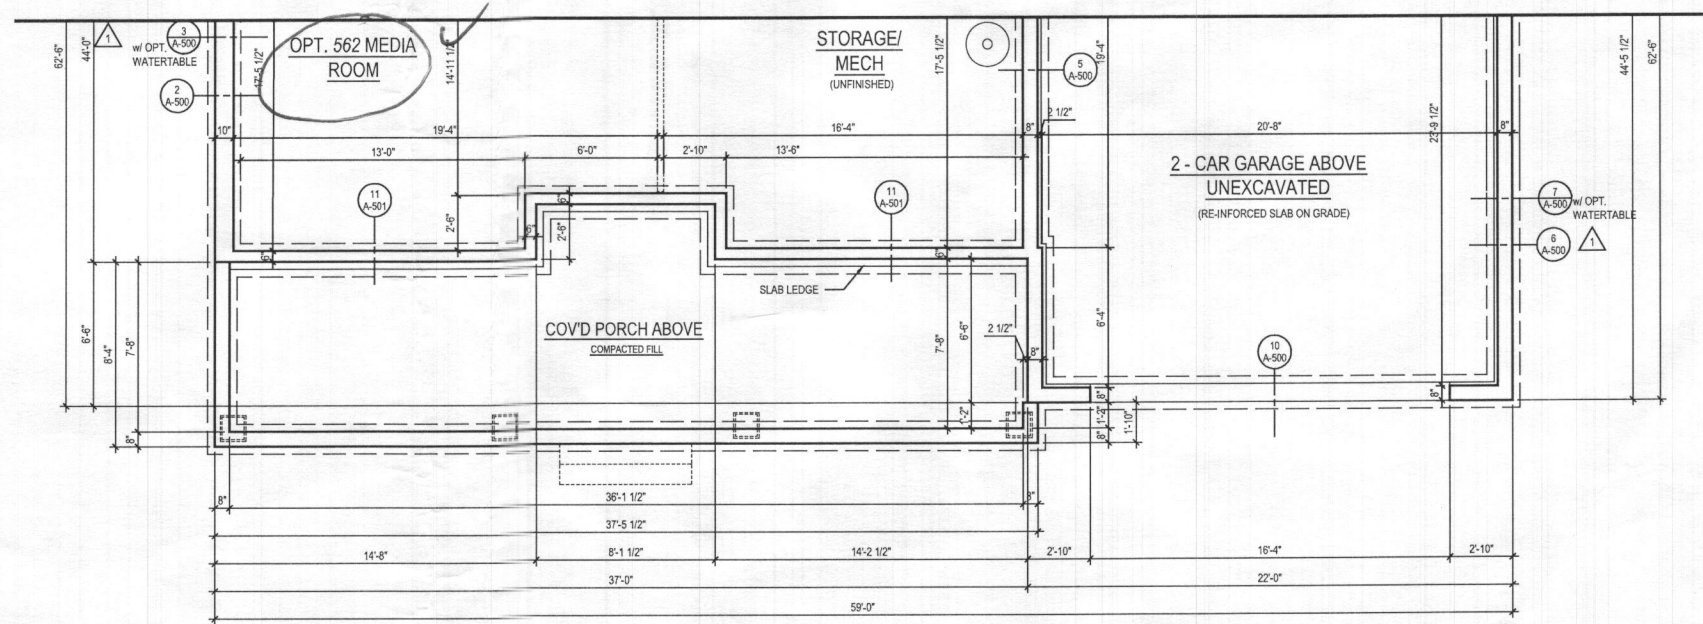

1 BASEMENT FLOOR PLAN
A-140 SCALE: 1/4"=1'-0"
TOL081a_A140.DWG

@ ELEV. 2 - MODERN FARMHOUSE

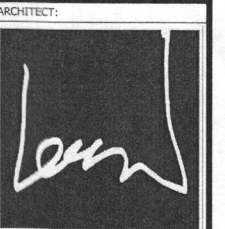

lessard
DESIGN

8521 Leesburg Pike
Suite 700 | Vienna, VA 22182
P: 571.830.1800 | F: 571.830.1801
www.lessarddesign.com

SEAL & SIGNATURE:

OWNER:

TOLL BROTHERS
19775 BELMONT EXECUTIVE PLAZA
ASHBURN, VA 20147
P: 571.291.8068
CONTACT: CHRISTINA LEMLEY
demley@tollbrothers.com

EXECUTIVE SERIES
MARYLAND

PARKHURST
FLOOR PLANS

PROJECT NAME:

SHEET TITLE:

ISSUE / REVISION		
NO.	DESCRIPTION	DATE
1	BID SET	05.29.19
2	PERMIT SET	06.19.19
3	MD NEW STANDARDS	09.16.19
4	MR #220241	12.11.20

PROJECT No: TOL081a
DRAWN BY: AC/RN
CHECKED BY: AP
PLOT DATE: Jan. 20, 2021
FILE NAME: TOL081a_A140.dwg

A-140