
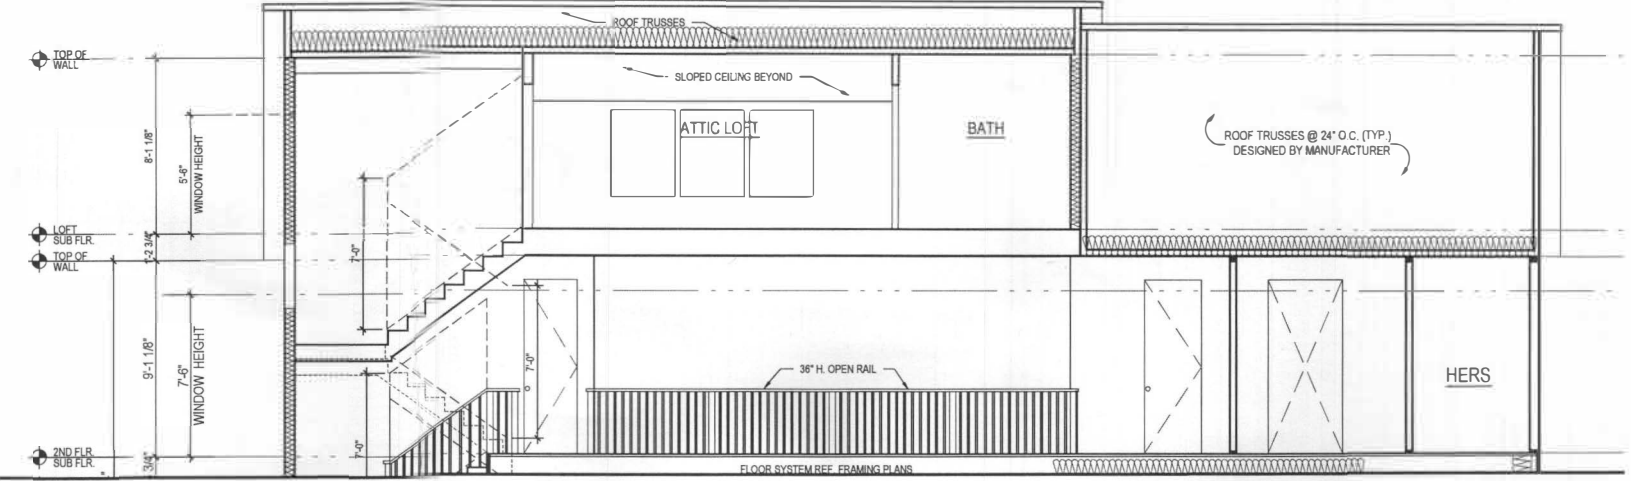


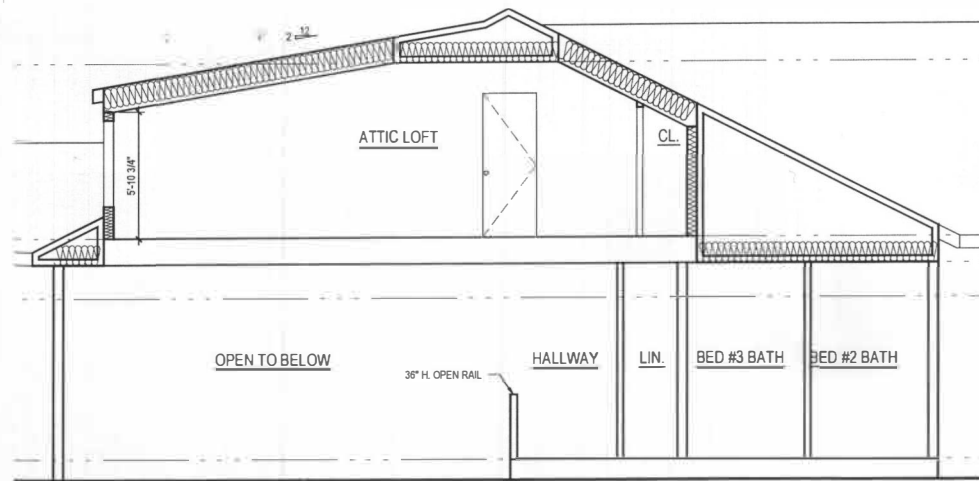


4 ATTIC SECTION w/ OPT. 539 : THIRD FLOOR WALK UP SPACE
 @ ELEV 2 - MODERN FARMHOUSE, & ELEV. 5 - FAIRVIEW
 N/A W/ ELEV. #1, & #4
 SCALE: 1/4"=1'-0"
 TOL081A_A408.dwg

3 ATTIC SECTION w/ OPT. 539 : THIRD FLOOR WALK UP SPACE
 @ ELEV 2 - MODERN FARMHOUSE, & ELEV. 5 - FAIRVIEW
 N/A W/ ELEV. #1, & #4
 SCALE: 1/4"=1'-0"
 TOL081A_A408.dwg


GENERAL PLAN NOTES

- ALL WOOD STUD PARTITIONS NOT DIMENSIONED ARE TO BE 3 1/2" FOR INTERIOR AND 5 1/2" FOR EXTERIOR WALLS UNLESS OTHERWISE NOTED.
- ALL INTERIOR DIMENSIONS ARE TO FACE OF STUDS.
- ALL EXTERIOR DIMENSIONS ARE TO FACE OF STUDS.
- ALL DIMENSIONS GOVERN OVER SCALE.
- ALL SMOKE DETECTORS ARE TO BE WIRED IN SUCH A MANNER THAT ACTIVATION OF ONE WILL ACTIVATE THEM ALL.
- ENCLOSED ACCESSIBLE SPACE UNDER STAIRS SHALL HAVE WALLS AND SOFFITS PROTECTED ON ENCLOSED SIDE WITH 1/2" GYPSUM BOARD.
- ALL WINDOWS SIZE ARE NOTED IN FEET + INCHES AS MEASURED FROM SASH TO SASH.
- REFER TO ELEVATIONS FOR WINDOW HEAD HEIGHTS.
- ALL DOORS ARE TO BE 6'-8" HIGH UNLESS OTHERWISE NOTED.
- WASHER ALWAYS TO BE ON LEFT SIDE OF DRYER.
- DISHWASHER ALWAYS TO BE ON RIGHT SIDE OF SINK.

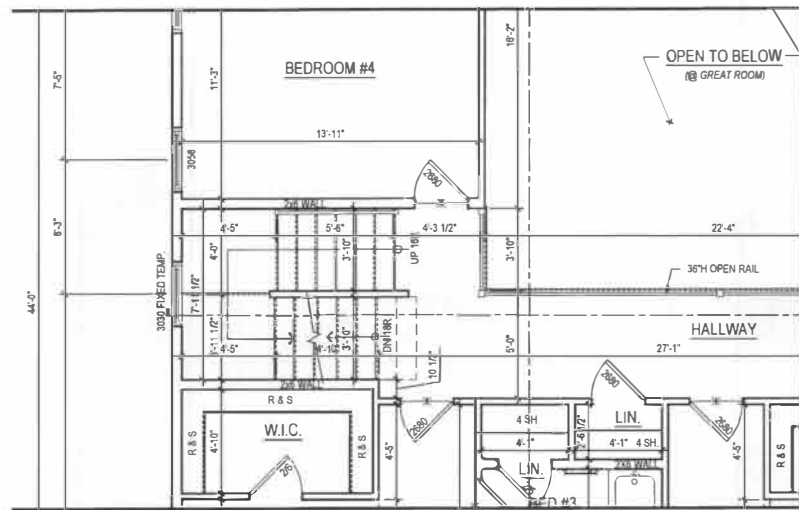

2 PART. SECOND FLOOR PLAN w/ OPT. 539 : THIRD FLOOR WALK UP SPACE
 @ ELEV 2 - MODERN FARMHOUSE, & ELEV. 5 - FAIRVIEW
 N/A W/ ELEV. #1, & #4
 SCALE: 1/4"=1'-0"
 TOL081A_A408.dwg

USABLE SPACE	SQ. FT.
ATTIC LOFT AREA	545.70 SQ. FT.
50% AREA	272.85 SQ. FT.
AREA WITH 7' CEILING	342.30 SQ. FT.

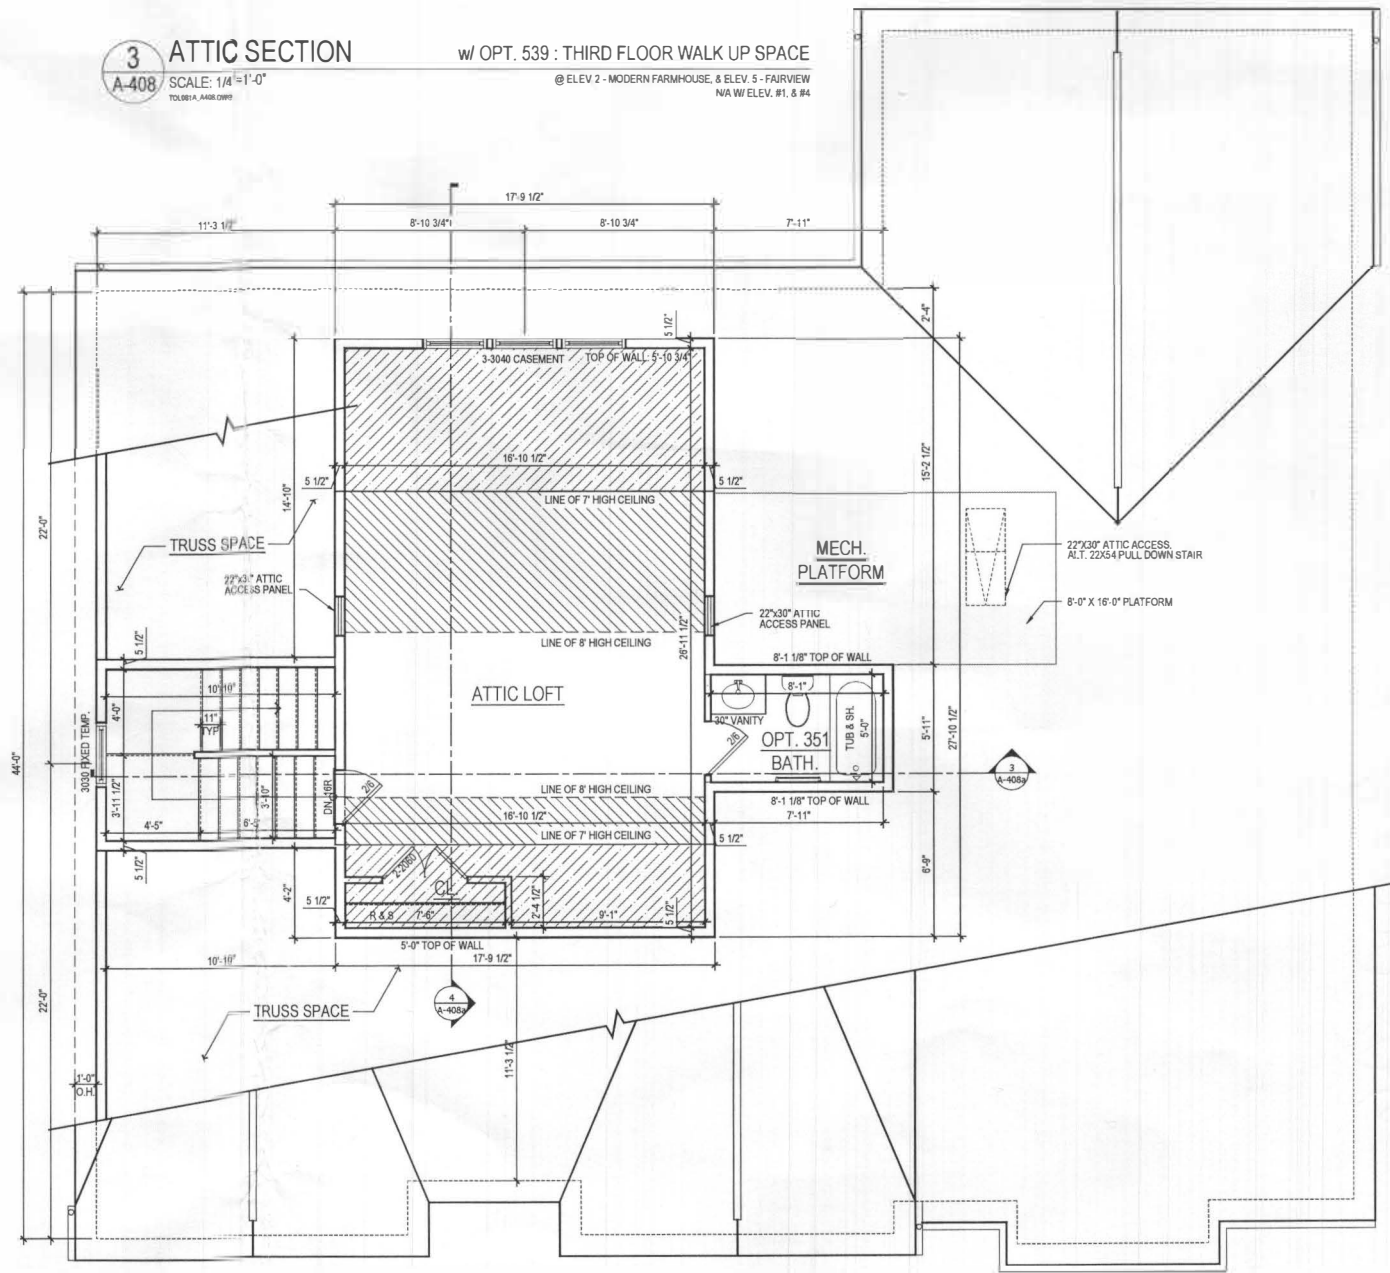

1 ATTIC FLOOR PLAN w/ OPT. 539 : THIRD FLOOR WALK UP SPACE
 @ ELEV 2 - MODERN FARMHOUSE, & ELEV. 5 - FAIRVIEW
 N/A W/ ELEV. #1, & #4
 SCALE: 1/4"=1'-0"
 TOL081A_A408.dwg

ARCHITECT:
lessard
 DESIGN
 8521 Leesburg Pike
 Suite 700 | Vienna, VA 22182
 P: 571.830.1800 | F: 571.830.1801
 www.lessarddesign.com

SEAL & SIGNATURE:

OWNER:

TOLL BROTHERS
 19775 BELMONT EXECUTIVE PLAZA
 ASHBURN, VA 20147
 P: 571.291.8068
 CONTACT: CHRISTINA LEMLEY
 clemley@tollbrothers.com

EXECUTIVE SERIES
 MARYLAND

PARKHURST

OPT. 539 : 3RD FLOOR WALK UP SPACE

PROJECT NAME:

SHEET TITLE:

NO.	DESCRIPTION	DATE
1	BID SET	05.29.19
2	PERMIT SET	06.19.19
3	MD NEW STANDARDS	09.16.19
4	MR #220241	12.11.20


PROJECT No: TOL081A
 DRAWN BY: AC/REN
 CHECKED BY: AP
 PLOT DATE: Jan. 20, 2021
 FILE NAME: TOL081A_A408.dwg

A-408

Health Dept

- GENERAL PLAN NOTES
- A. ALL WOOD STUD PARTITIONS NOT DIMENSIONED ARE TO BE 3 1/2" FOR INTERIOR AND 5 1/2" FOR EXTERIOR WALLS UNLESS OTHERWISE NOTED.
 - B. ALL INTERIOR DIMENSIONS ARE TO FACE OF STUDS.
 - C. ALL EXTERIOR DIMENSIONS ARE TO FACE OF STUDS.
 - D. ALL DIMENSIONS GOVERN OVER SCALE.
 - E. ALL SMOKE DETECTORS ARE TO BE WIRED IN SUCH A MANNER THAT ACTIVATION OF ONE WILL ACTIVATE THEM ALL.
 - F. ENCLOSED ACCESSIBLE SPACE UNDER STAIRS SHALL HAVE WALLS AND SOFFITS PROTECTED ON ENCLOSED SIDE WITH 1/2" GYPSUM BOARD.
 - G. ALL WINDOWS SIZE ARE NOTED IN FEET + INCHES AS MEASURED FROM SASH TO SASH.
 - H. REFER TO ELEVATIONS FOR WINDOW HEAD HEIGHTS.
 - I. ALL DOORS ARE TO BE 6'-8" HIGH UNLESS OTHERWISE NOTED.
 - J. WASHER ALWAYS TO BE ON LEFT SIDE OF DRYER.
 - K. DISHWASHER ALWAYS TO BE ON RIGHT SIDE OF SINK.

10521 Pudding Lane
lot 31
Kings Forest

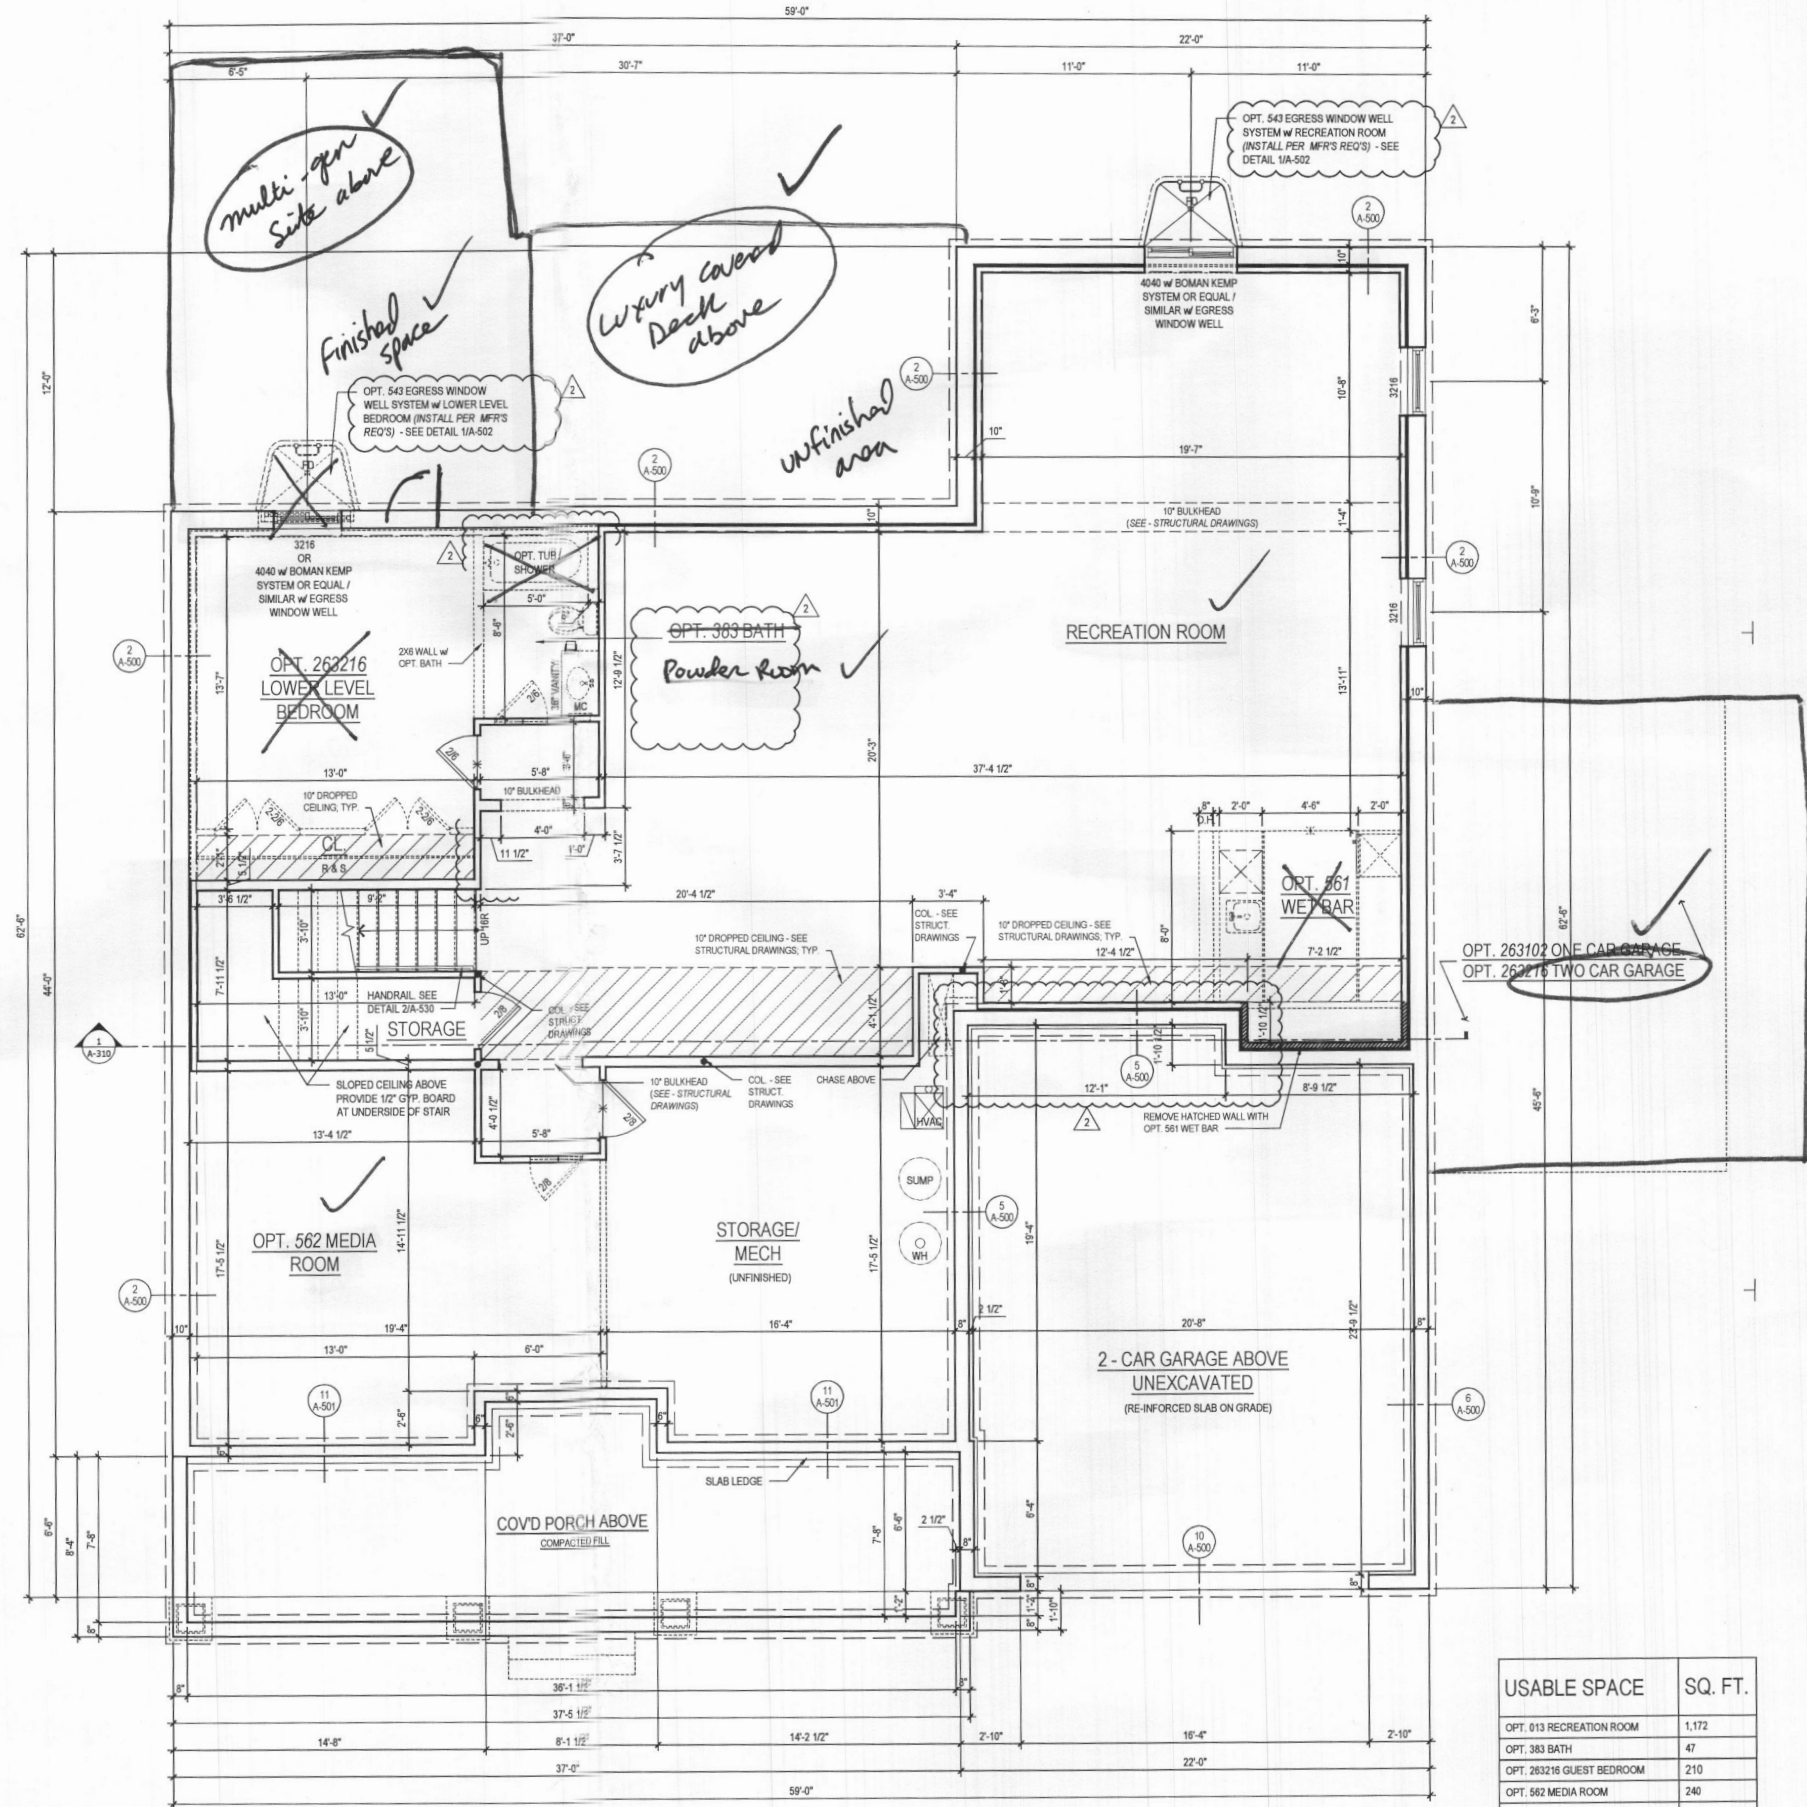

1 BASEMENT FLOOR PLAN
A-100a SCALE: 1/4"=1'-0"

W/ OPT 013 RECREATION ROOM @ ELEV. 1 - CRAFTSMAN
@ FINISHED CONDITION
See additional pages for "Modern farmhouse" etc.

USABLE SPACE	SQ. FT.
OPT. 013 RECREATION ROOM	1,172
OPT. 383 BATH	47
OPT. 263216 GUEST BEDROOM	210
OPT. 562 MEDIA ROOM	240
TOTAL	1,669

ARCHITECT:
lessard DESIGN
8521 Leesburg Pike
Suite 700 | Vienna, VA 22182
P: 571.830.1800 | F: 571.830.1801
www.lessarddesign.com

SEAL & SIGNATURE:

OWNER:
TOLL BROTHERS
19775 BELMONT EXECUTIVE PLAZA
ASHBURN, VA 20147
P: 571.291.8068
CONTACT: CHRISTINA LEMLEY
clemley@tollbrothers.com

PROJECT NAME:
PARKHURST FLOOR PLANS

SHEET TITLE:
MARYLAND

ISSUE / REVISION


NO.	DESCRIPTION	DATE
1	BID SET	06.29.19
2	PERMIT SET	06.19.19
3	MD NEW STANDARDS	09.16.19
4	MR #220241	12.11.20

PROJECT No: TOL081a
DRAWN BY: AC/RN
CHECKED BY: AP
PLOT DATE: Jan, 20, 2021
FILE NAME: TOL081a_A100.dwg


A-100a

GENERAL PLAN NOTES

- ALL WOOD STUD PARTITIONS NOT DIMENSIONED ARE TO BE 3 1/2" FOR INTERIOR AND 5 1/2" FOR EXTERIOR WALLS UNLESS OTHERWISE NOTED.
- ALL INTERIOR DIMENSIONS ARE TO FACE OF STUDS.
- ALL EXTERIOR DIMENSIONS ARE TO FACE OF STUDS.
- ALL DIMENSIONS GOVERN OVER SCALE.
- ALL SMOKE DETECTORS ARE TO BE WIRED IN SUCH A MANNER THAT ACTIVATION OF ONE WILL ACTIVATE THEM ALL.
- ENCLOSED ACCESSIBLE SPACE UNDER STAIRS SHALL HAVE WALLS AND SOFFITS PROTECTED ON ENCLOSED SIDE WITH 1/2" GYPSUM BOARD.
- ALL WINDOWS SIZE ARE NOTED IN FEET + INCHES AS MEASURED FROM SASH TO SASH.
- REFER TO ELEVATIONS FOR WINDOW HEAD HEIGHTS.
- ALL DOORS ARE TO BE 6'-8" HIGH UNLESS OTHERWISE NOTED.
- WASHER ALWAYS TO BE ON LEFT SIDE OF DRYER.
- DISHWASHER ALWAYS TO BE ON RIGHT SIDE OF SINK.

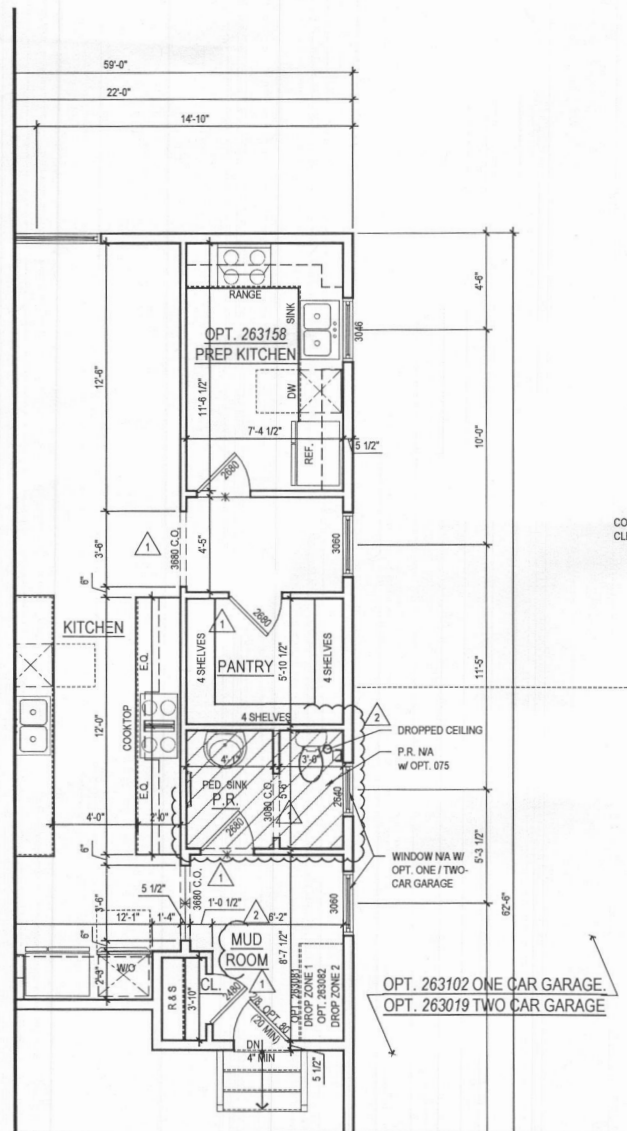

2 PART. FIRST FLOOR PLAN w/ OPT. 263158 - OPT. PREP KITCHEN
A-110 SCALE: 1/4"=1'-0"
TOL081A.A110.DWG

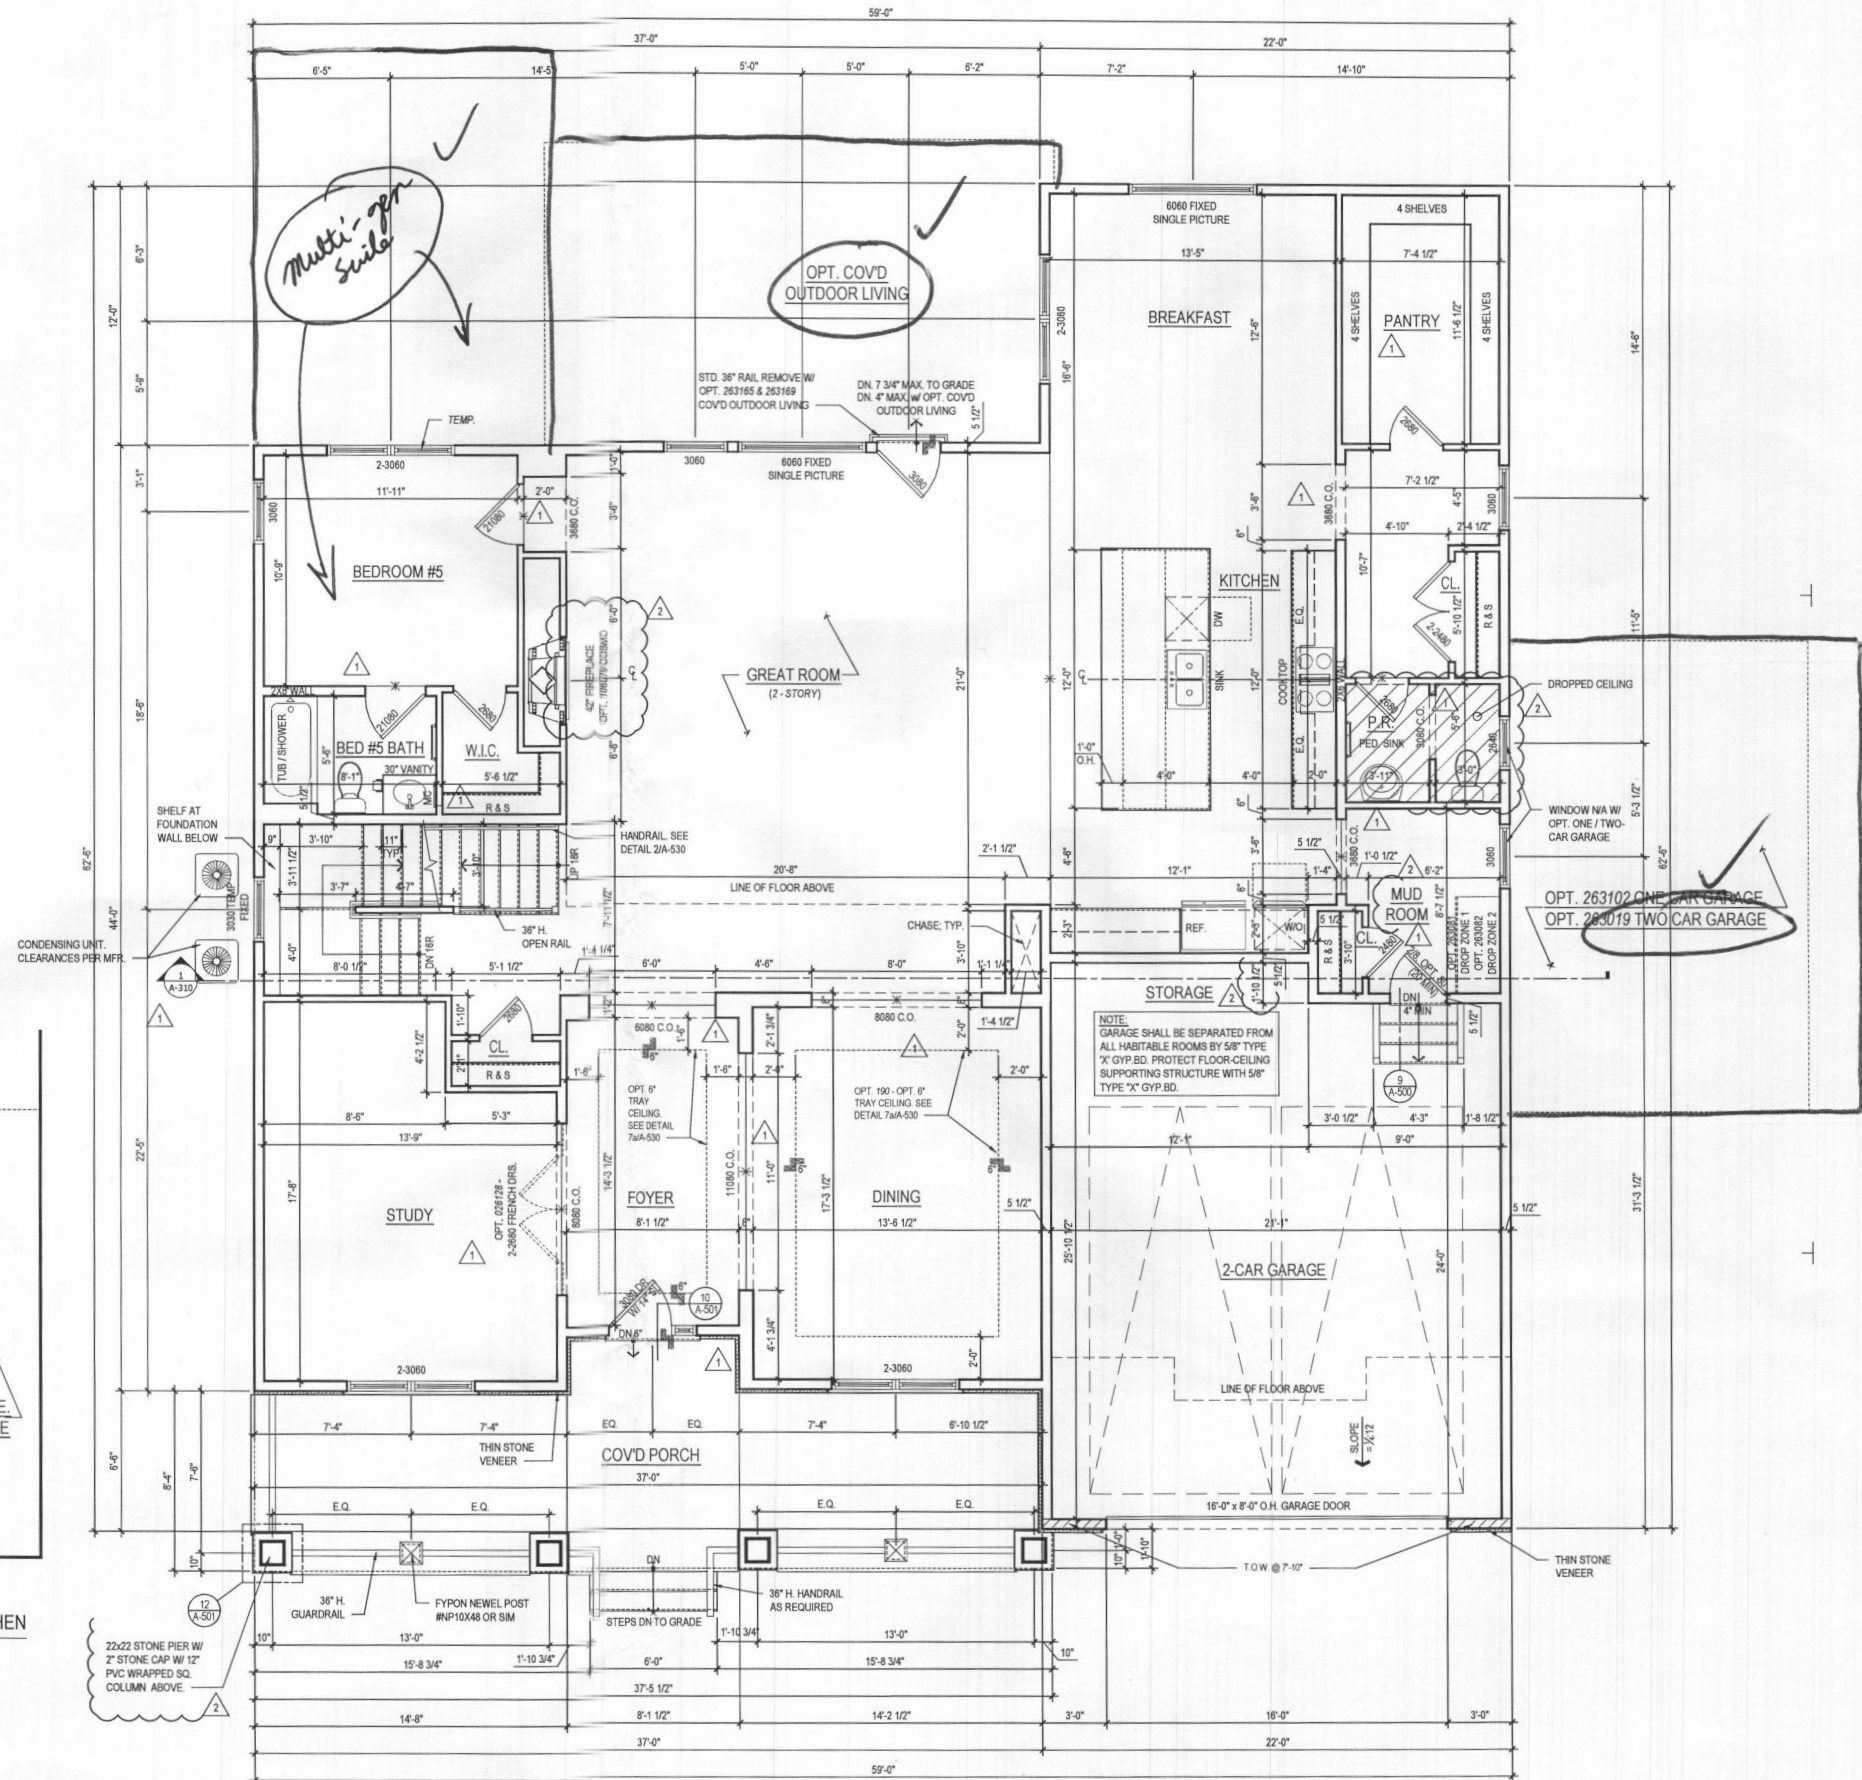

1 FIRST FLOOR PLAN
A-110 SCALE: 1/4"=1'-0"
TOL081A.A110.DWG

@ ELEV. 1 - CRAFTSMAN *shown*

See additional pages for "Modern farmhouse" elev.

ARCHITECT:
lessard DESIGN
8521 Leesburg Pike
Suite 700 | Vienna, VA 22182
P: 571.830.1800 | F: 571.830.1801
www.lessarddesign.com

SEAL & SIGNATURE:

OWNER:
TOLL BROTHERS
19775 BELMONT EXECUTIVE PLAZA
ASHBURN, VA 20147
P: 571.291.8058
CONTACT: CHRISTINA LEMLEY
clmley@tollbrothers.com

PARKHURST FLOOR PLANS
MARYLAND

ISSUE / REVISION		
NO.	DESCRIPTION	DATE
1	BID SET	05.29.19
2	PERMIT SET	06.19.19
3	1 MD NEW STANDARDS	09.16.19
4	2 MFR #220241	12.11.20

PROJECT No: TOL081A
DRAWN BY: AC/RM
CHECKED BY: AP
PLOT DATE: Jan. 20, 2021
FILE NAME: TOL081A_A110.dwg


A-110

- A. ALL WOOD STUD PARTITIONS NOT DIMENSIONED ARE TO BE 1 1/2" FOR INTERIOR AND 5 1/2" FOR EXTERIOR WALLS UNLESS OTHERWISE NOTED.
- B. ALL INTERIOR DIMENSIONS ARE TO FACE OF STUDS.
- C. ALL EXTERIOR DIMENSIONS ARE TO FACE OF STUDS.
- D. ALL DIMENSIONS GOVERN OVER SCALE.
- E. ALL SMOKE DETECTORS ARE TO BE WIRED IN SUCH A MANNER THAT ACTIVATION OF ONE WILL ACTIVATE THEM ALL.
- F. ENCLOSED ACCESSIBLE SPACE UNDER STAIRS SHALL HAVE WALLS AND SOFFITS PROTECTED ON ENCLOSED SIDE WITH 1/2" OPGM BOARD.
- G. ALL WINDOW SIZES ARE NOTED IN FEET + INCHES AS MEASURED FROM SASH TO SASH.
- H. REFER TO ELEVATIONS FOR WINDOW HEAD HEIGHTS.
- I. ALL DOORS ARE TO BE 6'-8" HIGH UNLESS OTHERWISE NOTED.
- J. WASHER ALWAYS TO BE ON LEFT SIDE OF DRYER.
- K. DISHWASHER ALWAYS TO BE ON RIGHT SIDE OF SINK.



1 BASEMENT FLOOR PLAN
A-140 SCALE: 1/4"=1'-0"


A-140

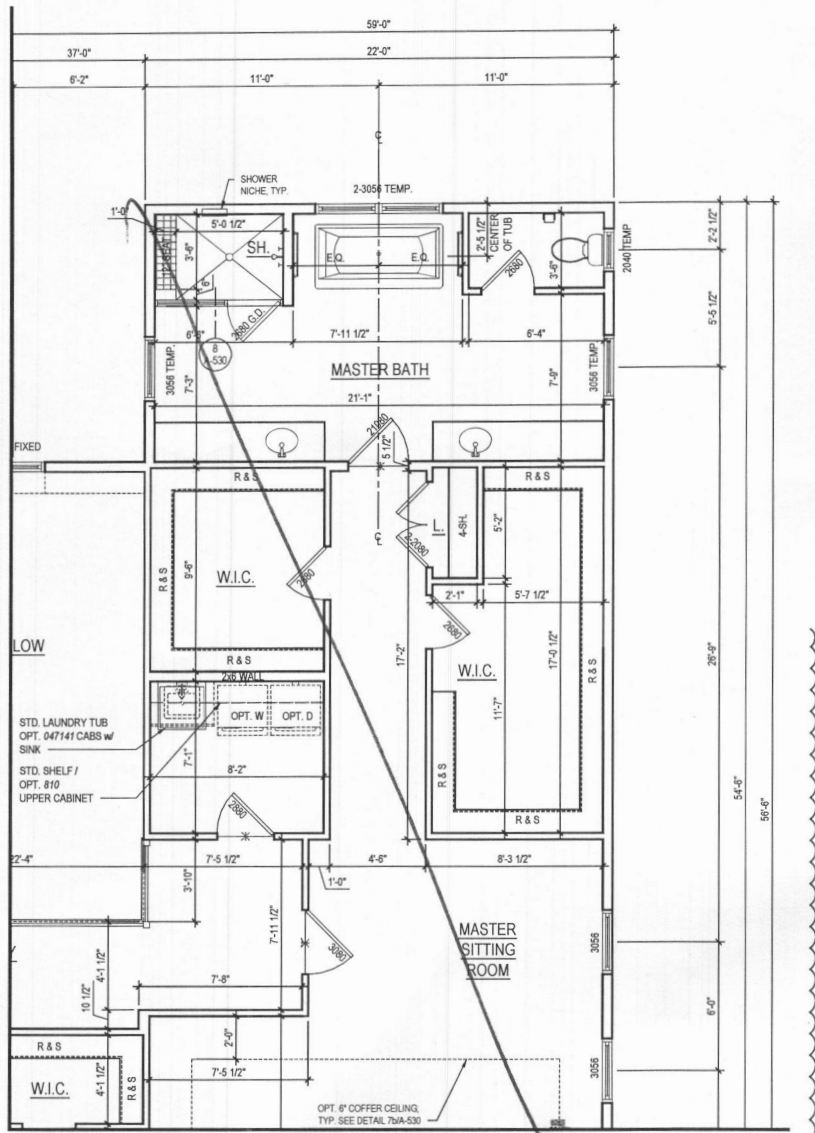

2 PART. SECOND FLOOR PLAN W/ OPT. 030 - ADDITIONAL WALK IN CLOSET
 A-120 SCALE: 1/4"=1'-0"
 TOL081a_A120.dwg

GENERAL PLAN NOTES

- A. ALL WOOD STUD PARTITIONS NOT DIMENSIONED ARE TO BE 3 1/2" FOR INTERIOR AND 5 1/2" FOR EXTERIOR WALLS UNLESS OTHERWISE NOTED.
- B. ALL INTERIOR DIMENSIONS ARE TO FACE OF STUDS.
- C. ALL EXTERIOR DIMENSIONS ARE TO FACE OF STUDS.
- D. ALL DIMENSIONS GOVERN OVER SCALE.
- E. ALL SMOKE DETECTORS ARE TO BE WIRED IN SUCH A MANNER THAT ACTIVATION OF ONE WILL ACTIVATE THEM ALL.
- F. ENCLOSED ACCESSIBLE SPACE UNDER STAIRS SHALL HAVE WALLS AND SOFFITS PROTECTED ON ENCLOSED SIDE WITH 1/2" GYPSUM BOARD.
- G. ALL WINDOWS SIZE ARE NOTED IN FEET + INCHES AS MEASURED FROM SASH TO SASH.
- H. REFER TO ELEVATIONS FOR WINDOW HEAD HEIGHTS.
- I. ALL DOORS ARE TO BE 6'-8" HIGH UNLESS OTHERWISE NOTED.
- J. WASHER ALWAYS TO BE ON LEFT SIDE OF DRYER.
- K. DISHWASHER ALWAYS TO BE ON RIGHT SIDE OF SINK.

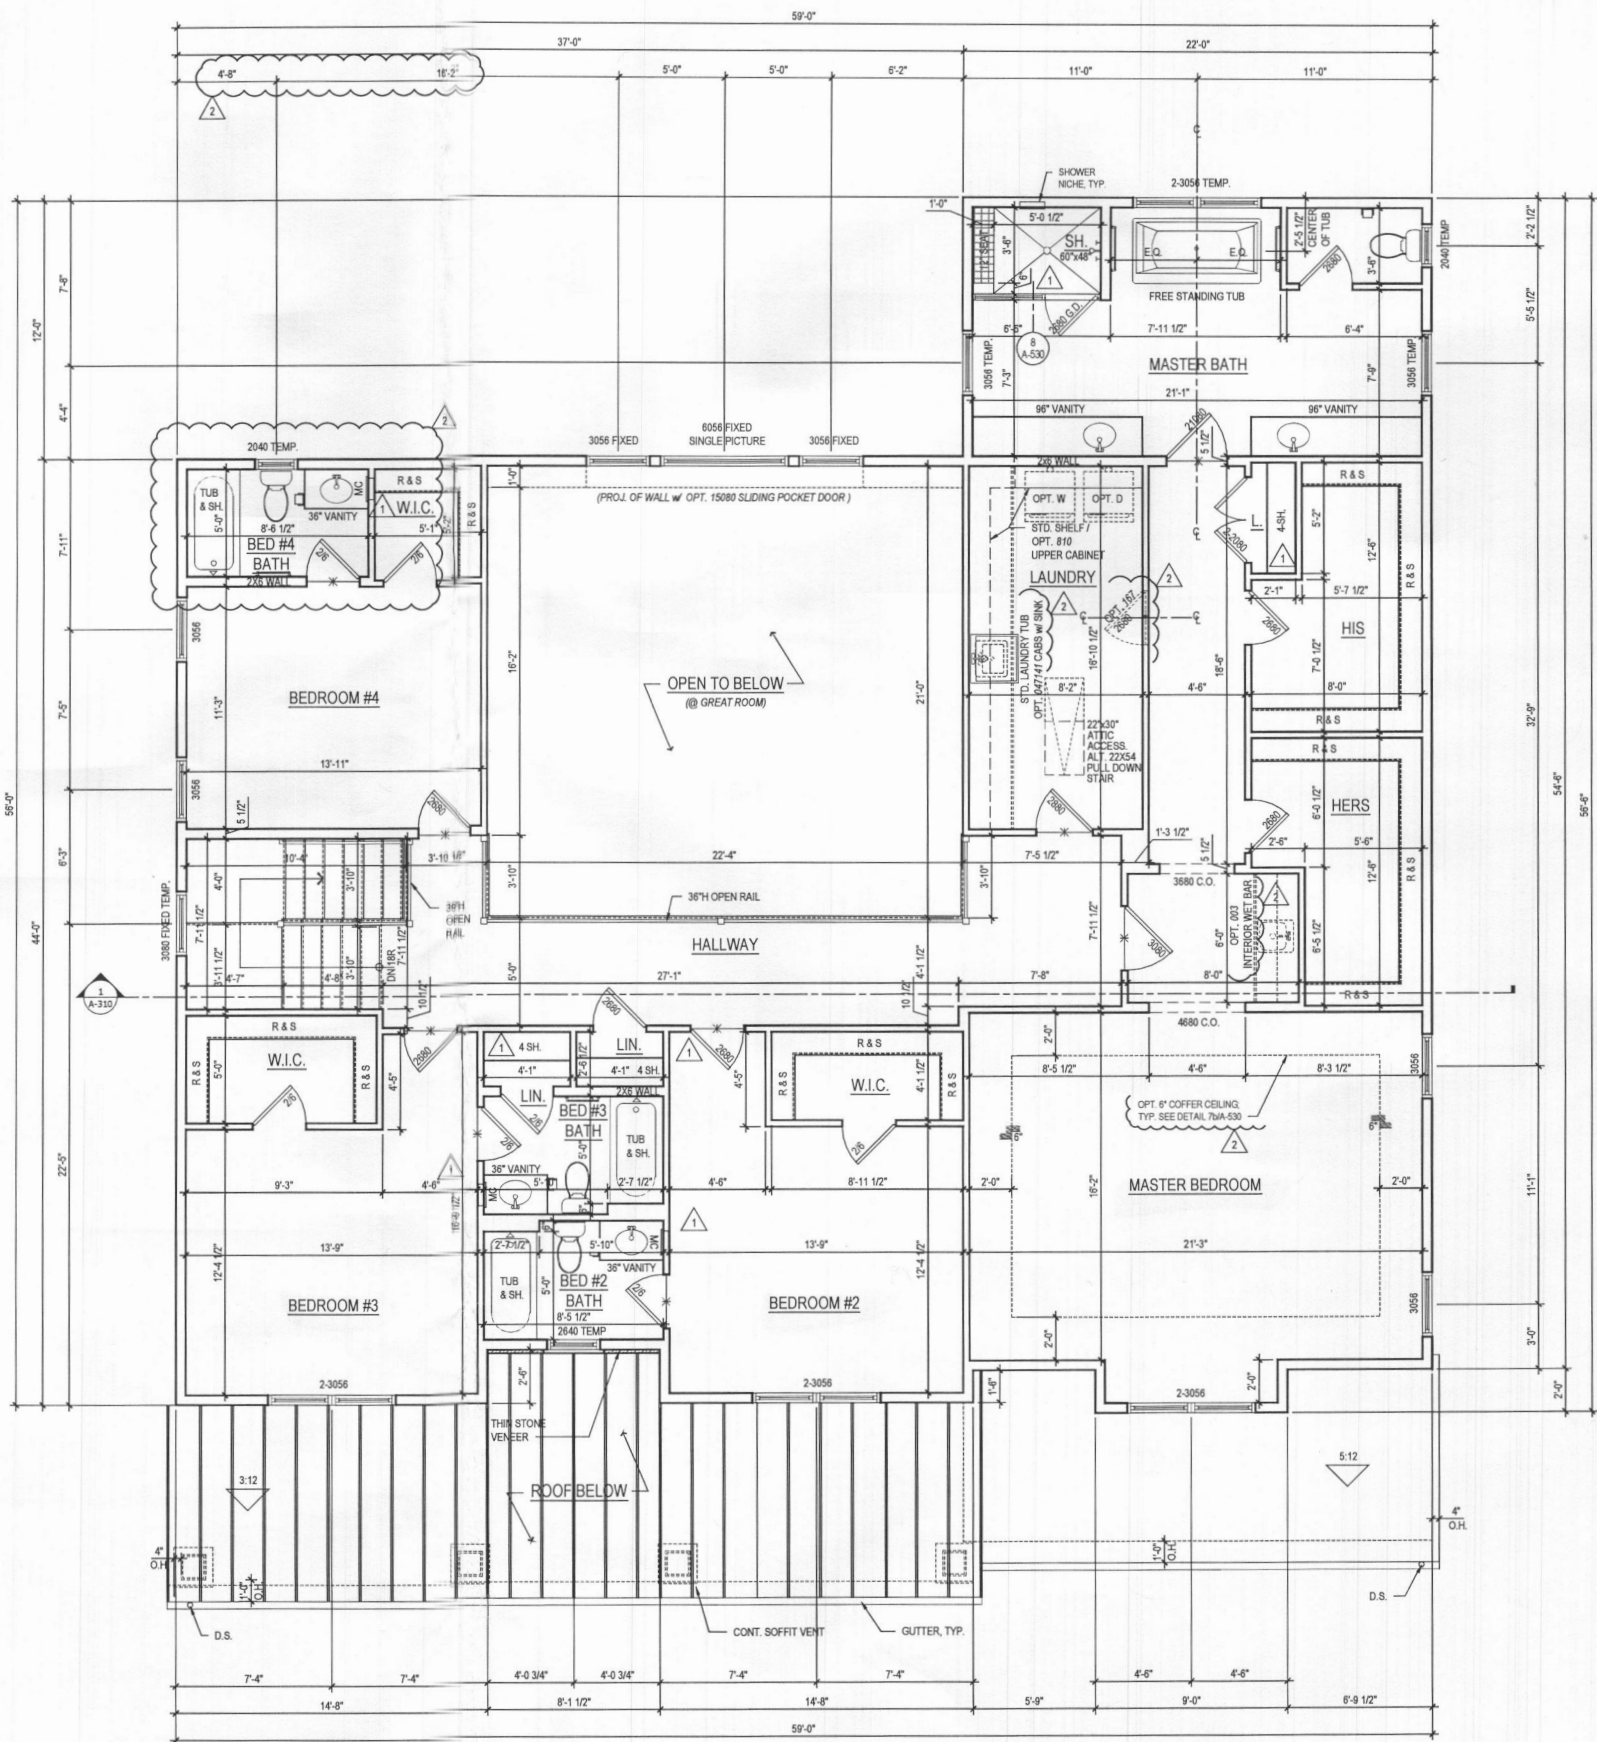

1 SECOND FLOOR PLAN
 A-120 SCALE: 1/4"=1'-0"
 TOL081a_A120.dwg

@ ELEV. 1 - CRAFTSMAN *Shawn*

see additional pages for "Modern Farmhouse" etc.

8521 Leesburg Pike
 Suite 700 | Vienna, VA 22182
 P: 571.830.1800 | F: 571.830.1801
 www.lessarddesign.com

ARCHITECT:

SEAL & SIGNATURE:

OWNER:

TOLL BROTHERS
 19775 BELMONT EXECUTIVE PLAZA
 ASHBURN, VA 20147
 P: 571.291.8068
 CONTACT: CHRISTINA LEMLEY
 clemley@tollbrothers.com

PROJECT NAME:

MARYLAND

SHEET TITLE:

PARKHURST FLOOR PLANS

ISSUE / REVISION

NO.	DESCRIPTION	DATE
BID SET		05.29.19
PERMIT SET		06.19.19
1 MD NEW STANDARDS		09.16.19
2 MR #220241		12.11.20

PROJECT No:

TOL081a

DRAWN BY:

AC/RN

CHECKED BY:

AP

PLOT DATE:

Jan. 20, 2022

FILE NAME:

TOL081a_A120.dwg

A-120

GENERAL PLAN NOTES

- ALL WOOD STUD PARTITIONS NOT DIMENSIONED ARE TO BE 3 1/2" FOR INTERIOR AND 5 1/2" FOR EXTERIOR WALLS UNLESS OTHERWISE NOTED.
- ALL INTERIOR DIMENSIONS ARE TO FACE OF STUDS.
- ALL EXTERIOR DIMENSIONS ARE TO FACE OF STUDS.
- ALL DIMENSIONS GOVERN OVER SCALE.
- ALL SMOKE DETECTORS ARE TO BE WIRED IN SUCH A MANNER THAT ACTIVATION OF ONE WILL ACTIVATE THEM ALL.
- ENCLOSED ACCESSIBLE SPACE UNDER STAIRS SHALL HAVE WALLS AND SOFFITS PROTECTED ON ENCLOSED SIDE WITH 1/2" GYPSUM BOARD.
- ALL WINDOWS SIZE ARE NOTED IN FEET + INCHES AS MEASURED FROM SASH TO SASH.
- REFER TO ELEVATIONS FOR WINDOW HEAD HEIGHTS.
- ALL DOORS ARE TO BE 6'-8" HIGH UNLESS OTHERWISE NOTED.
- WASHER ALWAYS TO BE ON LEFT SIDE OF DRYER.
- DISHWASHER ALWAYS TO BE ON RIGHT SIDE OF SINK.



5 PART. LEFT ELEV.

A-407 SCALE: 1/4"=1'-0"

w/ OPT. 263073 MULTI-GEN. SUITE

w/ COVD OUTDOOR LIVING @ WALKOUT CONDITION




4 REAR ELEVATION

A-407 SCALE: 1/4"=1'-0"

w/ OPT. 263073 MULTI-GEN. SUITE

w/ COVD OUTDOOR LIVING @ WALKOUT CONDITION

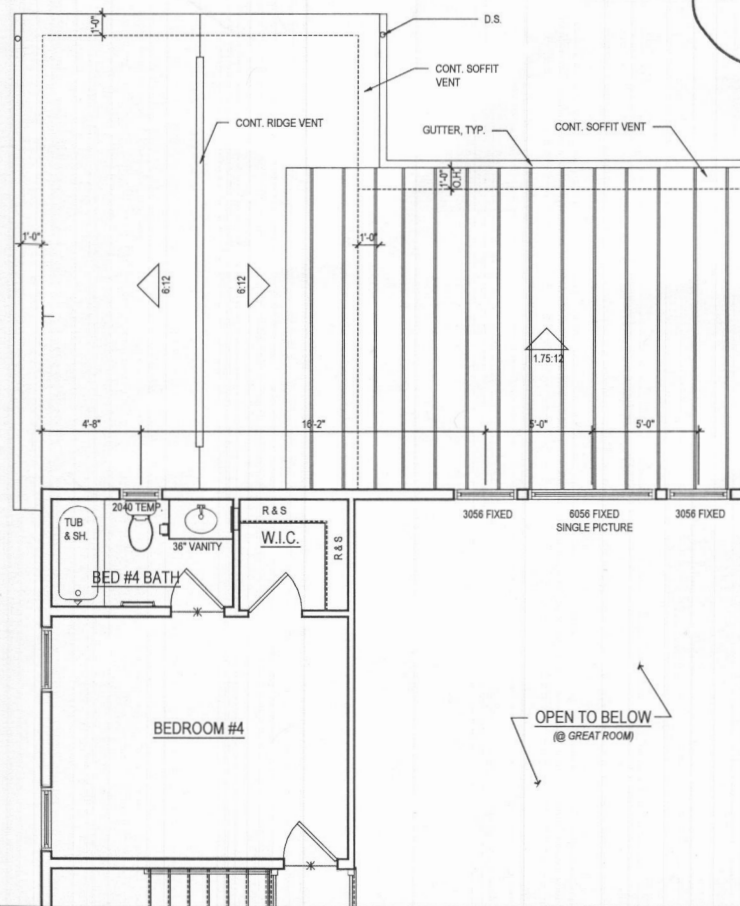


3 PART. SECOND FLOOR PLAN

A-407 SCALE: 1/4"=1'-0"

w/ OPT. 263073 MULTI-GEN. SUITE

w/ COVD OUTDOOR LIVING @ WALKOUT CONDITION

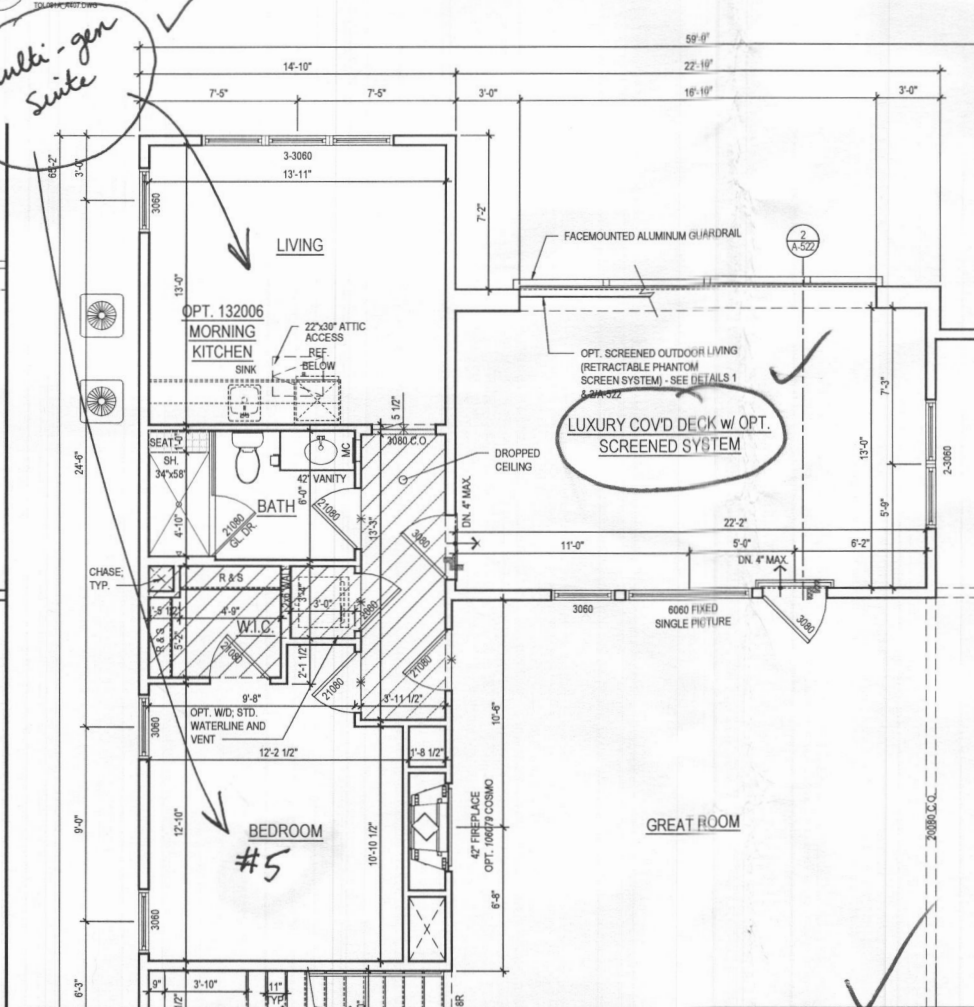


2 PART. FIRST FLOOR PLAN

A-407 SCALE: 1/4"=1'-0"

w/ OPT. 263073 MULTI-GEN. SUITE

w/ COVD OUTDOOR LIVING @ WALKOUT CONDITION

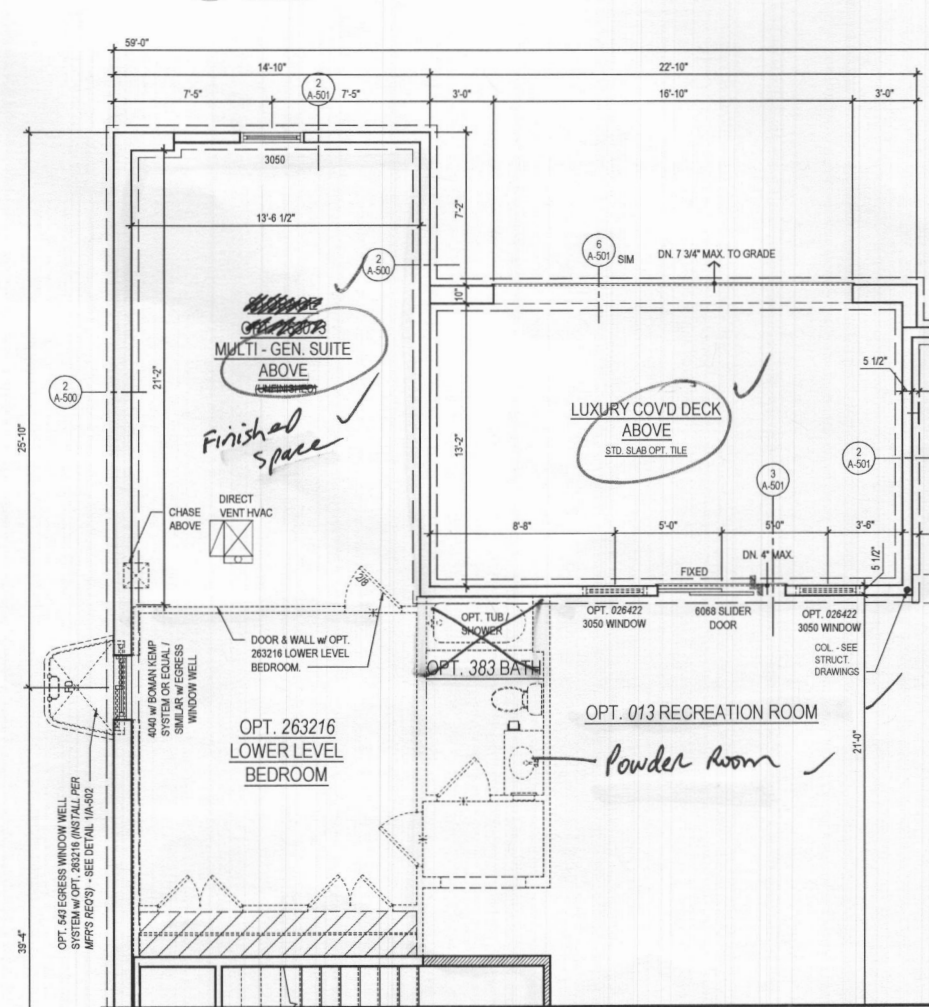

1 PART. BASEMENT PLAN

A-407 SCALE: 1/4"=1'-0"

w/ OPT. 263073 MULTI-GEN. SUITE

w/ COVD OUTDOOR LIVING @ WALKOUT CONDITION

ARCHITECT:

lessard
DESIGN

8521 Leesburg Pike
Suite 700 | Vienna, VA 22182
P: 571.830.1800 | F: 571.830.1801
www.lessarddesign.com

SEAL & SIGNATURE:

OWNER:

TOLL BROTHERS

19775 BELMONT EXECUTIVE PLAZA
ASHBURN, VA 20147
P: 571.291.8068
CONTACT: CHRISTINA LEMLEY
clemley@tollbrothers.com

PROJECT NAME:

SHEET TITLE:

ISSUE / REVISION		
NO.	DESCRIPTION	DATE
1	BID SET	05.29.19
2	PERMIT SET	06.19.19
3	MD NEW STANDARDS	09.16.19
4	MR # 220241	12.11.20

PROJECT NO: TOL081a
DRAWN BY: AC/RN
CHECKED BY: AP
PLOT DATE: Jan. 20, 2021
FILE NAME: TOL081a_A407.dwg

A-407

PARKHURST
OPTIONS