
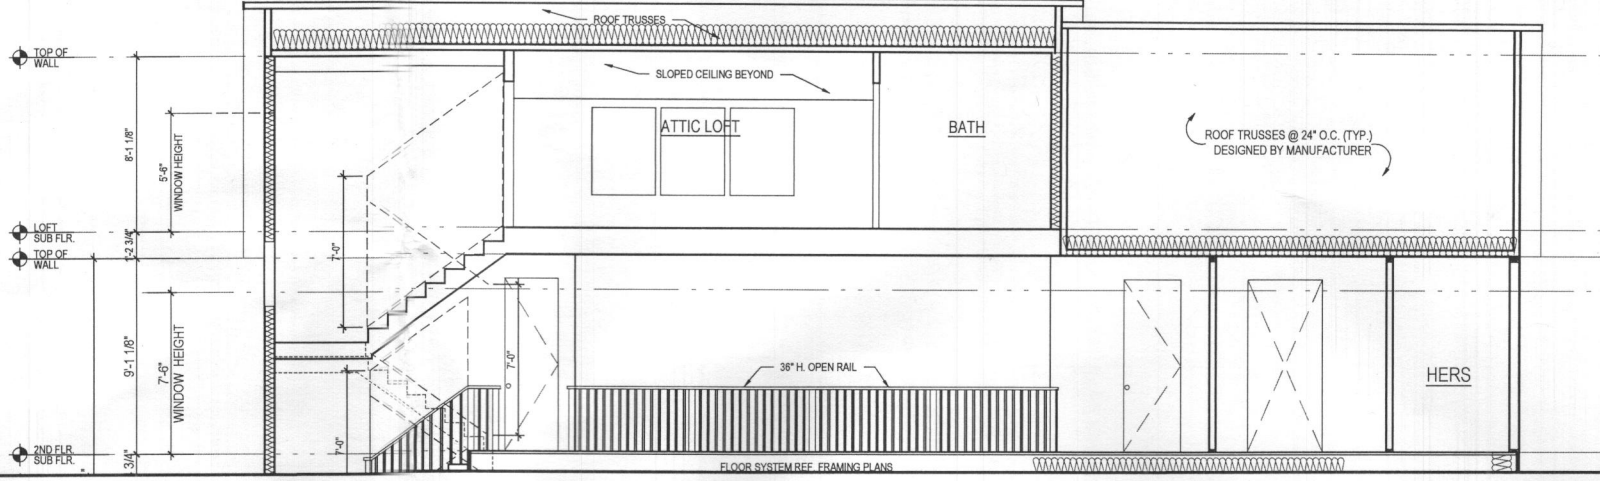


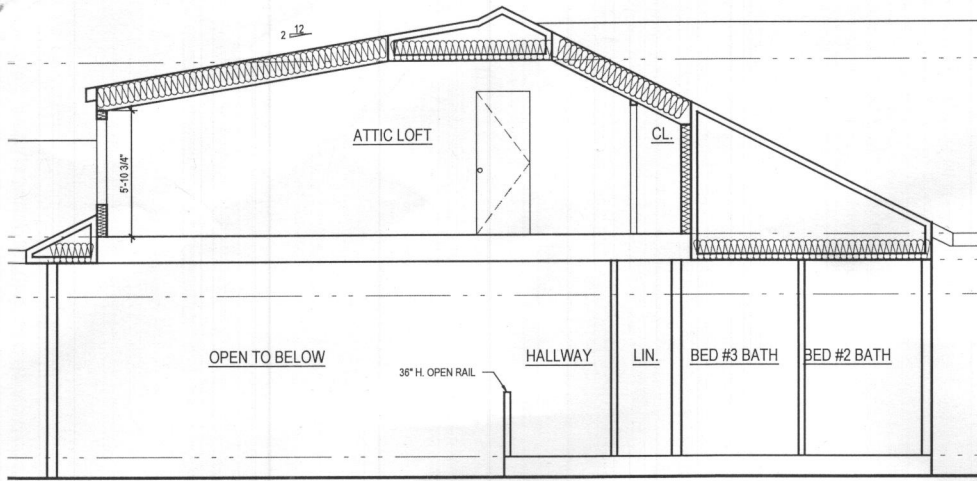


4 ATTIC SECTION w/ OPT. 539 : THIRD FLOOR WALK UP SPACE
 @ ELEV. 2 - MODERN FARMHOUSE, & ELEV. 5 - FAIRVIEW
 N/A W/ ELEV. #1, & #4
 A-408 SCALE: 1/4"=1'-0"
 TOL081a_A408.dwg

3 ATTIC SECTION w/ OPT. 539 : THIRD FLOOR WALK UP SPACE
 @ ELEV. 2 - MODERN FARMHOUSE, & ELEV. 5 - FAIRVIEW
 N/A W/ ELEV. #1, & #4
 A-408 SCALE: 1/4"=1'-0"
 TOL081a_A408.dwg


GENERAL PLAN NOTES

- A. ALL WOOD STUD PARTITIONS NOT DIMENSIONED ARE TO BE 3 1/2" FOR INTERIOR AND 5 1/2" FOR EXTERIOR WALLS UNLESS OTHERWISE NOTED.
- B. ALL INTERIOR DIMENSIONS ARE TO FACE OF STUDS.
- C. ALL EXTERIOR DIMENSIONS ARE TO FACE OF STUDS.
- D. ALL DIMENSIONS GOVERN OVER SCALE.
- E. ALL SMOKE DETECTORS ARE TO BE WIRED IN SUCH A MANNER THAT ACTIVATION OF ONE WILL ACTIVATE THEM ALL.
- F. ENCLOSED ACCESSIBLE SPACE UNDER STAIRS SHALL HAVE WALLS AND SOFFITS PROTECTED ON ENCLOSED SIDE WITH 1/2" GYPSUM BOARD.
- G. ALL WINDOWS SIZE ARE NOTED IN FEET + INCHES AS MEASURED FROM SASH TO SASH.
- H. REFER TO ELEVATIONS FOR WINDOW HEAD HEIGHTS.
- I. ALL DOORS ARE TO BE 6'-8" HIGH UNLESS OTHERWISE NOTED.
- J. WASHER ALWAYS TO BE ON LEFT SIDE OF DRYER.
- K. DISHWASHER ALWAYS TO BE ON RIGHT SIDE OF SINK.

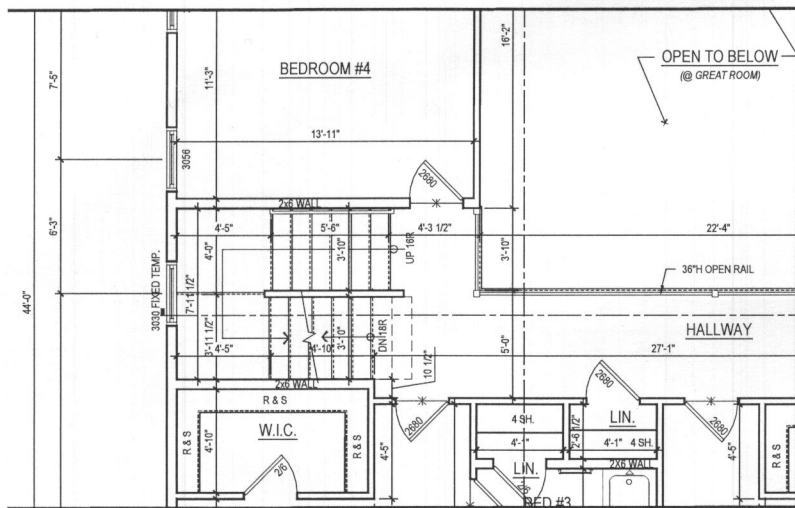

2 PART. SECOND FLOOR PLAN w/ OPT. 539 : THIRD FLOOR WALK UP SPACE
 @ ELEV. 2 - MODERN FARMHOUSE, & ELEV. 5 - FAIRVIEW
 N/A W/ ELEV. #1, & #4
 A-408 SCALE: 1/4"=1'-0"
 TOL081a_A408.dwg

USABLE SPACE	SQ. FT.
ATTIC LOFT AREA	545.70 SQ. FT.
50% AREA	272.85 SQ. FT.
AREA WITH 7' CEILING	342.30 SQ. FT.

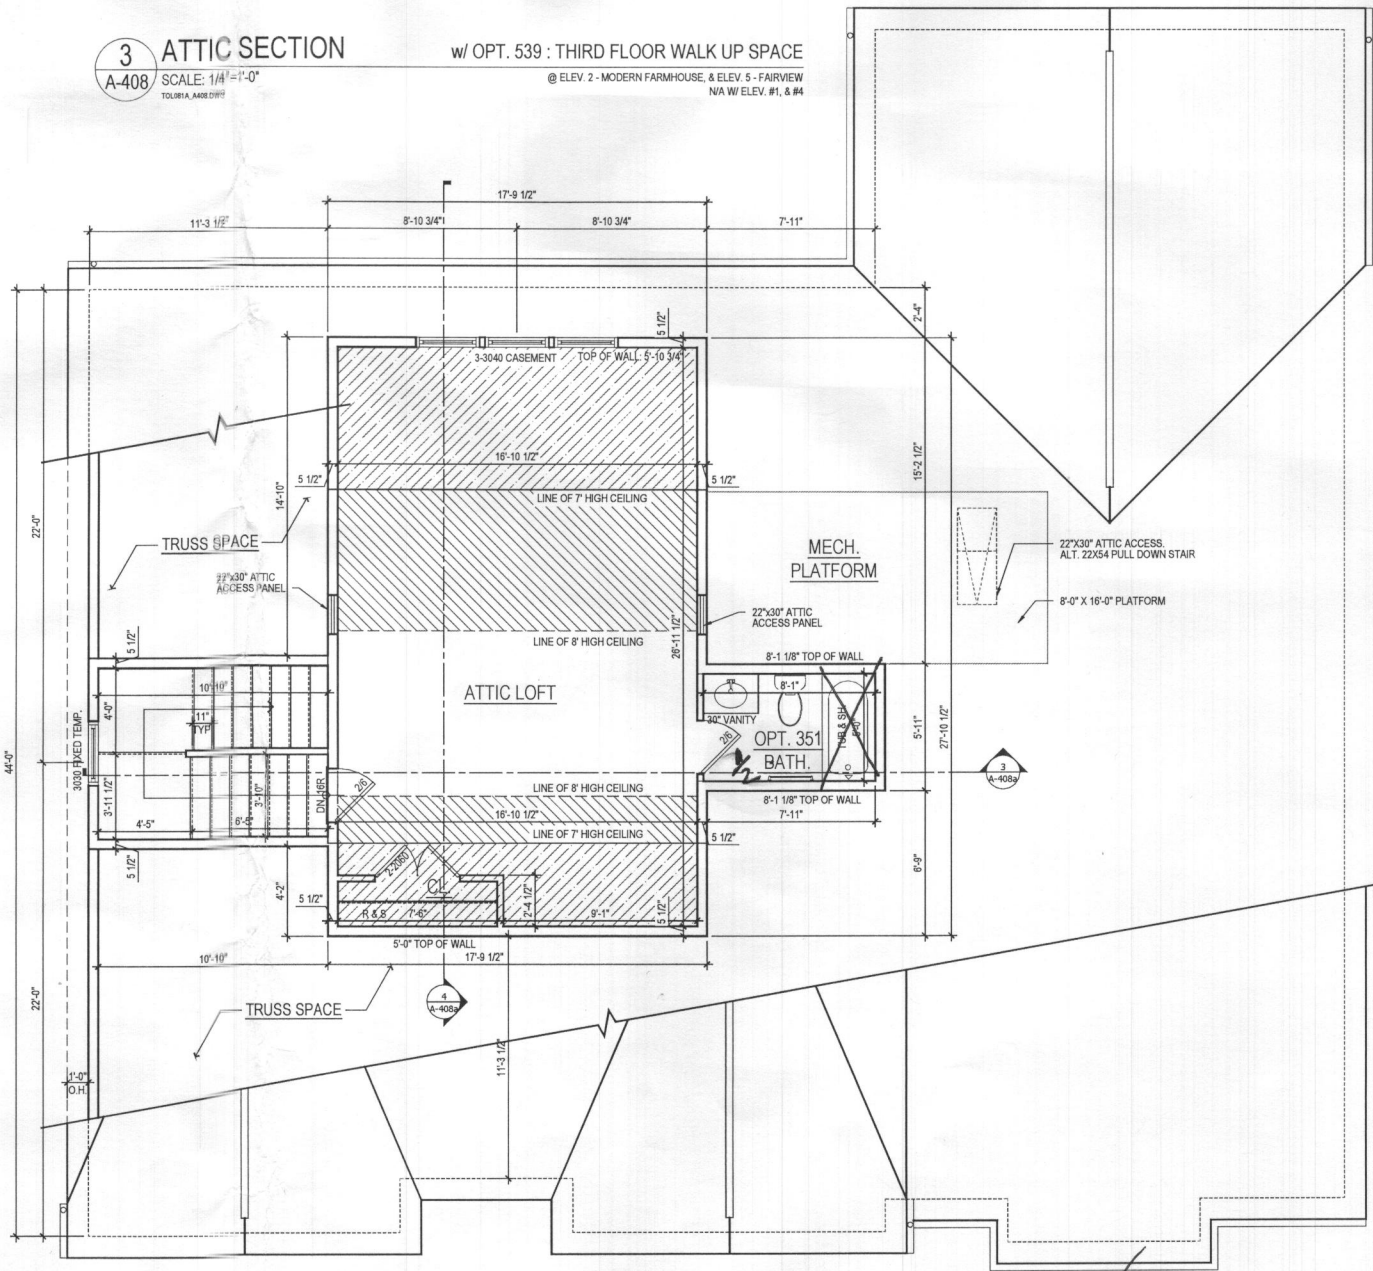

1 ATTIC FLOOR PLAN w/ OPT. 539 : THIRD FLOOR WALK UP SPACE
 @ ELEV. 2 - MODERN FARMHOUSE, & ELEV. 5 - FAIRVIEW
 N/A W/ ELEV. #1, & #4
 A-408 SCALE: 1/4"=1'-0"
 TOL081a_A408.dwg

ARCHITECT:

8521 Leesburg Pike
 Suite 700 | Vienna, VA 22182
 P: 571.291.8068 | F: 571.830.1801
 www.lessarddesign.com

SEAL & SIGNATURE:

OWNER:

TOLL BROTHERS
 19775 BELMONT EXECUTIVE PLAZA
 ASHBURN, VA 20147
 P: 571.291.8068
 CONTACT: CHRISTINA LEMLEY
 clemley@tollbrothers.com


PROJECT NAME: MARYLAND

SHEET TITLE: **PARKHURST**
OPT. 539 : 3RD FLOOR WALK UP SPACE

ISSUE / REVISION		
NO.	DESCRIPTION	DATE
BID SET		05.29.19
PERMIT SET		06.19.19
1 MD NEW STANDARDS		09.16.19
2 MR #220241		12.11.20

PROJECT NO: TOL081a
 DRAWN BY: AC/RN
 CHECKED BY: JF
 PLOT DATE: Jan. 20, 2021
 FILE NAME: TOL081a_A408.dwg

A-408

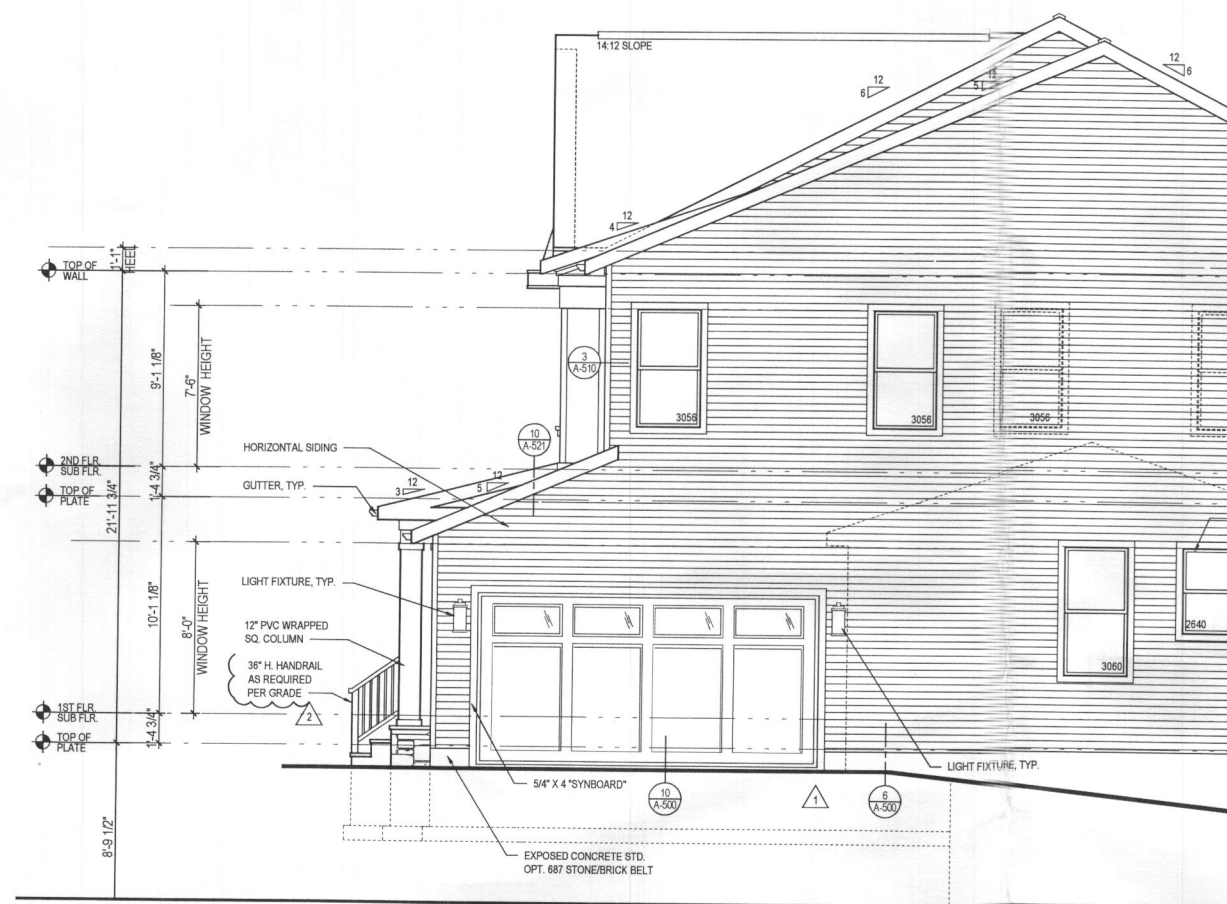


4 PART. RIGHT SIDE ELEVATION w/ OPT. 012 - SIDE LOAD GARAGE
A-400b SCALE: 1/4"=1'-0" ELEV. 2 - SHOWN
TOL081A_A400.DWG




3 PART. FRONT ELEVATION w/ OPT. 012 - SIDE LOAD GARAGE
A-400b SCALE: 1/4"=1'-0" ELEV. 2 - SHOWN
TOL081A_A400.DWG

- GENERAL PLAN NOTES**
- ALL WOOD STUD PARTITIONS NOT DIMENSIONED ARE TO BE 3 1/2" FOR INTERIOR AND 5 1/2" FOR EXTERIOR WALLS UNLESS OTHERWISE NOTED.
 - ALL INTERIOR DIMENSIONS ARE TO FACE OF STUDS.
 - ALL EXTERIOR DIMENSIONS ARE TO FACE OF STUDS.
 - ALL DIMENSIONS GOVERN OVER SCALE.
 - ALL SMOKE DETECTORS ARE TO BE WIRED IN SUCH A MANNER THAT ACTIVATION OF ONE WILL ACTIVATE THEM ALL.
 - ENCLOSED ACCESSIBLE SPACE UNDER STAIRS SHALL HAVE WALLS AND SOFFITS PROTECTED ON ENCLOSED SIDE WITH 1/2" GYPSUM BOARD.
 - ALL WINDOWS SIZE ARE NOTED IN FEET + INCHES AS MEASURED FROM SASH TO SASH.
 - REFER TO ELEVATIONS FOR WINDOW HEAD HEIGHTS.
 - ALL DOORS ARE TO BE 6'-8" HIGH UNLESS OTHERWISE NOTED.
 - WASHER ALWAYS TO BE ON LEFT SIDE OF DRYER.
 - DISHWASHER ALWAYS TO BE ON RIGHT SIDE OF SINK.

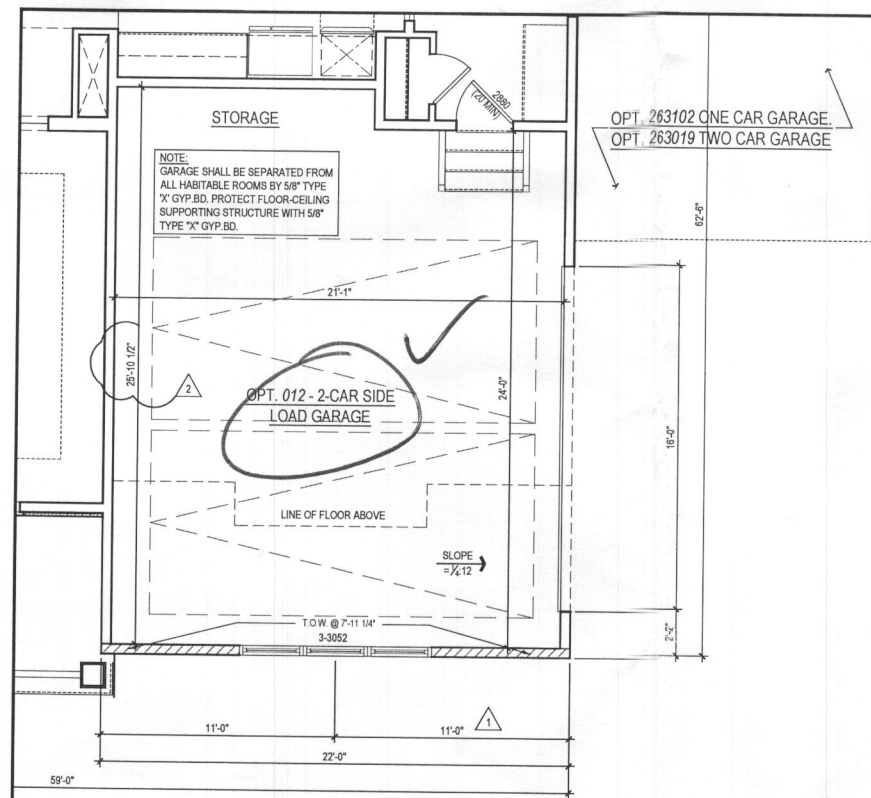

2 PART. FIRST FLOOR PLAN w/ OPT. 012 - SIDE LOAD GARAGE
A-400b SCALE: 1/4"=1'-0" ELEV. 2 - SHOWN
TOL081A_A400.DWG

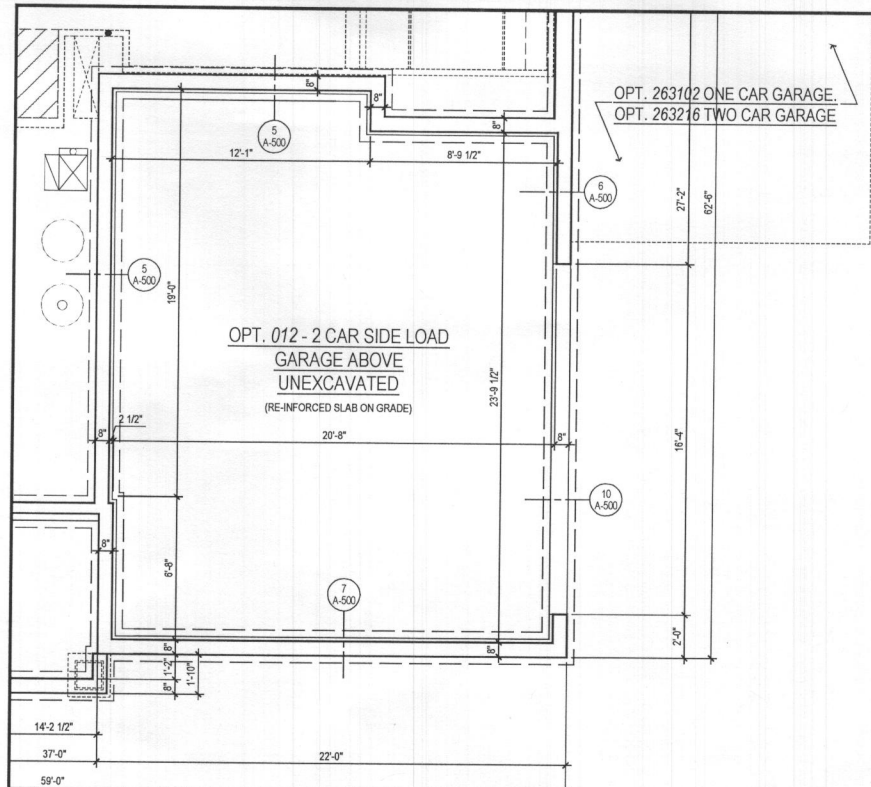

1 PART. BASEMENT FLOOR PLAN w/ OPT. 012 - SIDE LOAD GARAGE
A-400b SCALE: 1/4"=1'-0" ELEV. 2 - SHOWN
TOL081A_A400.DWG

ARCHITECT:
lessard DESIGN
8521 Leesburg Pike
Suite 700 | Vienna, VA 22182
P: 571.830.1800 | F: 571.830.1801
www.lessarddesign.com

SEAL & SIGNATURE:

OWNER:

TOLL BROTHERS
19775 BELMONT EXECUTIVE PLAZA
ASHBURN, VA 20147
P: 571.291.8068
CONTACT: CHRISTINA LEMLEY
clemley@tollbrothers.com

MARYLAND

**PARKHURST
OPTIONS**

PROJECT NAME: _____ SHEET TITLE: _____

ISSUE / REVISION		
NO.	DESCRIPTION	DATE
BID SET		05.29.19
PERMIT SET		06.19.19
1	MD NEW STANDARDS	09.16.19
2	MR #220241	12.11.20

PROJECT No: TOL081A
DRAWN BY: ACR
CHECKED BY: AL
PLOT DATE: Jan. 20, 2021
FILE NAME: TOL081a_A400.dwg


A-400b

GENERAL PLAN NOTES


- ALL WOOD STUD PARTITIONS NOT DIMENSIONED ARE TO BE 3 1/2" FOR INTERIOR AND 5 1/2" FOR EXTERIOR WALLS UNLESS OTHERWISE NOTED.
- ALL INTERIOR DIMENSIONS ARE TO FACE OF STUDS.
- ALL EXTERIOR DIMENSIONS ARE TO FACE OF STUDS.
- ALL DIMENSIONS GOVERN OVER SCALE.
- ALL SMOKE DETECTORS ARE TO BE WIRED IN SUCH A MANNER THAT ACTIVATION OF ONE WILL ACTIVATE THEM ALL.
- ENCLOSED ACCESSIBLE SPACE UNDER STAIRS SHALL HAVE WALLS AND SOFFITS PROTECTED ON ENCLOSED SIDE WITH 1/2" GYPSUM BOARD.
- ALL WINDOWS SIZE ARE NOTED IN FEET + INCHES AS MEASURED FROM SASH TO SASH.
- REFER TO ELEVATIONS FOR WINDOW HEAD HEIGHTS.
- ALL DOORS ARE TO BE 8'-0" HIGH UNLESS OTHERWISE NOTED.
- WASHER ALWAYS TO BE ON LEFT SIDE OF DRYER.
- DISHWASHER ALWAYS TO BE ON RIGHT SIDE OF SINK.

ROOF VENTILATION CALCULATIONS - TWO CAR GARAGE ROOF


ROOF AREA	=	484.00 SQ. FT.
/ 300	=	1.61 SQ. FT.
x 12 x 12	=	232.32 SQ. IN.
50% (INTAKE)	=	116.16 SQ. IN.
SOFFIT VENT - REQUIRED (INTAKE @ 5.9 SQ. IN. / FT.)	=	19.69 FT.
SOFFIT VENT - PROVIDED	=	70.00 FT.
50% (OUTTAKE)	=	116.16 SQ. IN.
RIDGE VENT - REQUIRED (OUTTAKE @ 14.1 SQ. IN. / FT.)	=	8.24 FT.
RIDGE VENT - PROVIDED	=	19.00 FT.

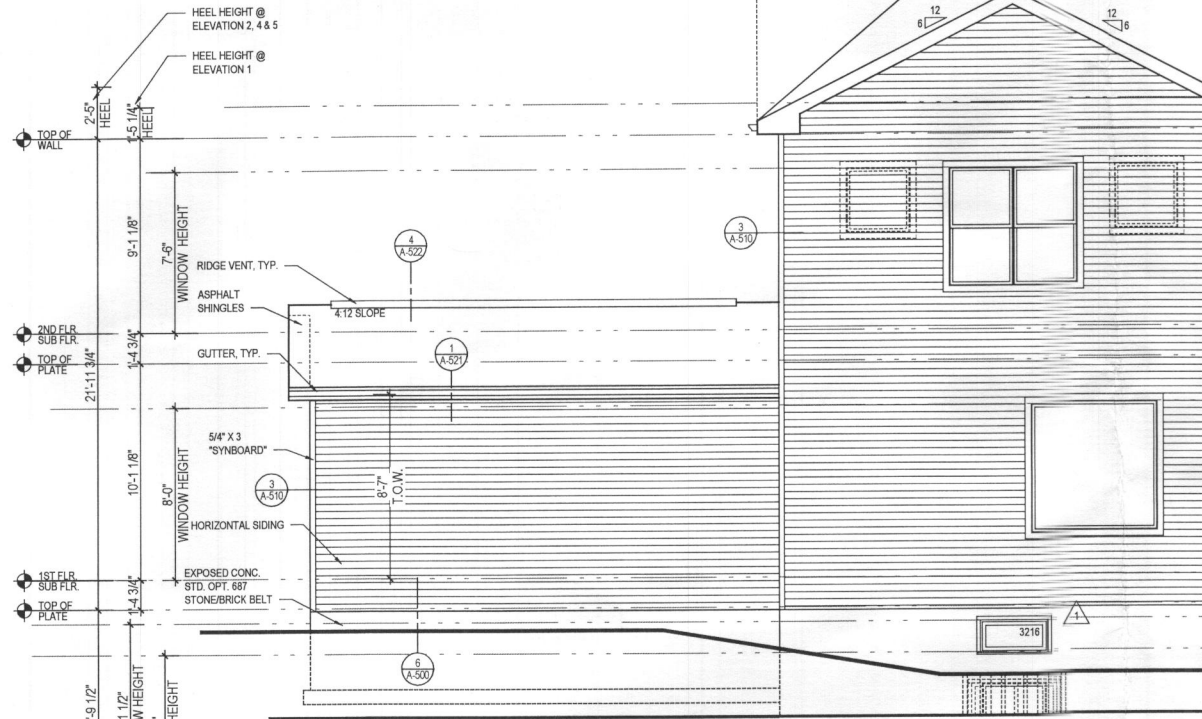


6 PART. REAR ELEVATION w/ OPT. 263019 - ADDITIONAL TWO CAR FRONT ENTRY GARAGE
ELEV. 1 - SHOWN
SCALE: 1/4"=1'-0"
TOL081A_A404.DWG

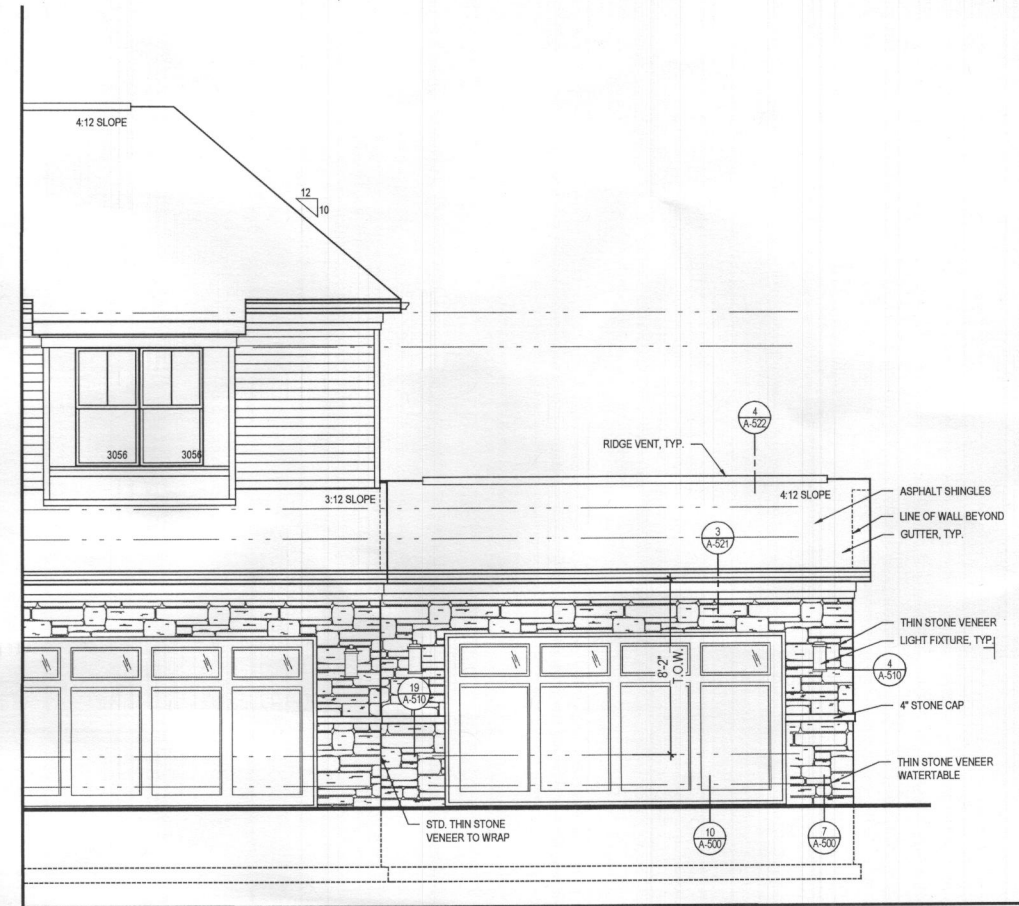


4 PART. FRONT ELEVATION w/ OPT. 263019 - ADDITIONAL TWO CAR FRONT ENTRY GARAGE
ELEV. 1 - SHOWN
SCALE: 1/4"=1'-0"
TOL081A_A404.DWG

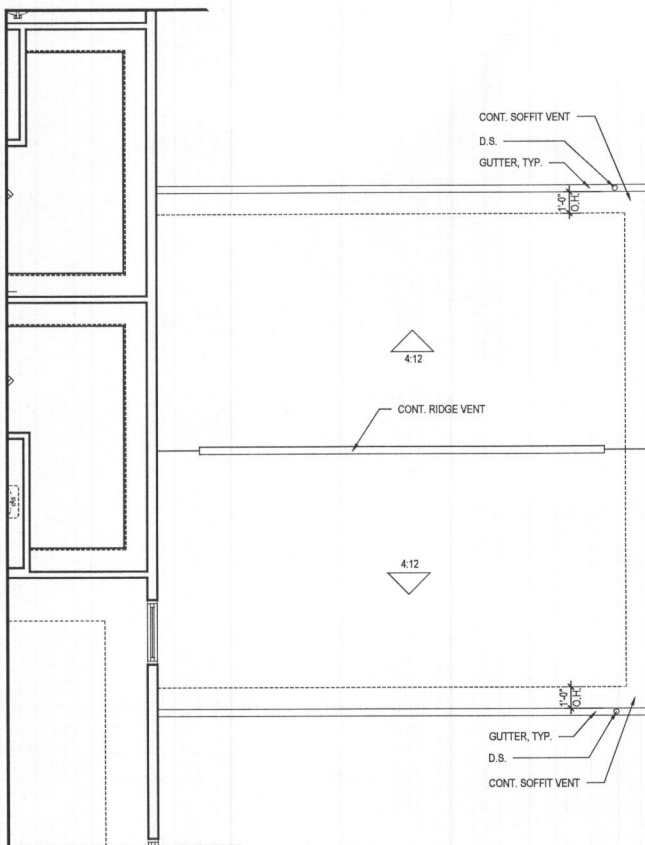

3 P. SECOND FLOOR w/ OPT. 263019 - ADDITIONAL TWO CAR FRONT ENTRY GARAGE
SCALE: 1/4"=1'-0"
TOL081A_A404.DWG

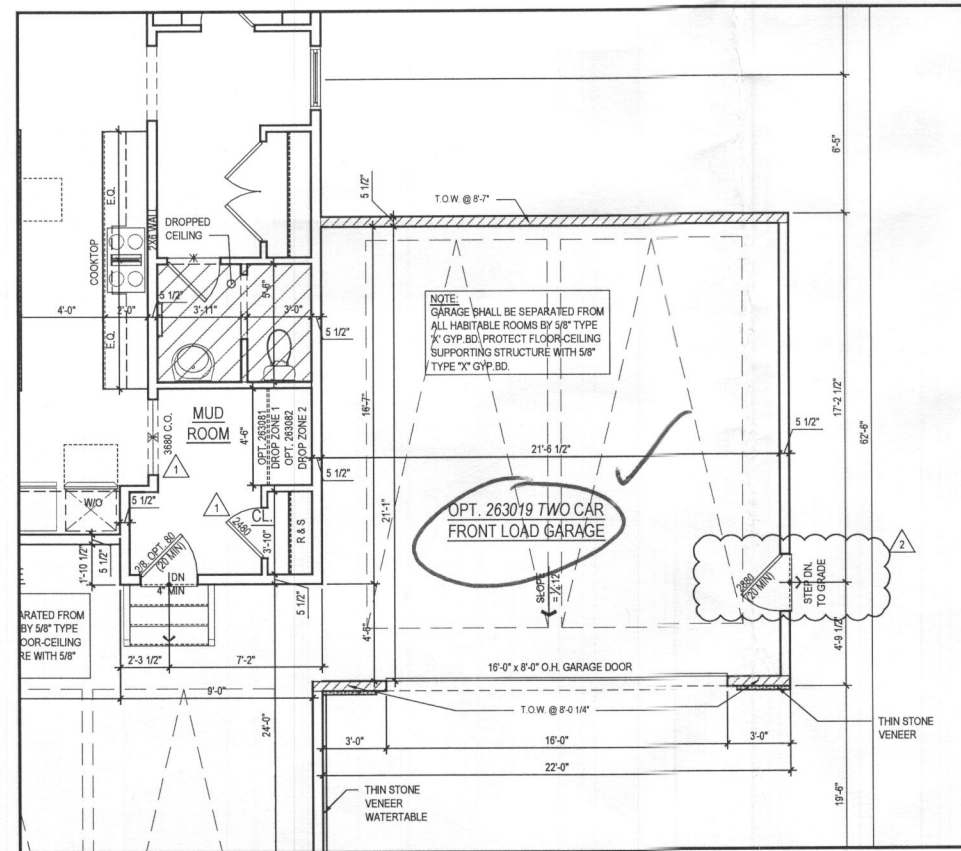

2 PART. FIRST FLOOR PLAN w/ OPT. 263019 - ADDITIONAL TWO CAR FRONT ENTRY GARAGE
SCALE: 1/4"=1'-0"
TOL081A_A404.DWG

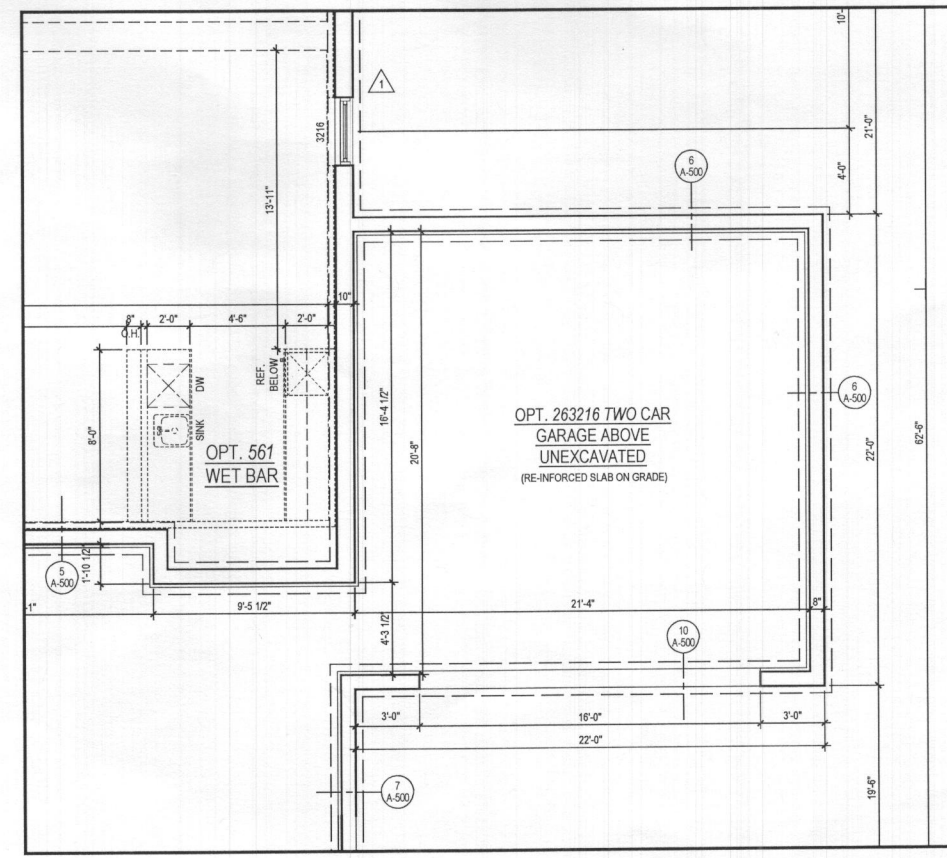

1 PART. BASEMENT FLOOR PLAN w/ OPT. 263019 - ADDITIONAL TWO CAR FRONT ENTRY GARAGE
SCALE: 1/4"=1'-0"
TOL081A_A404.DWG

ARCHITECT:

lessard
DESIGN

8521 Leesburg Pike
Suite 700 | Vienna, VA 22182
P: 571.830.1800 | F: 571.830.1801
www.lessarddesign.com

SEAL & SIGNATURE:

OWNER:

TOLL BROTHERS
19775 BELMONT EXECUTIVE PLAZA
ASHBURN, VA 20147
P: 571.291.8068
CONTACT: CHRISTINA LEMLEY
clemley@tollbrothers.com

PROJECT NAME: MARYLAND

SHEET TITLE: PARKHURST OPTIONS


ISSUE / REVISION		
NO.	DESCRIPTION	DATE
1	BID SET	05.29.19
2	PERMIT SET	06.19.19
3	MD NEW STANDARDS	09.16.19
4	MR #220241	12.11.20

PROJECT NO: TOL081A
DRAWN BY: AC/RN
CHECKED BY: AP
PLOT DATE: Jan. 20, 2021
FILE NAME: TOL081A_A404.dwg

A-404


GENERAL PLAN NOTES

- ALL WOOD STUD PARTITIONS NOT DIMENSIONED ARE TO BE 3 1/2" FOR INTERIOR AND 5 1/2" FOR EXTERIOR WALLS UNLESS OTHERWISE NOTED.
- ALL INTERIOR DIMENSIONS ARE TO FACE OF STUDS.
- ALL EXTERIOR DIMENSIONS ARE TO FACE OF STUDS.
- ALL DIMENSIONS GOVERN OVER SCALE.
- ALL SMOKE DETECTORS ARE TO BE WIRED IN SUCH A MANNER THAT ACTIVATION OF ONE WILL ACTIVATE THEM ALL.
- ENCLOSED ACCESSIBLE SPACE UNDER STAIRS SHALL HAVE WALLS AND SOFFITS PROTECTED ON ENCLOSED SIDE WITH 1/2" GYPSUM BOARD.
- ALL WINDOWS SIZE ARE NOTED IN FEET + INCHES AS MEASURED FROM SASH TO SASH.
- REFER TO ELEVATIONS FOR WINDOW HEAD HEIGHTS.
- ALL DOORS ARE TO BE 6'-8" HIGH UNLESS OTHERWISE NOTED.
- WASHER ALWAYS TO BE ON LEFT SIDE OF DRYER.
- DISHWASHER ALWAYS TO BE ON RIGHT SIDE OF SINK.

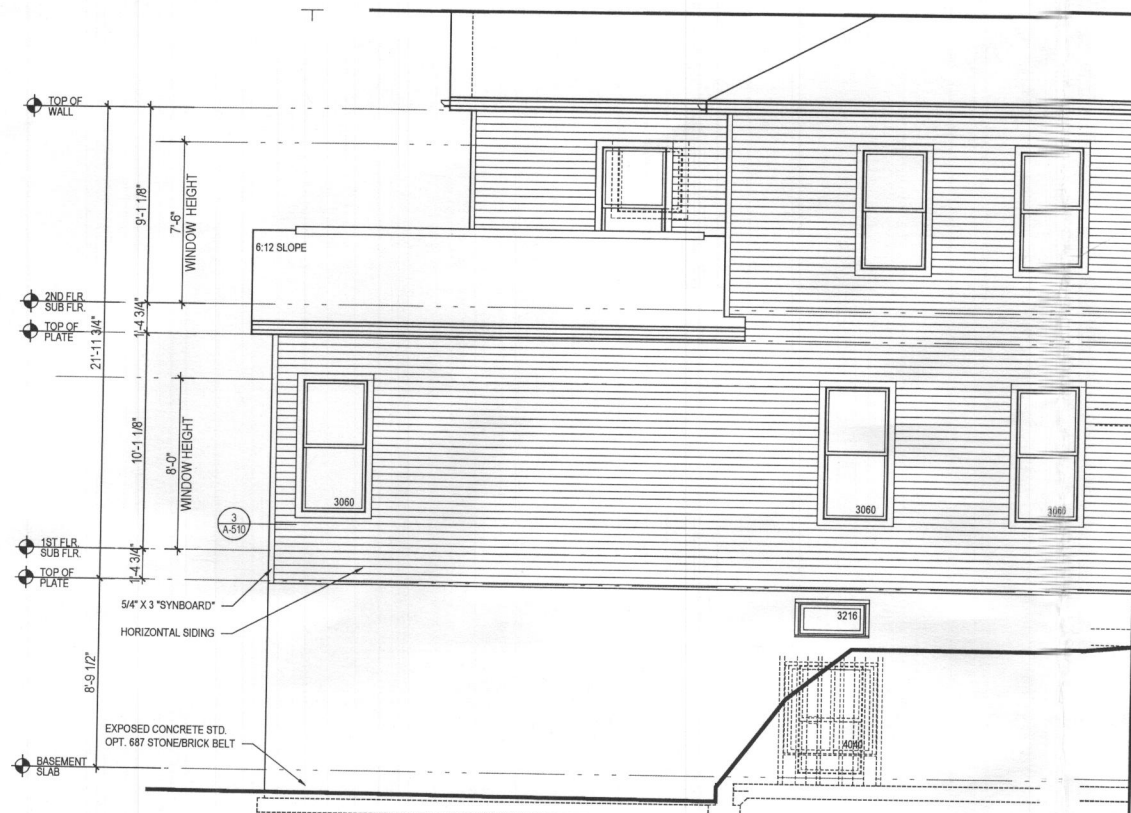


5 PART. LEFT ELEV.
A-407 SCALE: 1/4"=1'-0"
TOLUBIA, A&B DWG

w/ OPT. 263073 MULTI-GEN. SUITE
w/ COVD OUTDOOR LIVING @ WALKOUT CONDITION

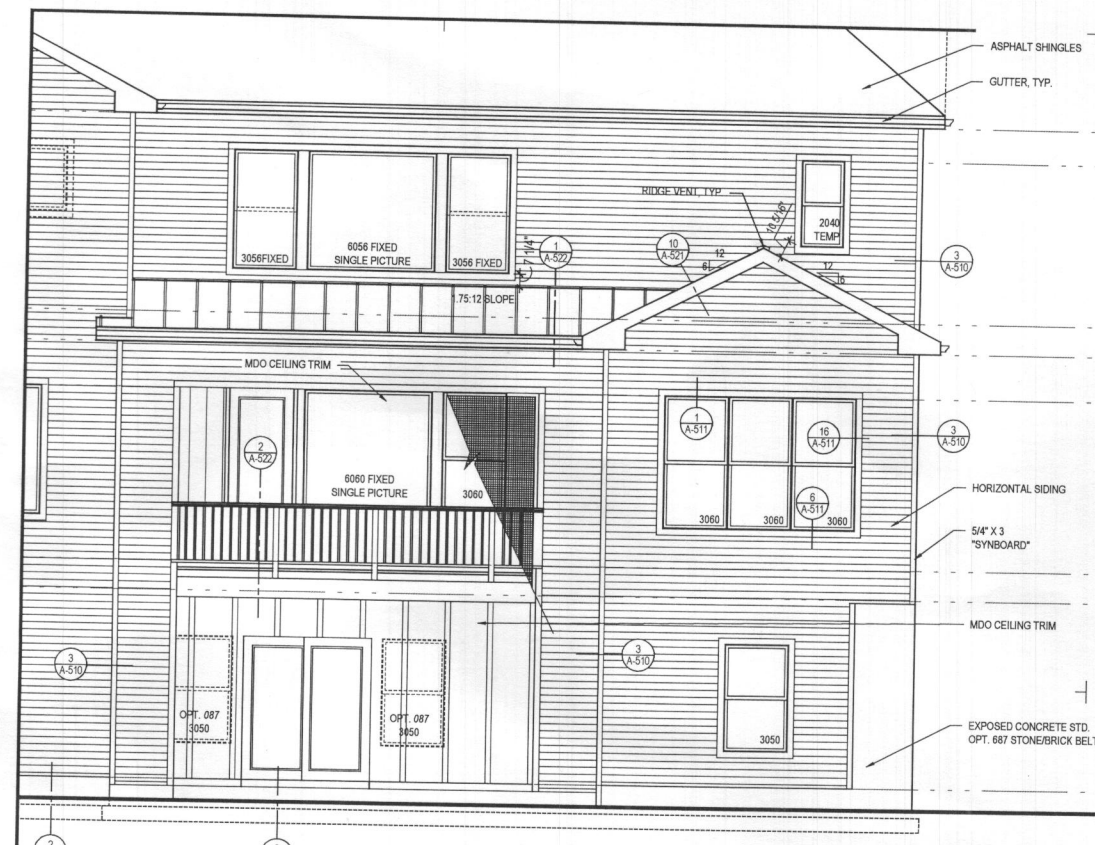


4 REAR ELEVATION
A-407 SCALE: 1/4"=1'-0"
TOLUBIA, A&B DWG

w/ OPT. 263073 MULTI-GEN. SUITE
w/ COVD OUTDOOR LIVING @ WALKOUT CONDITION

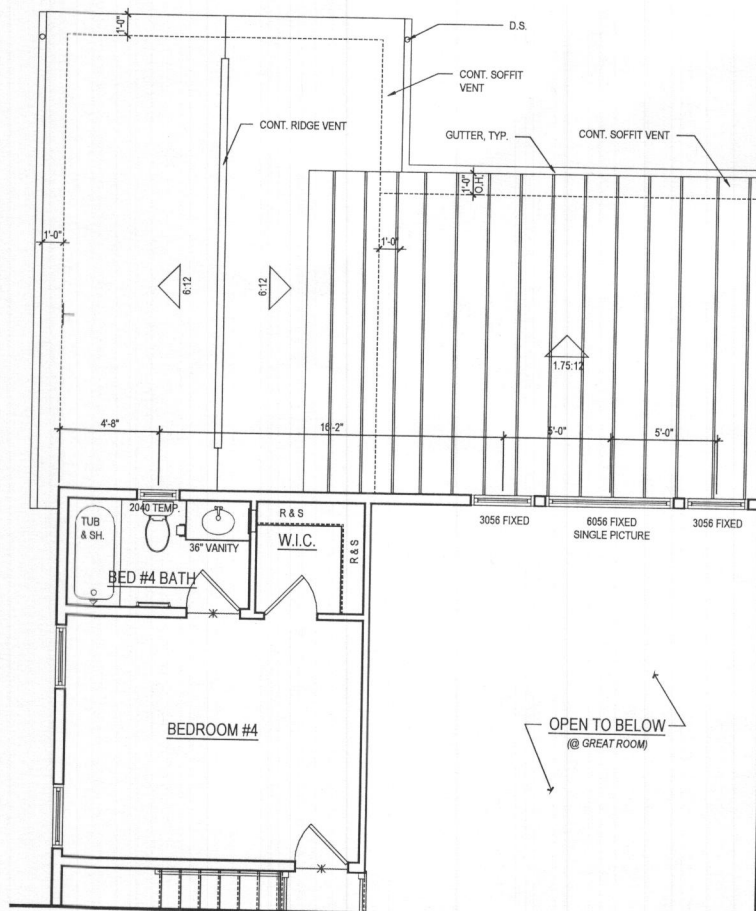


3 PART. SECOND FLOOR PLAN
A-407 SCALE: 1/4"=1'-0"
TOLUBIA, A&B DWG

w/ OPT. 263073 MULTI-GEN. SUITE
w/ COVD OUTDOOR LIVING @ WALKOUT CONDITION

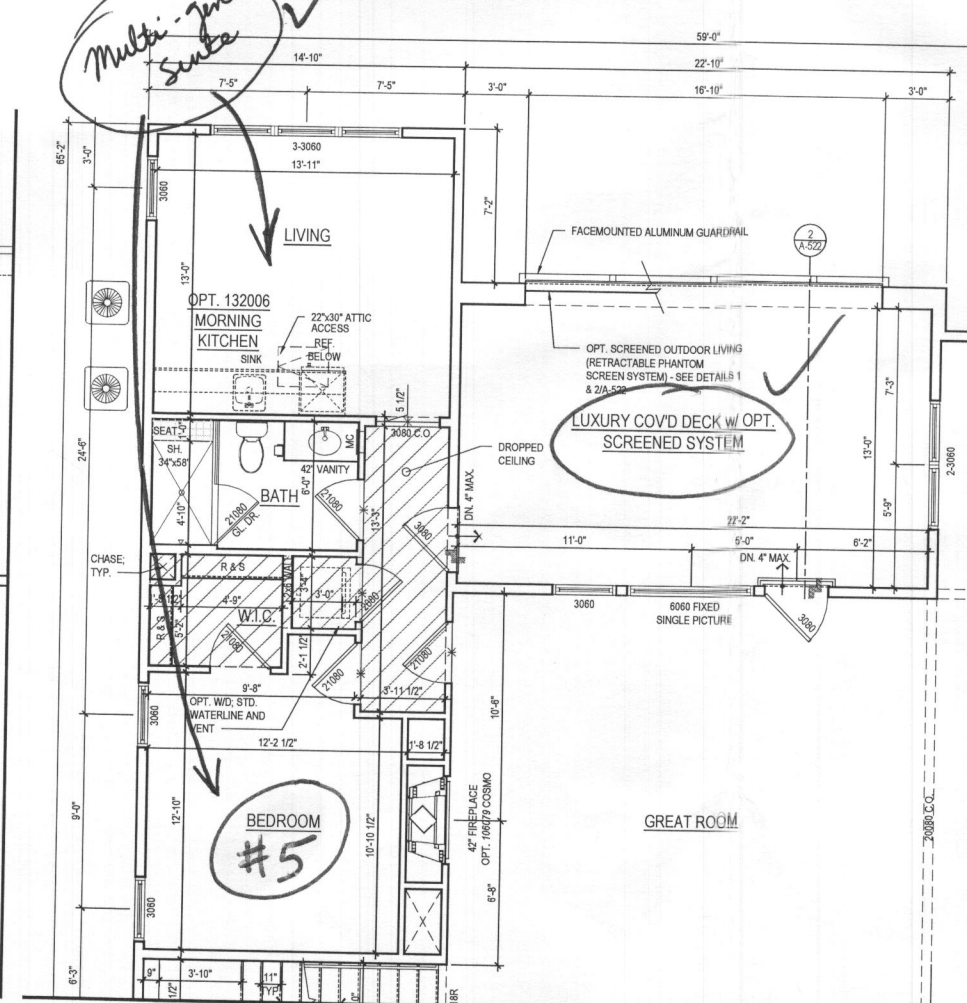

2 PART. FIRST FLOOR PLAN
A-407 SCALE: 1/4"=1'-0"
TOLUBIA, A&B DWG


w/ OPT. 263073 MULTI-GEN. SUITE
w/ COVD OUTDOOR LIVING @ WALKOUT CONDITION

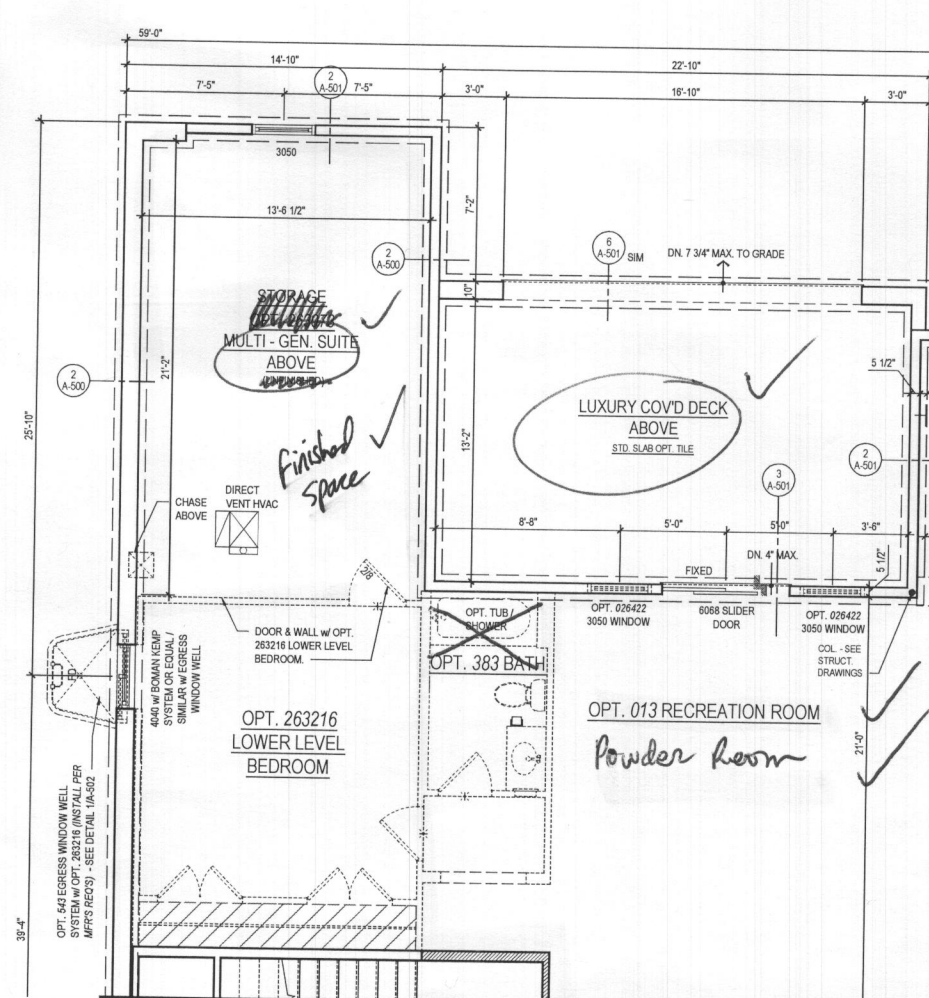

1 PART. BASEMENT PLAN
A-407 SCALE: 1/4"=1'-0"
TOLUBIA, A&B DWG

w/ OPT. 263073 MULTI-GEN. SUITE
w/ COVD OUTDOOR LIVING @ WALKOUT CONDITION

ARCHITECT:

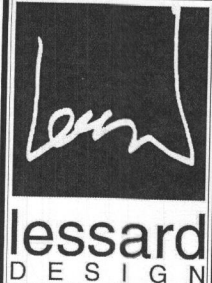

8521 Leesburg Pike
Suite 700 | Vienna, VA 22182
P: 571.830.1800 | F: 571.830.1801
www.lessarddesign.com

SEAL & SIGNATURE:

OWNER:

TOLL BROTHERS

19775 BELMONT EXECUTIVE PLAZA
ASHBURN, VA 20147
P: 571.291.8068
CONTACT: CHRISTINA LEMLEY
clmley@tollbrothers.com



PROJECT NAME:

SHEET TITLE:

ISSUE / REVISION

NO.	DESCRIPTION	DATE
1	BID SET	05.29.19
2	PERMIT SET	06.19.19
3	1 MD NEW STANDARDS	09.16.19
4	2 MR #220241	12.11.20

PROJECT NO:

DRAWN BY:

CHECKED BY:

PLOT DATE:


FILE NAME:

A-407

MARYLAND
PARKHURST
OPTIONS

GENERAL PLAN NOTES


- A. ALL WOOD STUD PARTITIONS NOT DIMENSIONED ARE TO BE 3 1/2" FOR INTERIOR AND 5 1/2" FOR EXTERIOR WALLS UNLESS OTHERWISE NOTED.
- B. ALL INTERIOR DIMENSIONS ARE TO FACE OF STUDS.
- C. ALL EXTERIOR DIMENSIONS ARE TO FACE OF STUDS.
- D. ALL DIMENSIONS GOVERN OVER SCALE.
- E. ALL SMOKE DETECTORS ARE TO BE WIRED IN SUCH A MANNER THAT ACTIVATION OF ONE WILL ACTIVATE THEM ALL.
- F. ENCLOSED ACCESSIBLE SPACE UNDER STAIRS SHALL HAVE WALLS AND SOFFITS PROTECTED ON ENCLOSED SIDE WITH 1/2" GYPSUM BOARD.
- G. ALL WINDOWS SIZE ARE NOTED IN FEET + INCHES AS MEASURED FROM SASH TO SASH.
- H. REFER TO ELEVATIONS FOR WINDOW HEAD HEIGHTS.
- I. ALL DOORS ARE TO BE 6'-8" HIGH UNLESS OTHERWISE NOTED.
- J. WASHER ALWAYS TO BE ON LEFT SIDE OF DRYER.
- K. DISHWASHER ALWAYS TO BE ON RIGHT SIDE OF SINK.

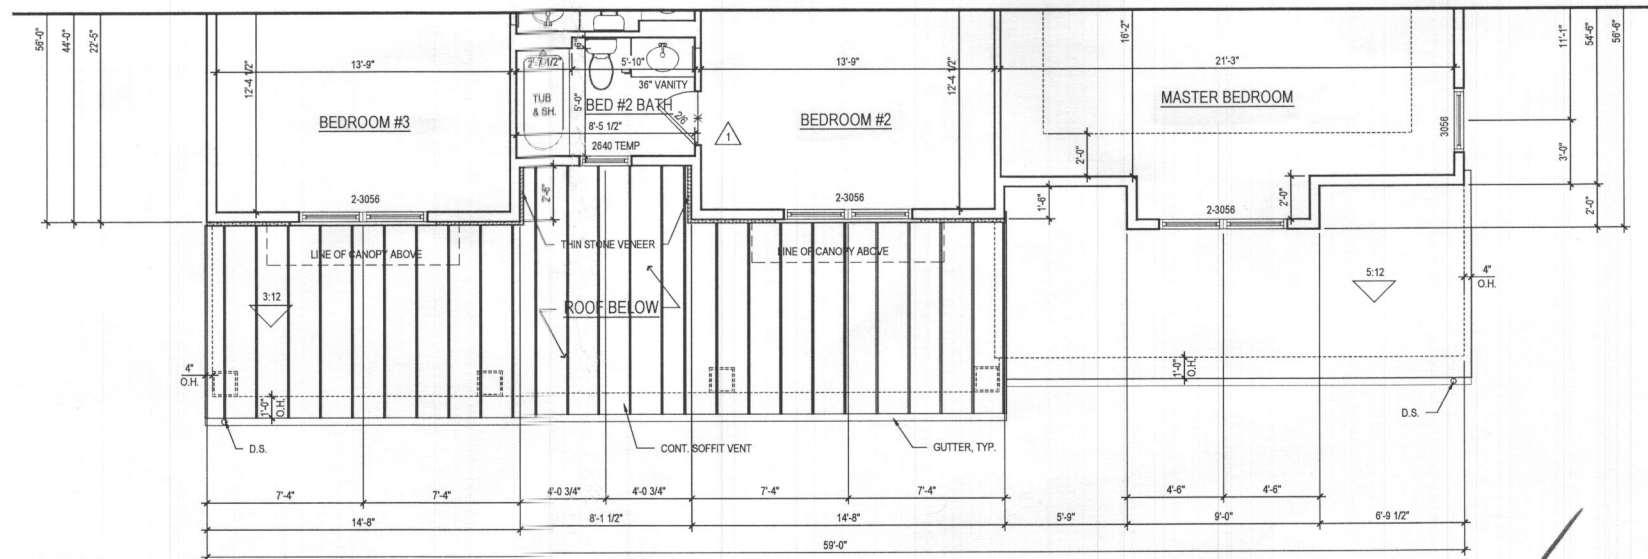

1 SECOND FLOOR PLAN
A-141 SCALE: 1/4"=1'-0"
TOL081a_A141.dwg

@ ELEV. 2 - MODERN FARMHOUSE

ARCHITECT:

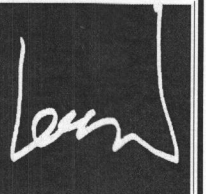

lessard
DESIGN

8521 Leesburg Pike
Suite 700 | Vienna, VA 22182
P: 571.830.1800 | F: 571.830.1801
www.lessarddesign.com

SEAL & SIGNATURE:

OWNER:

TOLL BROTHERS

19775 BELMONT EXECUTIVE PLAZA
ASHBURN, VA 20147
P: 571.291.8068
CONTACT: CHRISTINA LEMLEY
clemley@tollbrothers.com

PROJECT NAME:

MARYLAND

PARKHURST
FLOOR PLANS

SHEET TITLE:

ISSUE / REVISION		
NO.	DESCRIPTION	DATE
BID SET		05.29.19
PERMIT SET		06.19.19
1	MD NEW STANDARD	09.16.19
2	MR #220241	12.11.20

PROJECT No: TOL081a
DRAWN BY: AL/RN
CHECKED BY: AP
PLOT DATE: Jan. 20, 2021
FILE NAME: TOL081a_A141.dwg

A-141