

# APPLICATION

PERCOLATION TESTING

\$ 10.00 FEE

HOWARD COUNTY HEALTH DEPARTMENT  
BUREAU OF ENVIRONMENTAL HEALTH  
P.O. BOX 476 ELLICOTT CITY, MARYLAND 21043  
TELEPHONE: 461-9933

REPAIR

A ES Repair

P 43804

DISTRICT 4TH

DATE 3-15-89

TO: THE COUNTY HEALTH OFFICER  
ELLICOTT CITY, MARYLAND

I HEREBY, APPLY FOR THE NECESSARY TEST IN ORDER TO CONSTRUCT (OR RECONSTRUCT) A SEWAGE DISPOSAL SYSTEM.

PROPERTY OWNER RICHARD HUDSON

ADDRESS 13801 FORSYTHE ROAD PHONE 442-2279

PROSPECTIVE BUYER - N/A

ADDRESS - PHONE -

PROPERTY LOCATION:

SUBDIVISION HUDSON PROPERTY LOT NO. 1

ROAD AND DESCRIPTION SOUTH SIDE OF FORSYTHE ROAD - APPROX 4500 FEET WEST OF UNDERWOOD ROAD

TAX MAP 9 PARCEL # 162

SIZE OF LOT 3 ACRES ± TYPE BLDG. (EXISTING) SINGLE FAMILY  
(SINGLE FAMILY DWELLING OR COMMERCIAL)

THE SYSTEM INSTALLED UNDER THIS APPLICATION IS ACCEPTABLE ONLY UNTIL PUBLIC FACILITIES BECOME AVAILABLE. I FULLY UNDERSTAND THE FEE CONNECTED WITH THE FILING OF THIS PERC TEST APPLICATION IS NON-REFUNDABLE UNDER ANY CIRCUMSTANCES. I ALSO AGREE TO COMPLY WITH ALL M.O.S.H.A. REQUIREMENTS IN TESTING THIS LOT.

Richard C. Hudson  
(SIGNATURE OF APPLICANT)

APPROVED BY \_\_\_\_\_ FOR \_\_\_\_\_ DATE \_\_\_\_\_

REJECTED BY \_\_\_\_\_ FOR \_\_\_\_\_ DATE \_\_\_\_\_

HOLD PENDING FURTHER TESTS \_\_\_\_\_ DATE \_\_\_\_\_

REASONS FOR REJECTION OR HOLDING HOLD FOR CERTIFIED PLAT

## THIS IS NOT A PERMIT


Lot 1  
43804

Lot 2 ↑

appears to be lot 2 on map

SOIL PROFILE

6' Topsoil  
reddish  
brown top  
clay loam  
1 1/2' med brn to  
rock } yellow  
vein } sandy  
7' silt  
100m  
15-20%  
frags

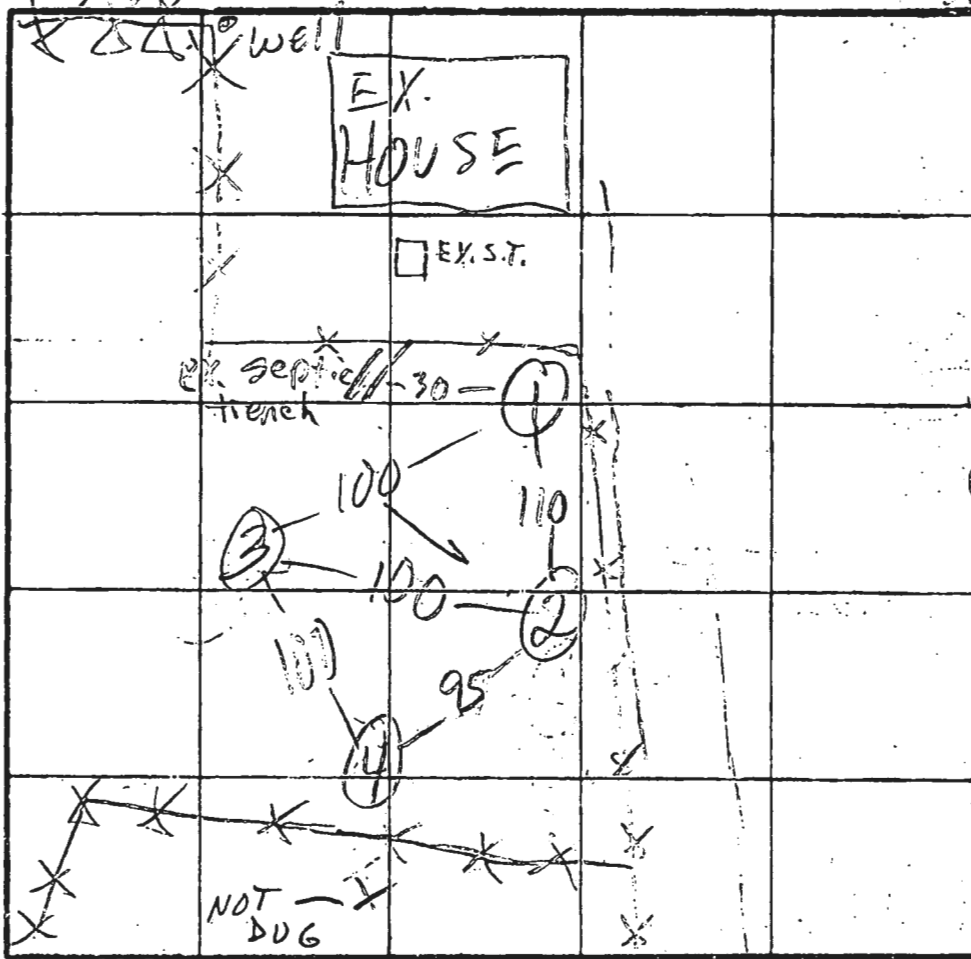

① ③ H  
④ MED  
② LO  
Z=10  
210 PRR  
Inlet 3 1/2  
Bottom 5

FORSYTHE RD INDICATE NORTH - NAME ADJOINING ROADWAY AS BASE LINE.

DATE	TEST NO.	DEPTH	PRE-WET		TEST - 1' DROP		TIME
			START	STOP	START	STOP	
4/13/89	1 S	3 1/2	3:58	4:03	4:03	4:12	9
	1 V	1 1/2	see profile				
	2 S	4	4:07	4:14	4:14	4:28	14
	2 V	12	clay to 3' 5-10% frags sim 10/10				
	3 S	3	4:07	4:10	4:10	4:17	7
	3 V	1 1/2	rock 5-10' clay to 3'				
	4	10	LOOKS OK				

REMARKS

HOLE ①-③ DUG PER PLAT

TYPE OF SOIL

M. Rifkin

TESTED BY

ALSO PRESENT

Pat, Surveyor

RIELY

443 605 3814

REALTOR - EXECUTIVE

CHRIS LUECKING

410 746 2042



CAD Drawing File Name: