


(A)
Red Org
Clay
Org/Tan
Clay Sa
Tan Org
Clay S/Loc

(B)
Typical
Org Brown
Cl S/Loc
Orange Tan
Cl S/Loc
250x

(C)
Red Brown
Gr Sel
stick
yel-brn
& brn
vgr sel
sticky
brn
vgr s
clay coatings
45% gravel
stone
more rock
in west end

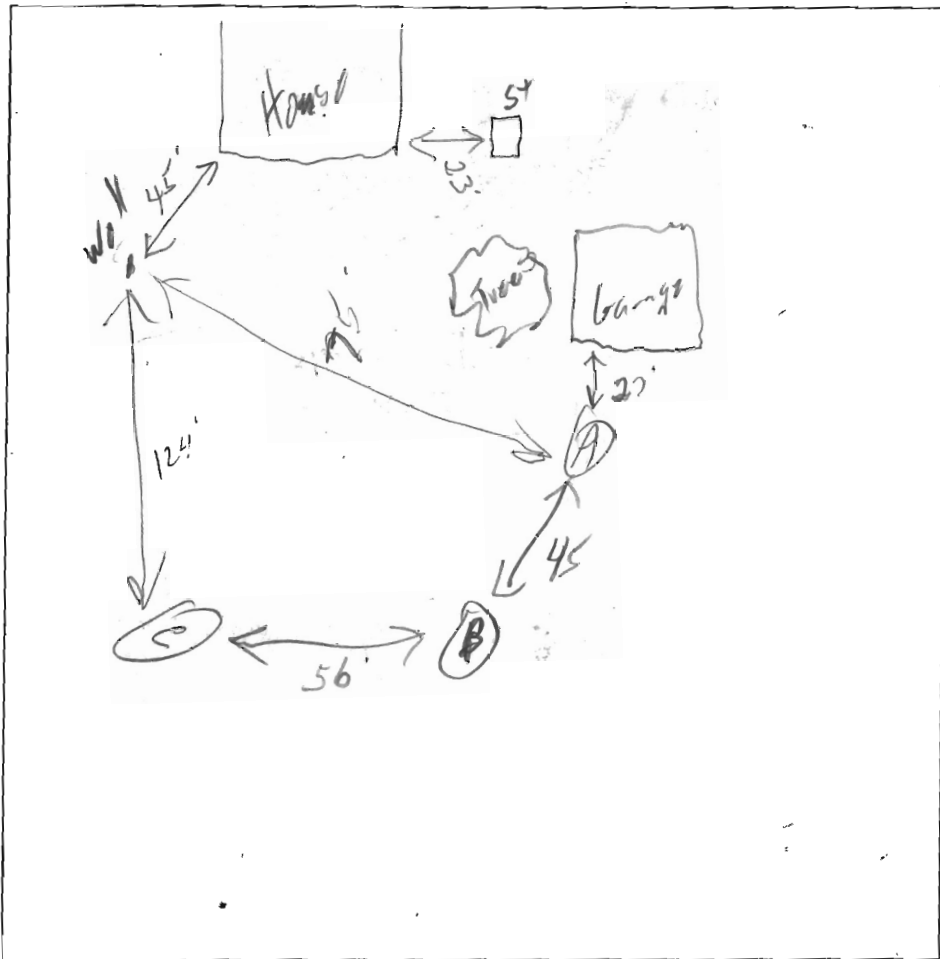

DATE	TEST #	DEPTH	START	BREAK 1" DROP	STOP 2" DROP	TIME OF 2ND INCH	P/F/H
8/11/08	A	8' 12	11:15	11:26	12:01	35	
	B	7.5' 14	12:01	12:04	12:02	2	
		Refuse		12:04	12:06	2	
	C	7' 13	1:21	1:25	1:31	6	

REMARKS

SANITARIAN SED BACKHOE Brace OTHERS Mike, Paul
 TEST HOLES USED IN SDA ABC AVG. PERC TIME 14 SQ. FT/BR 0.8
 TRENCH WIDTH 2 INLET DEPTH 4 MAX. BOT DEPTH 5 EFFECTIVE SW 2.5