

PUB. SEWER STATUS VERIFIED BY _____

ISSUE DATE: 08/06/08

APPROVAL DATE: 10/1/08

PERMIT

Tax ID # 06-411193

P NO FEE 47125

A REPAIR

ON-SITE SEWAGE DISPOSAL SYSTEM HOWARD COUNTY HEALTH DEPARTMENT BUREAU OF ENVIRONMENTAL HEALTH

Hatfield's to do

Howard Co Maryland-Dept of Recreation & Parks IS PERMITTED TO INSTALL ☐ ALTER ☒

ADDRESS: 3430 Courthouse Dr, Ellicott City MD 21043 PHONE NUMBER: _____

SUBDIVISION: _____ LOT NUMBER: _____

ADDRESS: 9275 Vollmerhausen Road PROPERTY OWNER: Recreation and Parks

SEPTIC TANK CAPACITY (GALLONS): New 1500 2 comp Top Seams

PUMP CHAMBER CAPACITY (GALLONS): N/A Min 75' from well

NUMBER OF BEDROOMS: 3

SQUARE FEET PER BEDROOM: 08

LINEAR FEET OF TRENCH REQUIRED: 135

TRENCHES:	<u>(2) 60' trenches on contour</u> <u>(1) 6' edge to edge</u>
LOCATION:	<u>D.B. location painted on ground</u> <u>Inset 4' Bottom 8' 2' wide</u>
ADDITIONAL NOTES:	<u>Call in for layout inspection</u> <u>Abandon old ST & DW?</u>

PLANS APPROVED: Stan. Ester DATE: 8/11/08

NOTE: PERMIT VOID AFTER 2 YEARS


NOTE: CONTRACTOR RESPONSIBLE FOR SCHEDULING A PRE-CONSTRUCTION INSPECTION FOR ALL INSTALLATIONS

NOTE: WATERTIGHT SEPTIC TANKS REQUIRED

NOTE: ALL PARTS OF SEPTIC SYSTEM SHALL BE 100 FEET FROM ANY WATER WELL

NOTE: MANHOLE RISERS REQUIRED ON ALL SEPTIC TANKS AND PUMP CHAMBERS

NEITHER THE HOWARD COUNTY COUNCIL OR THE HEALTH DEPARTMENT IS
RESPONSIBLE FOR THE SUCCESSFUL OPERATION OF ANY SYSTEM
PERMITTEE RESPONSIBLE FOR OBTAINING FINAL APPROVAL ON THIS PERMIT
CALL 410-313-2640 FOR INSPECTION OF SEPTIC SYSTEM

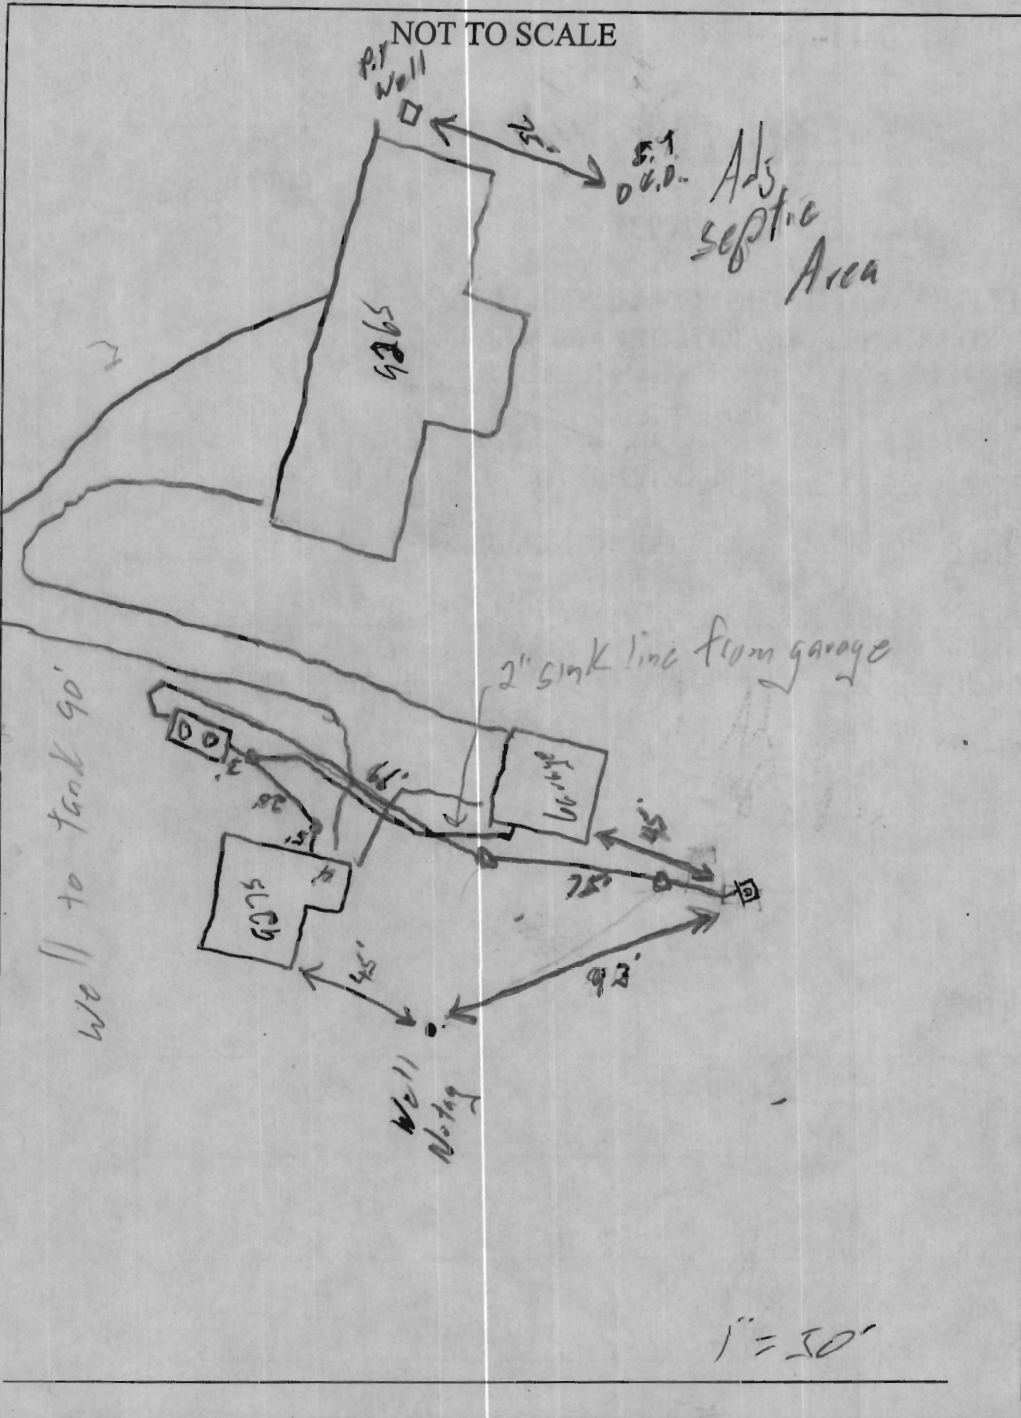

TRENCH/DRAINFIELD DATA

WIDTH	INLET	BOTTOM
2'	4'	8'

NUMBER OF TRENCHES 3

TOTAL LENGTH 188'

ABSORPTION AREA

DISTRIBUTION BOX LEVEL Levelers

DISTRIBUTION BOX BAFFLE Yes

DISTRIBUTION BOX PORT Yes

SEPTIC TANK DATA

SEPTIC TANK 1 LEVEL

MANUFACTURER Bolyer

CAPACITY 1500 GAL

SEAM LOC TOP

TANK LID DEPTH 1-1.5'

BAFFLES

BAFFLE FILTER

MANHOLE LOC F&B

6" PORT LOC

WATERTIGHT TEST

SLOTTED

PUMP/SEPTIC TANK LEVEL

MANUFACTURER

CAPACITY GAL

SEAM LOC

TANK LID DEPTH

BAFFLES

BAFFLE FILTER

MANHOLE LOC

6" PORT LOC

WATERTIGHT TEST

SLOTTED

PRE-CONSTRUCTION

9/29/08 - Large tree next to house has been removed. May be able to make DP by

quality. New tank s.t. may only be 18' from house to keep it away from the driveway. Shot elevation w/ Jett & marked on the ground OK to proceed (SO)

INSTALLATION

9/30/08 Old Metal tank & D.W. abandoned. New S.T. set. Found 3" sink line coming from garage. Installed up to DB, OK to cover (SO) 10/1/08 System finished. O.K. to backfill. Dirt from trenches was mostly clay. (RB)

FINAL INSPECTOR


S. Oster/B. Baker

DATE OF APPROVAL

10/1/08

10/1/08
(BB)

Keep With
File

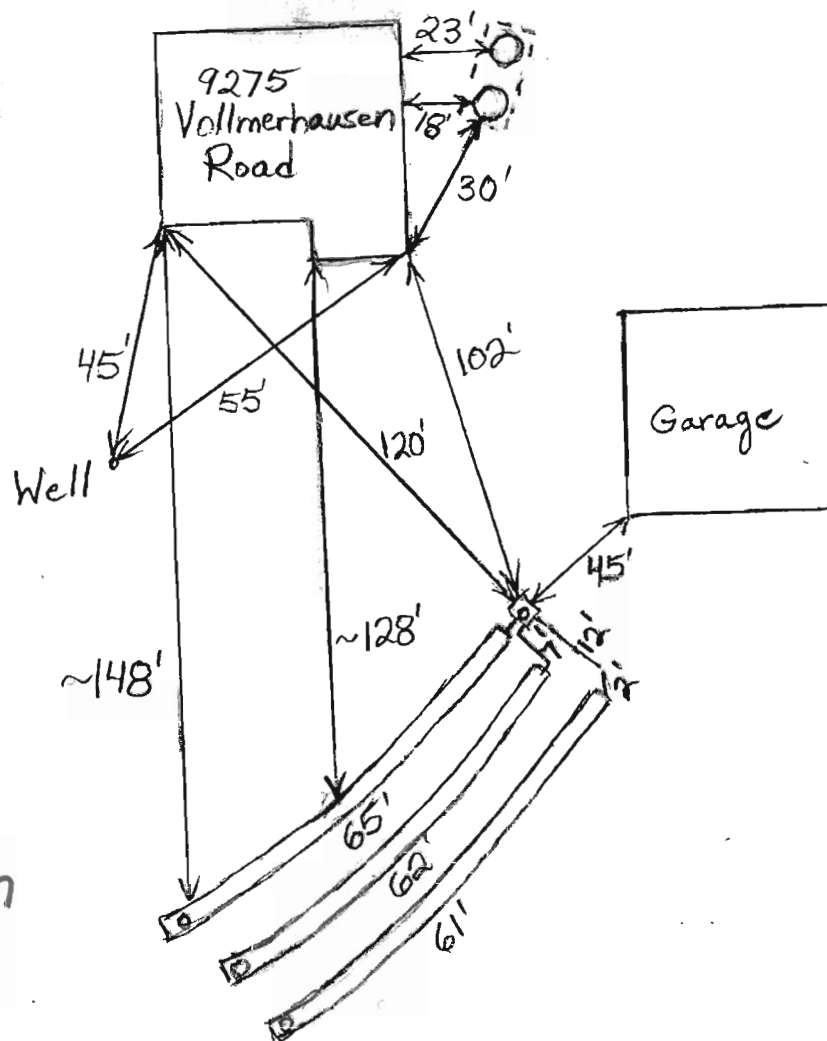

4/28/91 AM Attn: Payl Nalsky

PERMIT

SEWAGE DISPOSAL SYSTEM

DEPARTMENT OF HEALTH AND MENTAL HYGIENE

HOWARD COUNTY HEALTH DEPARTMENT

BUREAU OF ENVIRONMENTAL HEALTH

461-9933

#411193
INDEXED

File
Please scan

① P.C.O.
② P.C.O. 4/18

P 47125

A REPAIR

DISTRICT

DATE 5/20/91

DATE SYSTEM APPROVED 4/18/91

INSPECTOR C.B. d

Jack Fyock

IS PERMITTED TO INSTALL _____ ALTER ☒ X

ADDRESS 13775 Triadelphia Road, Glenelg, Maryland 21737 PHONE 988-9270

SUBDIVISION _____ LOT _____ ROAD 9275 Vollmerhausen Drive

PROPERTY OWNER _____ Lash

ADDRESS _____

SEPTIC TANK CAPACITY 325 GALLONS

OF BEDROOMS 3

FEET PER BEDROOM

14' 325 absorbant sidewalk and
(plus old dry well)

GROUND IS OPENED SO SANITARIAN CAN RECOMMEND