

APPLICATION

SEWAGE DISPOSAL TESTING

A 09119

P

MARYLAND STATE DEPARTMENT OF HEALTH

HOWARD COUNTY *750 Gallon Tank*

ELLICOTT CITY

DISTRICT 3

DATE 9/21/64

*Dry Well - 300 sq ft sidewall area
below the inlet*

*Place the dry well 100 ft to 120 ft from the edge
of the dirt driveway where the dirt driveway runs
parallel to Folly Quarter Rd. and 190 ft to 210
ft. from the edge of the dirt driveway where the dirt*

TO: THE COUNTY HEALTH OFFICER

ELLICOTT CITY, MARYLAND

*driveway runs perpendicular to
Folly Quarter Rd*

I, HEREBY, APPLY FOR THE NECESSARY TESTS IN ORDER TO CONSTRUCT (OR RECONSTRUCT) A SEWAGE DISPOSAL SYSTEM.

PROPERTY OWNER Cora B. Gallion

ADDRESS Glencol, Maryland

PHONE AT 6-2565

PROPERTY LOCATION:

SUBDIVISION

LOT NO.

ROAD AND DESCRIPTION

Folly Quarter Road

Between Glencol country school

*8 ft. sidewalk across E. Folly Quarter Rd from a by a sidewalk
and a pond*

OCCUPANT

PHONE

PERSON TO CONSTRUCT SYSTEM

ADDRESS

PHONE

SIZE OF LOT 3 acres

TYPE BLDG.

NUMBER OF BEDROOMS 3

IF NOT SINGLE RESIDENCE DESCRIBE

Status a share.

SIGNATURE OF APPLICANT

APPROVED BY *Raymond Hodge*

FOR *Dry Well*

(KIND OF SYSTEM)

DATE 22 Sept 64

REJECTED BY

FOR

(KIND OF SYSTEM)

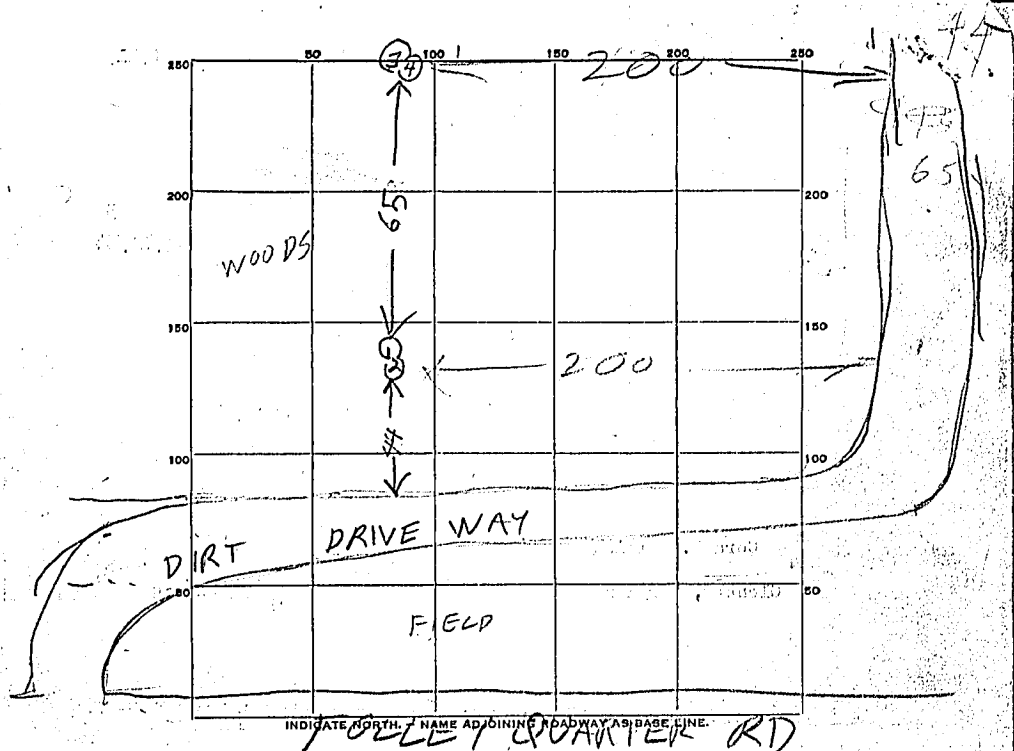
DATE

HOLD PENDING FURTHER TESTS

DATE

REASONS FOR REJECTION OR HOLDING

THIS IS NOT A PERMIT

[illegible]

SOIL AUGER FINDING.

TESTED BY

REMARKS.

ALSO PRESENT

LOT NO