

*3/17/65
after 1 p.m.
3/24/65 approved B/H*

PERMIT

SEWAGE DISPOSAL SYSTEM

MARYLAND STATE DEPARTMENT OF HEALTH

HOWARD COUNTY

ELLICOTT CITY

DISTRICT 3

DATE 3/17/65

INDEXED

Walter A. Shank

IS PERMITTED TO INSTALL ☒ ALTER

ADDRESS Simpsonville, Maryland

PHONE HO 5-4123

A SEWAGE DISPOSAL SYSTEM LOCATED AT _____

SUBDIVISION _____

ROAD Folly Quarter Rd.

LOT _____

PROPERTY OWNER Cora B. Gallion

ADDRESS _____

SPECIFICATIONS - 3 bedrooms

DRAIN FIELD _____ DEPTH _____ FEET, BOTTOM AREA _____ SQ. FT.

SEEPAGE PITS _____ ABSORBENT SIDE-WALL AREA _____ SQ. FT.

SEPTIC TANK CAPACITY 750 GALLONS

FOR GARBAGE GRINDER, INCREASE DISPOSAL AREA 22% & TANK CAPACITY 50%.

OTHER Dry well - 300 sq. ft. side wall area below the inlet.

Place the dry well 100 ft. to 120 ft. from the edge of the dirt driveway where the dirt driveway runs parallel to Folly Quarter Rd. and 190 ft. to 210 ft. from the edge of the dirt driveway where the dirt driveway runs perpendicular to Folly Quarter Rd.

Well permit # HO-65-W-342


PLANS APPROVED BY Raymond Hodges

DATE 9/22/64

FILL SEPTIC TANK AND DISTRIBUTION BOX WITH WATER BEFORE CALLING FOR AN INSPECTION. COVER NO WORK UNTIL INSPECTED AND APPROVED.

NEITHER THE HOWARD COUNTY COMMISSIONERS NOR THE HEALTH DEPARTMENT IS RESPONSIBLE FOR THE SUCCESSFUL OPERATION OF ANY SYSTEM.

67169

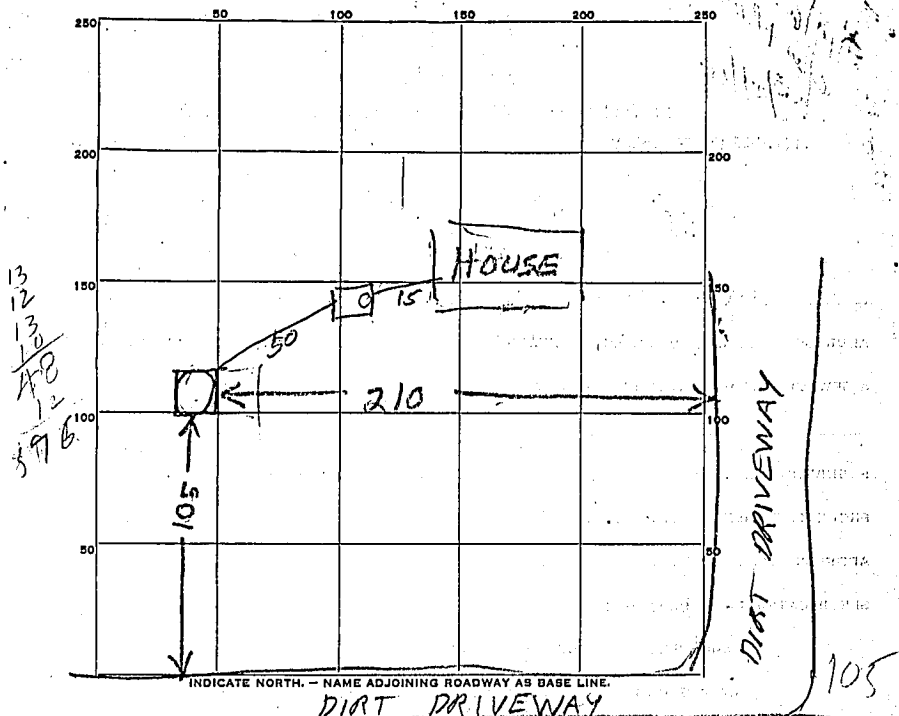

PERMIT CARD

SEPTIC TANK, LEVEL OK concrete 750

CLEANOUTS OK

DISTRIBUTION BOX, LEVEL

TILE FIELD, DEPTH _____ FT. TRENCH WIDTH _____ FT.

GRAVEL DEPTH _____ IN. TOTAL LENGTH _____ FT.

NUMBER OF TRENCHES _____ TOTAL BOTTOM AREA _____

SEEPAGE PITS, INSIDE DIAMETER 9 1/2 FT. DEPTH BELOW INLET 12 FT.

ABSORBENT AREA 576 SQ. FT. counting stone

17 MAR 65
REMARKS

Dry Well is 12 ft deep below top
My well inlet not installed. Only part of gravel installed R/V
I install pipes & gravel & Dry well Cleanouts & call for reinspection
24 MAR 65 - Dry Well Inlet is 3 FT below the top Approx perimeter
is 48 48 x 12 = 576 sq ft counting stone
Water well not seen

DATE SYSTEM APPROVED

24 MAR 65

INSPECTOR

Raymond Hodges

29
12
306