

Plot # 7001
 Folio 33
 Liber under Judith Robert
 property

DEPT. OF INSPECTIONS, LICENSES AND PERMITS 3400 COURT HOUSE DRIVE ELLICOTT CITY, MD 21043 PERMITS (410) 313-2455 INSPECTIONS (410) 313-1810 AUTOMATED INFORMATION (410) 313-3800		HOWARD COUNTY PERMIT APPLICATION		08002796 PERMIT NUMBER	
Building Address <u>6410 WATERLOO ROAD</u> <u>Columbia, MD 21045</u>		Property Owner's Name <u>PAT DOYLE</u> Address <u>3424 ALEAIDA DRIVE</u> City <u>ELICOTT CITY</u> State <u>MD</u> Zip Code <u>21042</u> Phone <u>443 286 6135</u>		Suite/Apt. #: _____ SDP/WP/Petition #: _____ Census Tract _____ Subdivision <u>Long Reach</u> Section _____ Area _____ Lot <u>57</u> Tax Map _____ Parcel _____ Grid _____ Zoning _____ Map Coordinates _____ Lot Size _____	
Existing Use _____ Proposed Use _____ Estimated Construction Cost \$ _____ Description of Work _____ Occupant or Tenant _____ Contact Name _____ Address _____ City _____ State _____ Zip Code _____ Phone _____ Fax _____		Contractor Company <u>Myers Home Improvement</u> Contact Person <u>Bill Myers</u> Address <u>8015 JETTA DRIVE</u> City <u>ELKridge</u> State <u>MD</u> Zip Code <u>21075</u> License No. <u>12002</u> Phone <u>301 919-2719</u> Fax _____ Engineer or Architect Company _____ Contact Person _____ Address _____ City _____ State _____ Zip Code _____ Phone _____ Fax _____		BUILDING DESCRIPTION - COMMERCIAL Building Characteristics Height: _____ No. of stories: <u>one</u> Gross area, sq. ft. per floor: _____ Use group: _____ Construction type: <input type="checkbox"/> Reinforced Concrete <input type="checkbox"/> Structural Steel <input type="checkbox"/> Masonry <input type="checkbox"/> Wood Frame <input type="checkbox"/> State Certified Modular Utilities Water Supply: _____ <input type="checkbox"/> Public <input type="checkbox"/> Private Sewage Disposal: <input type="checkbox"/> Public <input type="checkbox"/> Private Electric Yes <input type="checkbox"/> No <input type="checkbox"/> Gas Yes <input type="checkbox"/> No <input type="checkbox"/> Heating System: Electric <input type="checkbox"/> Oil <input type="checkbox"/> Natural Gas <input type="checkbox"/> Propane Gas <input type="checkbox"/> Sprinkler system: N/A <input type="checkbox"/> <input type="checkbox"/> Full <input type="checkbox"/> Partial <input type="checkbox"/> Other Suppression <input type="checkbox"/> # of Heads	
BUILDING DESCRIPTION - RESIDENTIAL Building Characteristics SF Dwelling <input checked="" type="checkbox"/> SF Townhouse <input type="checkbox"/> Depth <u>26</u> Width <u>31</u> 1 st floor: <u>X</u> Basement: <u>26</u> <u>31</u> Finished Basement <input checked="" type="checkbox"/> Unfinished Basement <input type="checkbox"/> Crawl space <input type="checkbox"/> Slab on Grade <input type="checkbox"/> No. of Bedrooms <u>TWO</u> Multi-family dwellings: No. of efficiency units: _____ No. of 1 BR units: _____ No. of 2 BR units: _____ No. of 3 BR units: _____ Other Structure: _____ Dimensions: _____ Footings: _____ Roof Height: _____ <input type="checkbox"/> State Certified Modular <input type="checkbox"/> Manufactured Home		Utilities Water Supply: _____ <input checked="" type="checkbox"/> Public <input type="checkbox"/> Private Sewage Disposal: <input type="checkbox"/> Public <input checked="" type="checkbox"/> Private Electric Yes <input checked="" type="checkbox"/> No <input type="checkbox"/> Gas Yes <input type="checkbox"/> No <input checked="" type="checkbox"/> Heating System: Electric <input checked="" type="checkbox"/> Oil <input type="checkbox"/> Natural Gas <input type="checkbox"/> Propane Gas <input type="checkbox"/> Sprinkler system: N/A <input checked="" type="checkbox"/> <input type="checkbox"/> NFPA #13D <input type="checkbox"/> NFPA #13R <input type="checkbox"/> Other:		THE UNDERSIGNED HEREBY CERTIFIES AND AGREES AS FOLLOWS: (1) THAT HE/SHE IS AUTHORIZED TO MAKE THIS APPLICATION; (2) THAT THE INFORMATION IS CORRECT; (3) THAT HE/SHE WILL COMPLY WITH ALL REGULATIONS OF HOWARD COUNTY WHICH ARE APPLICABLE THERETO; (4) THAT HE/SHE WILL PERFORM NO WORK ON THE ABOVE REFERENCED PROPERTY NOT SPECIFICALLY DESCRIBED IN THIS APPLICATION; (5) THAT HE/SHE GRANTS COUNTY OFFICIALS THE RIGHT TO ENTER ONTO THIS PROPERTY FOR THE PURPOSE OF INSPECTING THE WORK PERMITTED AND POSTING NOTICES Applicant's Signature <u>William Myers</u> Print Name <u>William Myers</u> Title/Company <u>owner Myers Home Improvement</u> Date <u>9-17-08</u>	
Checks payable to: DIRECTOR OF FINANCE OF HOWARD COUNTY **PLEASE WRITE NEATLY AND LEGIBLY.** - FOR OFFICE USE ONLY -					
AGENCY DATE SIGNATURE APPROVAL Land Development DPZ State Highways Building Officials Dev. Engineering DPZ Health Fire Protection Is Sediment Control approval required prior to issuance? YES <input type="checkbox"/> NO <input type="checkbox"/>		DPZ SETBACK INFORMATION Front: _____ Rear: _____ Side: _____ Side St. _____ All minimum setbacks met? YES <input type="checkbox"/> NO <input type="checkbox"/> Is Entrance Permit required? YES <input type="checkbox"/> NO <input type="checkbox"/> Historic District? YES <input type="checkbox"/> NO <input type="checkbox"/> Lot Coverage for New Town Zone SDP/Red-line approval date _____		PROPERTY ID # Filing fee \$ _____ Permit fee \$ _____ Excise tax \$ _____ Add'l per fee \$ _____ TOTAL FEES \$ _____ Sub-total paid \$ _____ Balance due \$ _____ Check # _____ Validation # _____	
CONTINGENCY CONSTRUCTION START: <input type="checkbox"/> ONE STOP SHOP: <input type="checkbox"/>		Accepted by _____		Distribution of Copies - White: Building Officials Green: LDB, DPZ Yellow: DEB, DPZ Pink: Health Gold: SHA T-forms/building permit application REV 10/28/04	

REQUIRED NOTES PER COMAR 09.1306

- 1) This plat is of benefit to a consumer only insofar as it is required by a lender or title insurance company or its agent in connection with contemplated transfer, financing or refinancing.
- 2) This plat is not to be relied upon for the establishment or location of fences, garages, buildings, or other existing or future improvements;
- 3) This plat does not provide for the accurate identification of property boundary lines, but such identification may not be required for the transfer of title or securing financing or refinancing.
- 4) The level of accuracy of apparent setback distances is within 3 feet +/-.

ADDITIONAL NOTES

- 1) The subject property falls in flood zone "C" as shown on the flood hazard boundary map 2400440035B dated 12/04/86.
- 2) This is not a boundary survey or lot stakeout. No title research furnished to or done by this office.
- 3) This plat shows the principal structure and significant structures (close to the apparent property lines) as required by Maryland law. However, additional internal structures may not be shown.
- 4) Fences shown as \times are approximate only. The exact location of fences and boundary lines can be accomplished with a boundary survey.
- 5) The licensee either personally prepared this drawing or was in responsible charge over its preparation and the surveying work reflected in it, all in compliance with requirements set forth in Regulation .12 of Chapter 06 Minimum Standards of Practice.
- 6) The source of data, bearings, and/or coordinates used on this drawing are based on the record plat or deed referenced: PLAT#7001

APPROVED

WALKTHRU BUILDING PERMIT

BP# APESAN HS DATE 9-18-08


DECK as shown

SEPTIC TANK
38'
OFF HOME
in line
with
corner

3/8 scale

Myers Home Improvement
8015 Joetta Drive
Elkridge, MD 21075

I hereby certify that the improvements shown hereon to the best of my professional knowledge and ability.

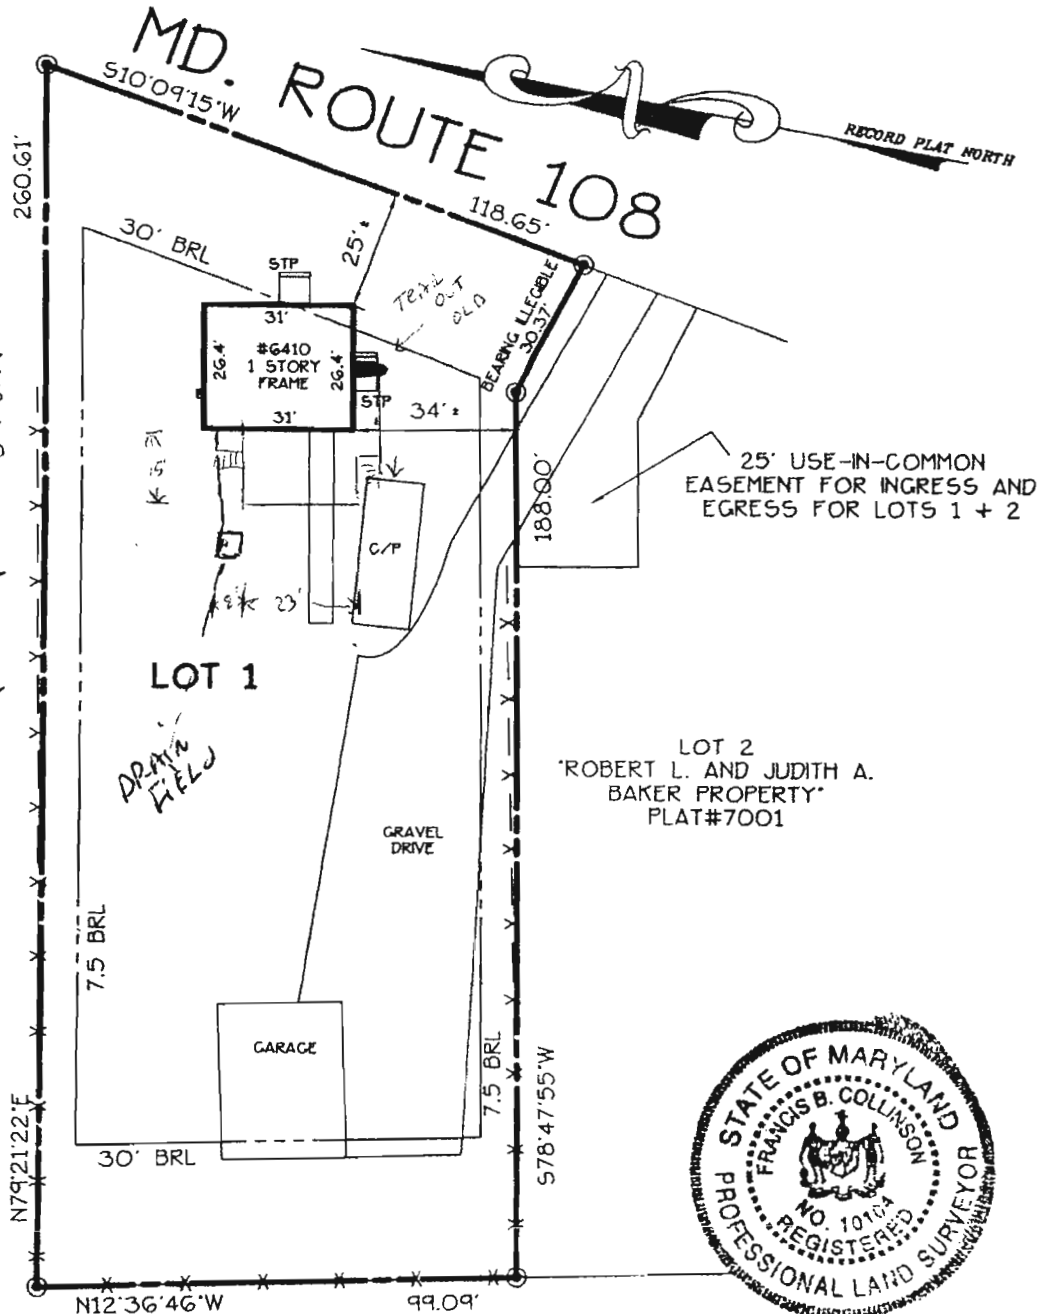

ATTENTION USER: SURVEY ORDER #147
BE ON FILE WITH ADVANCED SURVEYS
BEFORE THIS DOCUMENT CAN BE USED