

2-1/2' Lobs
4000 sq ft

APPLICATION

SEWAGE DISPOSAL TESTING

MARYLAND STATE DEPARTMENT OF HEALTH

HOWARD COUNTY

ELLICOTT CITY

DISTRICT

DATE

A 17440

P

52

11/5/72

TO: THE COUNTY HEALTH OFFICER
ELLICOTT CITY, MARYLAND

I, HEREBY, APPLY FOR THE NECESSARY TESTS IN ORDER TO CONSTRUCT (OR RECONSTRUCT) A SEWAGE DISPOSAL SYSTEM.

PROPERTY OWNER

ADDRESS

PHONE

PROPERTY LOCATION:

SUBDIVISION

LOT NO.

ROAD AND DESCRIPTION

OCCUPANT

PHONE

PERSON TO CONSTRUCT SYSTEM

ADDRESS

PHONE

SIZE OF LOT

TYPE BLDG.

NUMBER OF BEDROOMS

IF NOT SINGLE RESIDENCE DESCRIBE

SIGNATURE OF APPLICANT

APPROVED BY

FOR

(KIND OF SYSTEM)

DATE

REJECTED BY

FOR

(KIND OF SYSTEM)


DATE

HOLD PENDING FURTHER TESTS

DATE

REASONS FOR REJECTION OR HOLDING

THIS IS NOT A PERMIT

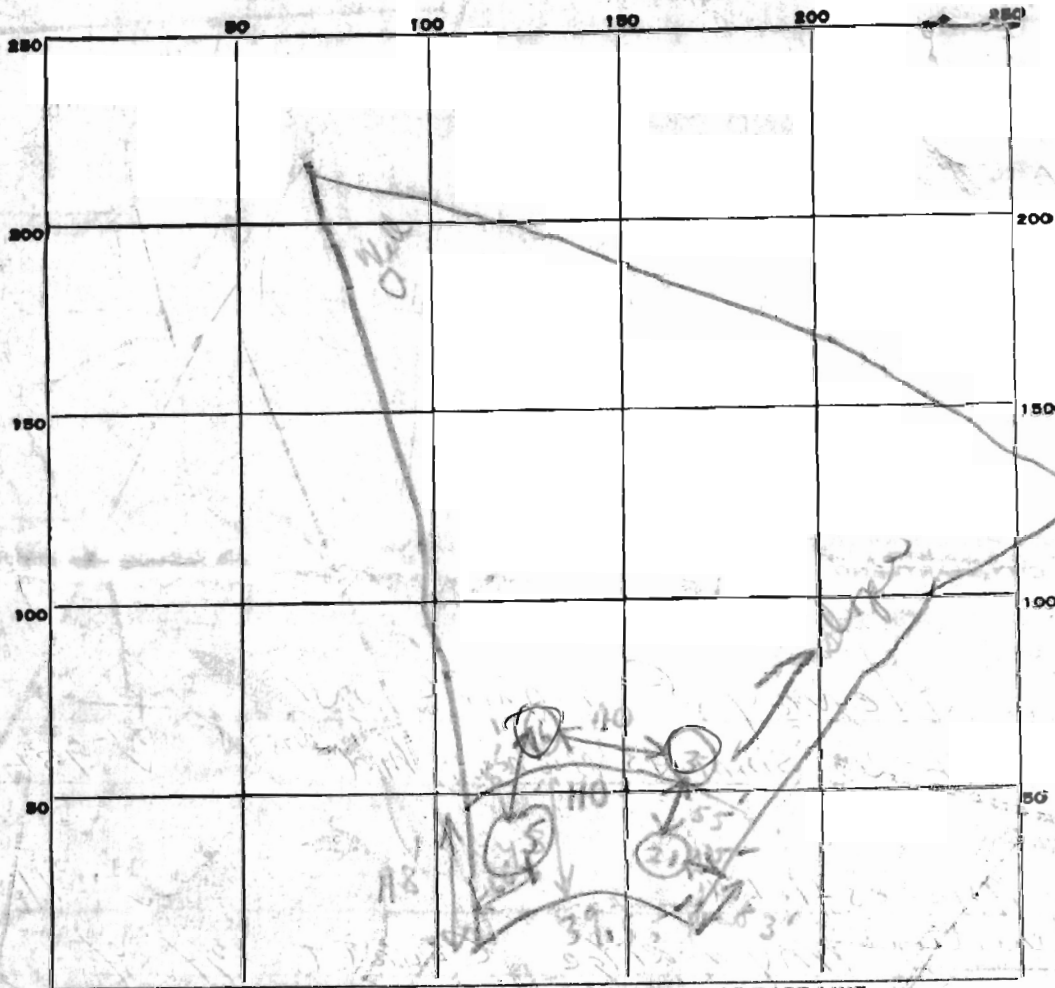

INDICATE NORTH. - NAME ADJOINING ROADWAY AS BASE LINE.


DATE	TEST NO.	DEPTH	PRE-WET		TEST - 1" DROP		TIME
			START	STOP	START	STOP	
11/1	1	4 1/2'	2:11	2:16	2:16	2:33	17 min
	2	12'	2:35	2:41	2:41	2:51	10 min
	(3)	2'	Water in hole				
	4	4 1/2'	2:52	2:54	2:54	2:57	3 min
	5	12'	3:00	3:05	3:05	3:10	5 min
	(6)	9'	Water in hole				

SOIL AUGER FINDING

TESTED BY

REMARKS

Test in high part of
H. Shuster Hold for super
No basement foundation

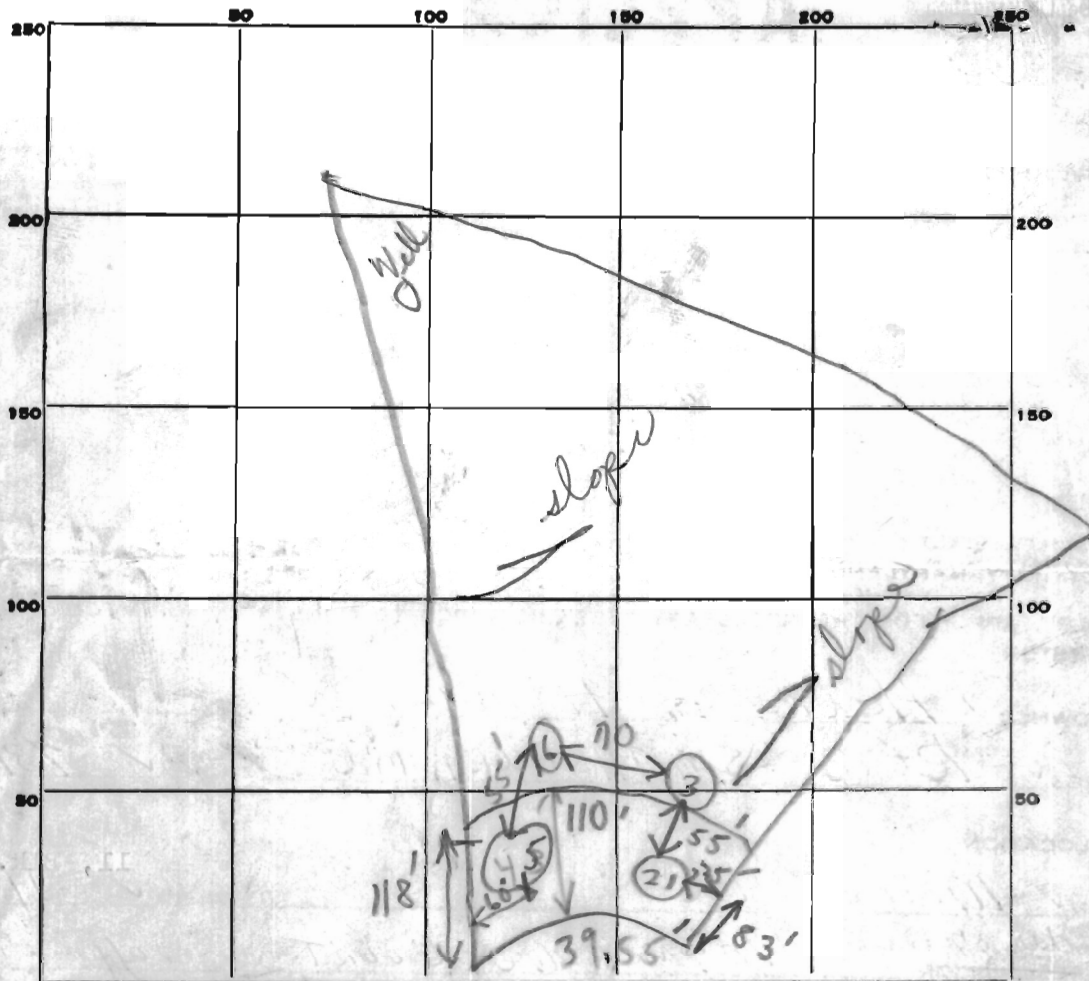

INDICATE NORTH. - NAME ADJOINING ROADWAY AS BASE LINE.

DATE	TEST NO.	DEPTH	PRE-WET		TEST - 1" DROP		TIME
			START	STOP	START	STOP	
7/24/2	1	4 1/2'	2:11	2:16	2:16	2:33	17 min
	2	12'	2:35	2:41	2:41	2:51	10 min
	3	7'	Water in hole				
	4	4 1/2'	2:52	2:54	2:54	2:57	3 min
	5	12'	3:00	3:05	3:05	3:10	5 min
	6	7'	Water in hole				

SOIL AUGER FINDING

TESTED BY

REMARKS

Test in high part of lot
B. Streaker Hold for supervisor
Weather passed by No Basement facilities
expected cpl.

APPLICATION

SEWAGE DISPOSAL TESTING

MARYLAND STATE DEPARTMENT OF HEALTH

HOWARD COUNTY

ELLICOTT CITY

DISTRICT

DATE

A 17440

P

5^a

11/5/72

TO: THE COUNTY HEALTH OFFICER
ELLICOTT CITY, MARYLAND

I, HEREBY, APPLY FOR THE NECESSARY TESTS IN ORDER TO CONSTRUCT (OR RECONSTRUCT) A SEWAGE DISPOSAL SYSTEM.

PROPERTY OWNER

ADDRESS

PHONE

PROPERTY LOCATION:

SUBDIVISION

LOT NO.

ROAD AND DESCRIPTION

OCCUPANT

PHONE

PERSON TO CONSTRUCT SYSTEM

ADDRESS

PHONE

SIZE OF LOT

TYPE BLDG.

NUMBER OF BEDROOMS

IF NOT SINGLE RESIDENCE DESCRIBE

SIGNATURE OF APPLICANT

APPROVED BY

FOR

DATE

REJECTED BY

FOR


DATE

HOLD PENDING FURTHER TESTS

DATE

REASONS FOR REJECTION OR HOLDING

THIS IS NOT A PERMIT

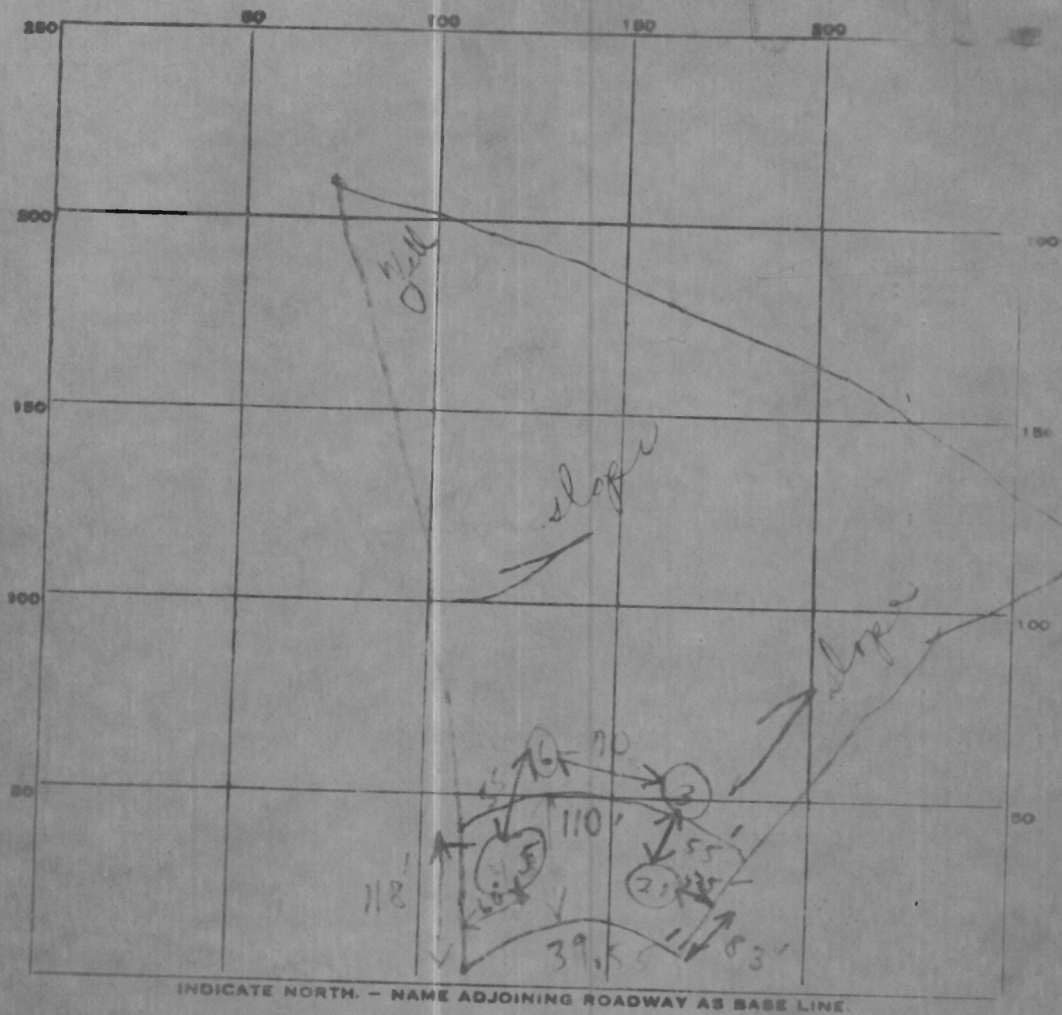

DATE	TEST NO.	DEPTH	PRE-WET		TEST - 1" DROP		TIME
			START	STOP	START	STOP	
7/2/42		4 1/2'	2:11	2:16	2:16	2:33	17 min
	2	12'	2:35	2:41	2:41	2:51	10 min
	3	7'	Water in hole				
	4	4 1/2'	2:52	2:54	2:54	2:57	3 min
	5	12'	3:00	3:05	3:05	3:10	5 min
	6	7'	Water in hole				

SOIL AUGER FINDING

TESTED BY

REMARKS

Test on high part of lot
Held for expansion
No expansion
No expansion

5/10/76

Mr. Wine

Please call:

Gris Van Swol

730 - 8888