

APPLICATION

SEWAGE DISPOSAL TESTING

A 06944

P 076521

MARYLAND STATE DEPARTMENT OF HEALTH

HOWARD COUNTY

ELLICOTT CITY

DISTRICT 5

DATE 6-14-63

*Dry well 11 ft in dia by 12 ft
deep below inlet located 45 ft.
from rear property line and 30 ft. off the
left side property line as determined when
having the lot from Cherry Tree Drive.
Inlet at 3 ft below original grade,
75 gal septic tank.*

TO: THE COUNTY HEALTH OFFICER
ELLICOTT CITY, MARYLAND

I, HEREBY, APPLY FOR THE NECESSARY TESTS IN ORDER TO CONSTRUCT (OR RECONSTRUCT) A SEWAGE DISPOSAL SYSTEM.

PROPERTY OWNER Thomas Lacey

ADDRESS _____ PHONE _____

PROPERTY LOCATION:

SUBDIVISION Moosefield LOT NO. 1, sec A

ROAD AND DESCRIPTION Cherry Tree Dr.

OCCUPANT _____ PHONE _____

PERSON TO CONSTRUCT SYSTEM _____

ADDRESS _____ PHONE _____

SIZE OF LOT 1/2 acre TYPE BLDG. 3

NUMBER OF BEDROOMS

IF NOT SINGLE RESIDENCE DESCRIBE _____

SIGNATURE OF APPLICANT Edward Suggs


APPROVED BY Henry FOR Dry Well DATE 7-11-63

REJECTED BY _____ FOR _____ DATE _____

HOLD PENDING FURTHER TESTS _____ DATE _____

REASONS FOR REJECTION OR HOLDING _____

THIS IS NOT A PERMIT

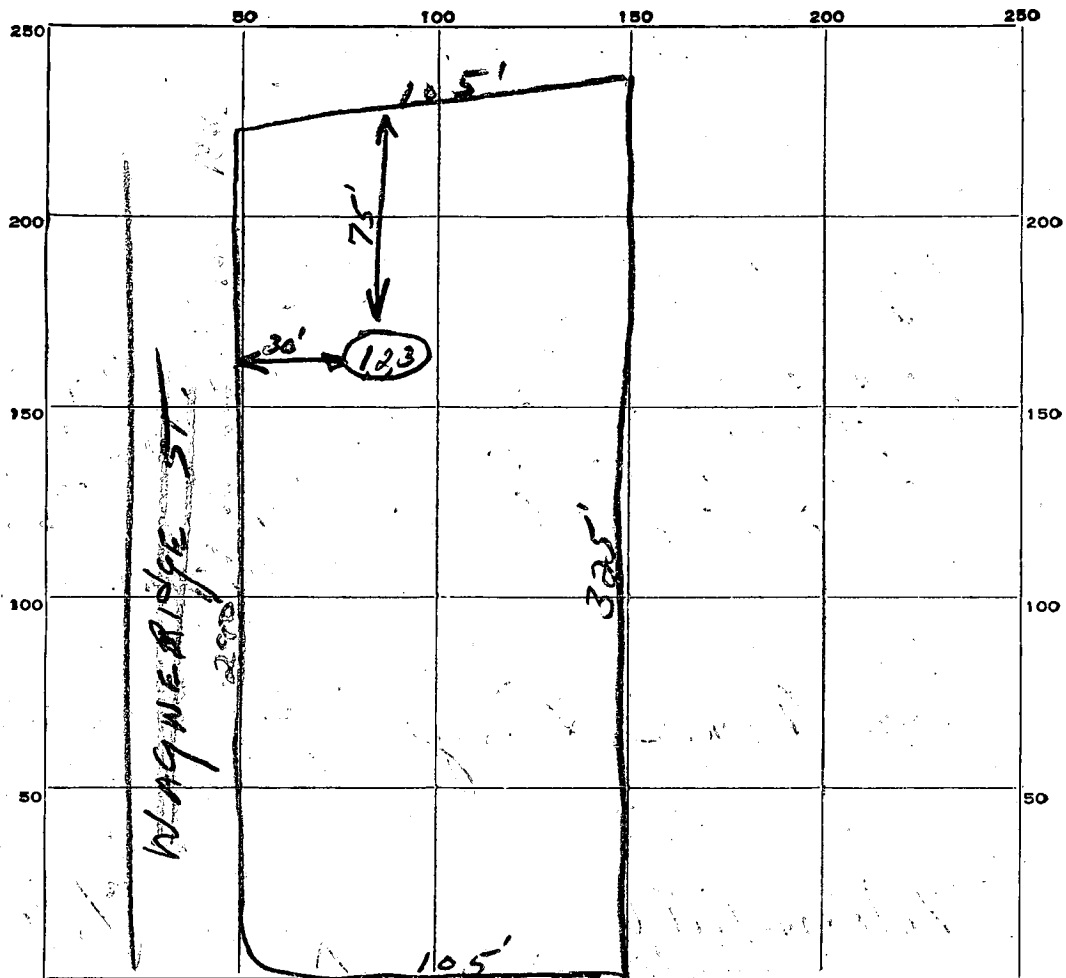

INDICATE NORTH. - NAME ADJOINING ROADWAY AS BASE LINE.

CHERRY TREE DRIVE

DATE	TEST NO.	DEPTH	PRE-WET		TEST - 1" DROP		TIME
			START	STOP	START	STOP	
7-11-63	1	9 1/2	11:40	11:42	11:42	11:48	6 M min
	2	5 1/2	11:55				
	3	11	Porous - red soil some moisture				

SOIL AUGER FINDING

TESTED BY

REMARKS

ALSO PRESENT

LOT NO.

15' 5 1/2 ft not good, not good to 11 FT.
7-11-63
123